



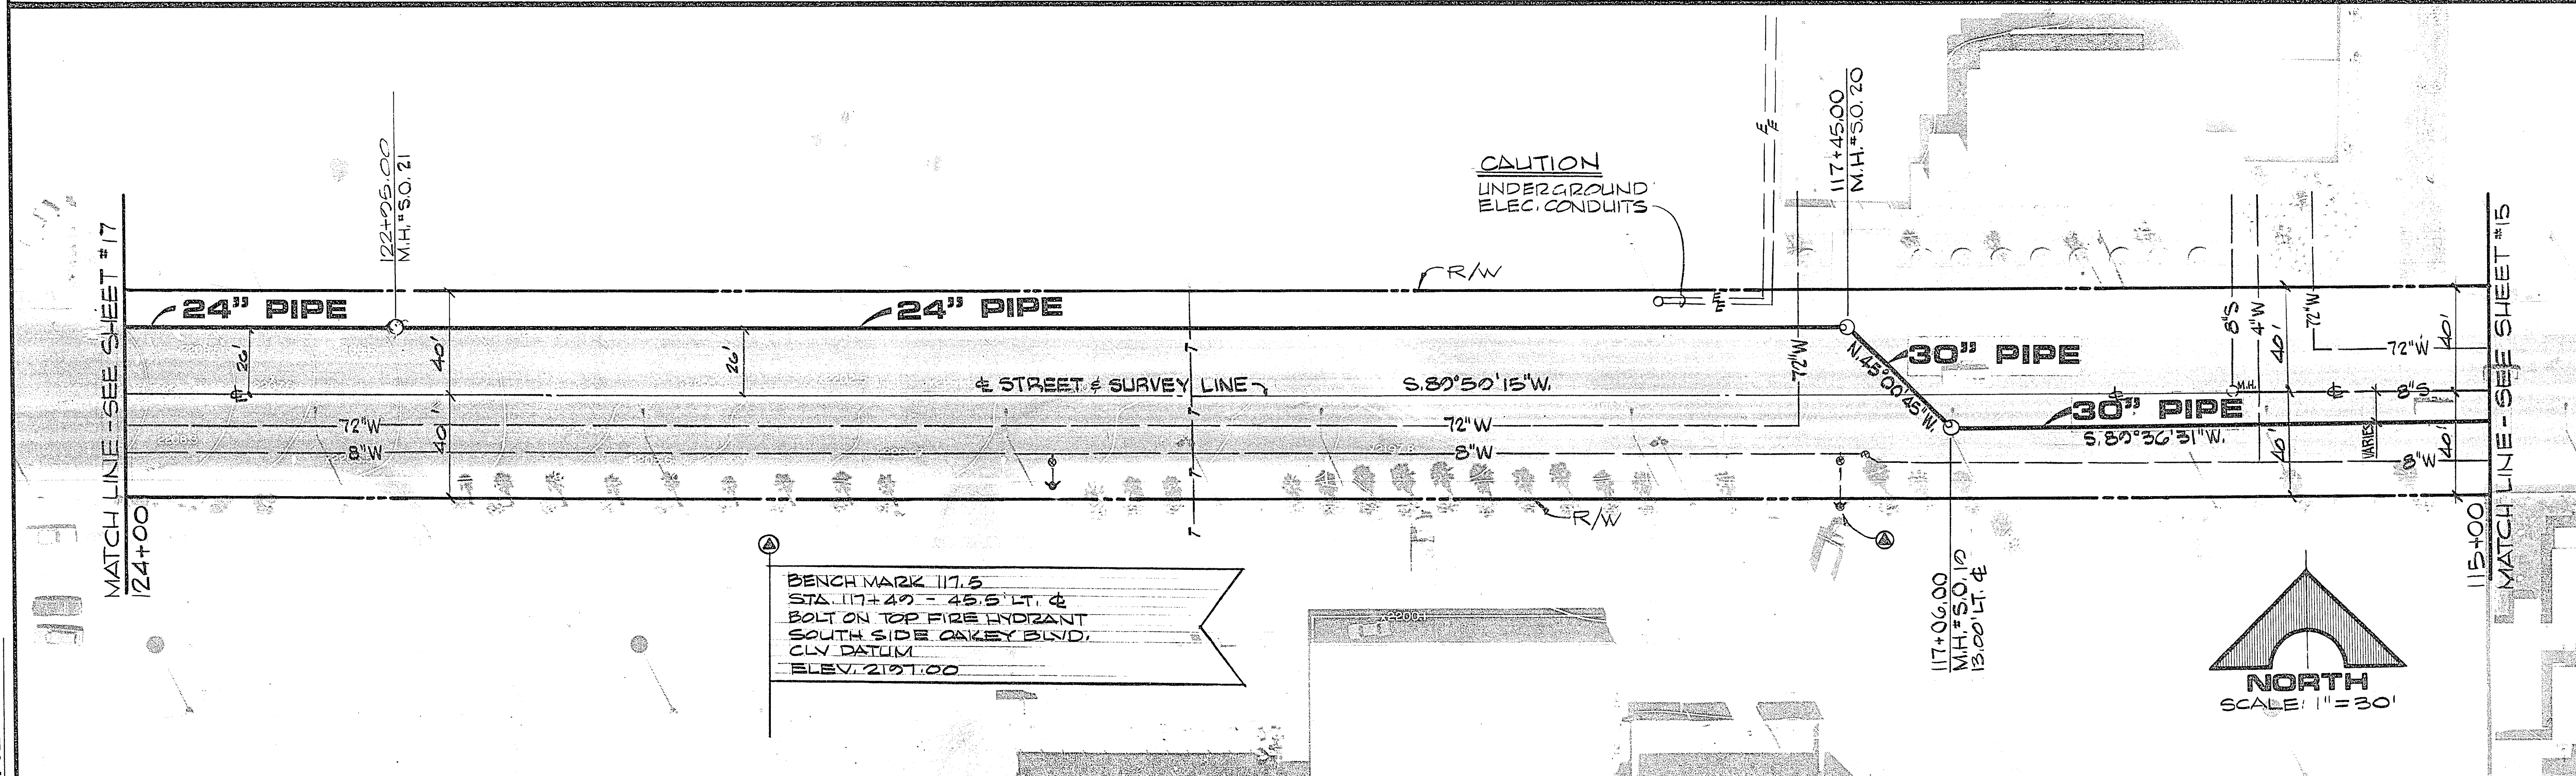

OAKLEY

BOULEVARD

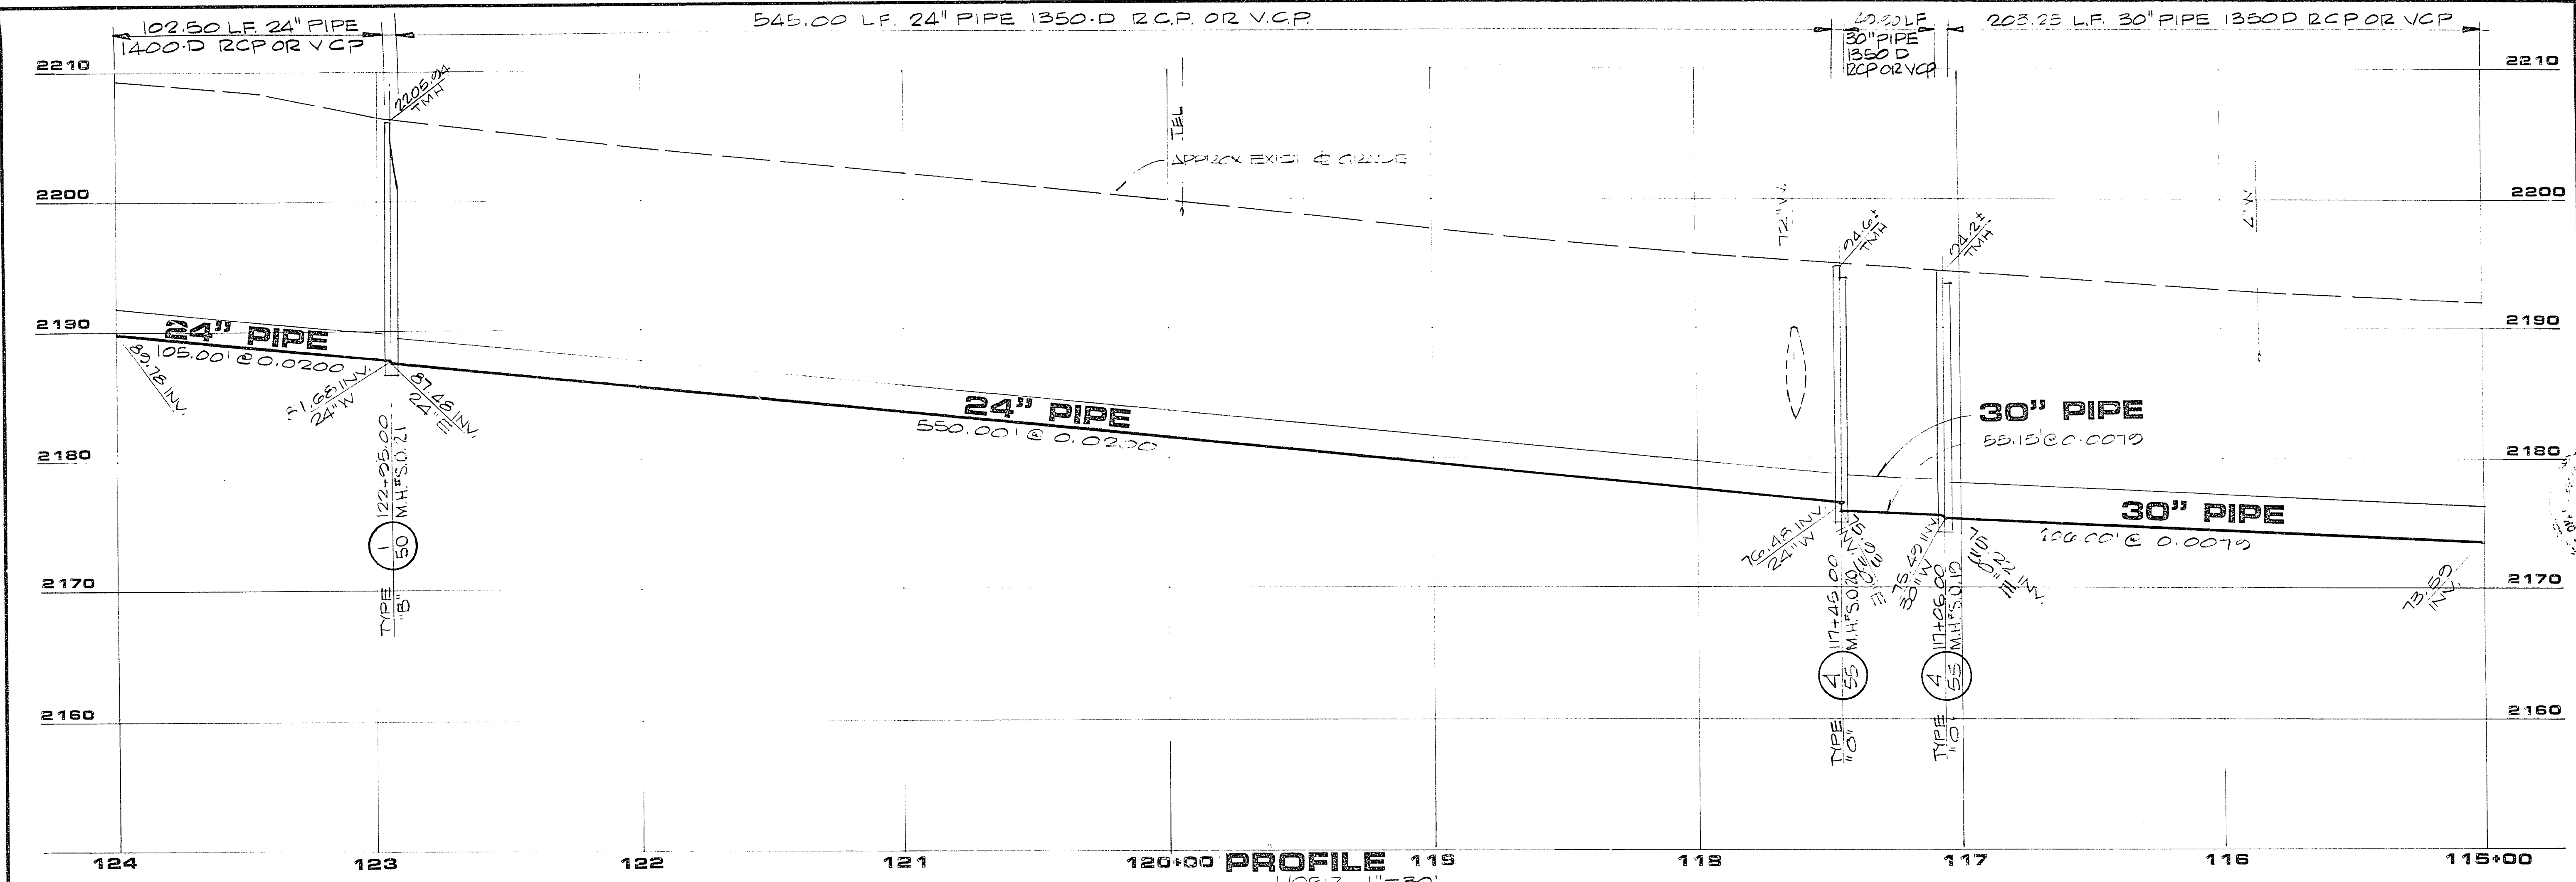

NORTH  
SCALE: 1"=30'

AS BUILT DRAWING

307-V 563

|                                                                                                          |          |
|----------------------------------------------------------------------------------------------------------|----------|
| REVISIONS                                                                                                |          |
| REV                                                                                                      | DATE     |
| 1                                                                                                        | 11/16/88 |
| DESCRIPTION: AS BUILT - NO REVISIONS                                                                     |          |
| DESIGNED BY: J. ROSS                                                                                     |          |
| CHECKED BY: J. ROSS                                                                                      |          |
| DATE: 11/16/88                                                                                           |          |
| PROJECT: SAHARA - OAKLEY SEWER INTERCEPTOR                                                               |          |
| SHEET: 16                                                                                                |          |
| OF 65 SHEETS                                                                                             |          |
| G.C. WALLACE<br>Consulting Engineers, Inc.<br>1100 East Sahara Ave. - Las Vegas, Nevada 89104 - 732-3330 |          |
| Department of Public Services<br>SAHARA - OAKLEY SEWER INTERCEPTOR<br>PLAN & PROFILE 115+00 TO 124+00    |          |