
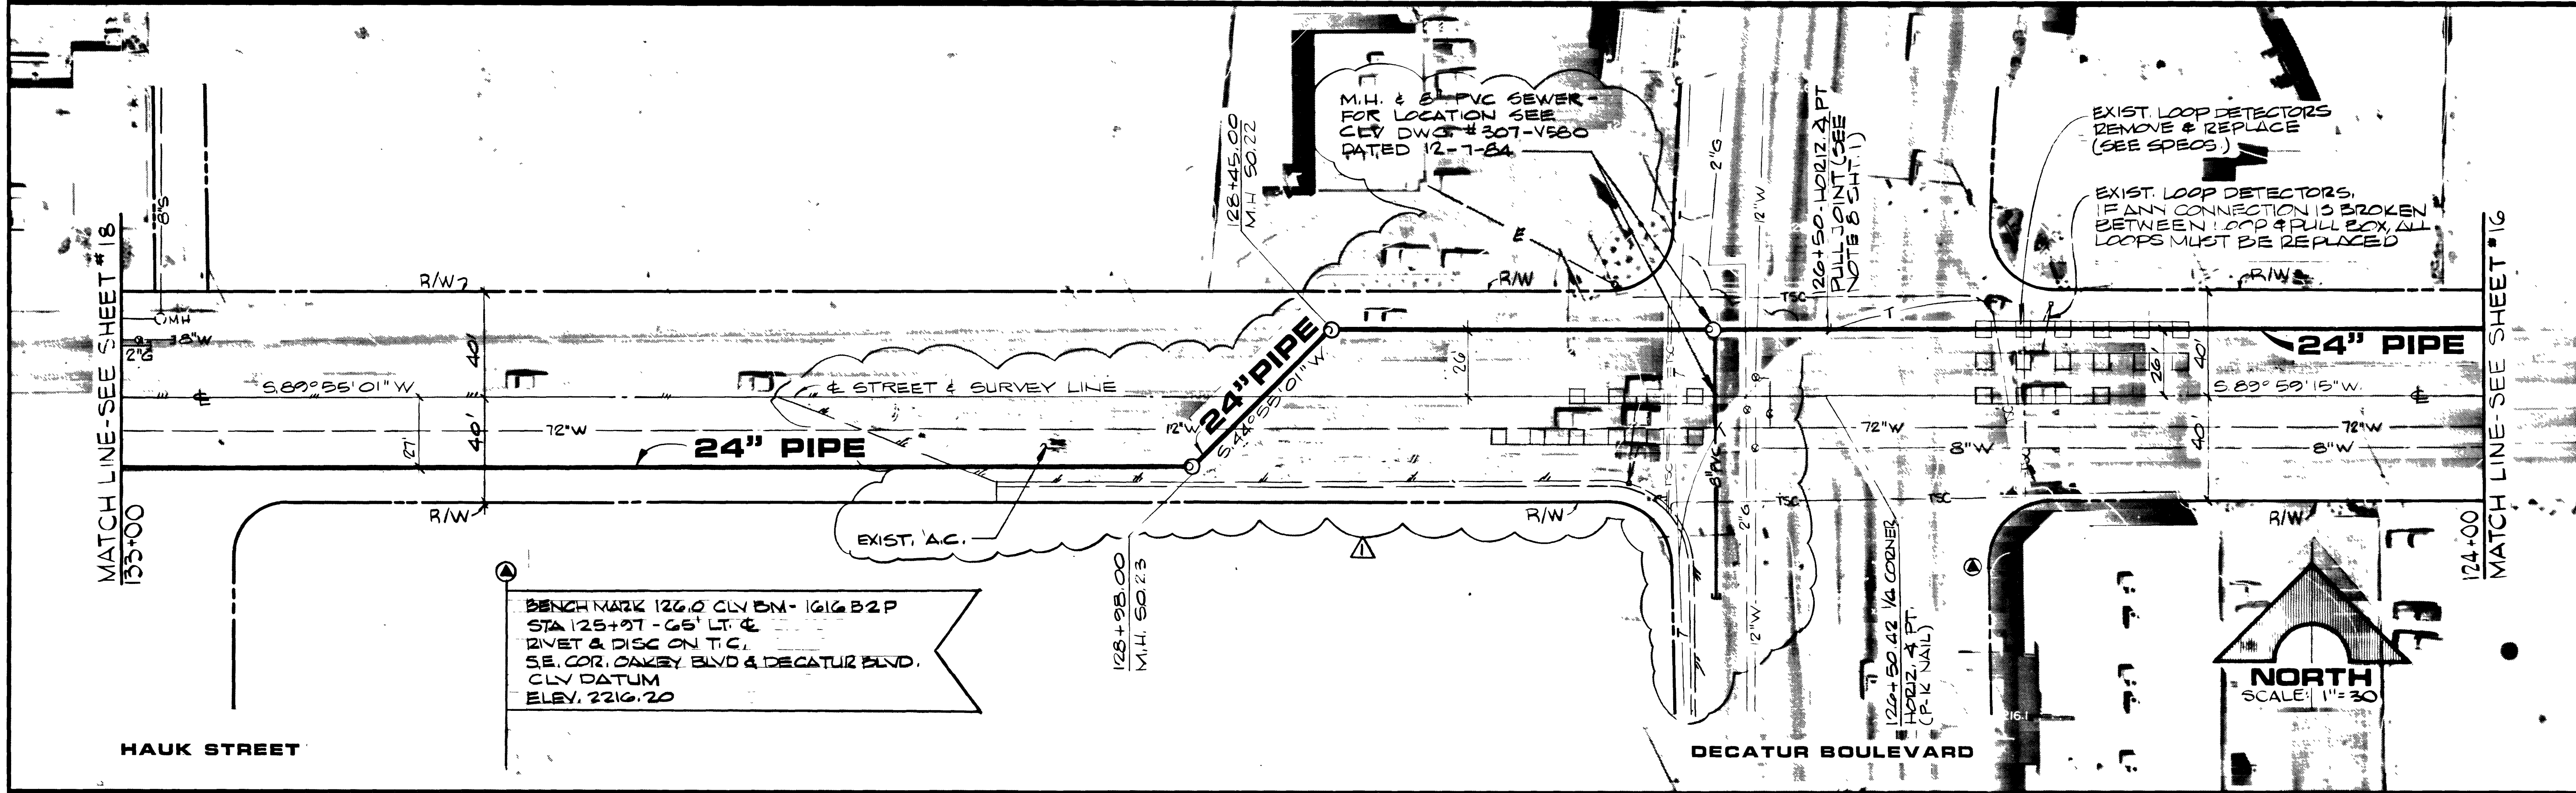


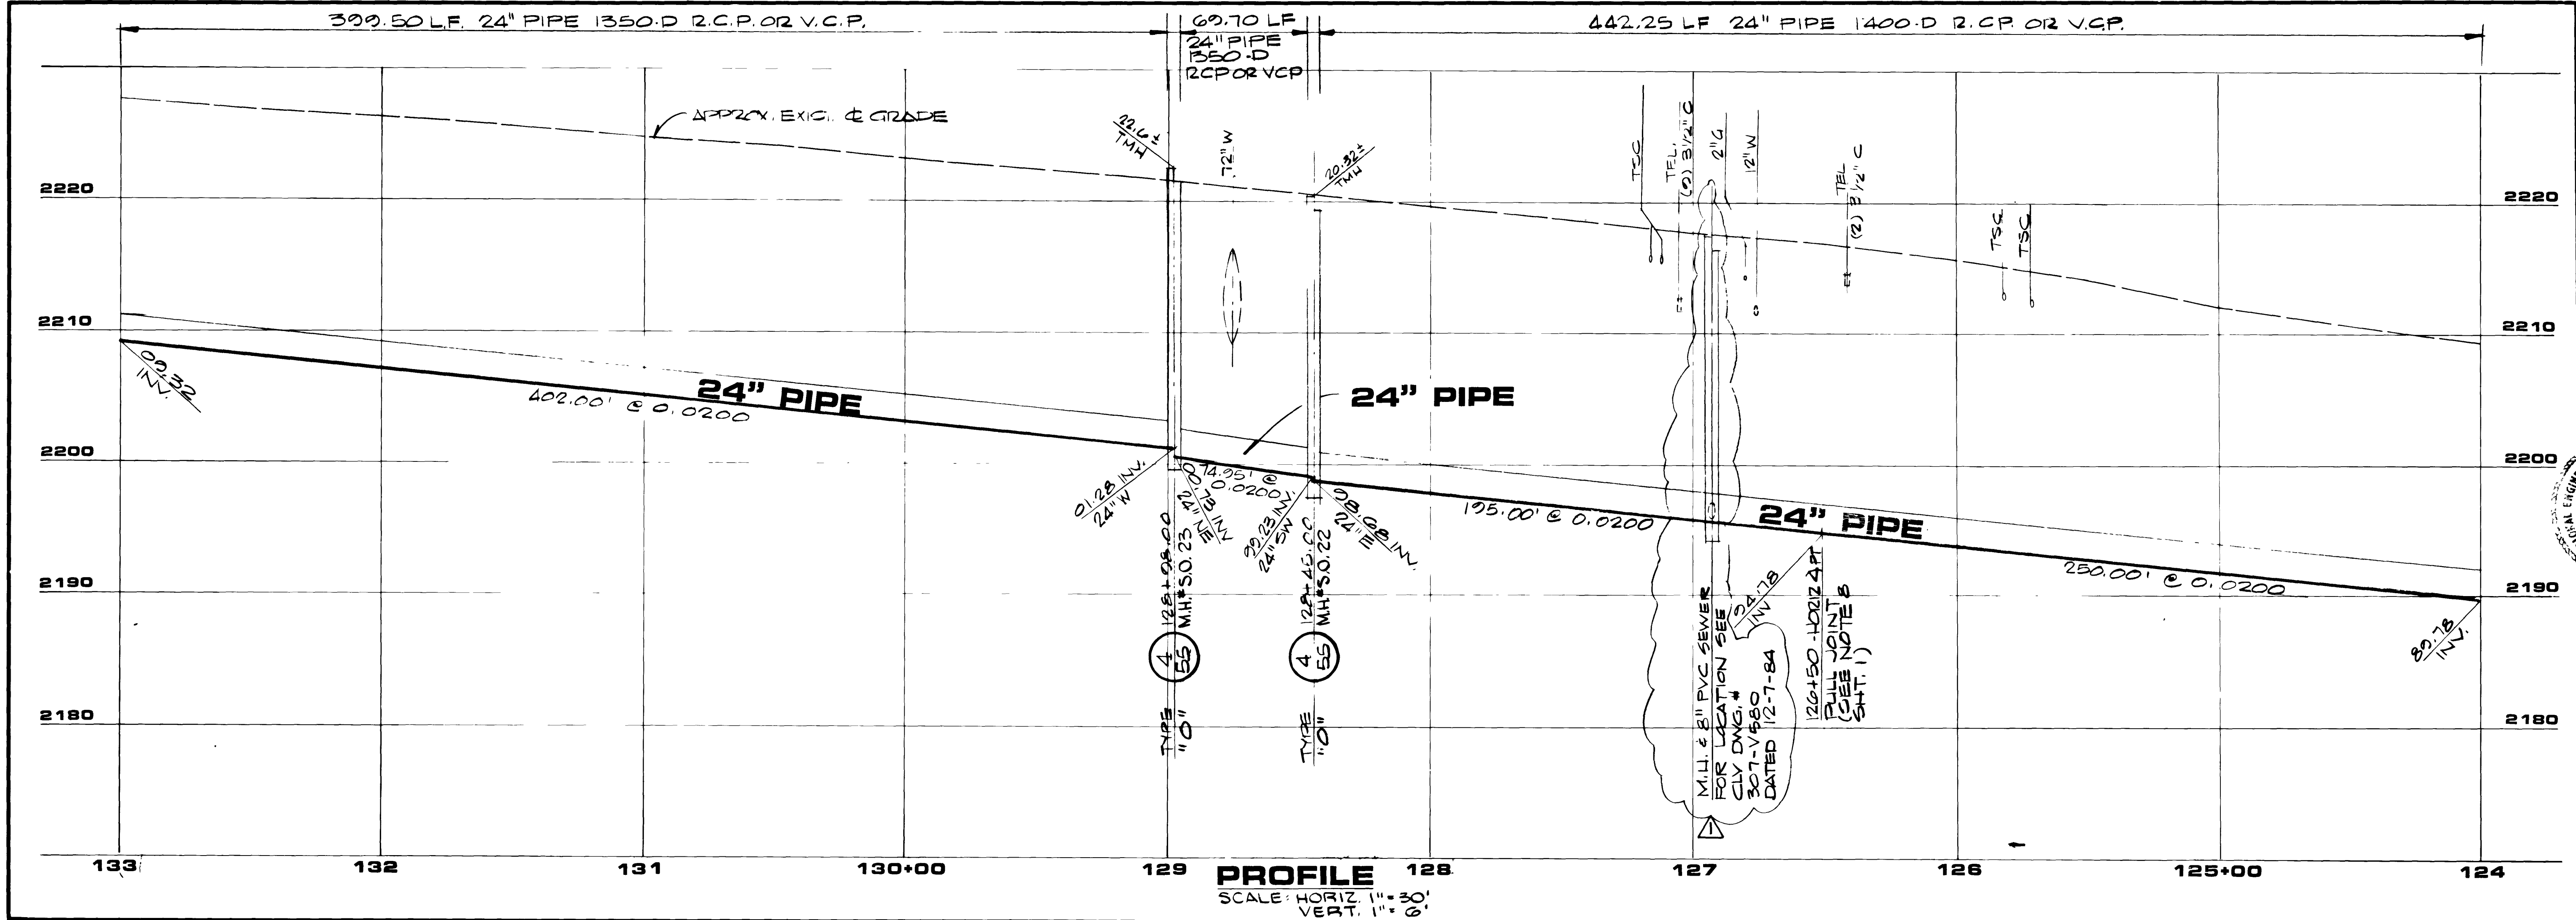

REVISION	DATE	DESCRIPTION
1	10/1/85	AS BUILT

LOCAL ENGINEER OF RECORD
MICHAEL D. ROSS
CIVIL
1100 East Sahara Ave. Las Vegas, Nevada 89104 • 732-3330

G.C. WALLACE
Consulting Engineers, Inc.

Department of Public Services
SAHARA - OAKLEY SEWER INTERCEPTOR
PLAN & PROFILE 124+00 TO 133+00

SHEET
17
OF 25 SHEETS

