



PROFILE
SCALE: HORIZ. 1"=30'
VERT. 1"=6'

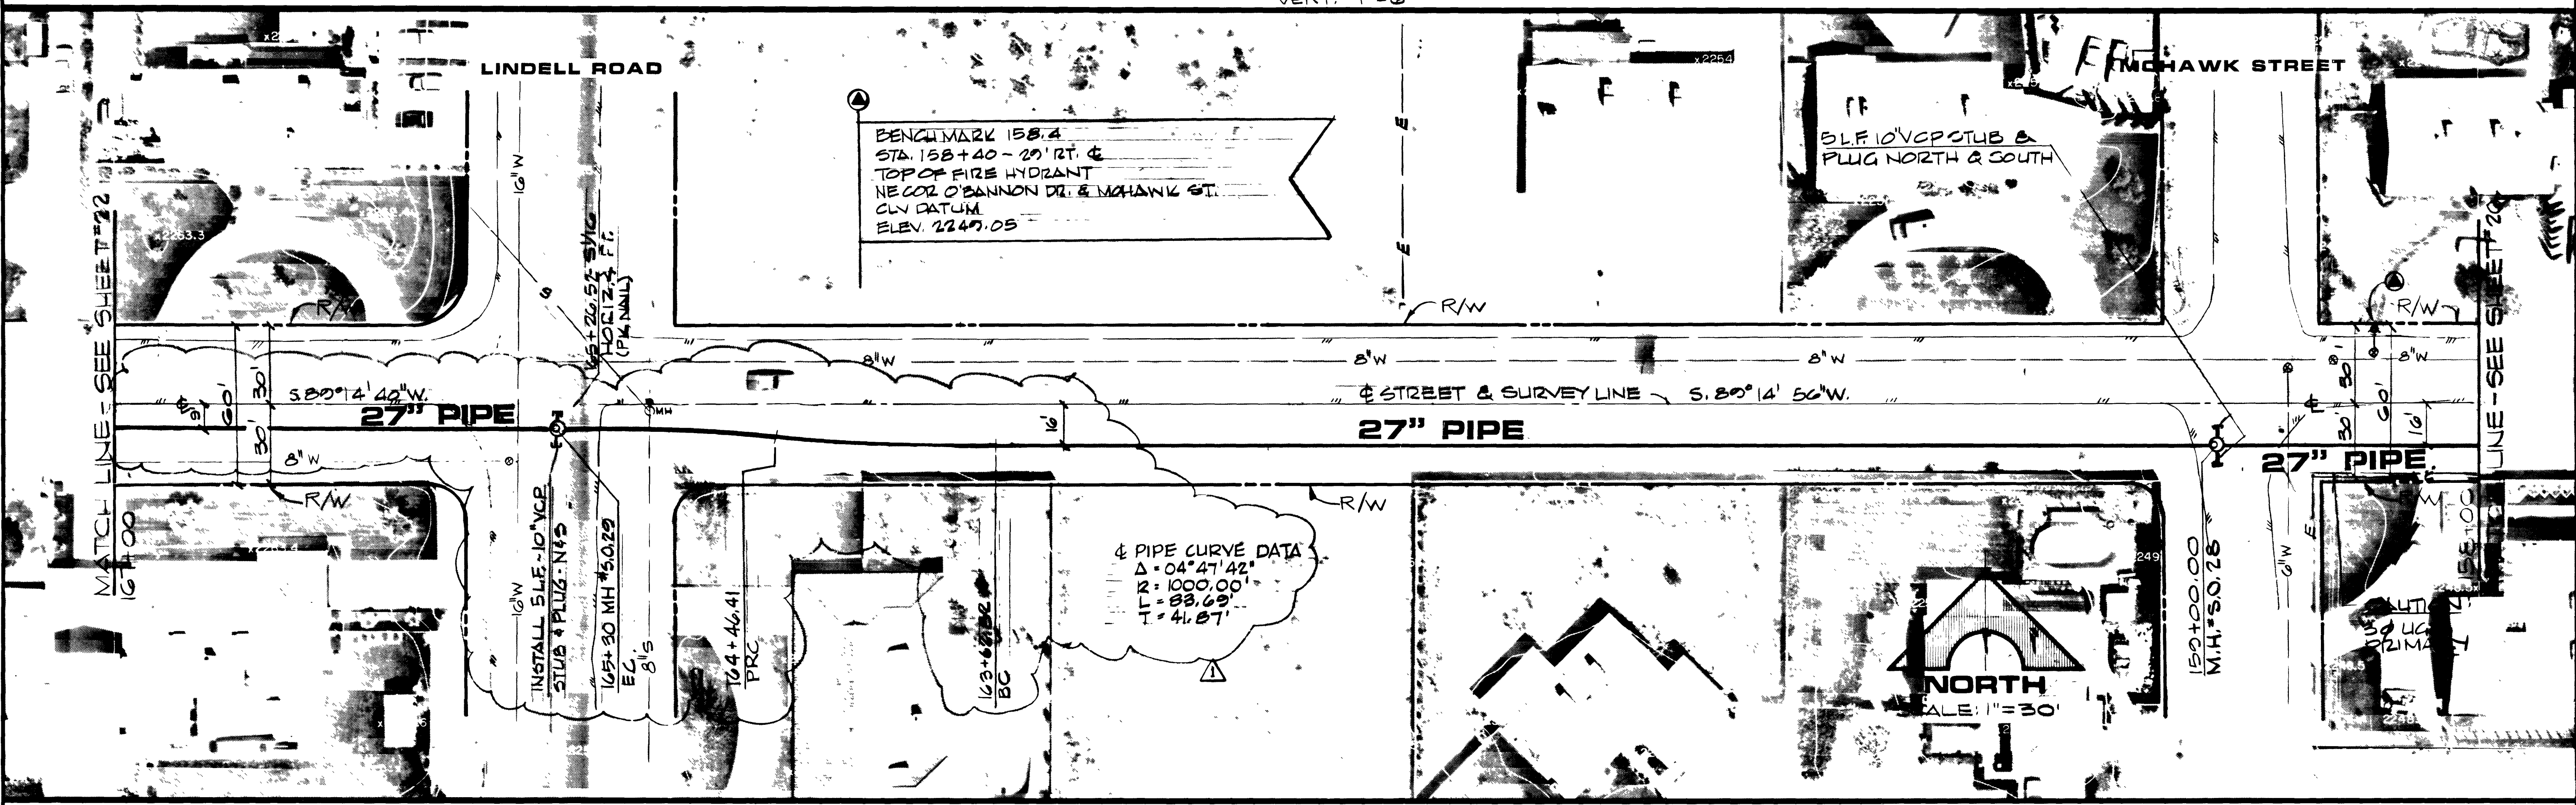

PIPE CURVE DATA
Δ = 04°47'42"
R = 1000.00'
L = 83.69'
T = 41.87'


NORTH
SCALE: 1"=30'

REV	DATE	DESCRIPTION
1	11/16/05	AS BUILT - NO REVISIONS
2	11/16/05	AS BUILT - NO REVISIONS

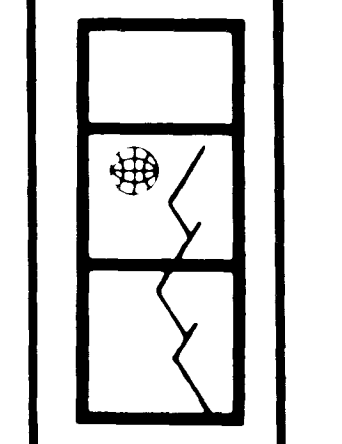

G. C. WALLACE
Consulting Engineers, Inc.
1100 East Sahara Ave. - Las Vegas, Nevada 89104 - 732-3330

Department of Public Services
SAHARA - O'AKY BEWER INTERCEPTOR
PLAN & PROFILE 158+00 TO 167+00

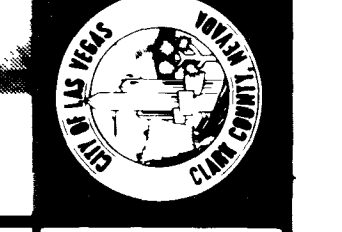

SHEET
21
OF 25 SHEETS

AS BUILT DRAWING