
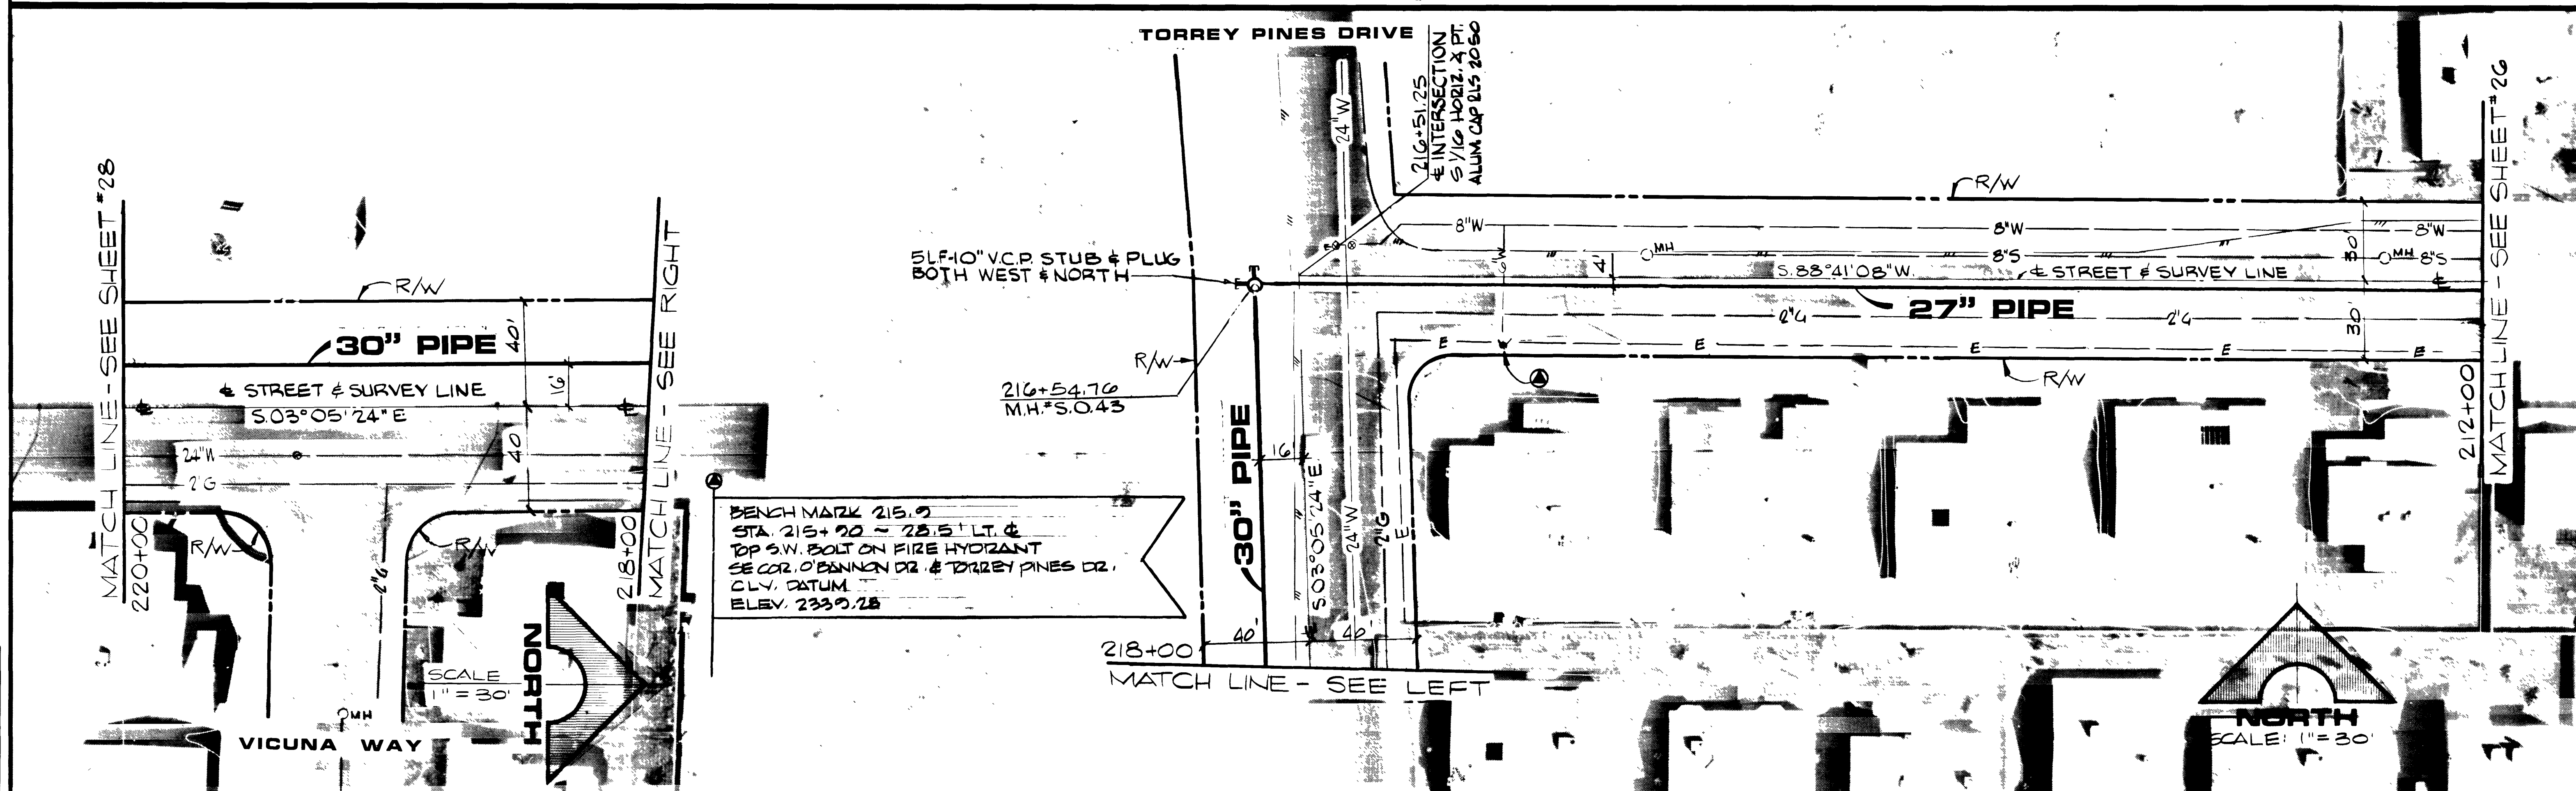


JOB NO. 412.140

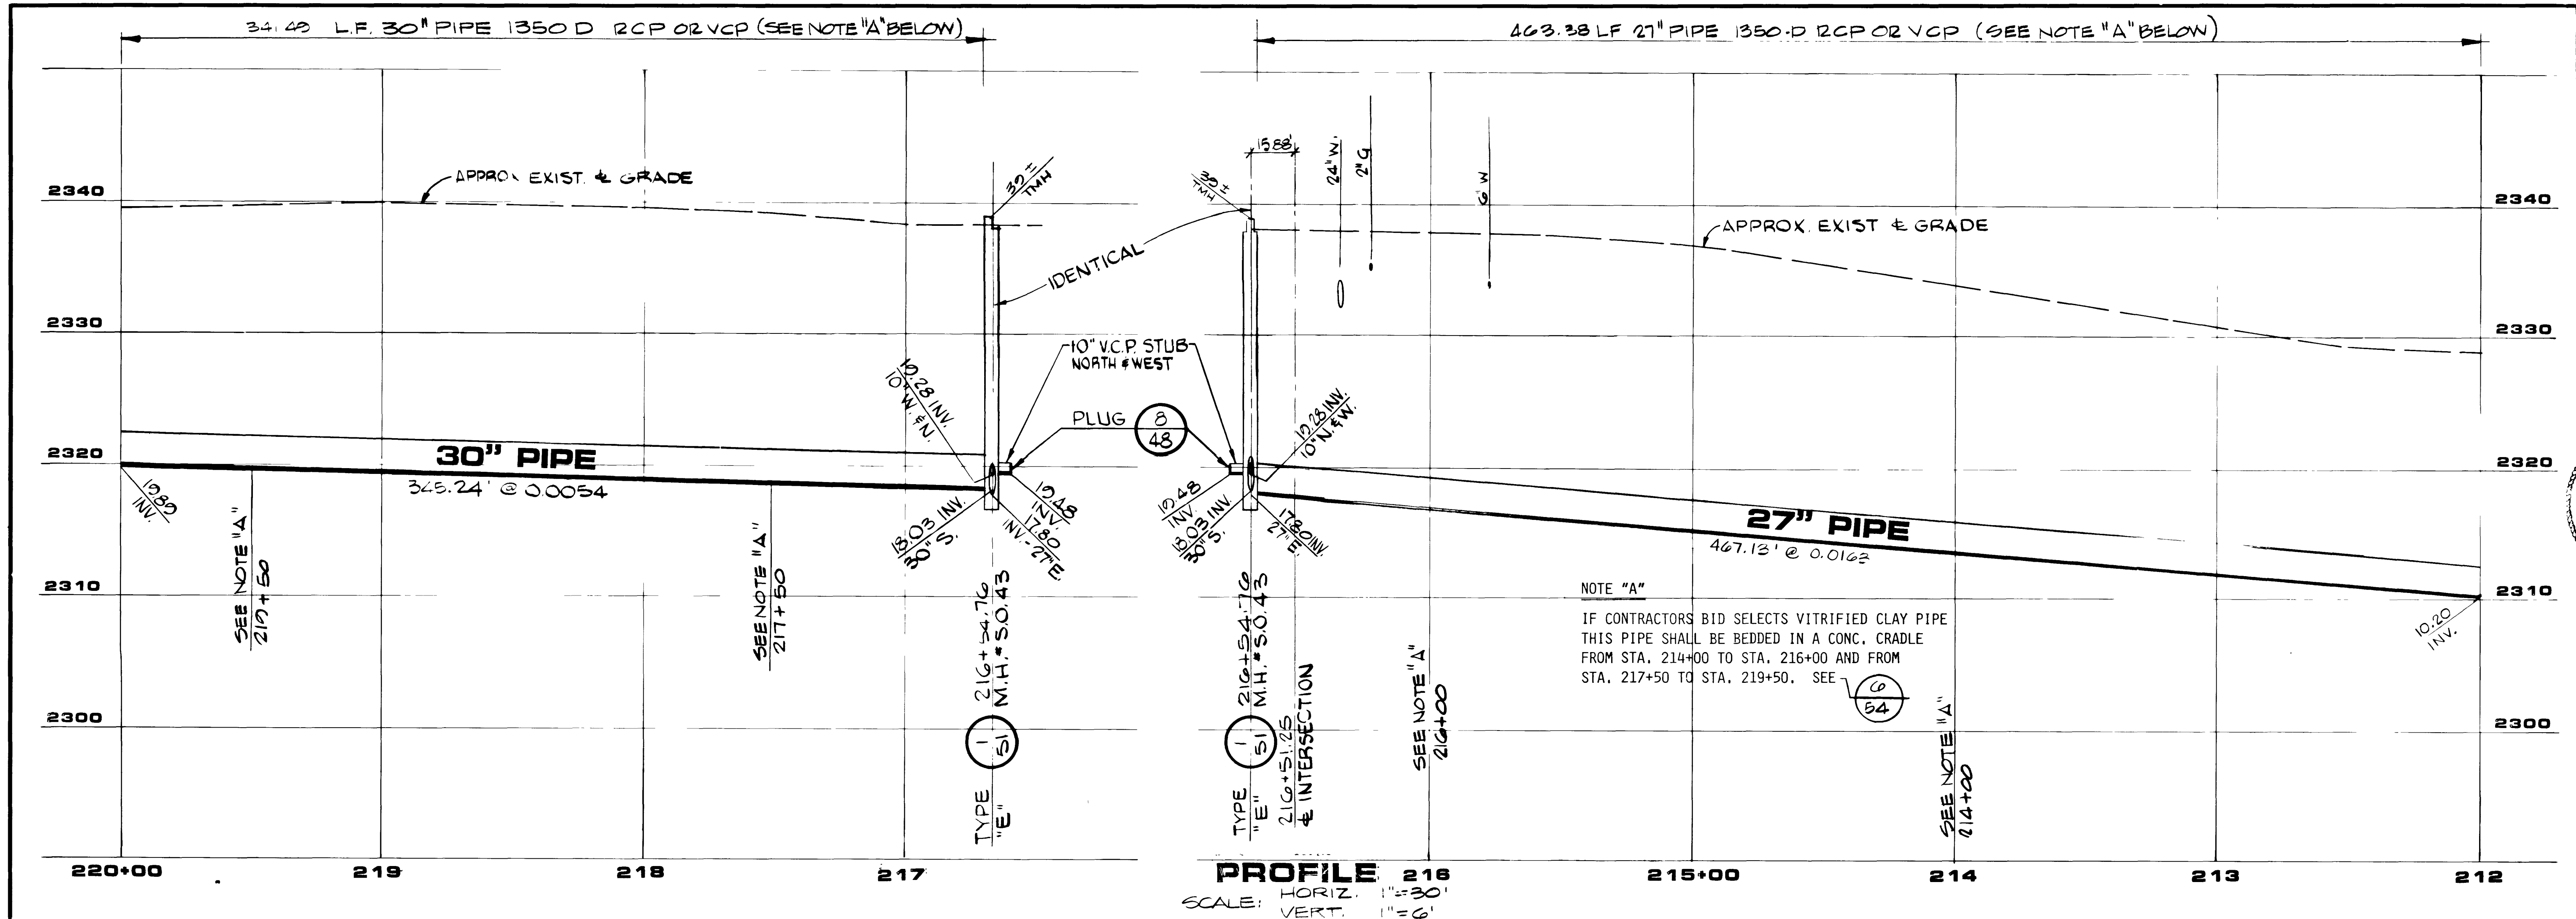

TORREY PINES DRIVE

(M)

O'BANNON

DRIVE

AS BUILT DRAWING

SHEET 27 OF 25 SHEETS

REV	DATE	DESCRIPTION
1	4/10/84	AS BUILT - NO REVISIONS
2	7/20/84	
3		
4		
G.C. WALLACE
Consulting Engineers, Inc.
1100 East Sahara Ave. • Las Vegas, Nevada 89104 • 732-3330

Department of Public Services
SAHARA - OAKLEY SEWER INTERCEPTOR
PLAN & PROFILE 212+00 TO 220+00

307-V 563 28-1-13

