
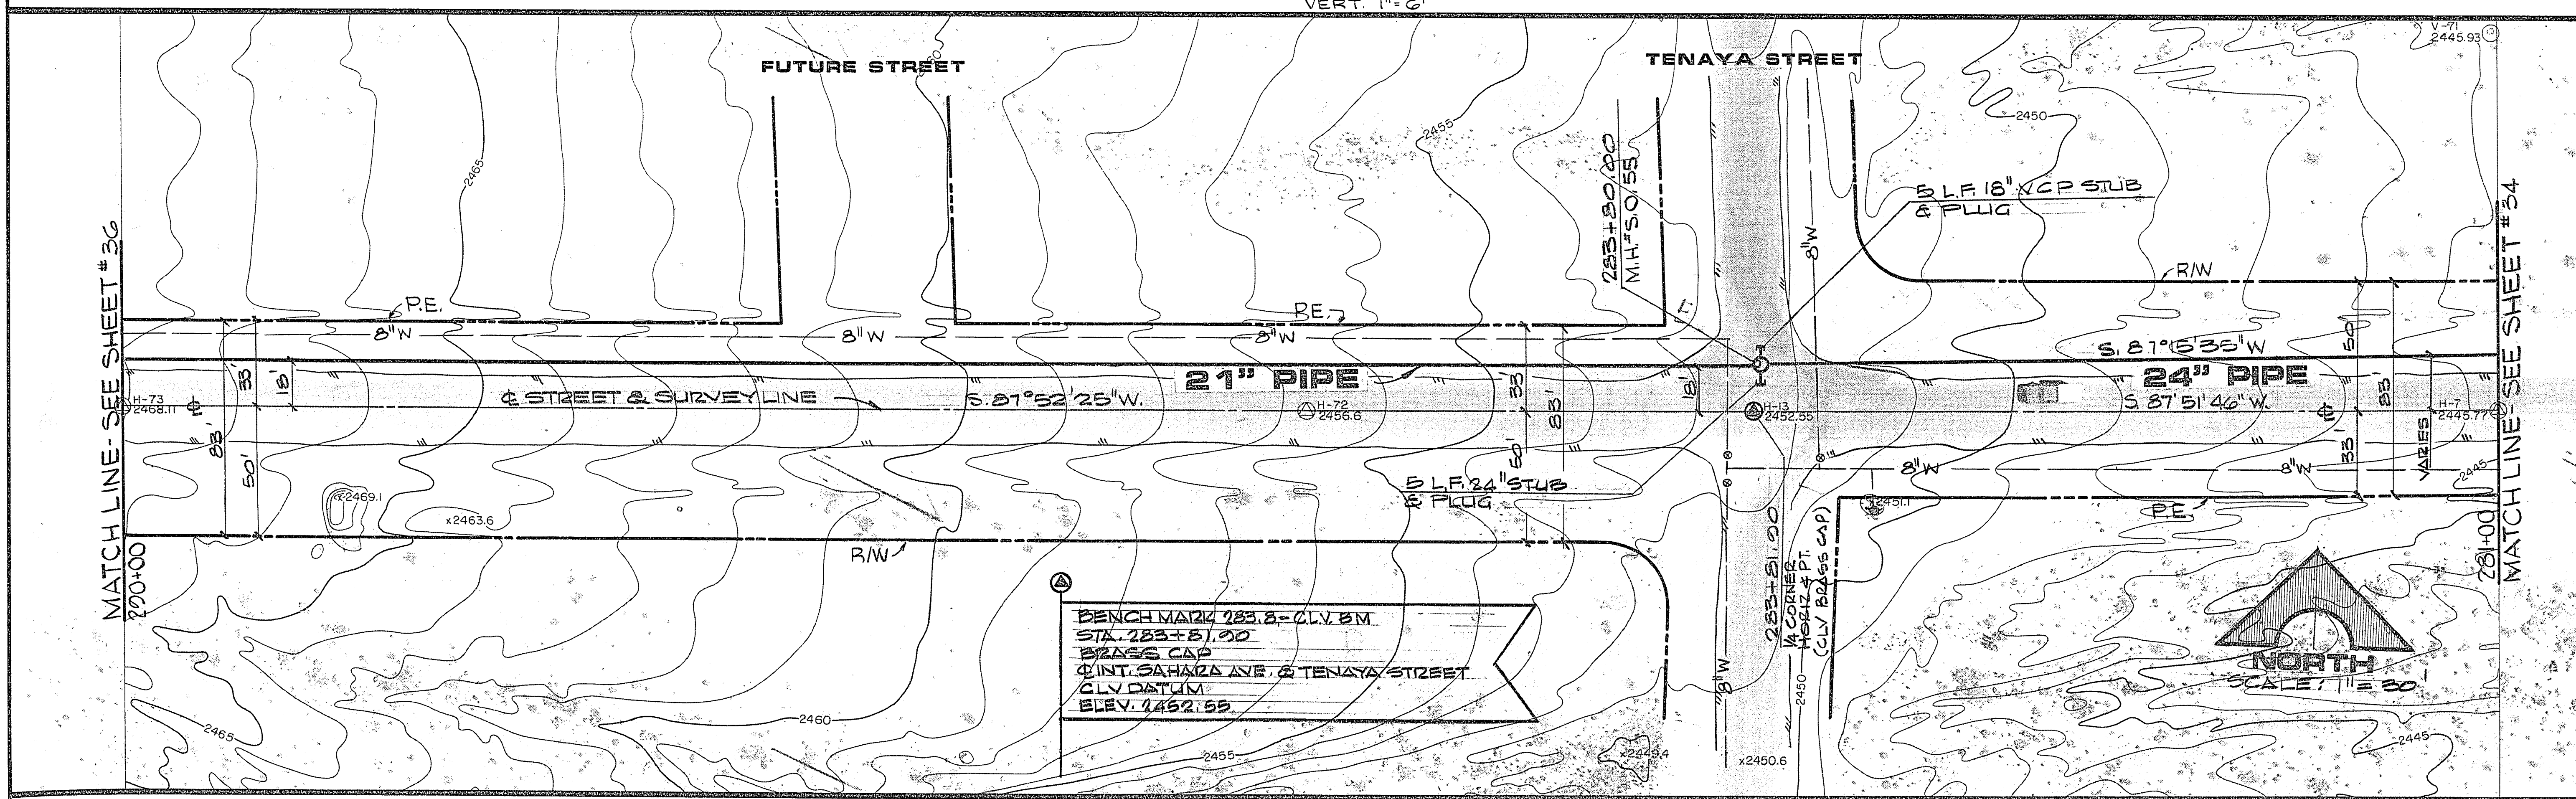


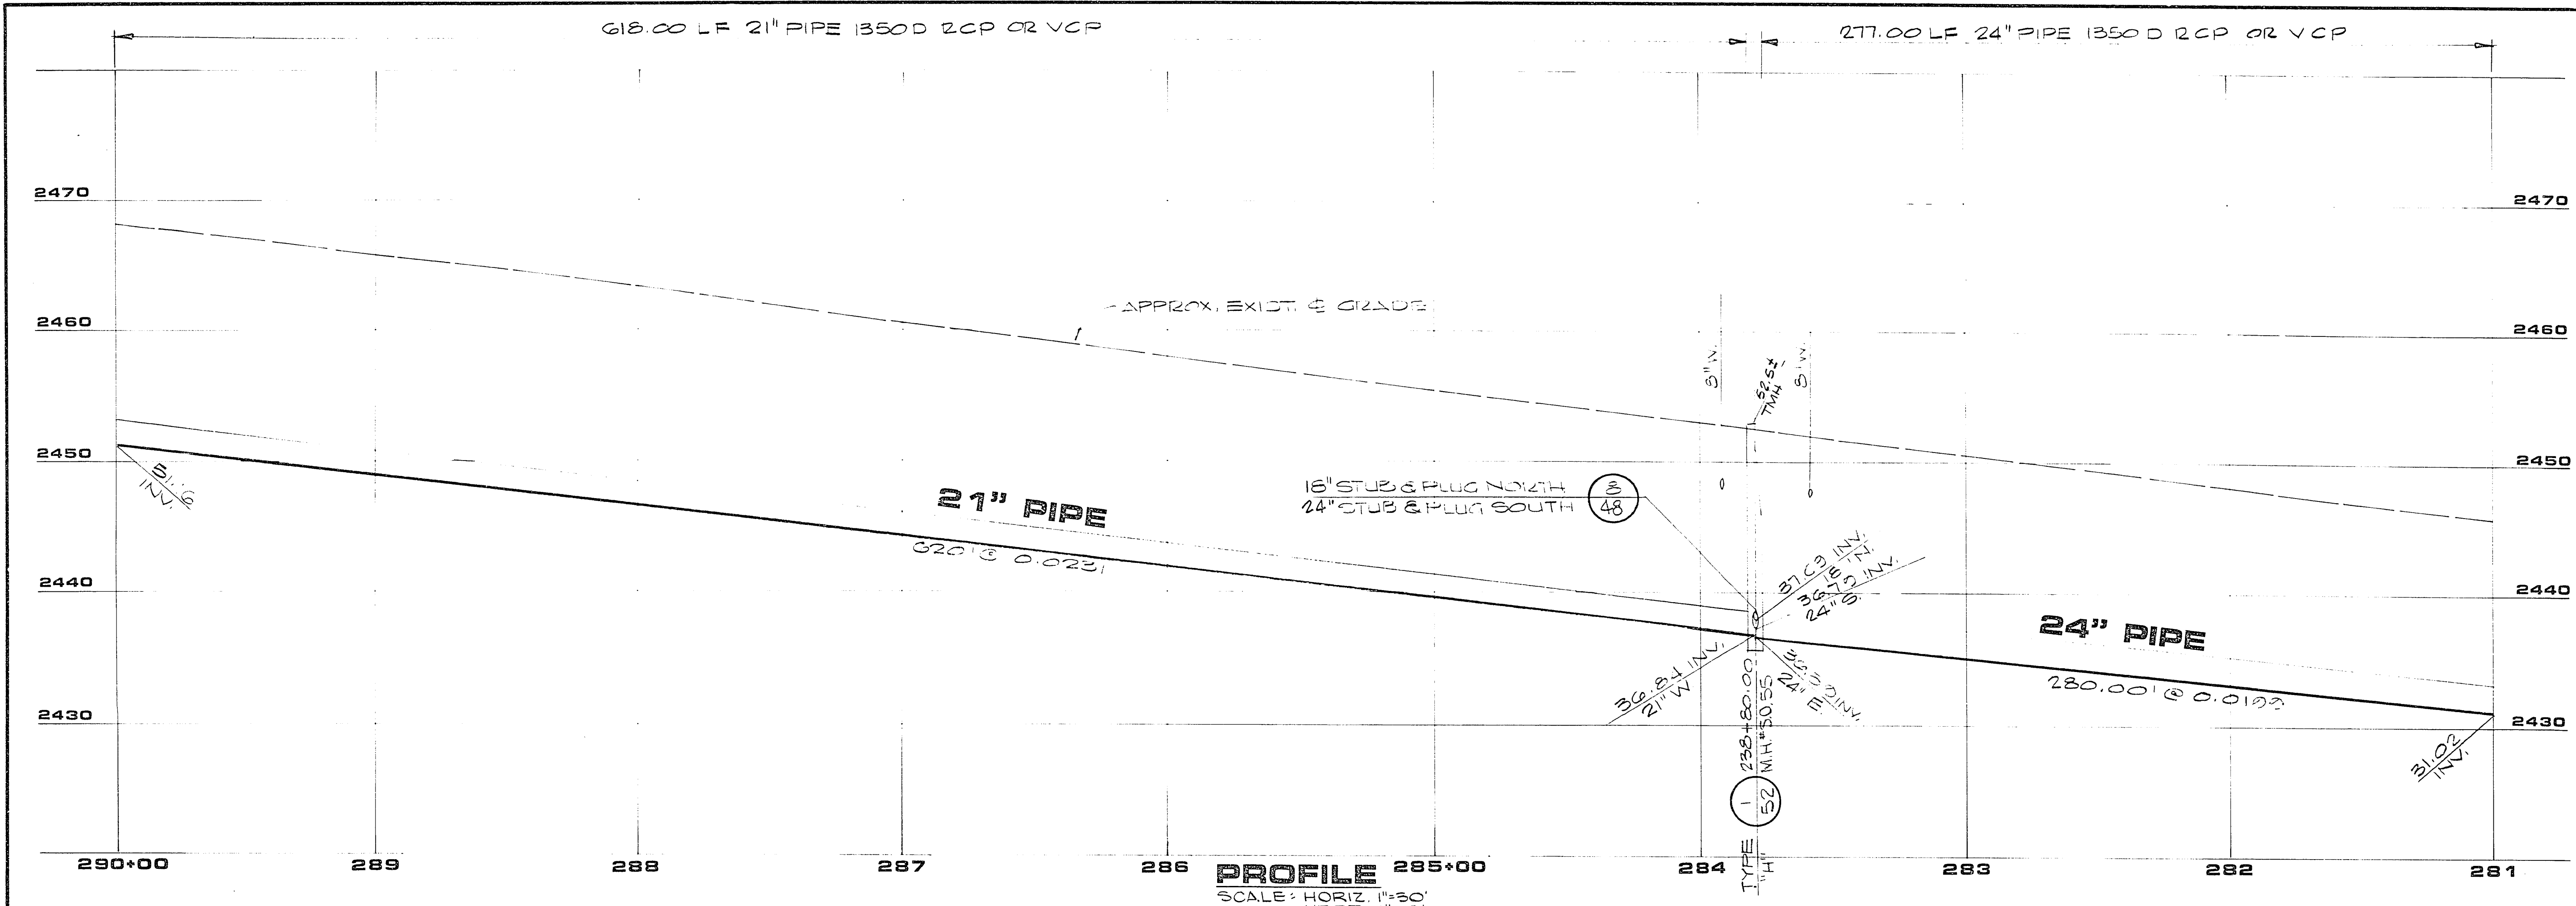

SAHARA

AVENUE

AS BUILT DRAWING

307-V 563

DESCRIPTION AS BUILT - NO REVISIONS	
REV	DATE
1	7/27/04
2	7/27/04
PROJECT: SAHARA AVENUE SEWER INTERCEPTOR DATE: 7/27/04 REVISIONS:	
ENGINEER: G. C. WALLACE CIVIL	
CONSULTING ENGINEERS, INC. 1100 East Sahara Ave. • Las Vegas, Nevada 89104 • 732-3330	
Department of Public Services SAHARA - OAKLEY SEWER INTERCEPTOR PLAN & PROFILE 281+00 TO 290+00	
SHEET 35 OF 65 SHEETS	