
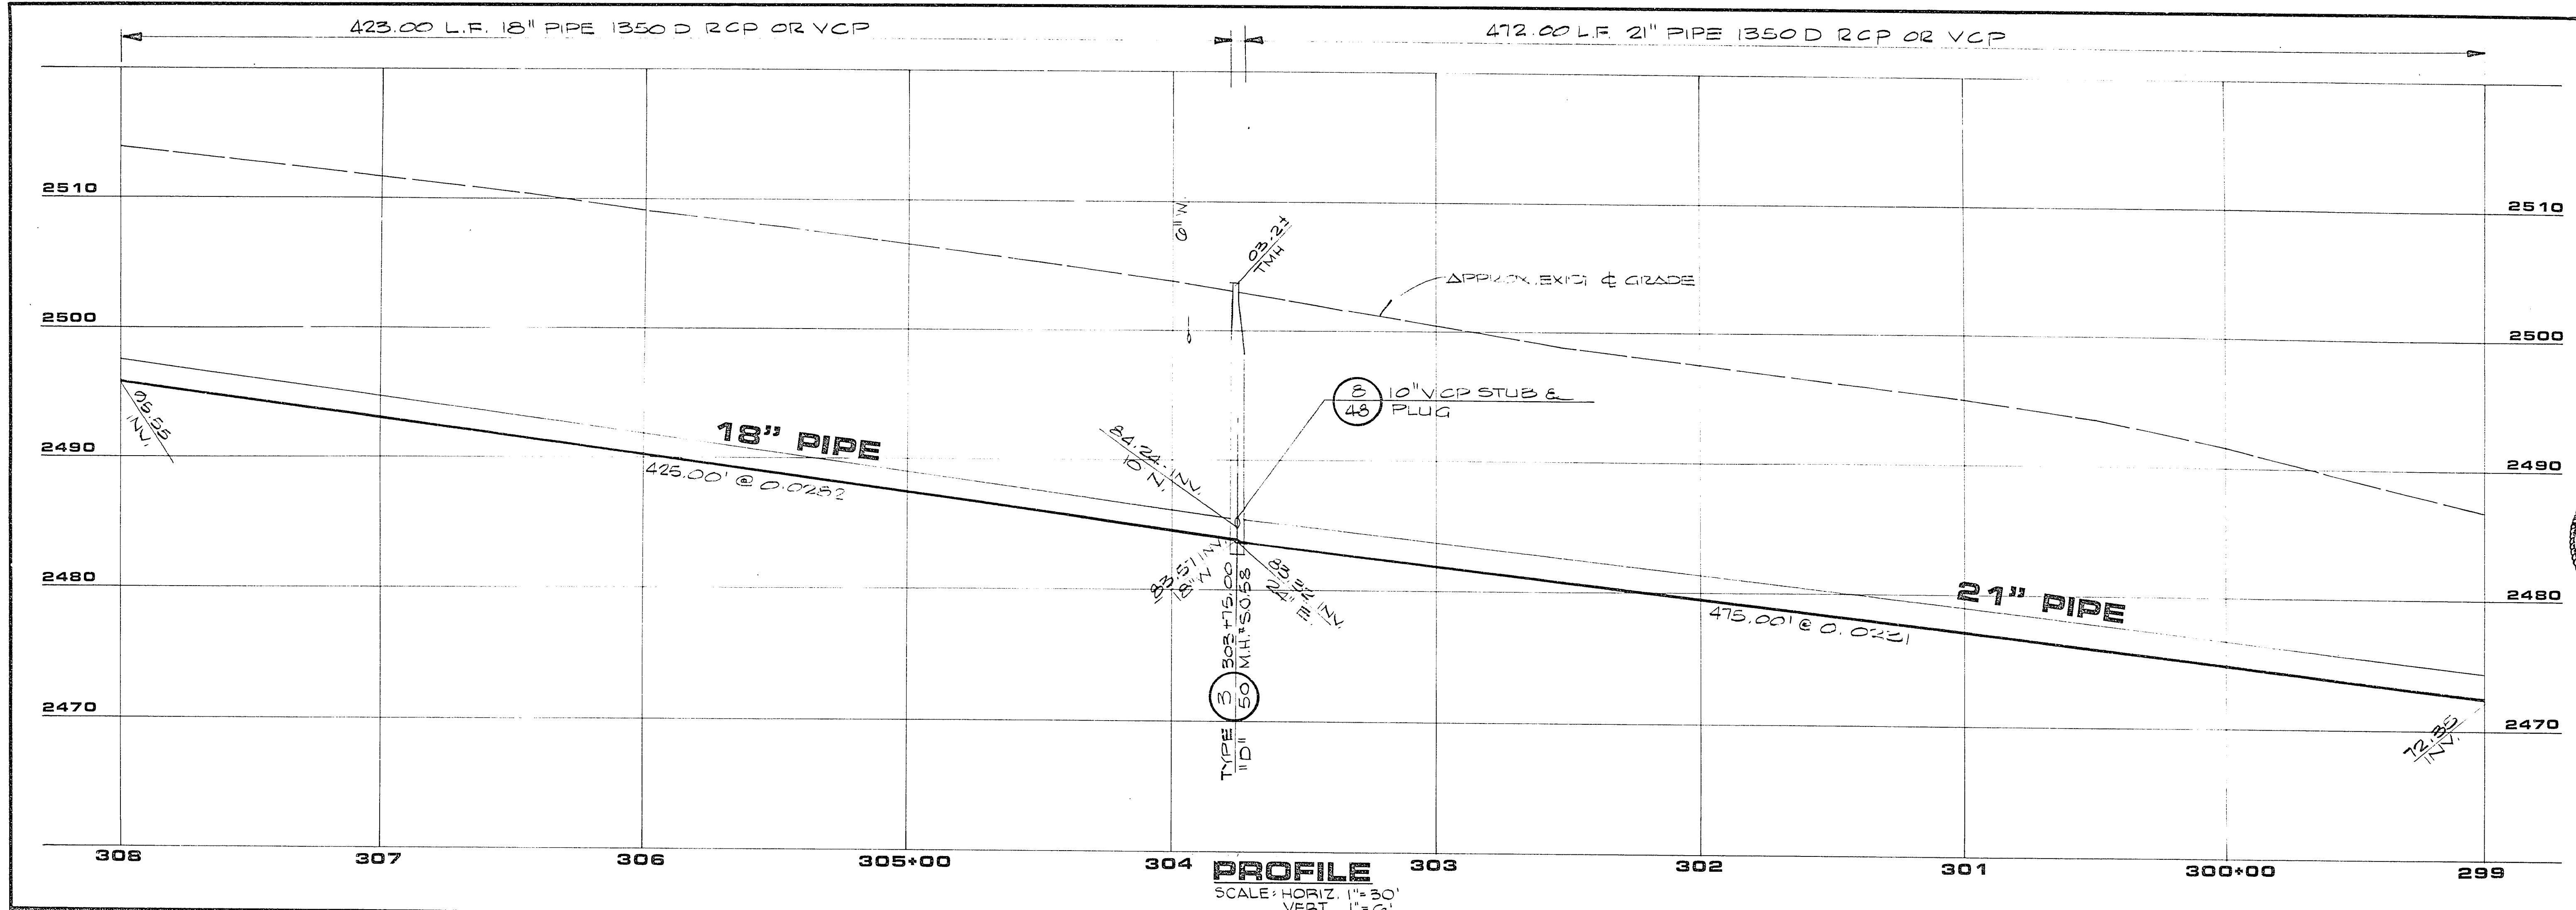


JOB NO. 412.140

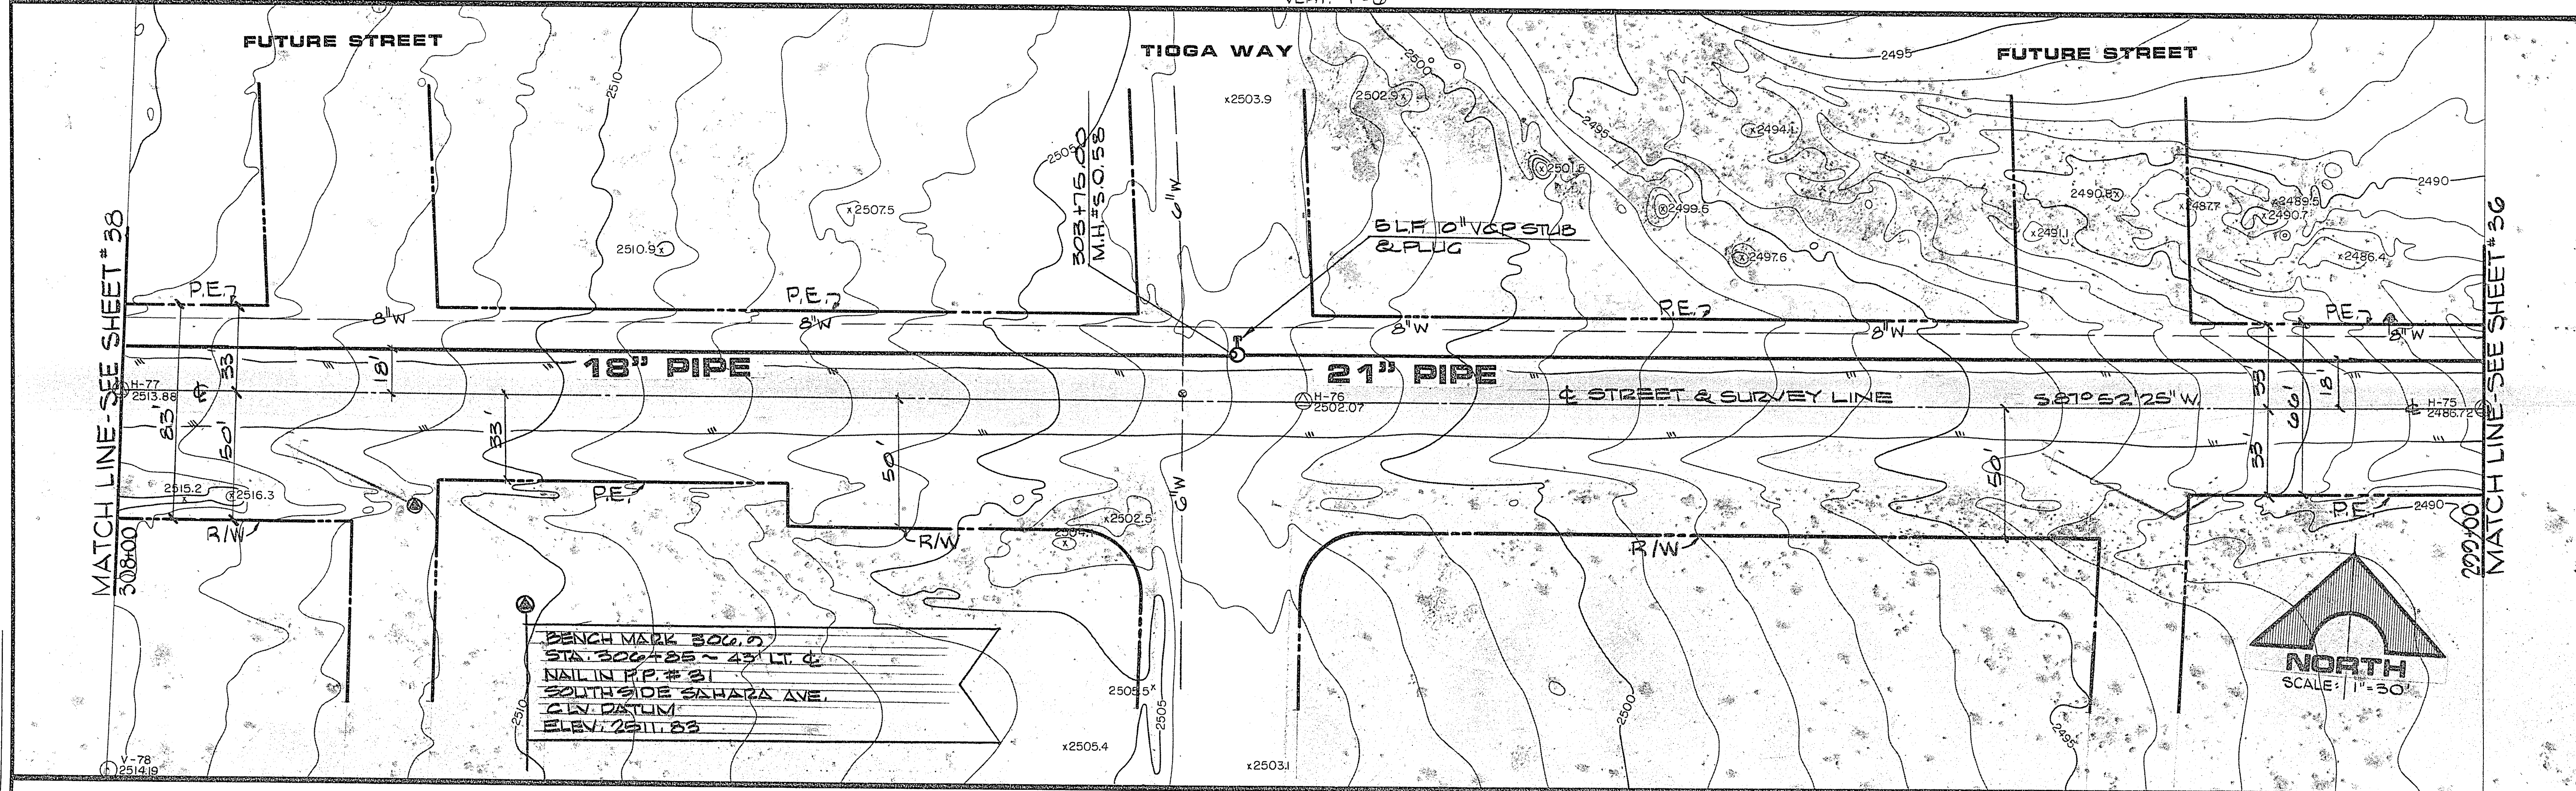

DESCRIPTION	
DATE	7/20/83
BY	AS BUILT - NO REVISIONS
DATE	
BY	
REGISTERED PROFESSIONAL ENGINEER - STATE OF NEVADA	
MICHAEL D. ROSS	
CIVIL	
G. C. WALLACE Consulting Engineers, Inc.	
1100 East Sahara Ave. • Las Vegas, Nevada 89104 • 732-3330	
Department of Public Services	
SAHARA - OAKLEY SEWER INTERCEPTOR	
PLAN & PROFILE 299+00 TO 308+00	
SHEET	
37	
OF 65 SHEETS	

AS BUILT DRAWING

307-V 563

28-1-113