
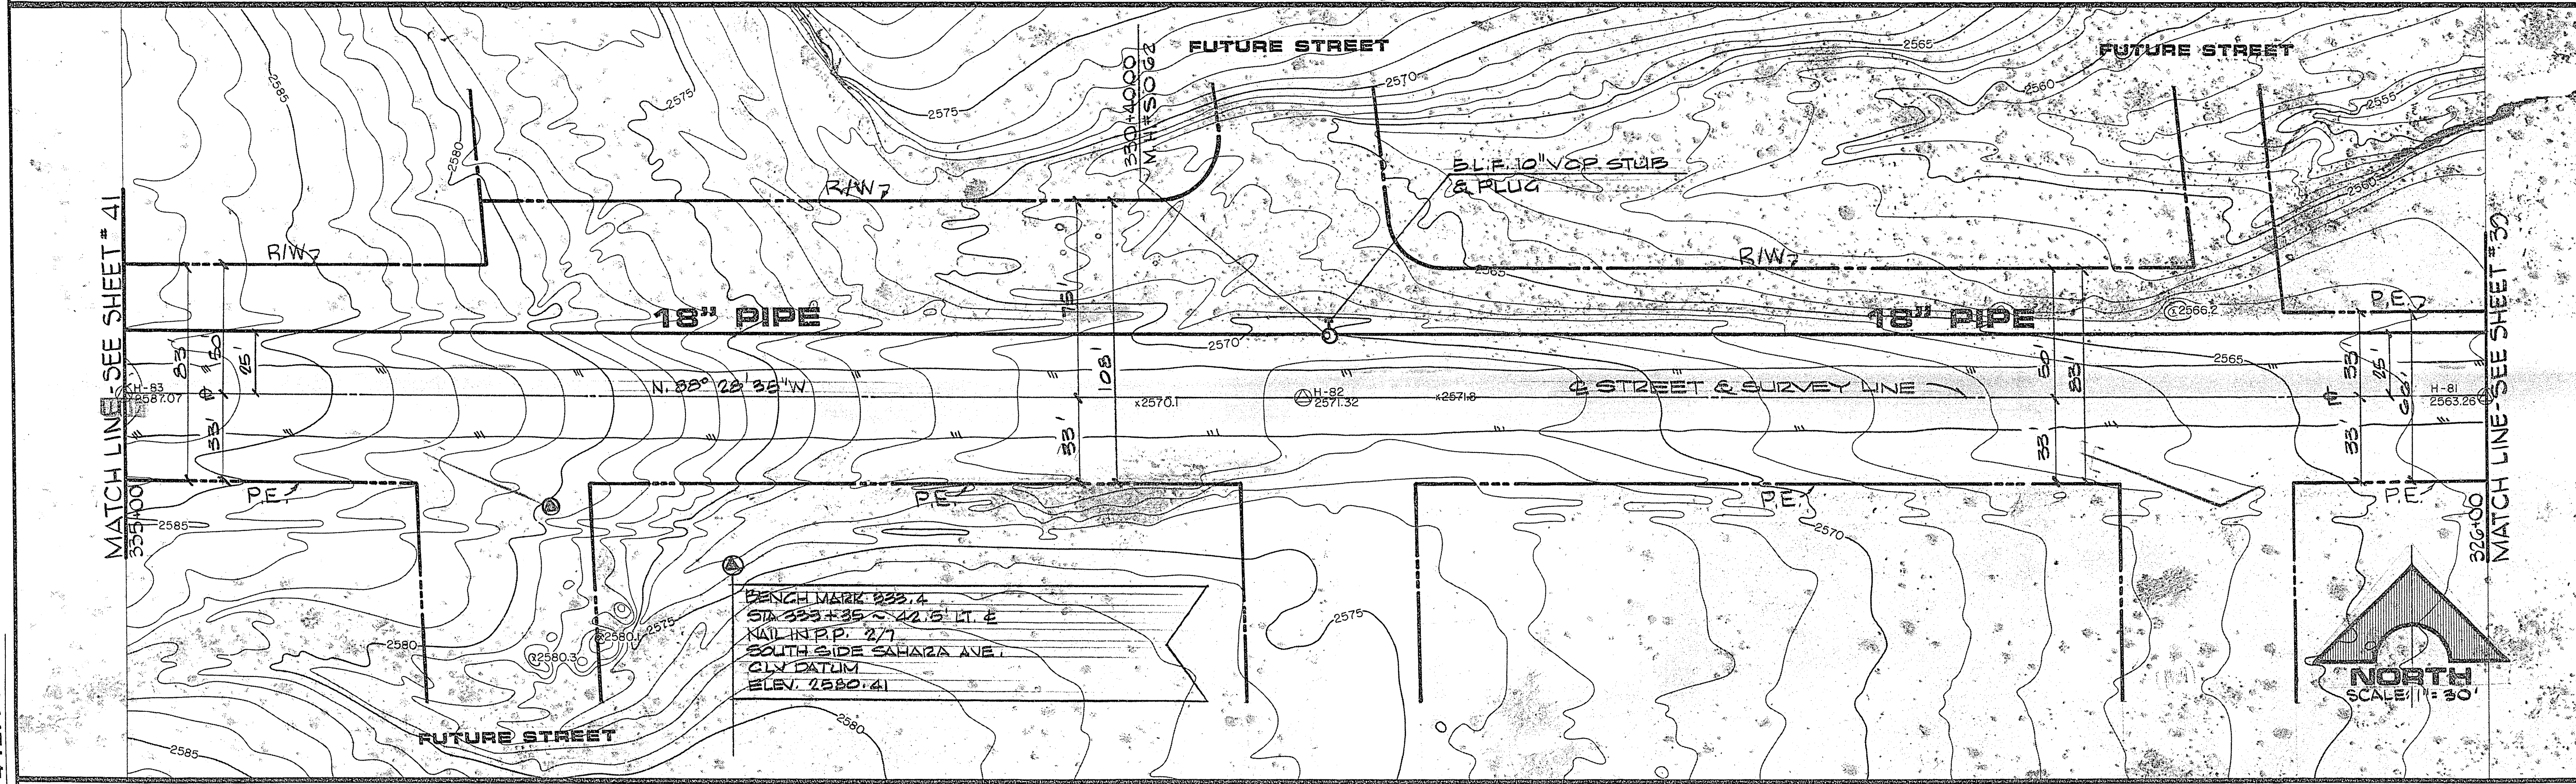


JOB NO. 412.140

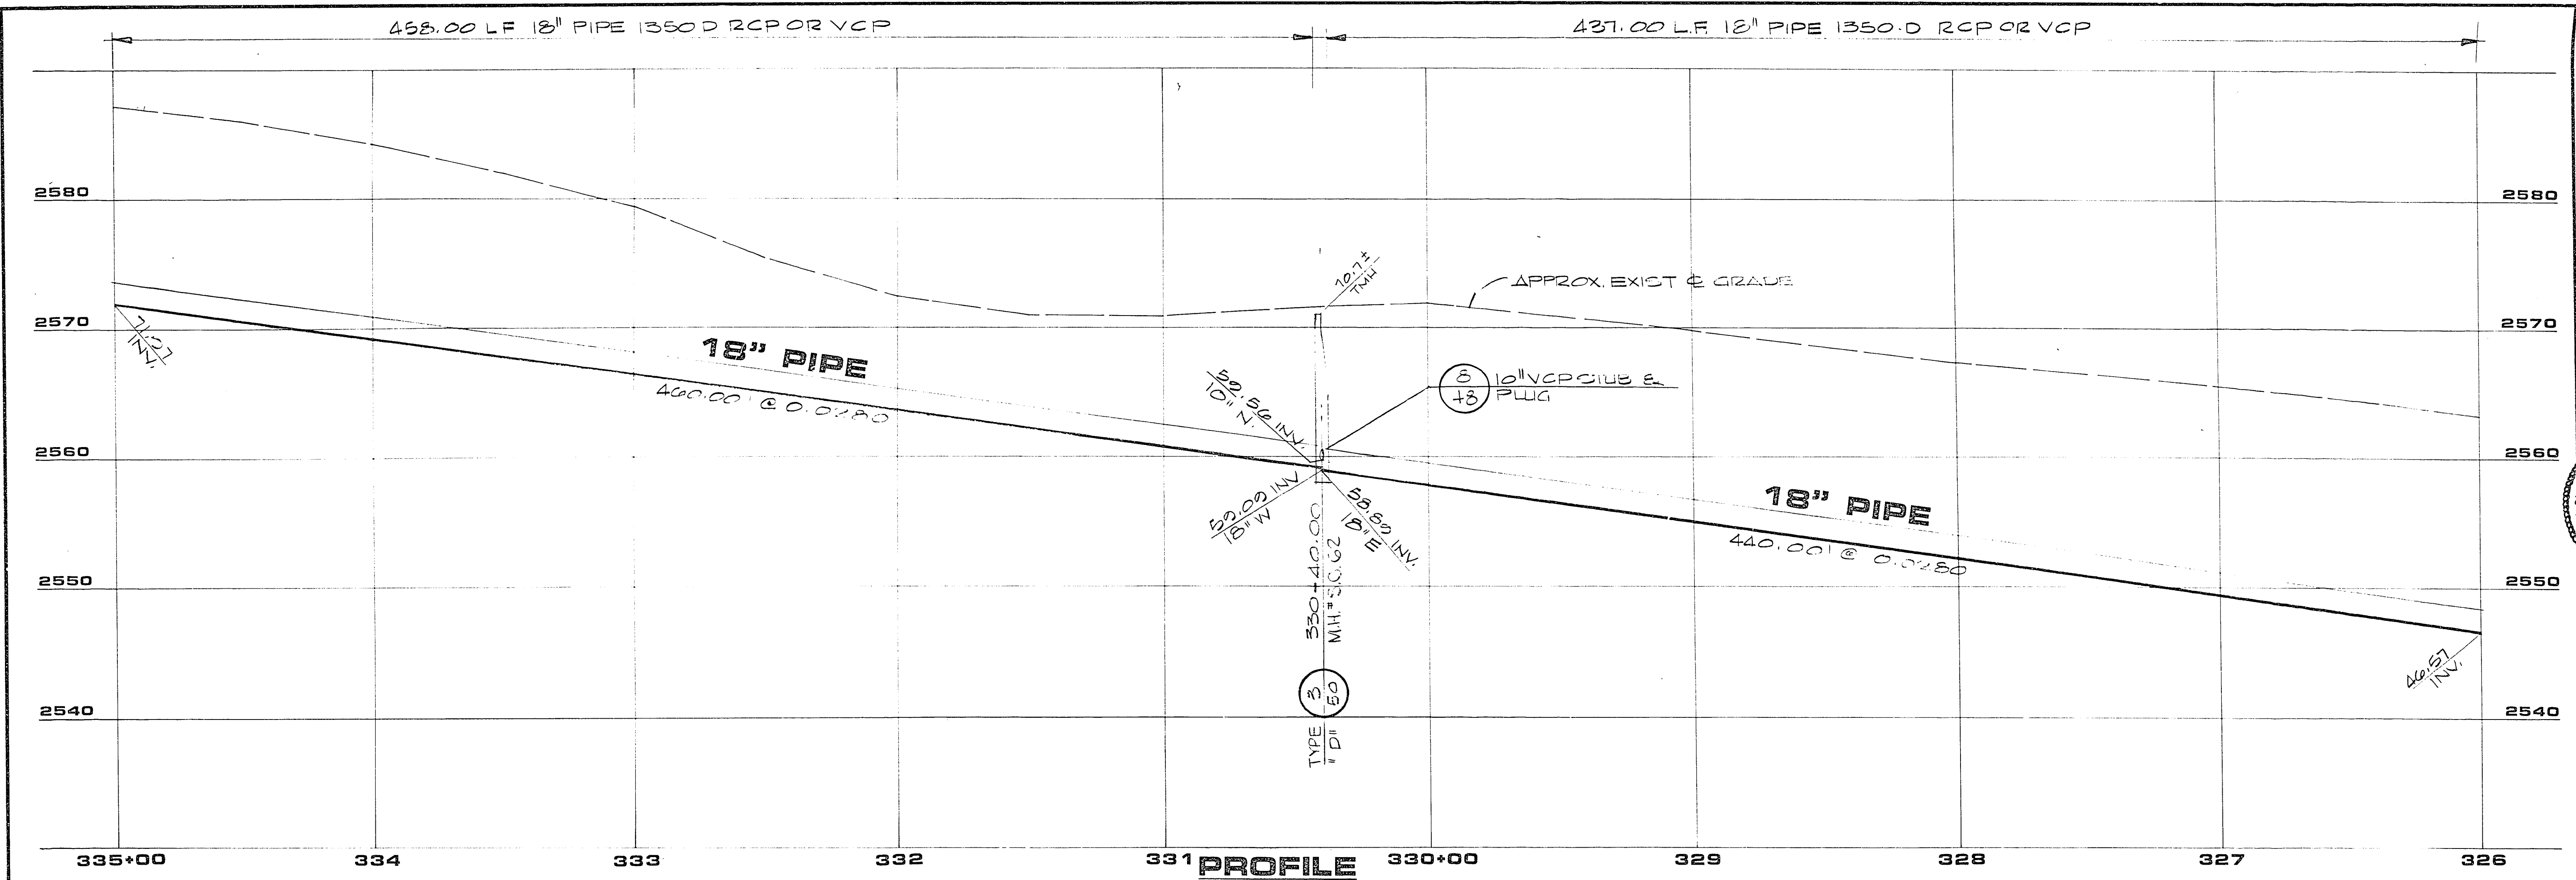

SAHARA

AVENUE

AS BUILT DRAWING

REVISIONS	
REV	DESCRIPTION
1	AS BUILT - NO REVISIONS
DATE 7/27/11	
BY R.E. NO. 430	
PROJECT: STATE OF NEVADA	
SHEET 40 OF 65 SHEETS	
G.C. WALLACE Consulting Engineers, Inc.	
1100 East Sahara Ave. • Las Vegas, Nevada 89104 • 732-3330	
Department of Public Services	
SAHARA - OAKLEY SEWER INTERCEPTOR	
PLAN & PROFILE 326+00 TO 335+00	
SHEET 40	

307-V 563

25-1-116