
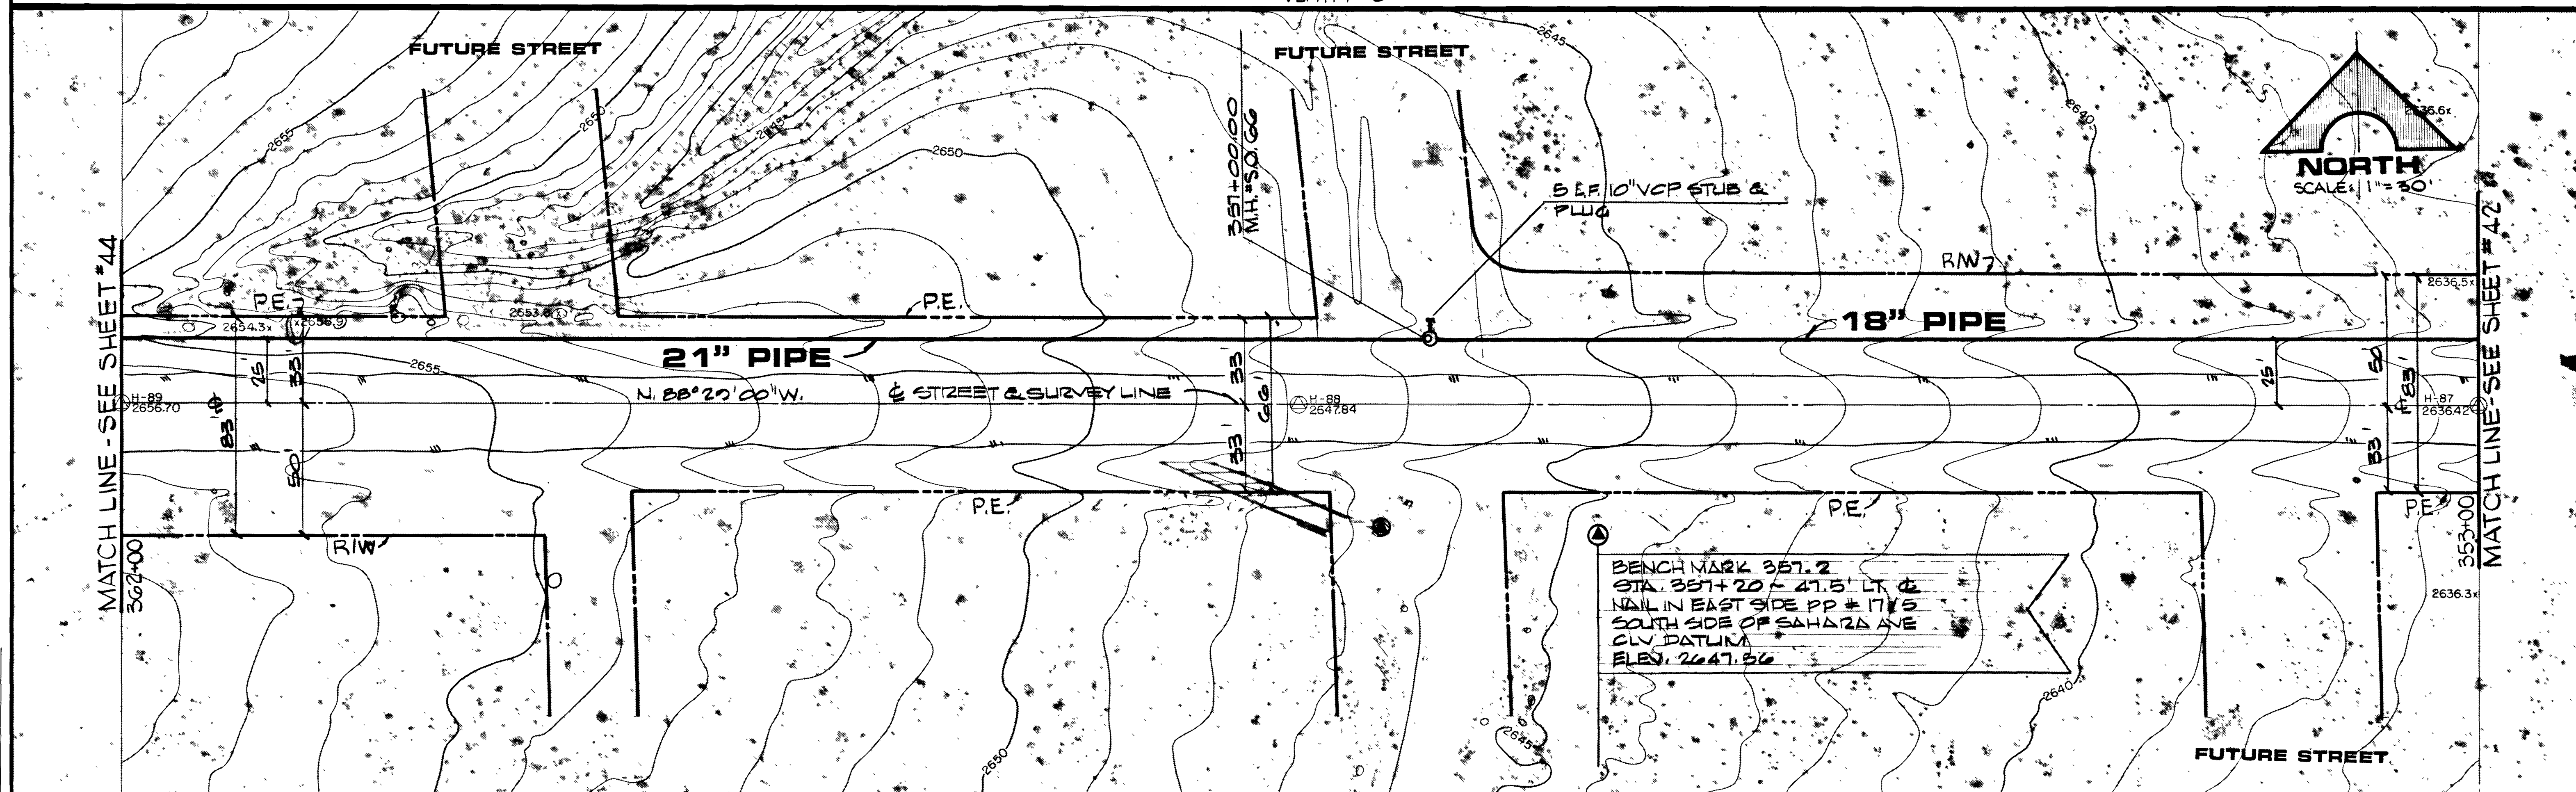


JOB NO. 412.140

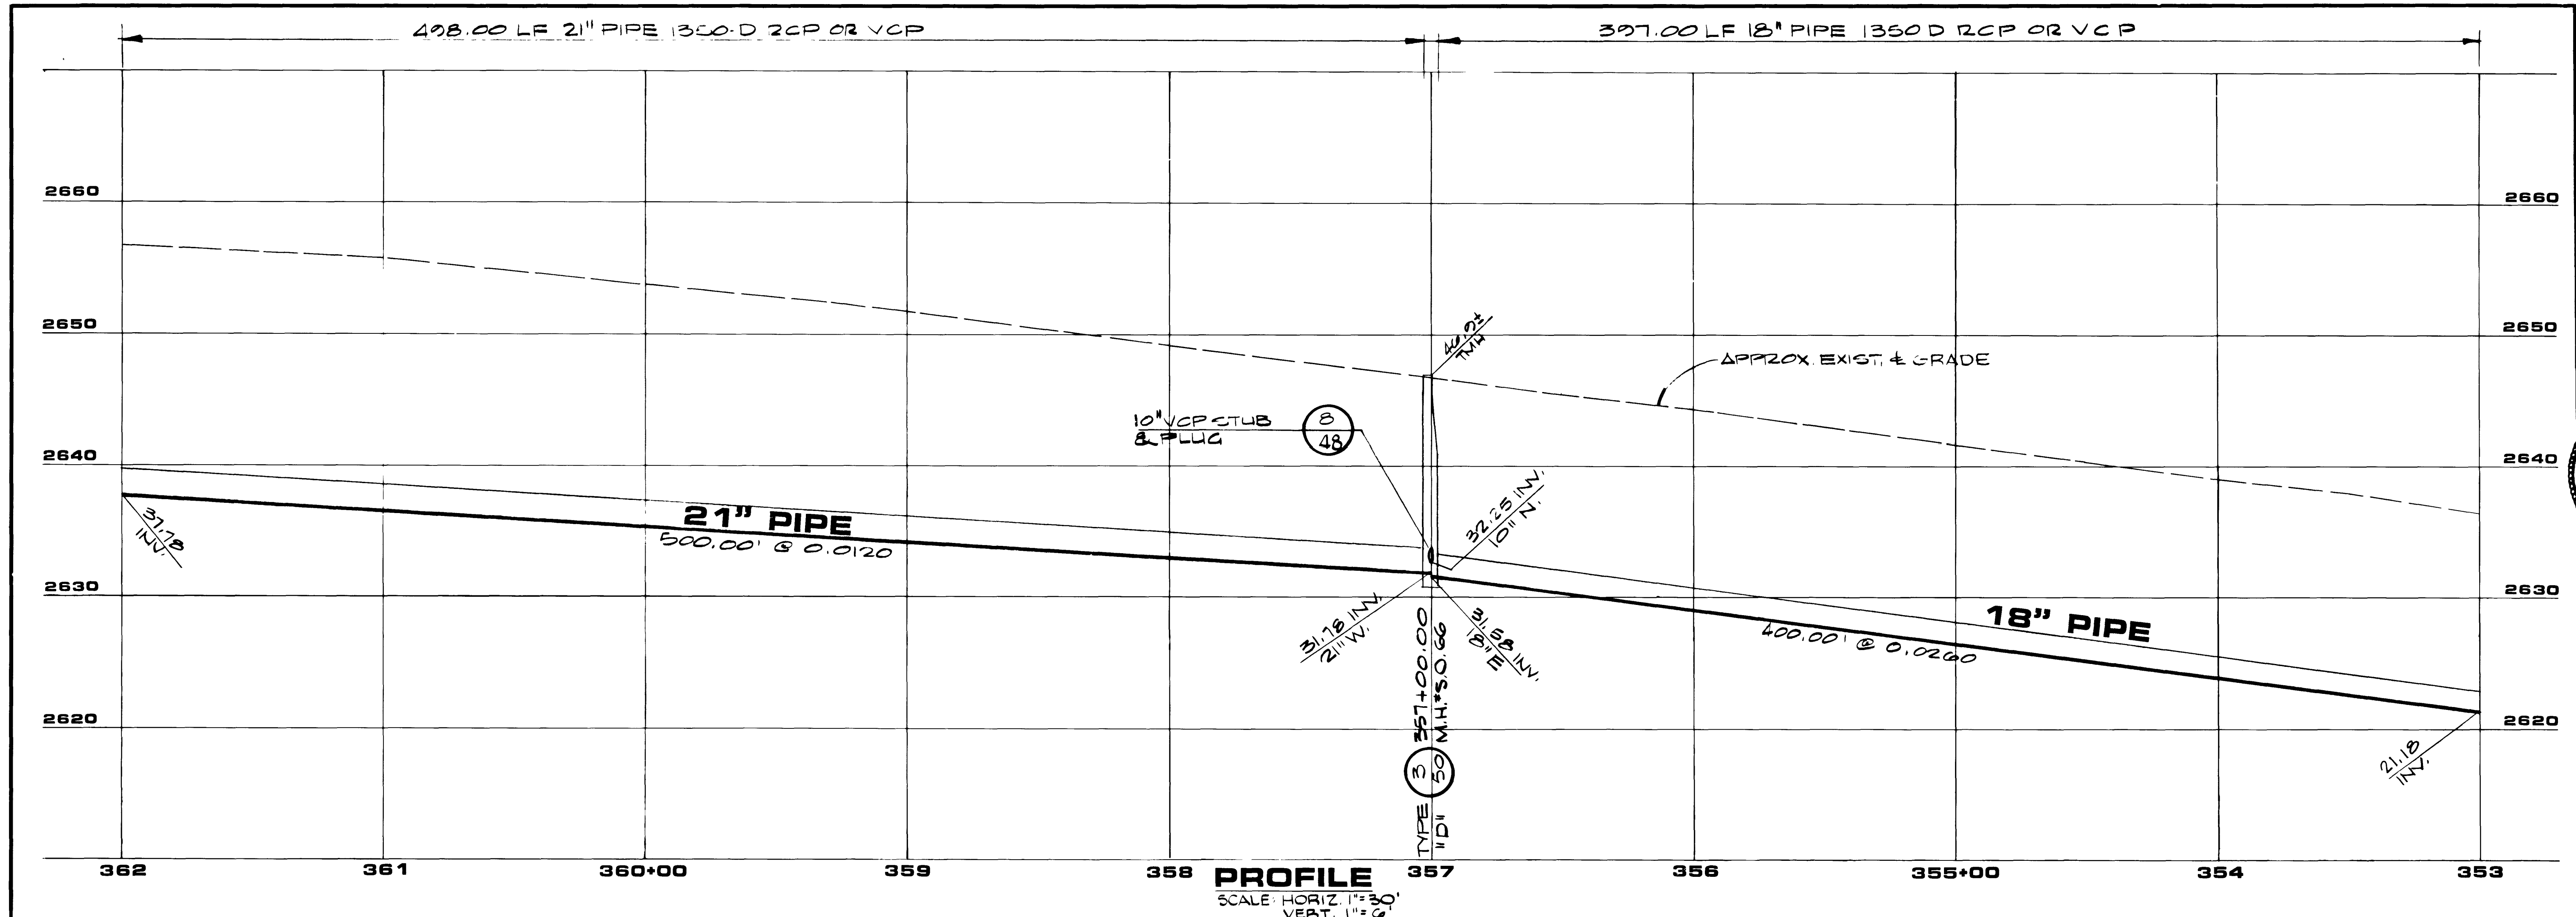

SAHARA

AVENUE


AS BUILT DRAWING

307-V 563

SHEET
43
OF 65 SHEETS

Department of Public Services
SAHARA - OAKLEY SEWER INTERCEPTOR
PLAN & PROFILE 353+00 TO 362+00

G.C. WALLACE
Consulting Engineers, Inc.
1100 East Sahara Ave. Las Vegas, Nevada 89104 - 732-3330

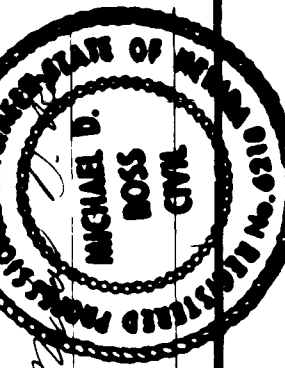

REV	DATE	DESCRIPTION
1	10/1/88	AS BUILT - 10 REVISIONS

