
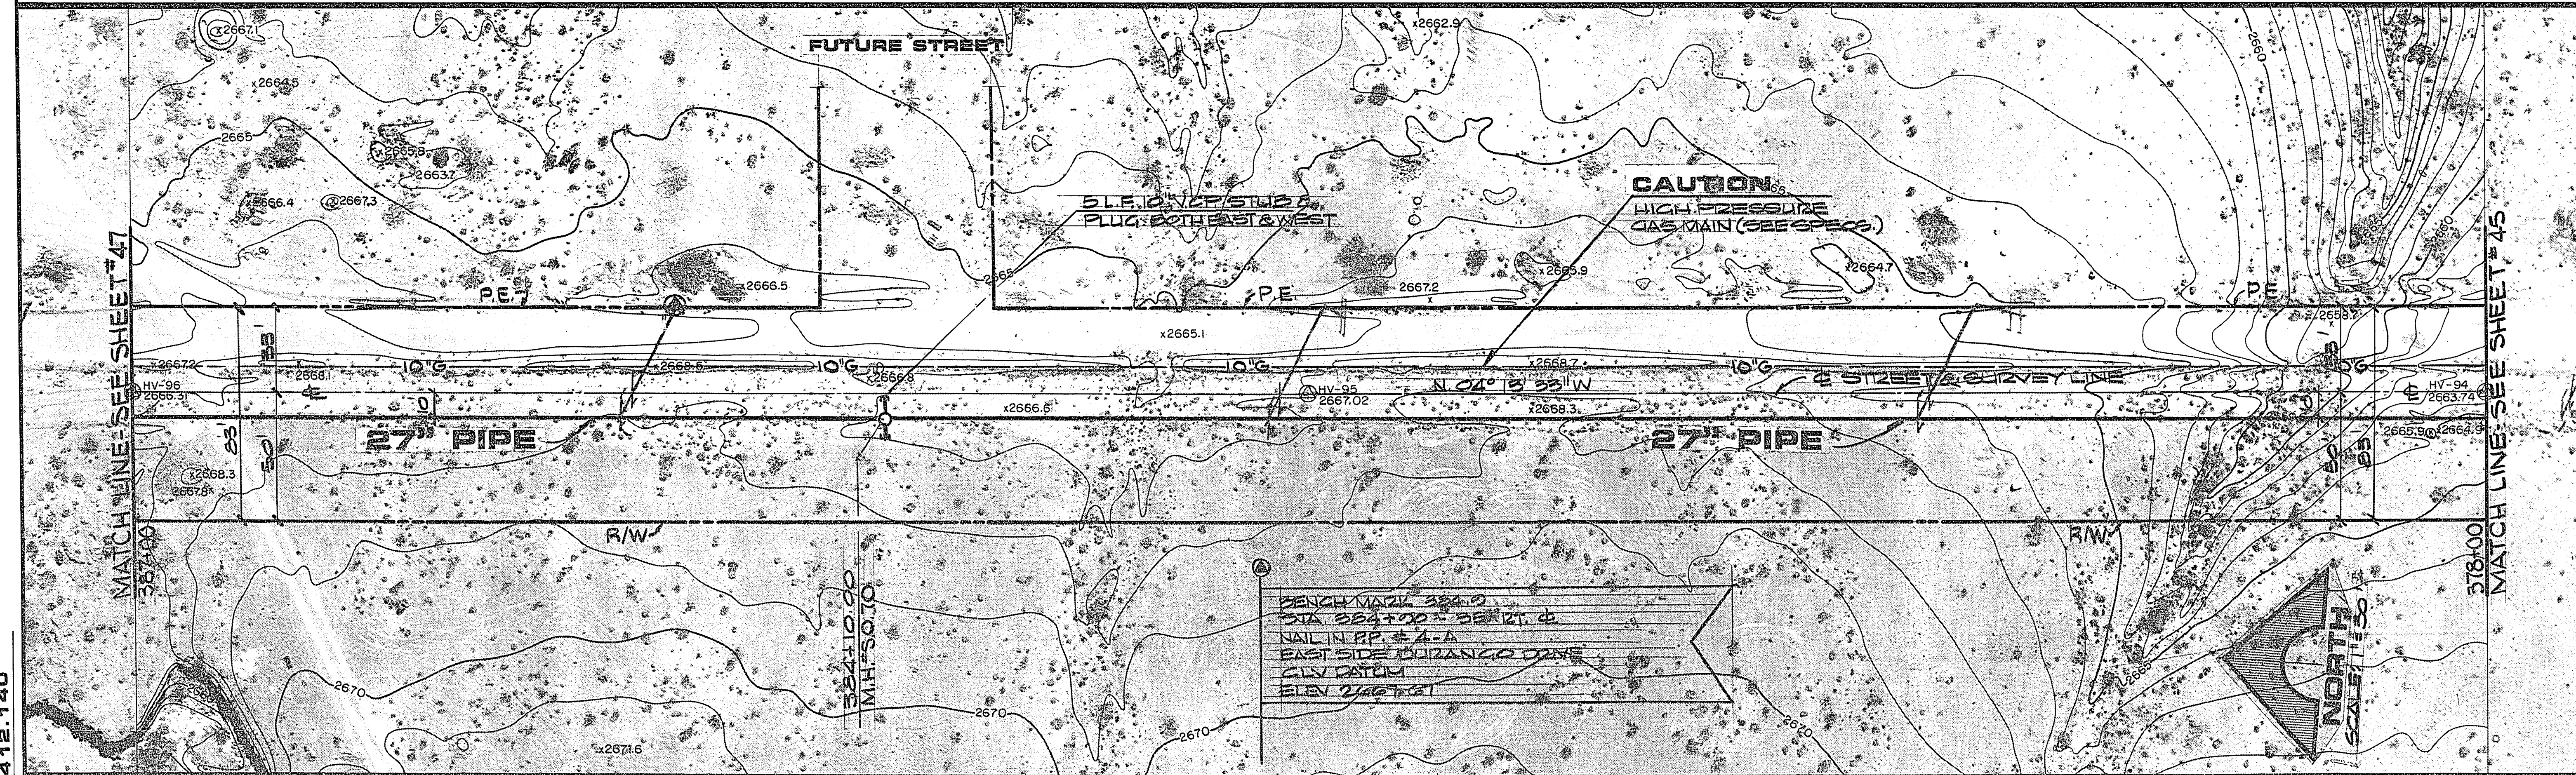


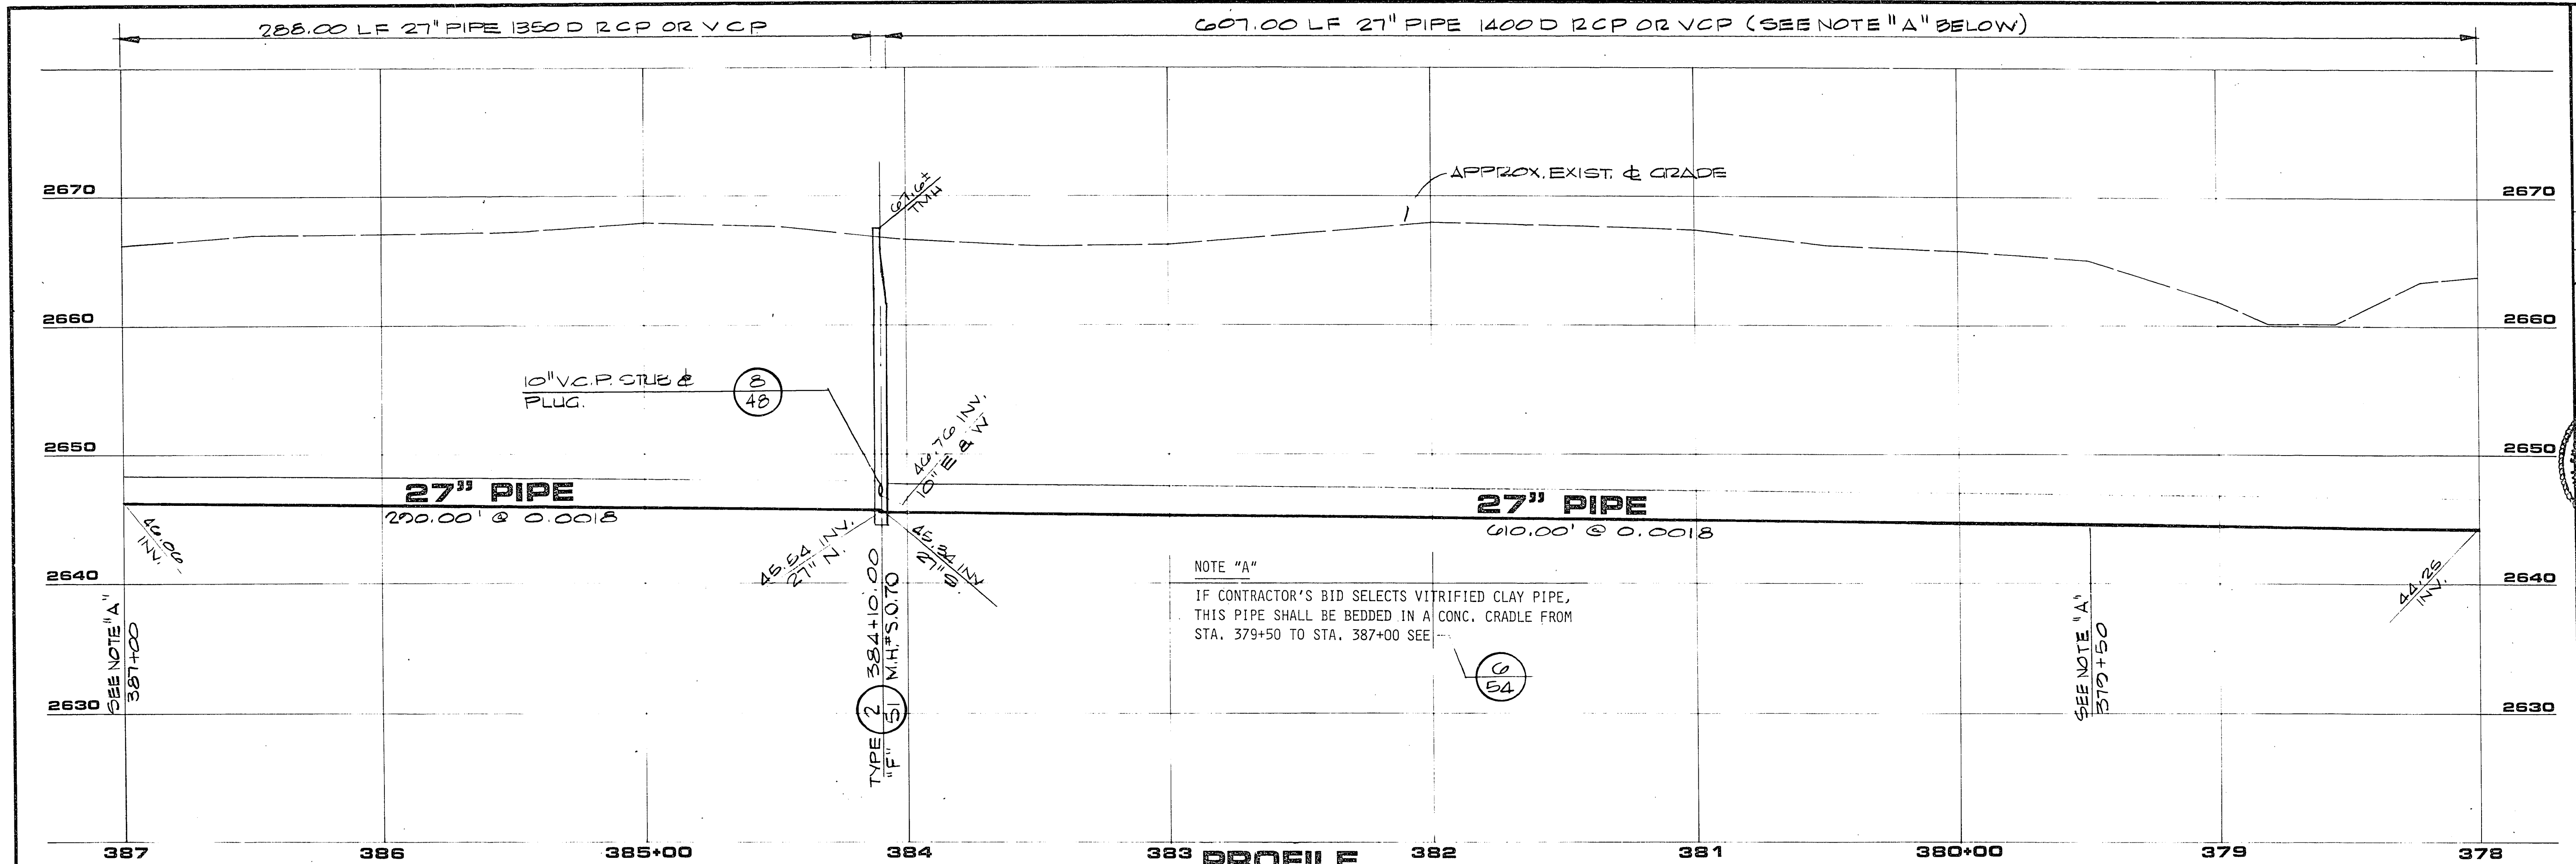

DURANGO

DRIVE

AS BUILT DRAWING

RECOMMENDED FOR THE STATE OF NEVADA	
REVISION	DATE
1	4/19/88
AS BUILT - NO REVISIONS	
G. C. WALLACE Consulting Engineers, Inc. 1100 East Sahara Ave. • Las Vegas, Nevada 89104 • 732-3330	
Department of Public Services SAHARA - OAKLEY SEWER INTERCEPTOR PLAN & PROFILE 378+00 TO 387+00	
SHEET 46 OF 65 SHEETS	