




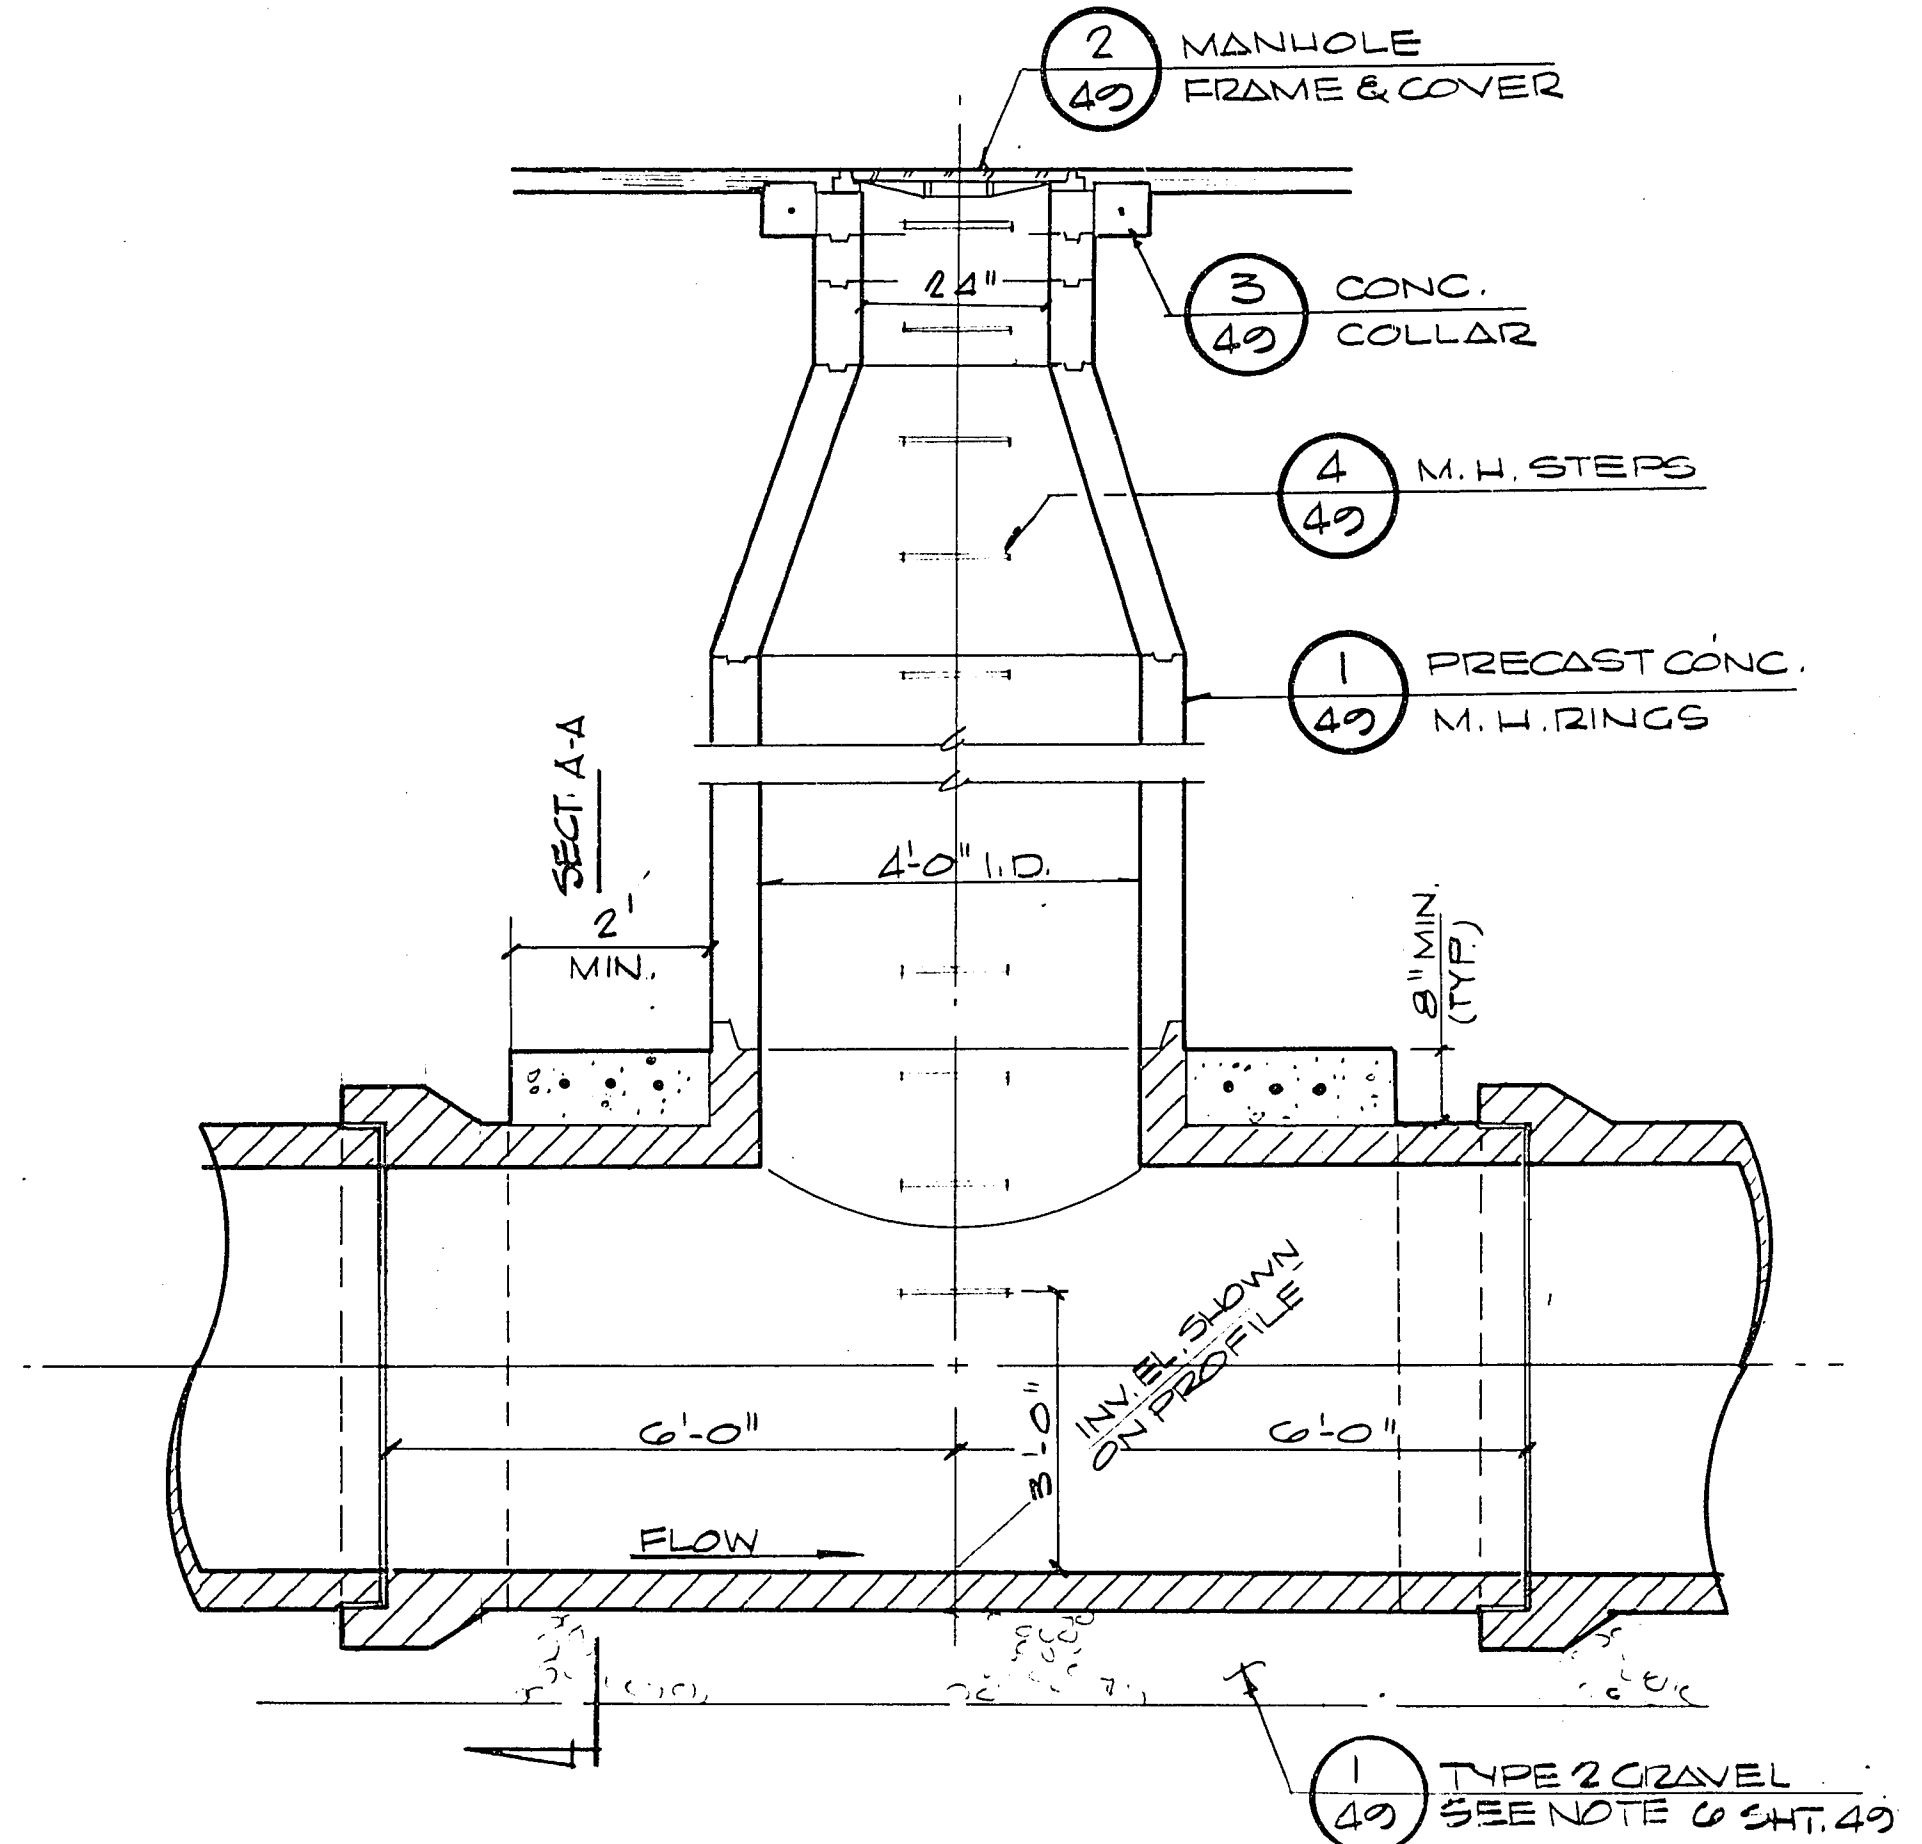


SECTION

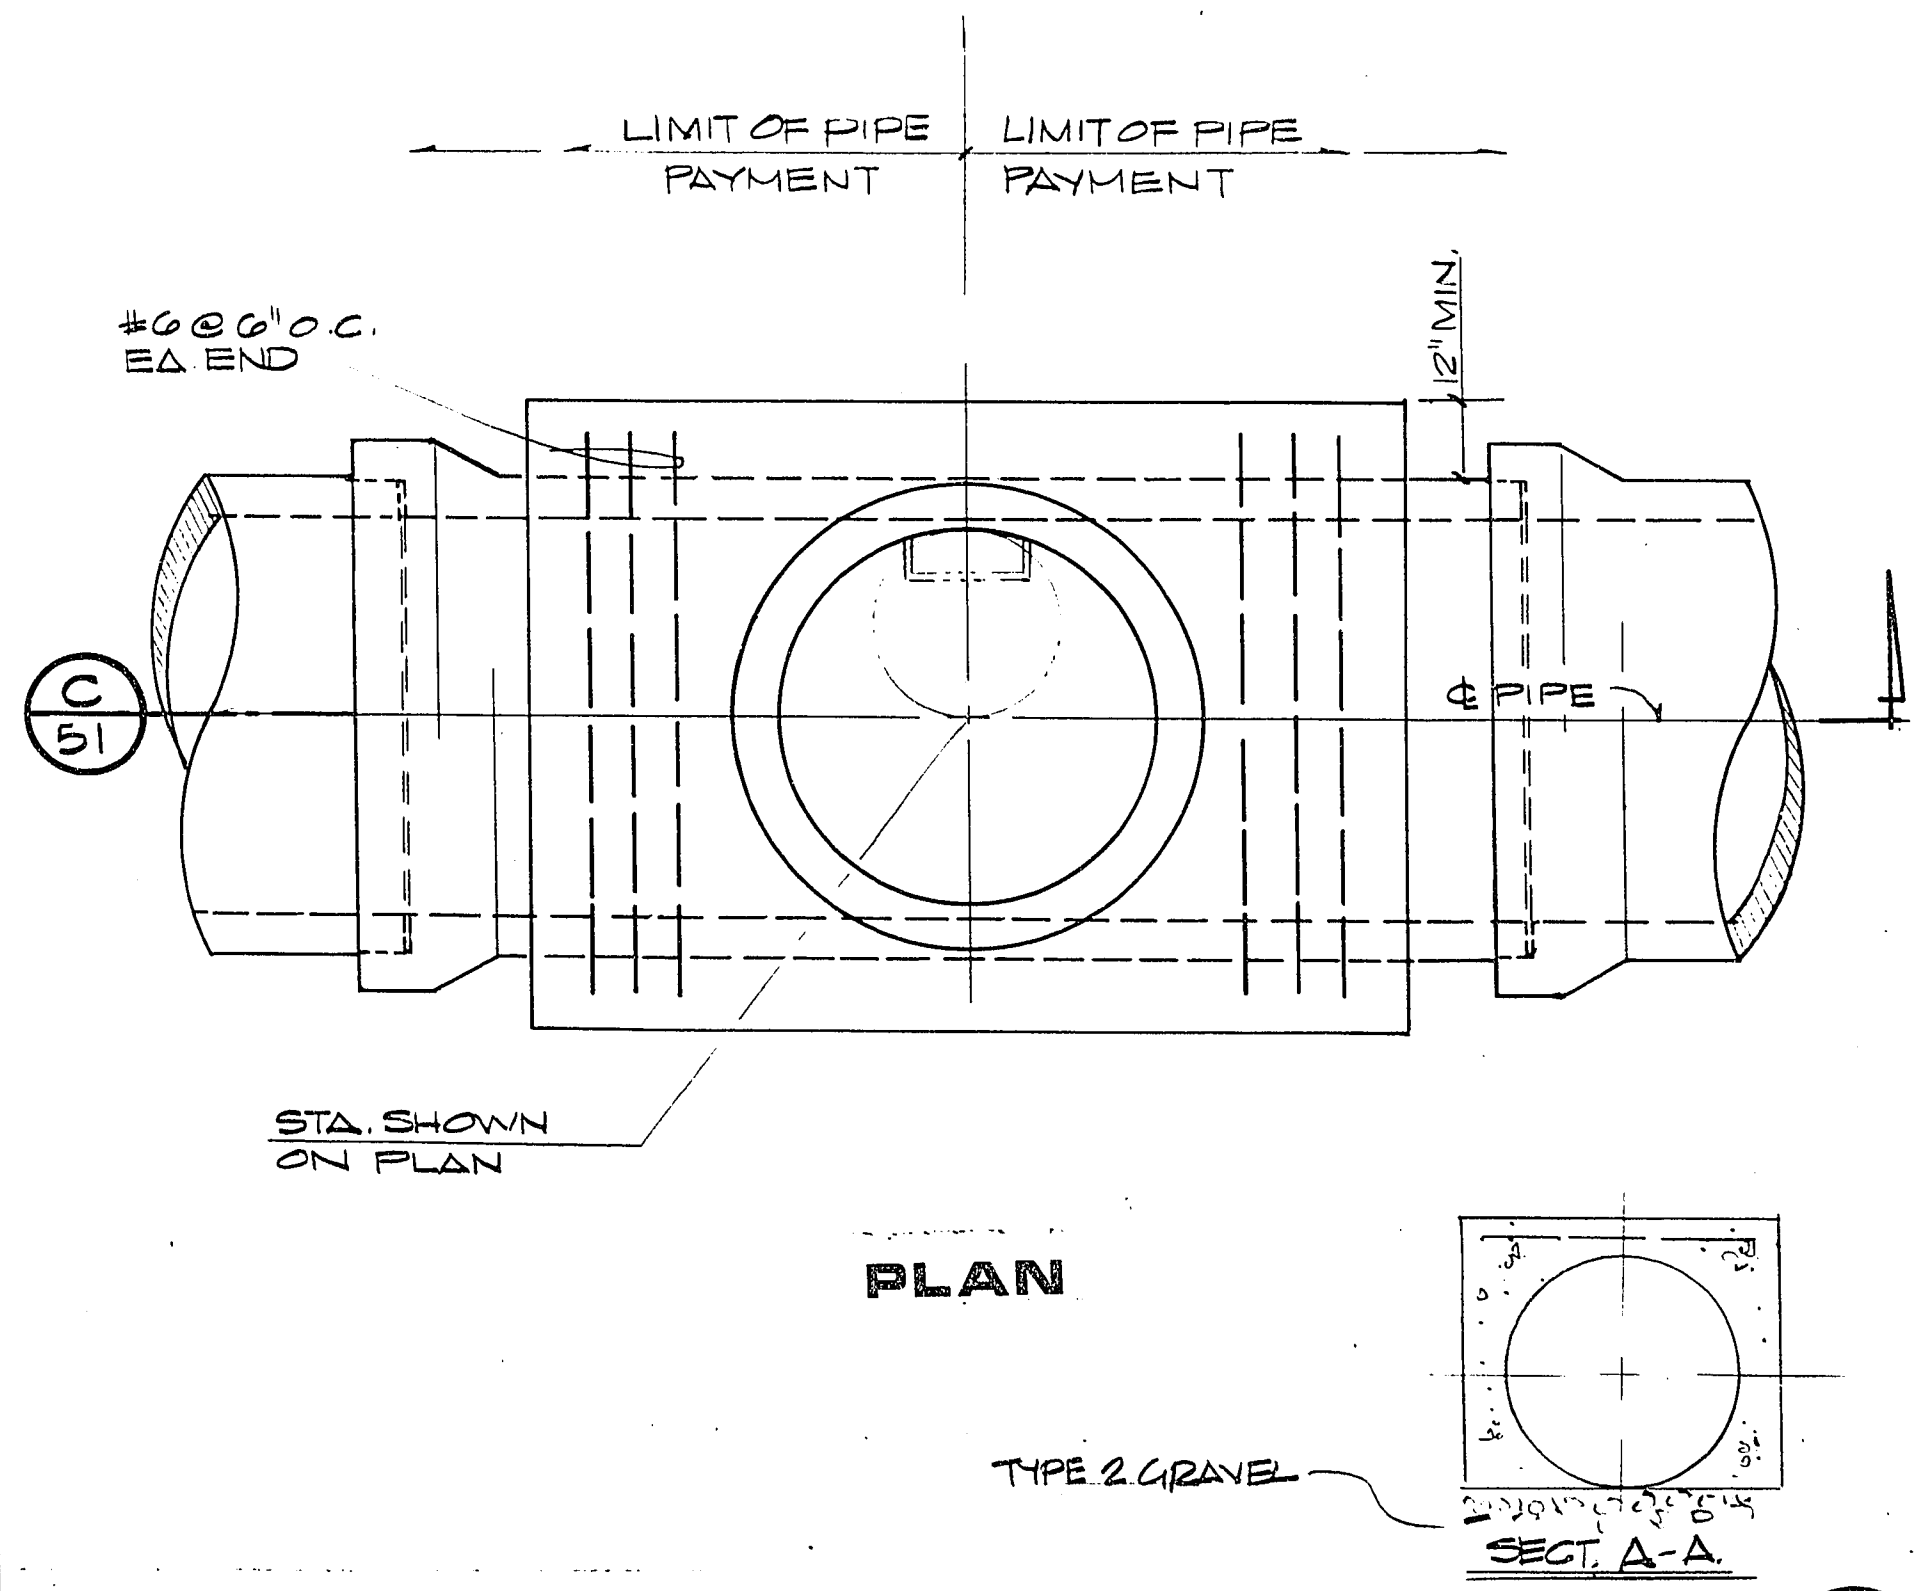


"G" TYPE MANHOLE
M.H. # S.O. 1

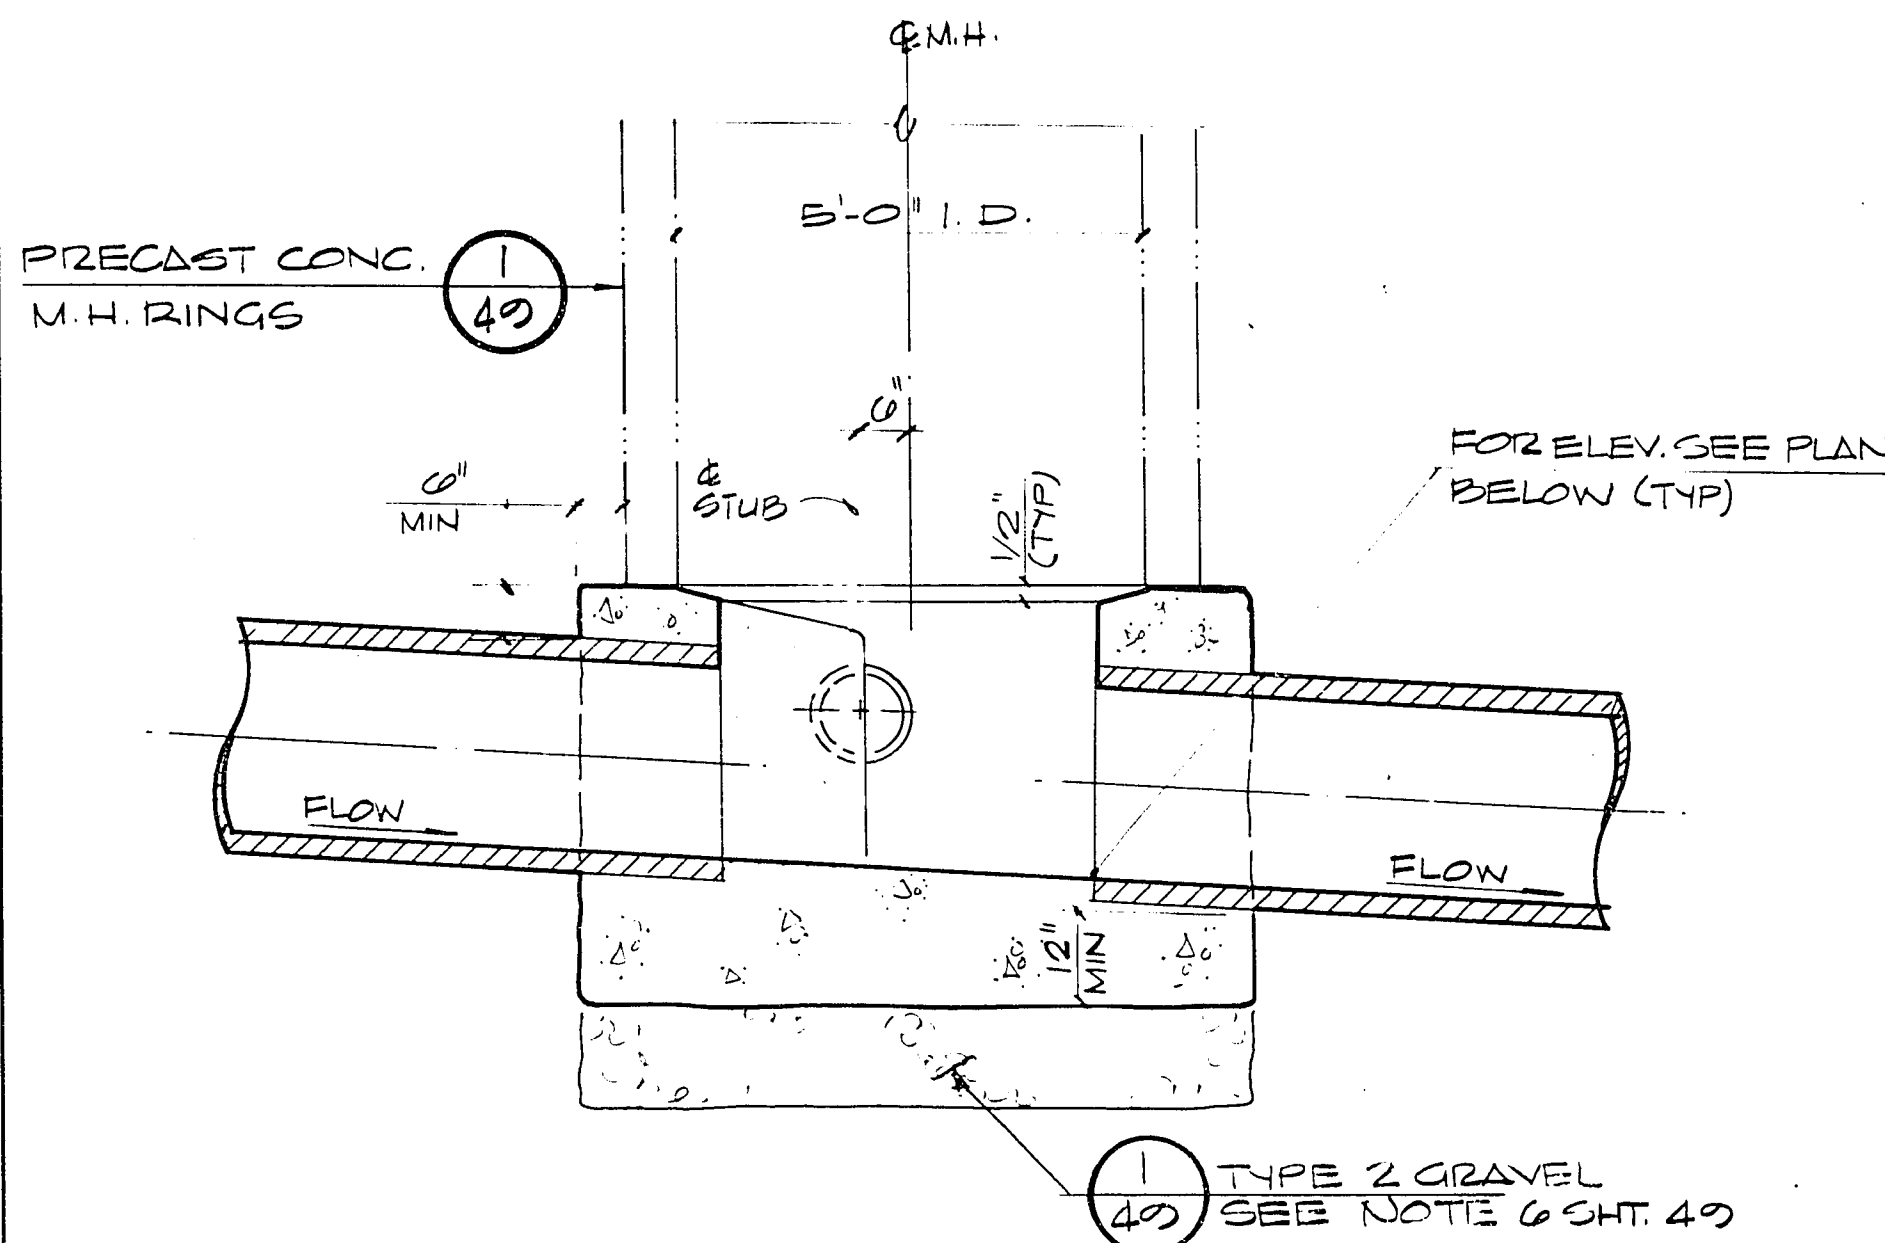


SECTION

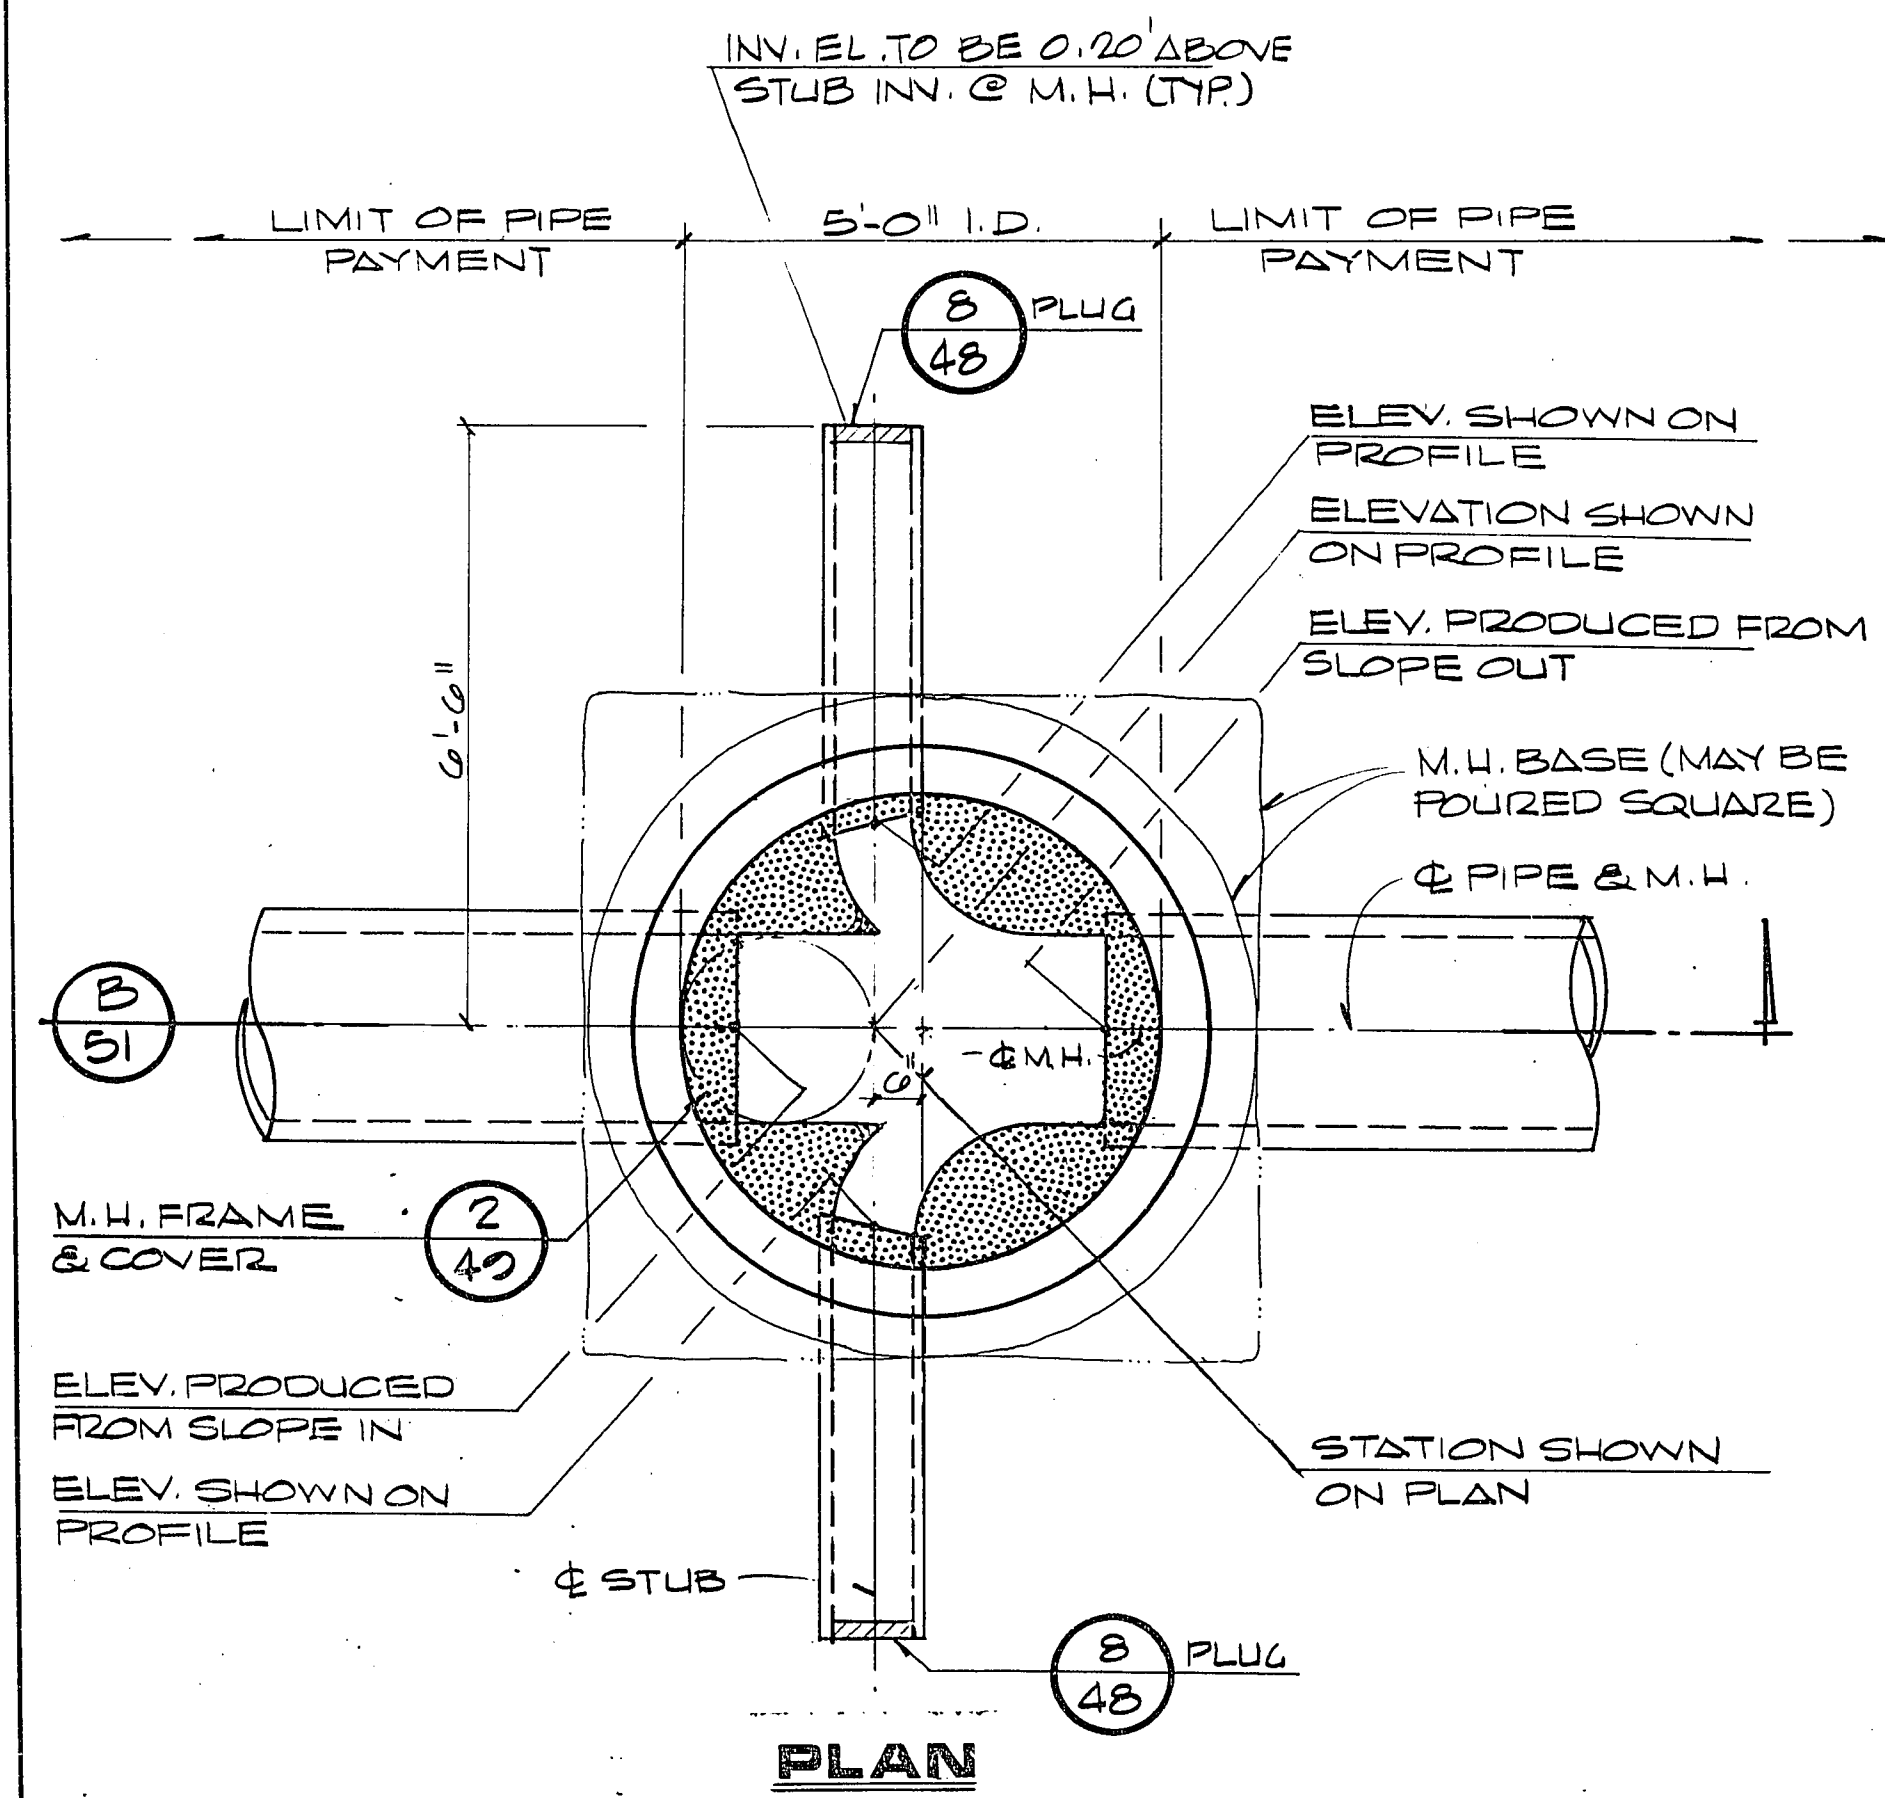

"F" TYPE MANHOLE
M.H. # S.O. 26, 28, 32, 33, 34, 51, 53, 63, 68, 69, 470

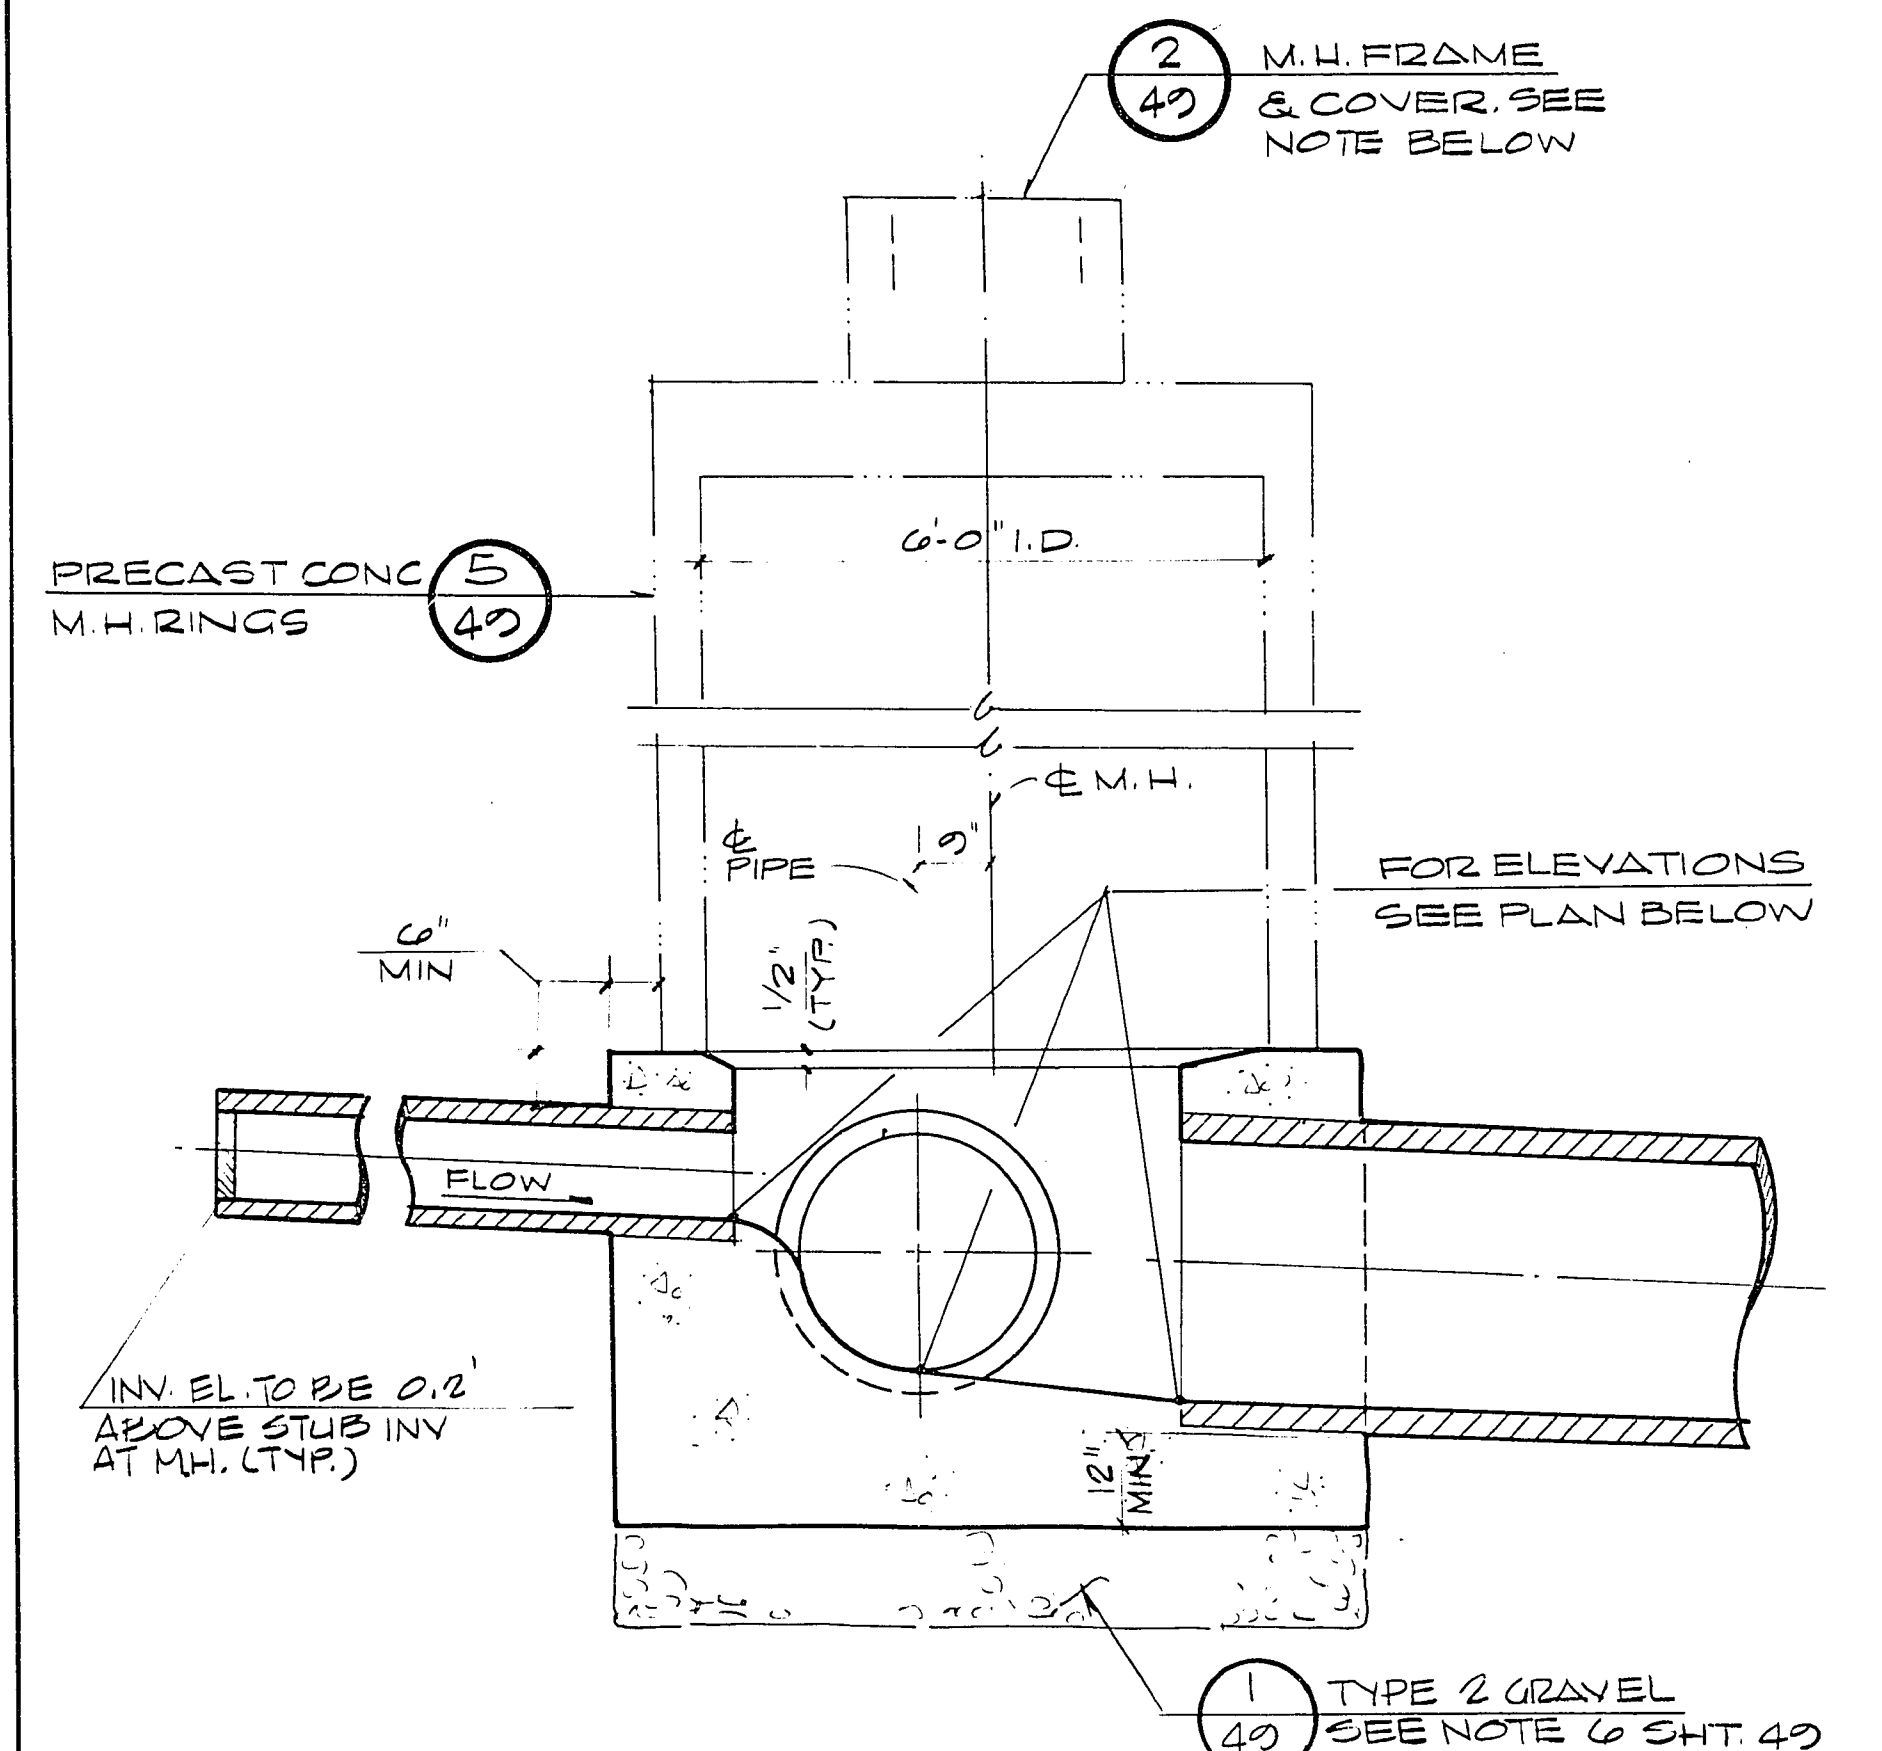

SECTION

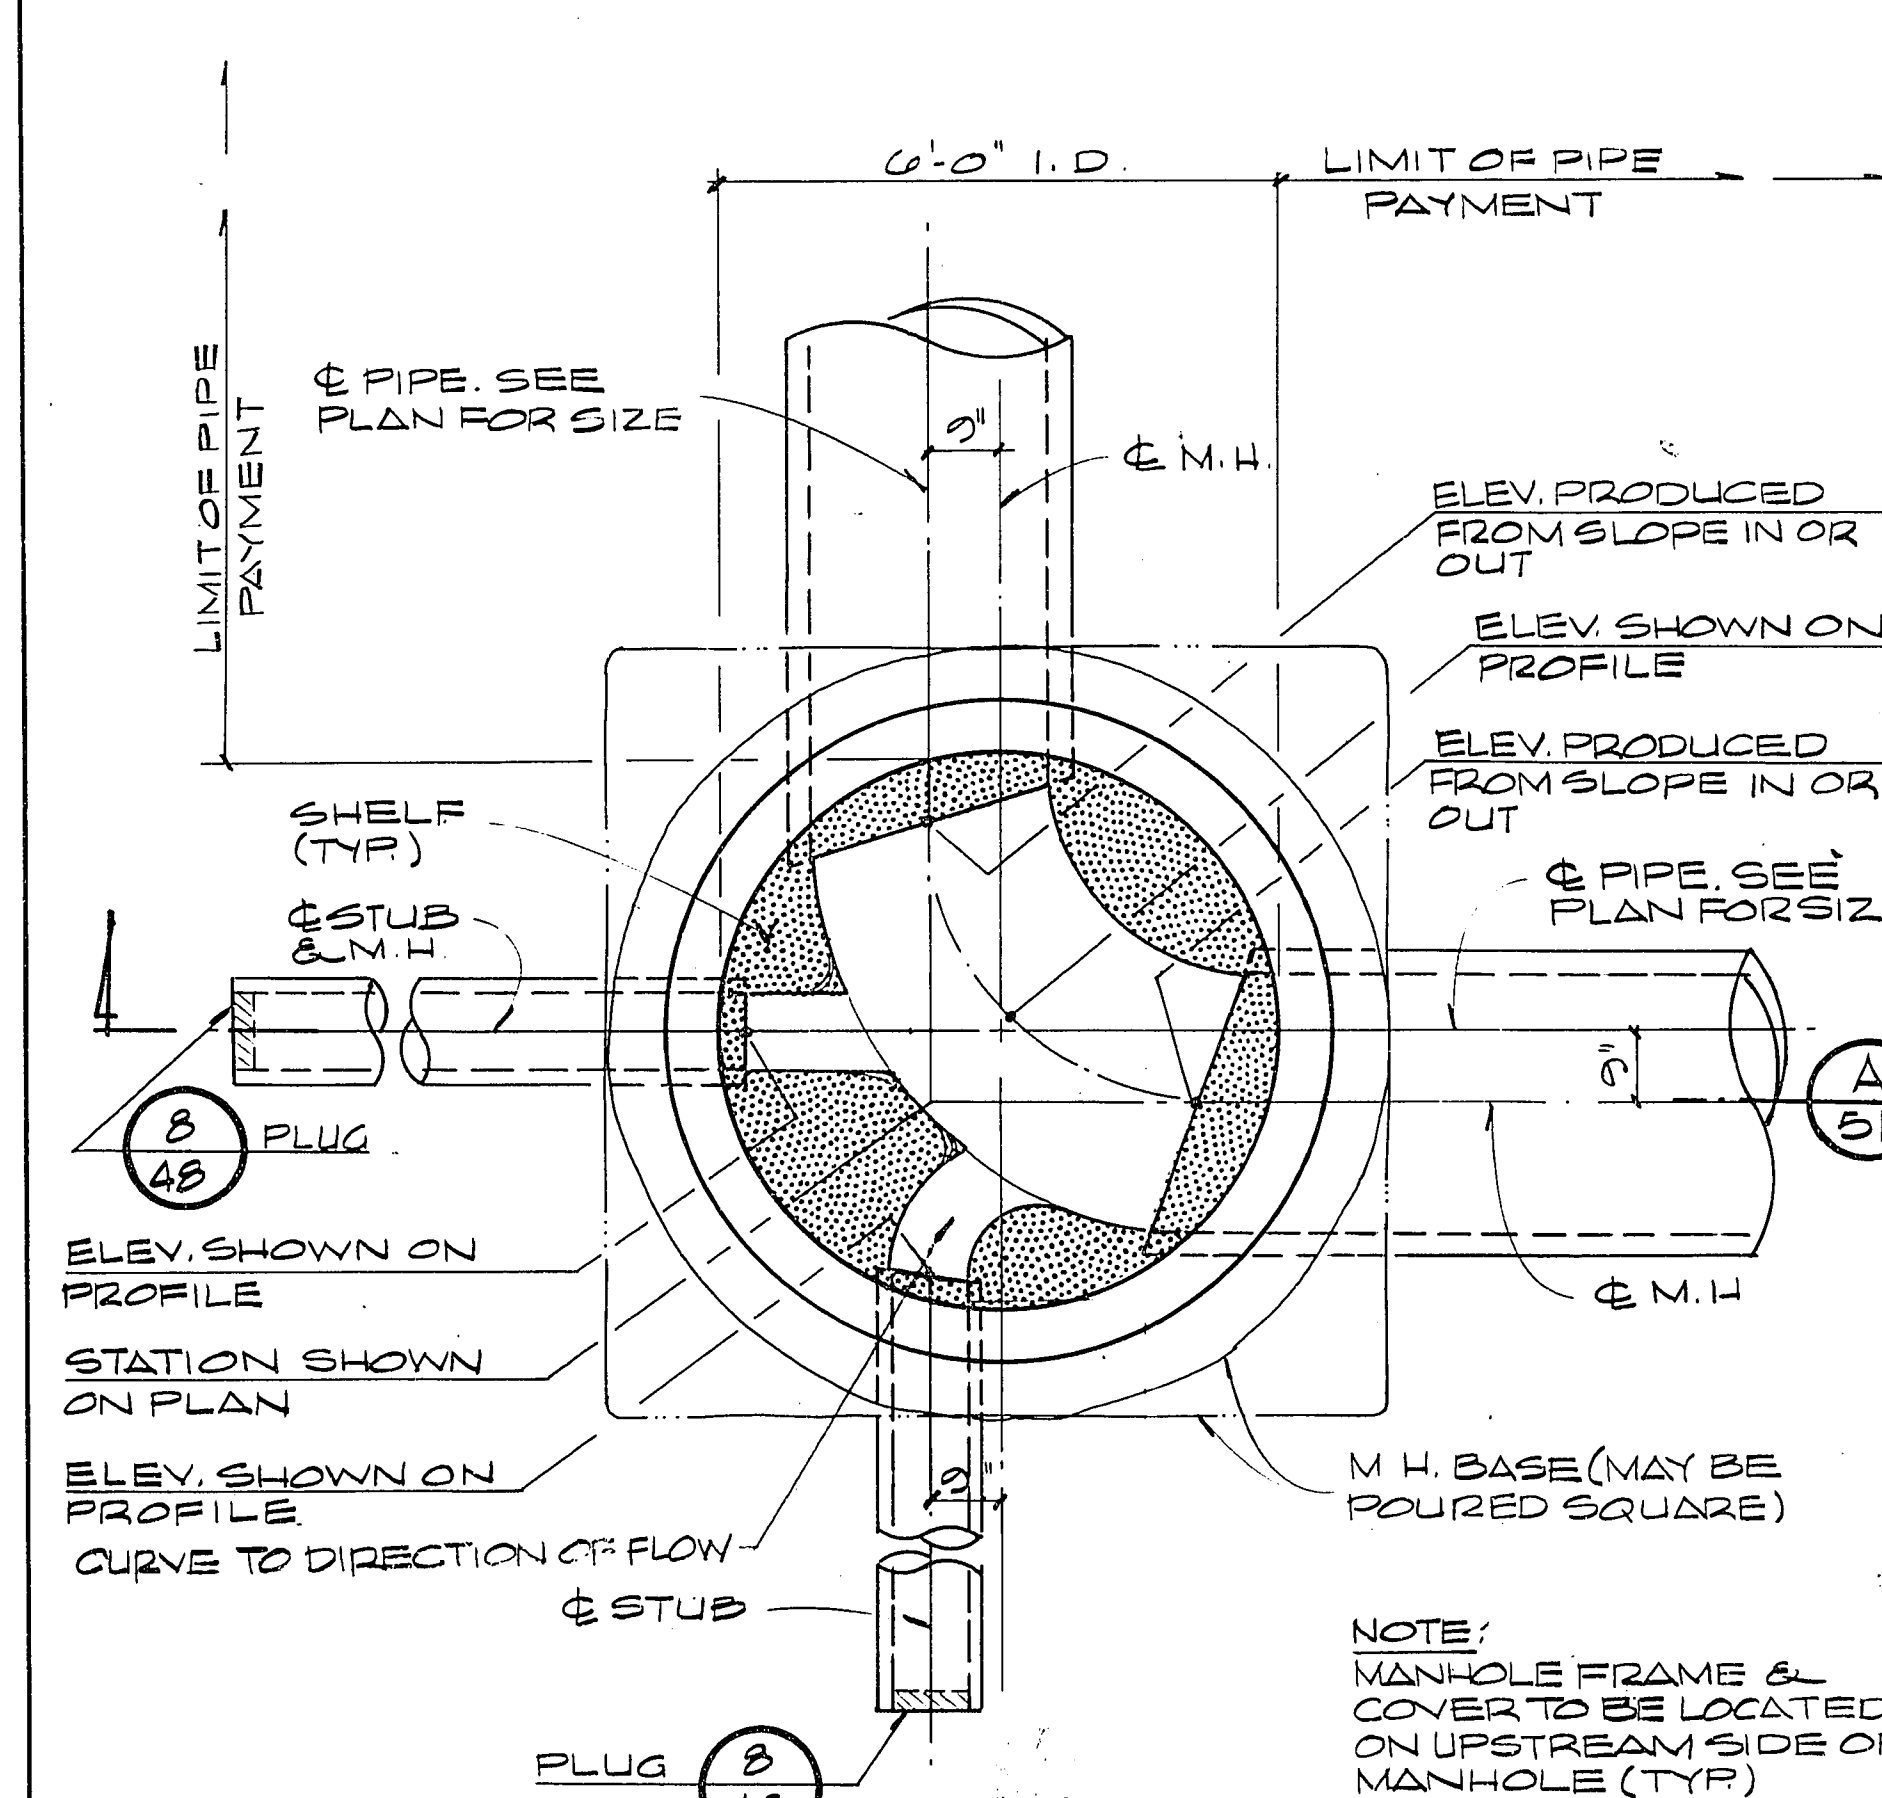

"E" TYPE MANHOLE
M.H. # S.O. 25, 27, & 43

REV	DATE	DESCRIPTION
1	10/15/84	AS BUILT - NO REVISIONS

REVISION	DATE	DESCRIPTION
1	10/15/84	AS BUILT - NO REVISIONS

G.C. WALLACE
Consulting Engineers, Inc.
1100 East Sahara Ave. • Las Vegas, Nevada 89104 • 732-3330

Department of Public Services
SAHARA - OAKY SEWER INTERCEPTOR
MANHOLE TYPES "E", "F", & "G"
DETAILS

SHEET
51
OF 65 SHEETS