



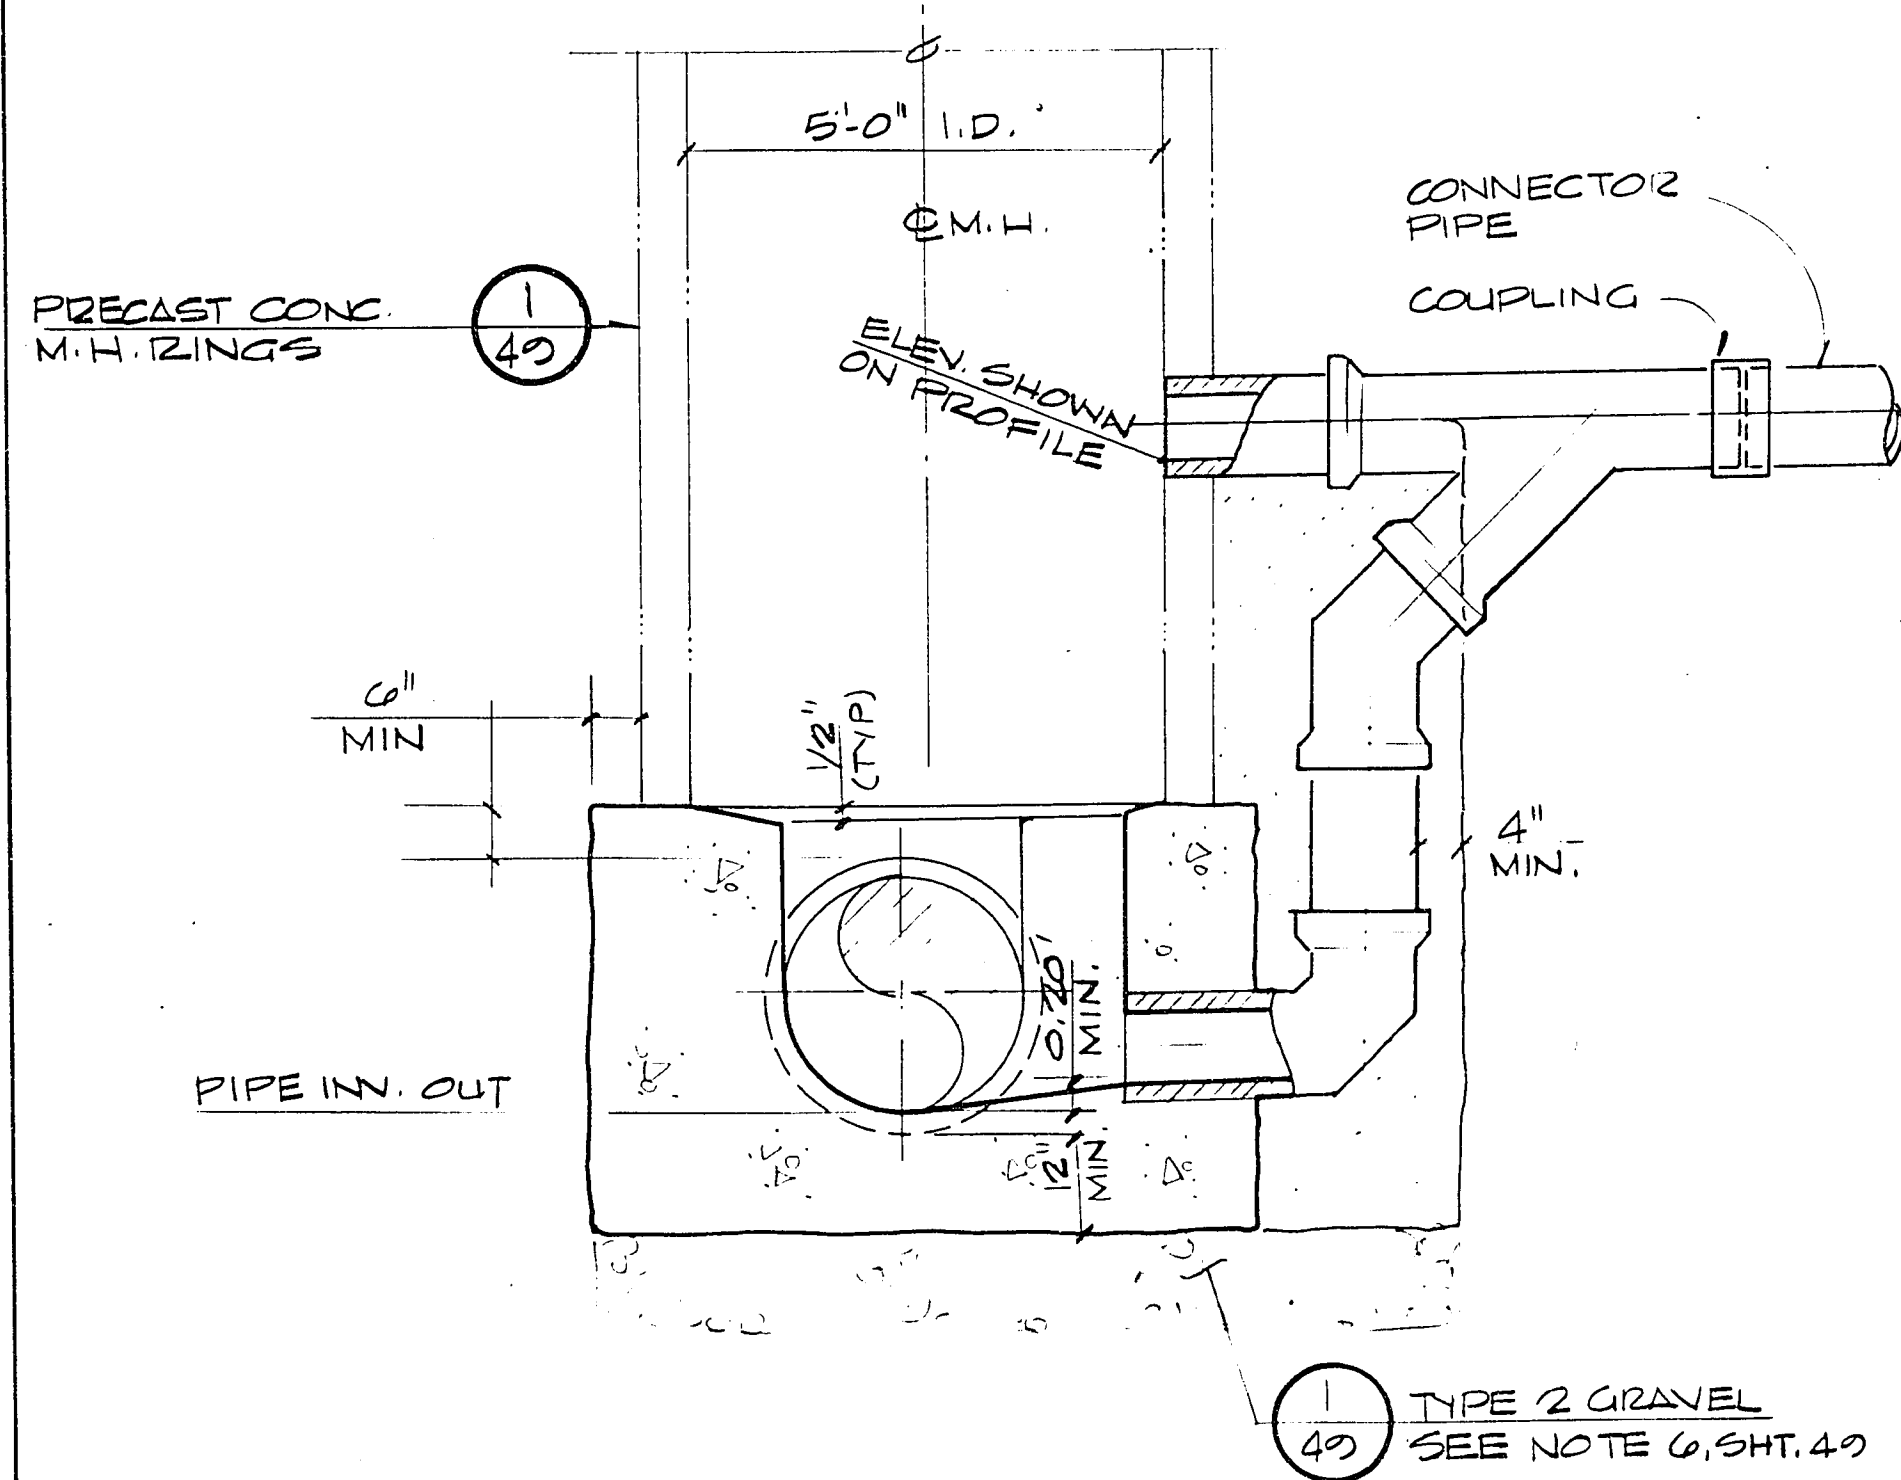


SECTION

C
52

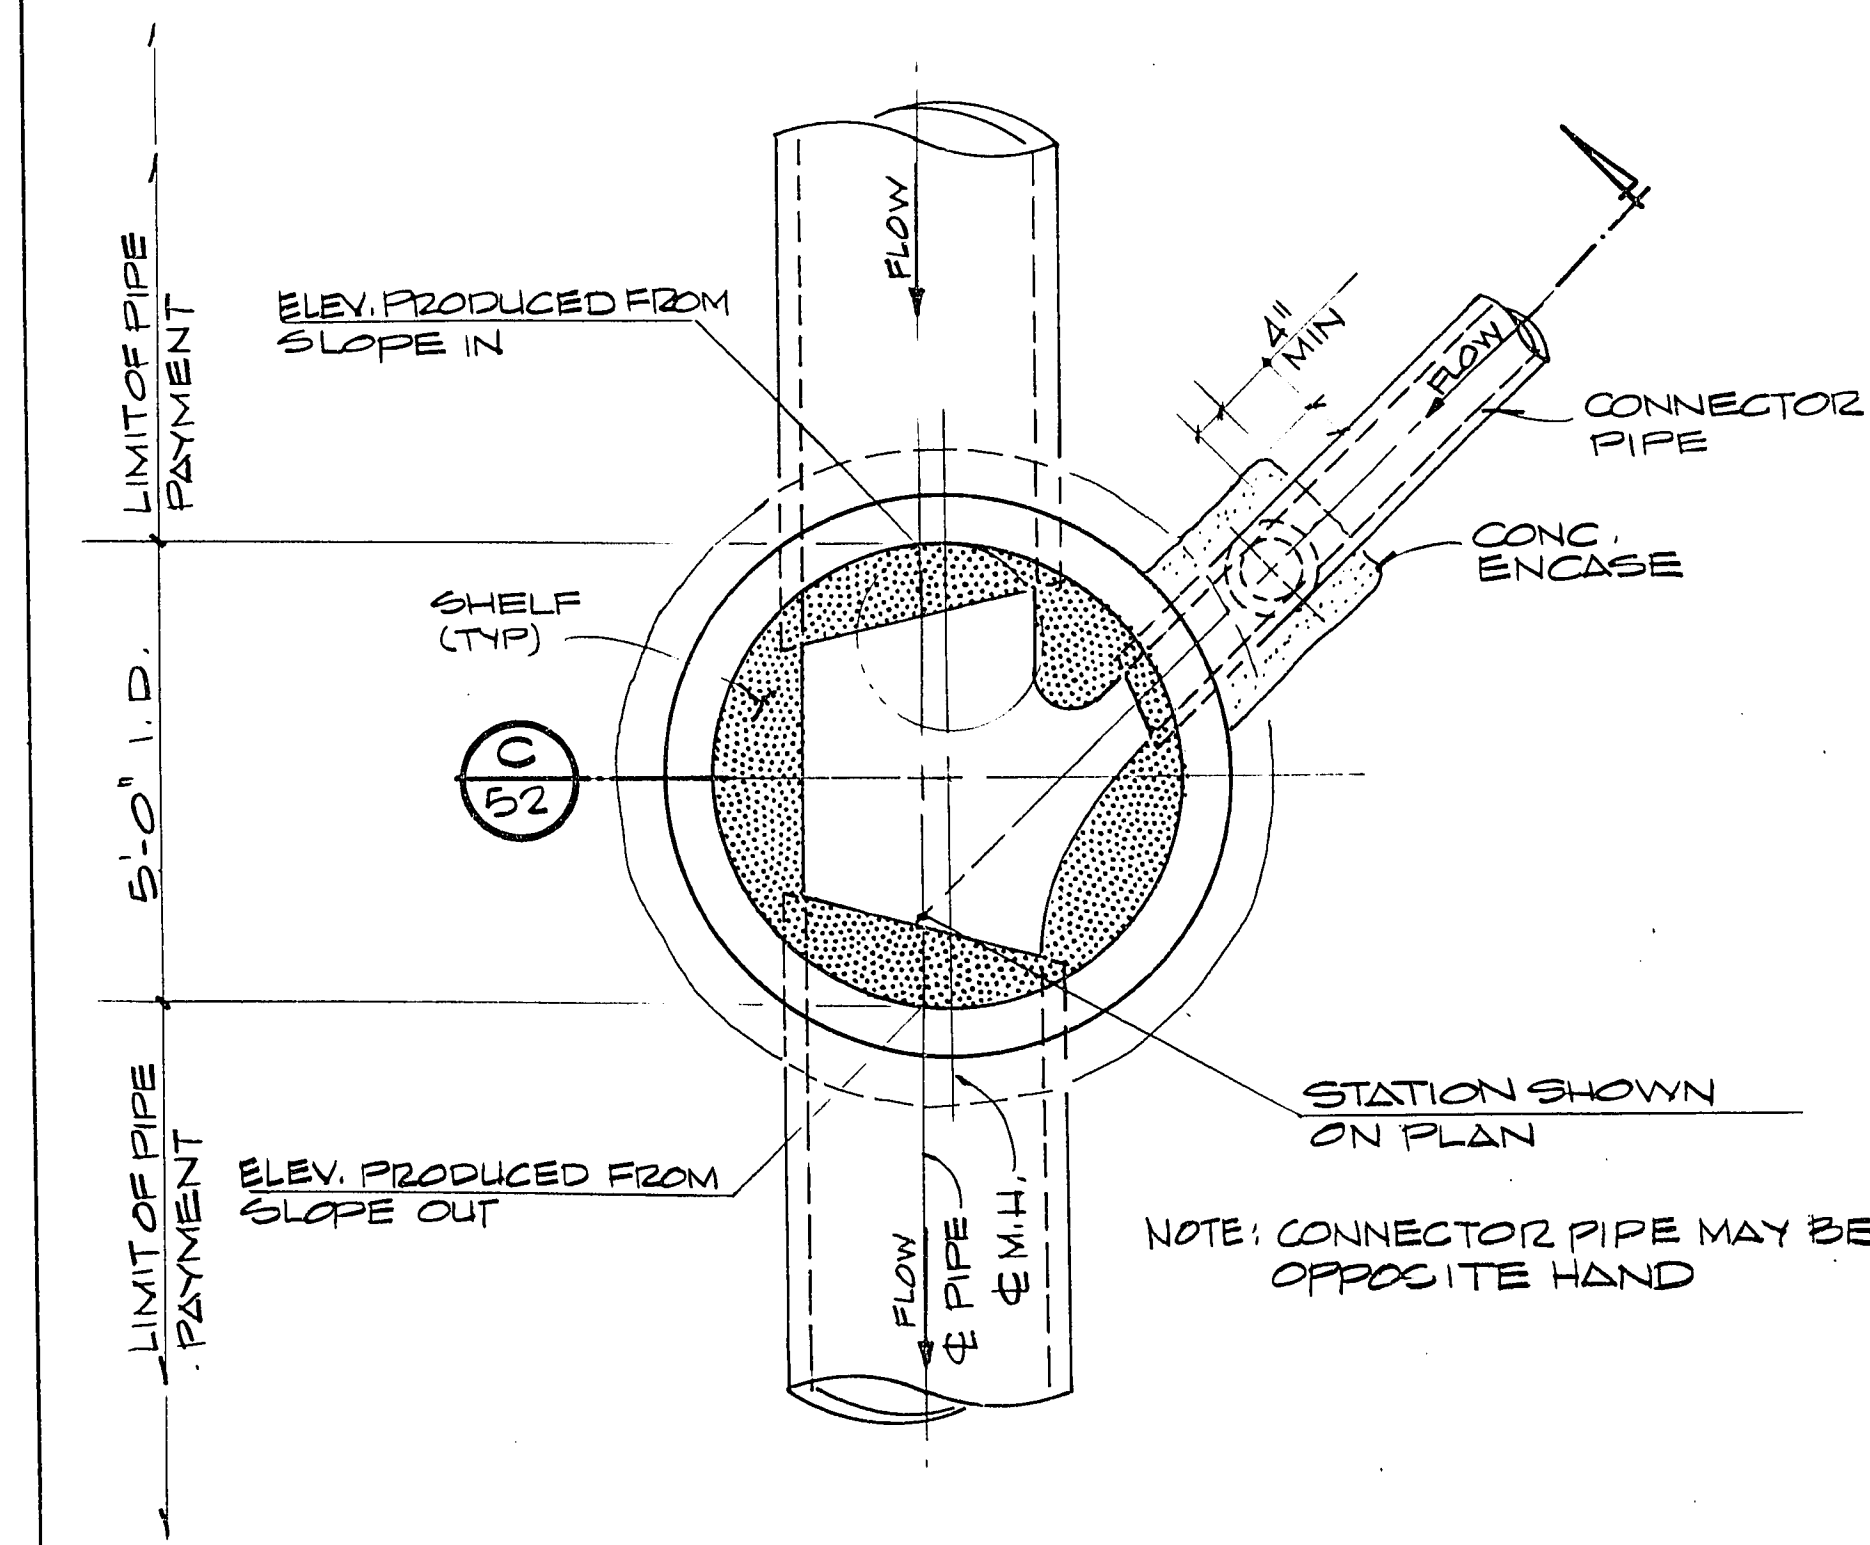


"J" TYPE MANHOLE
M.H. #S S.O. 37, & 39

3
52

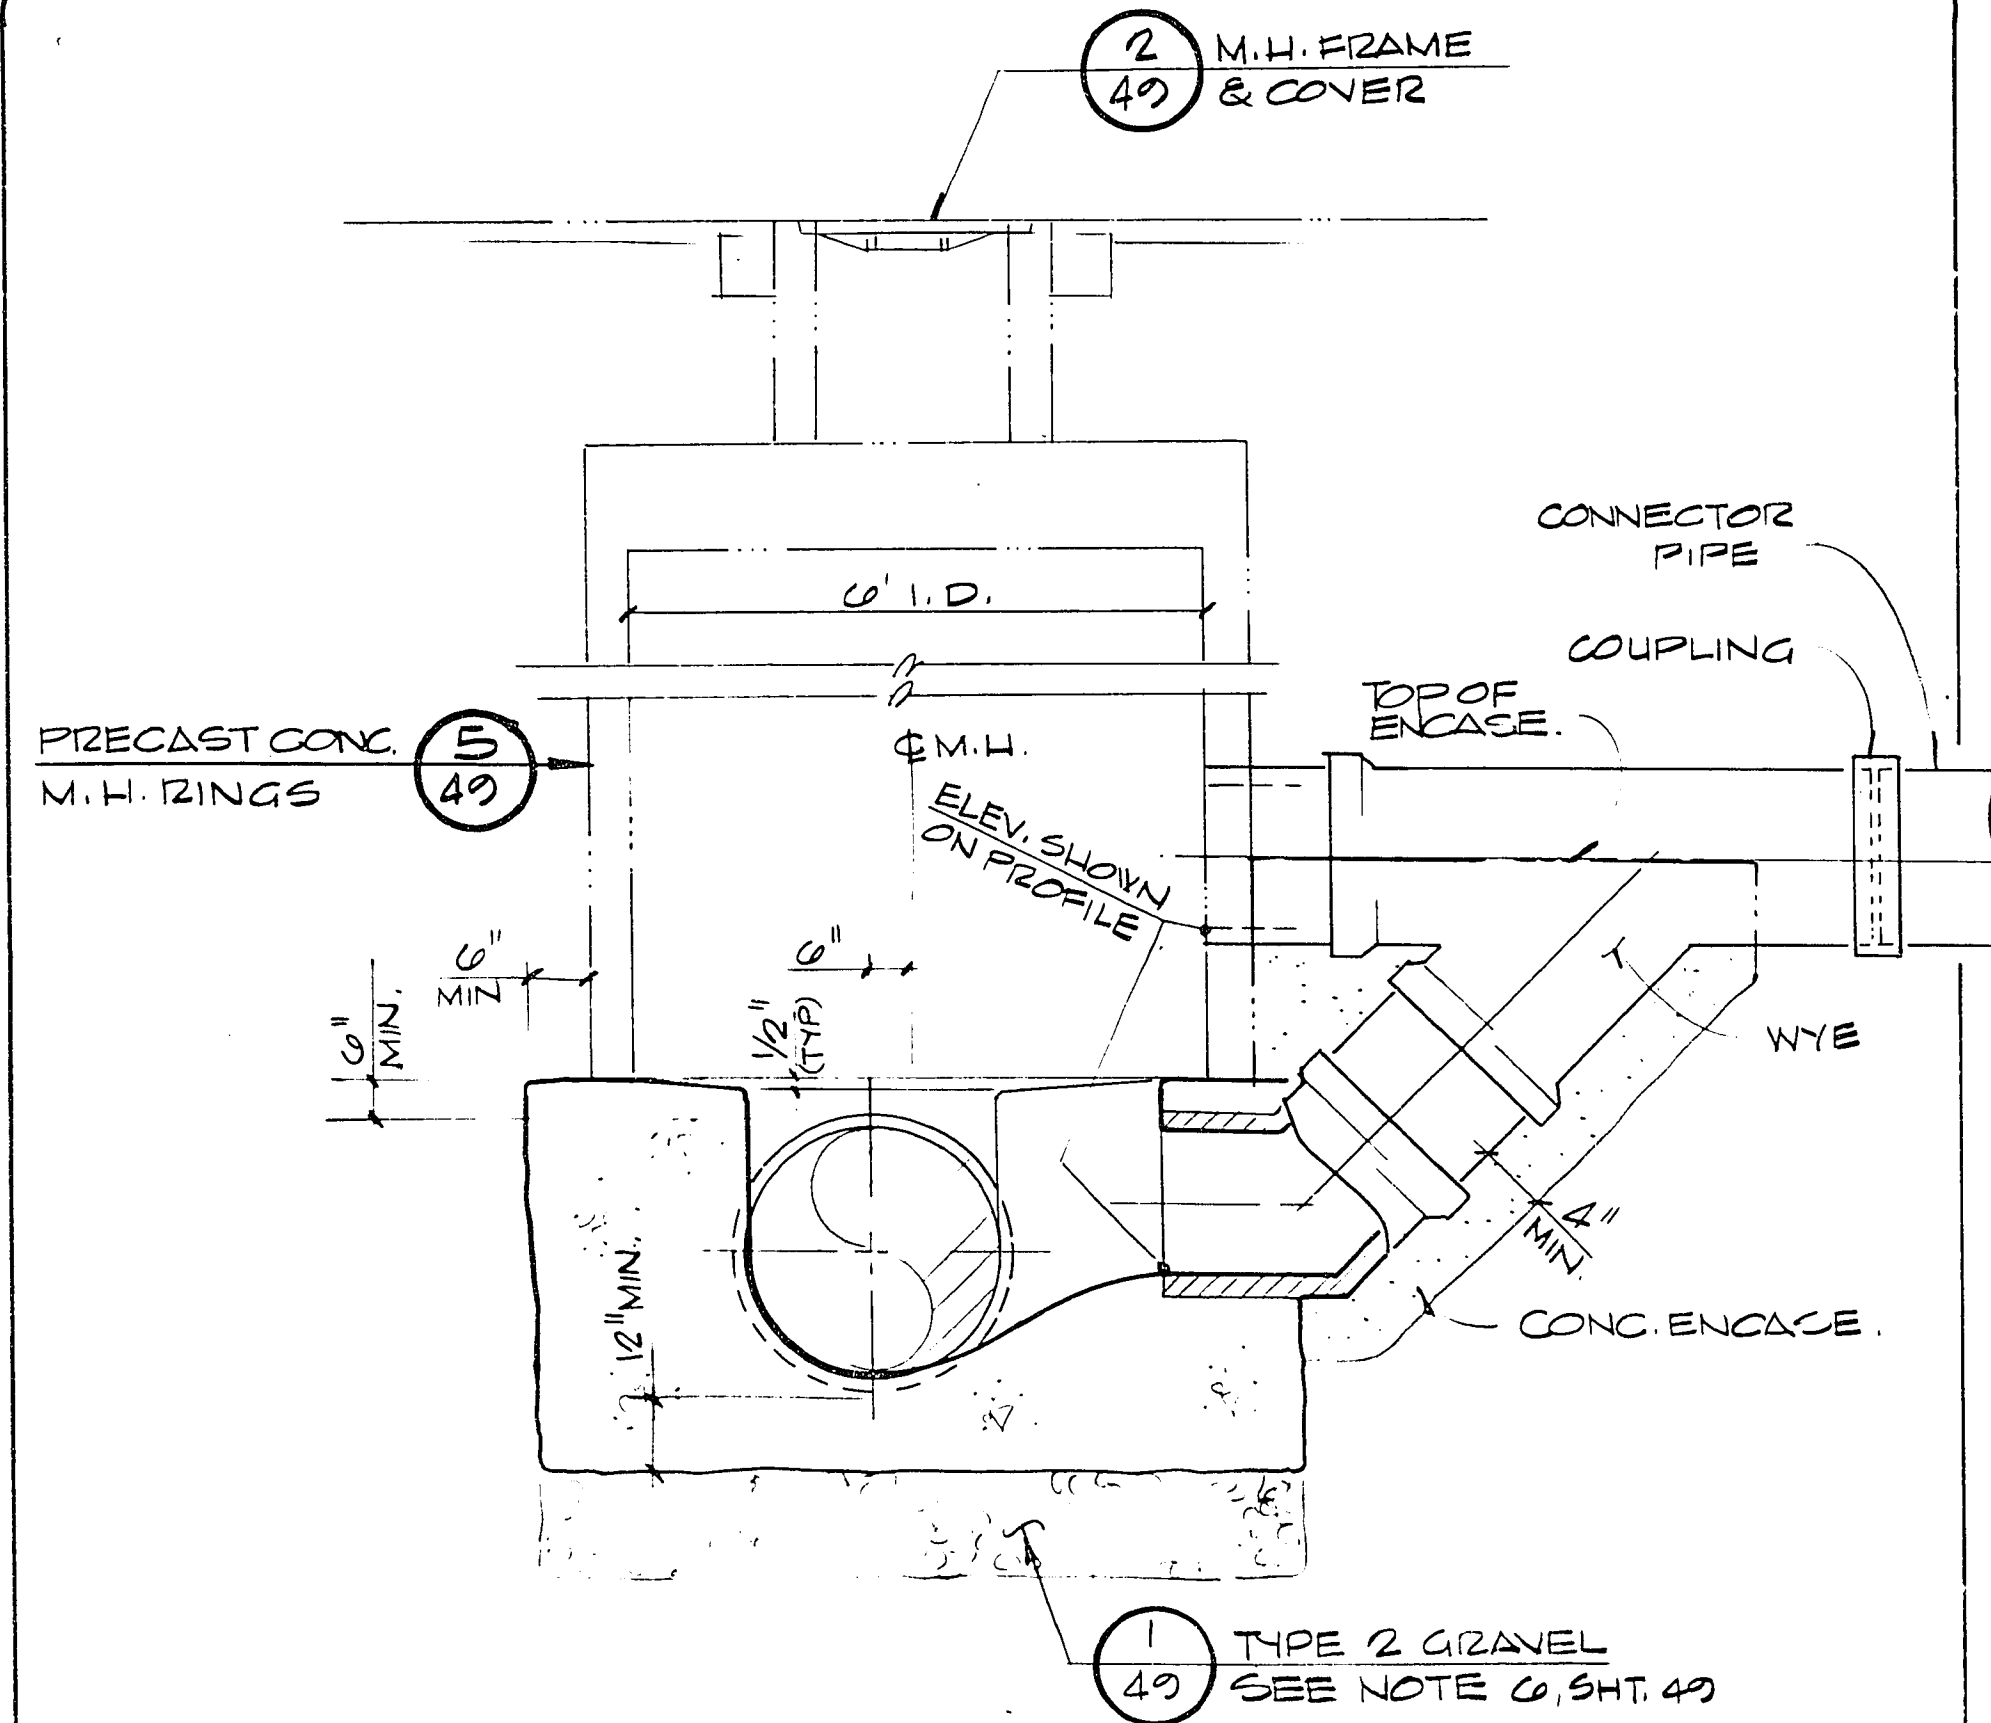


SECTION

B
52

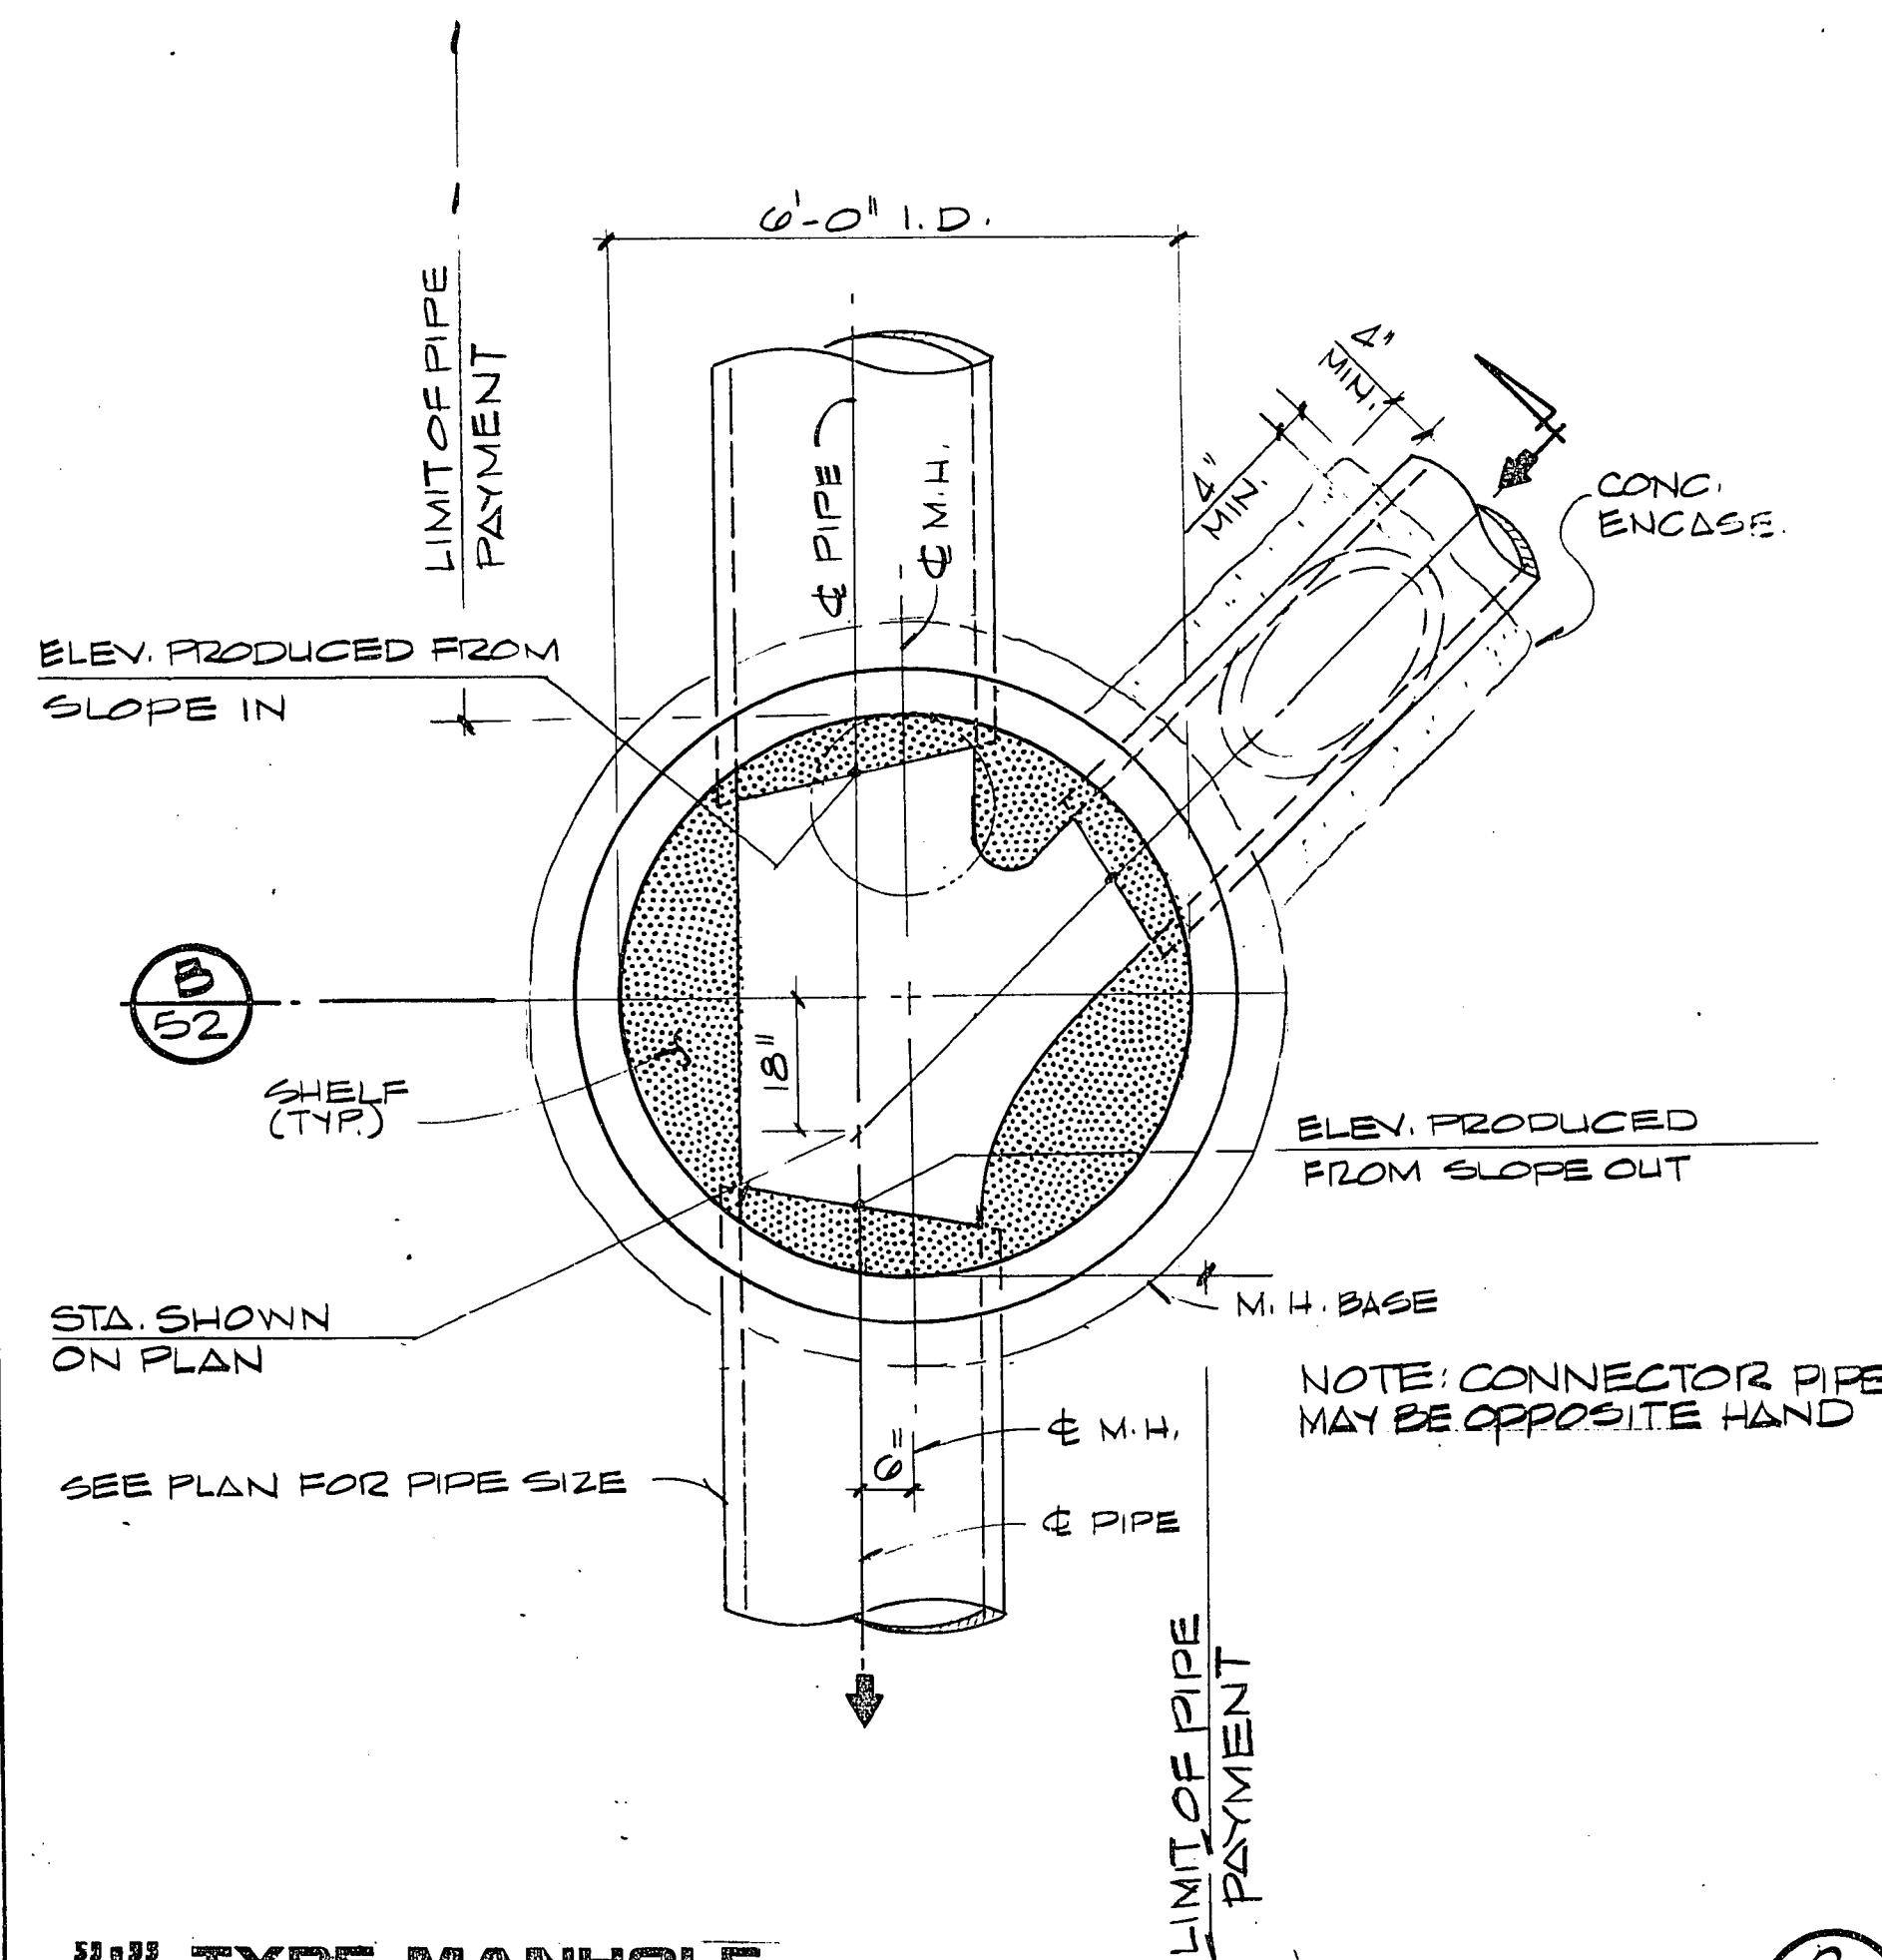


"I" TYPE MANHOLE
M.H. #S S.O. 16, & 82

2
52

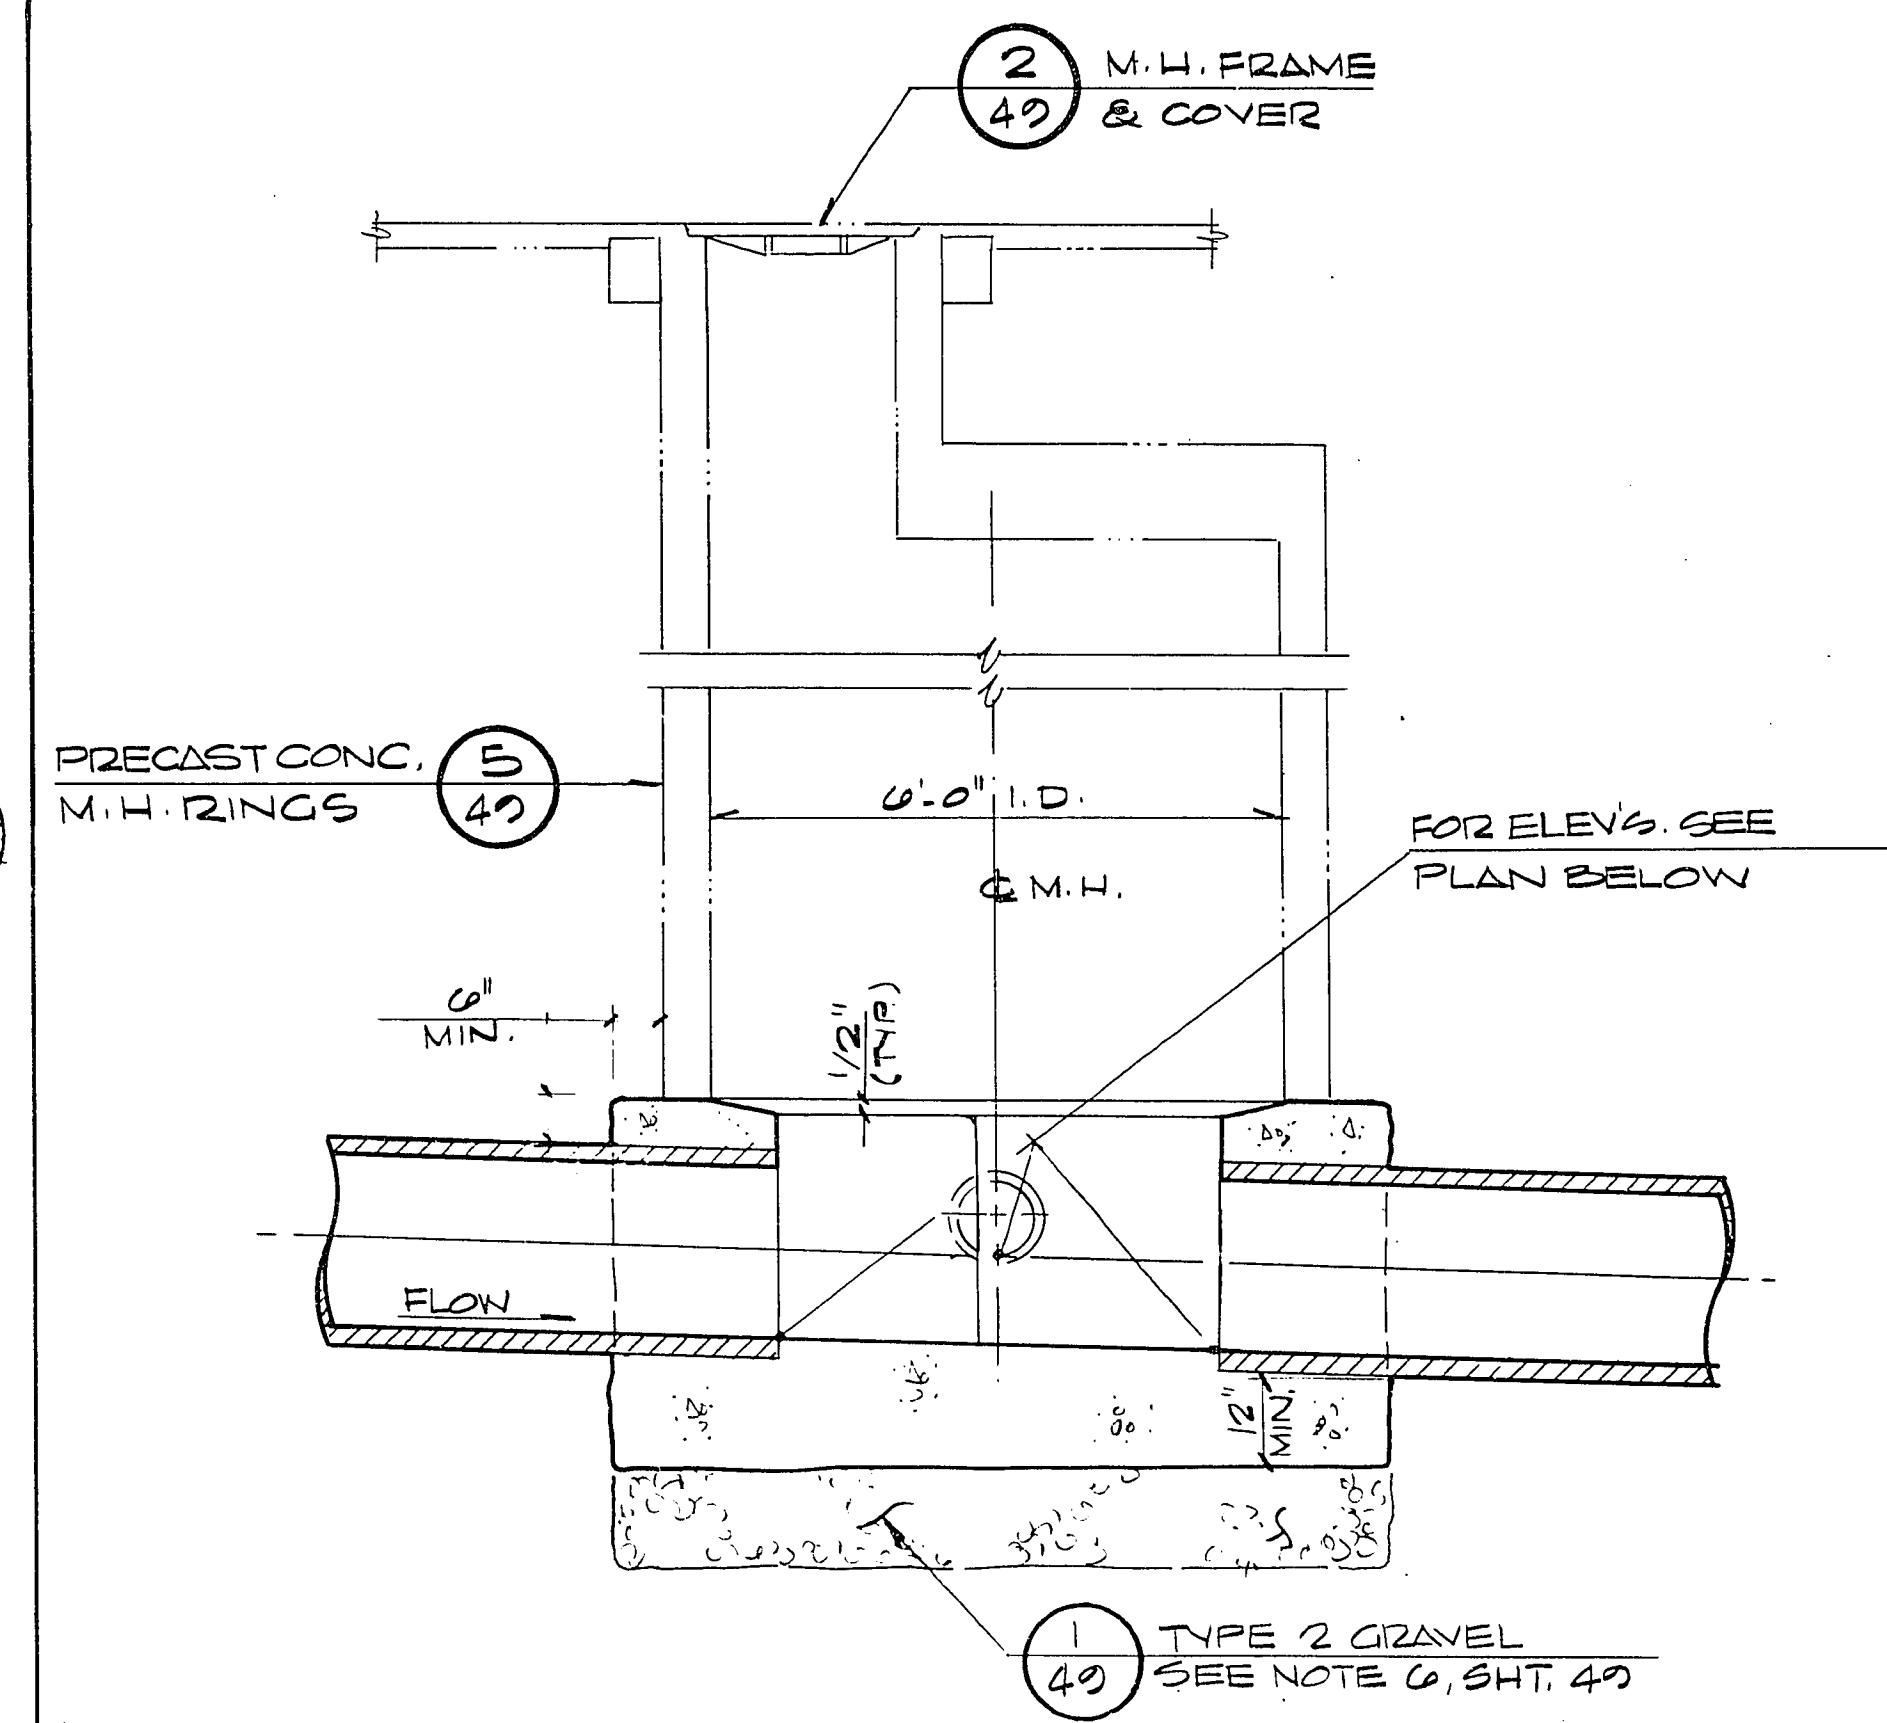

SECTION

A
52

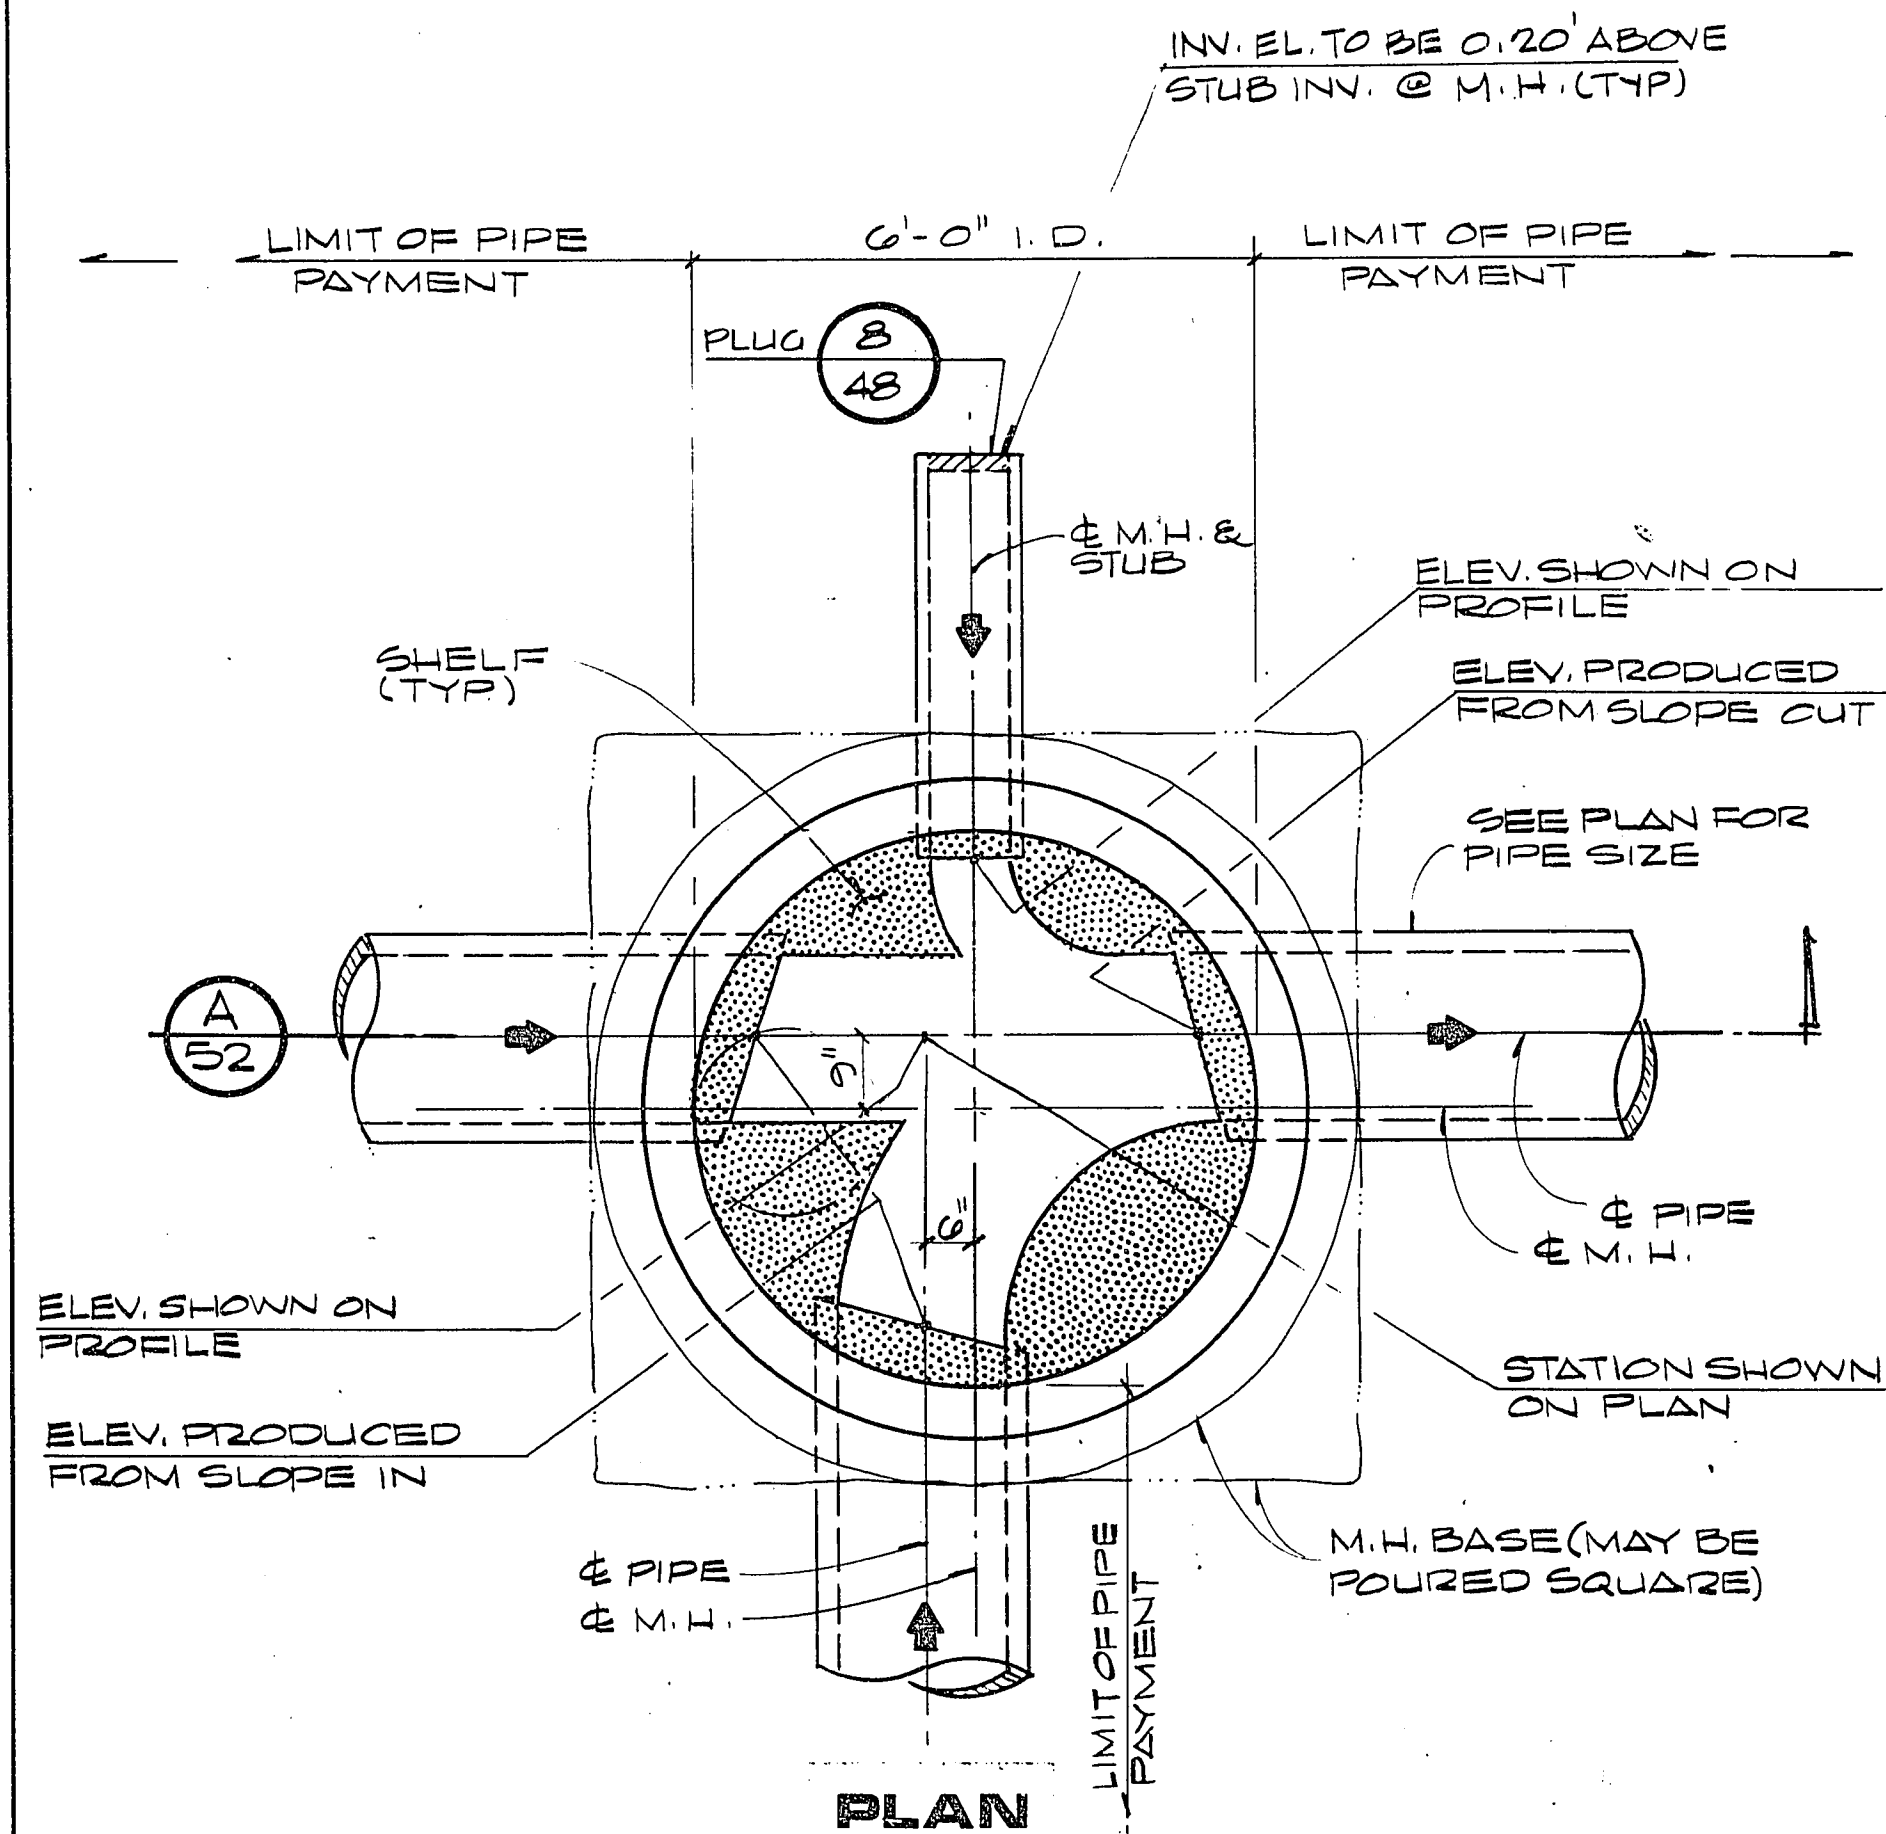

"H" TYPE MANHOLE
M.H. #S S.O. 55, 67, & 71

1
52

AS BUILT DRAWING

REVISIONS	DATE	DESCRIPTION
1	4/2/88	AS BUILT - 15 REVISIONS
2	7/20/83	DATE
3		R.E. NO.

G.C. WALLACE
 Consulting Engineers, Inc.
 1100 East Sahara Ave. • Las Vegas, Nevada 89104 • 732-3330

Department of Public Services
 SAHARA - OAKLEY SEWER INTERCEPTOR
 MANHOLE TYPES "H", "I", & "J"
 DETAILS

SHEET
52
 OF 65 SHEETS