
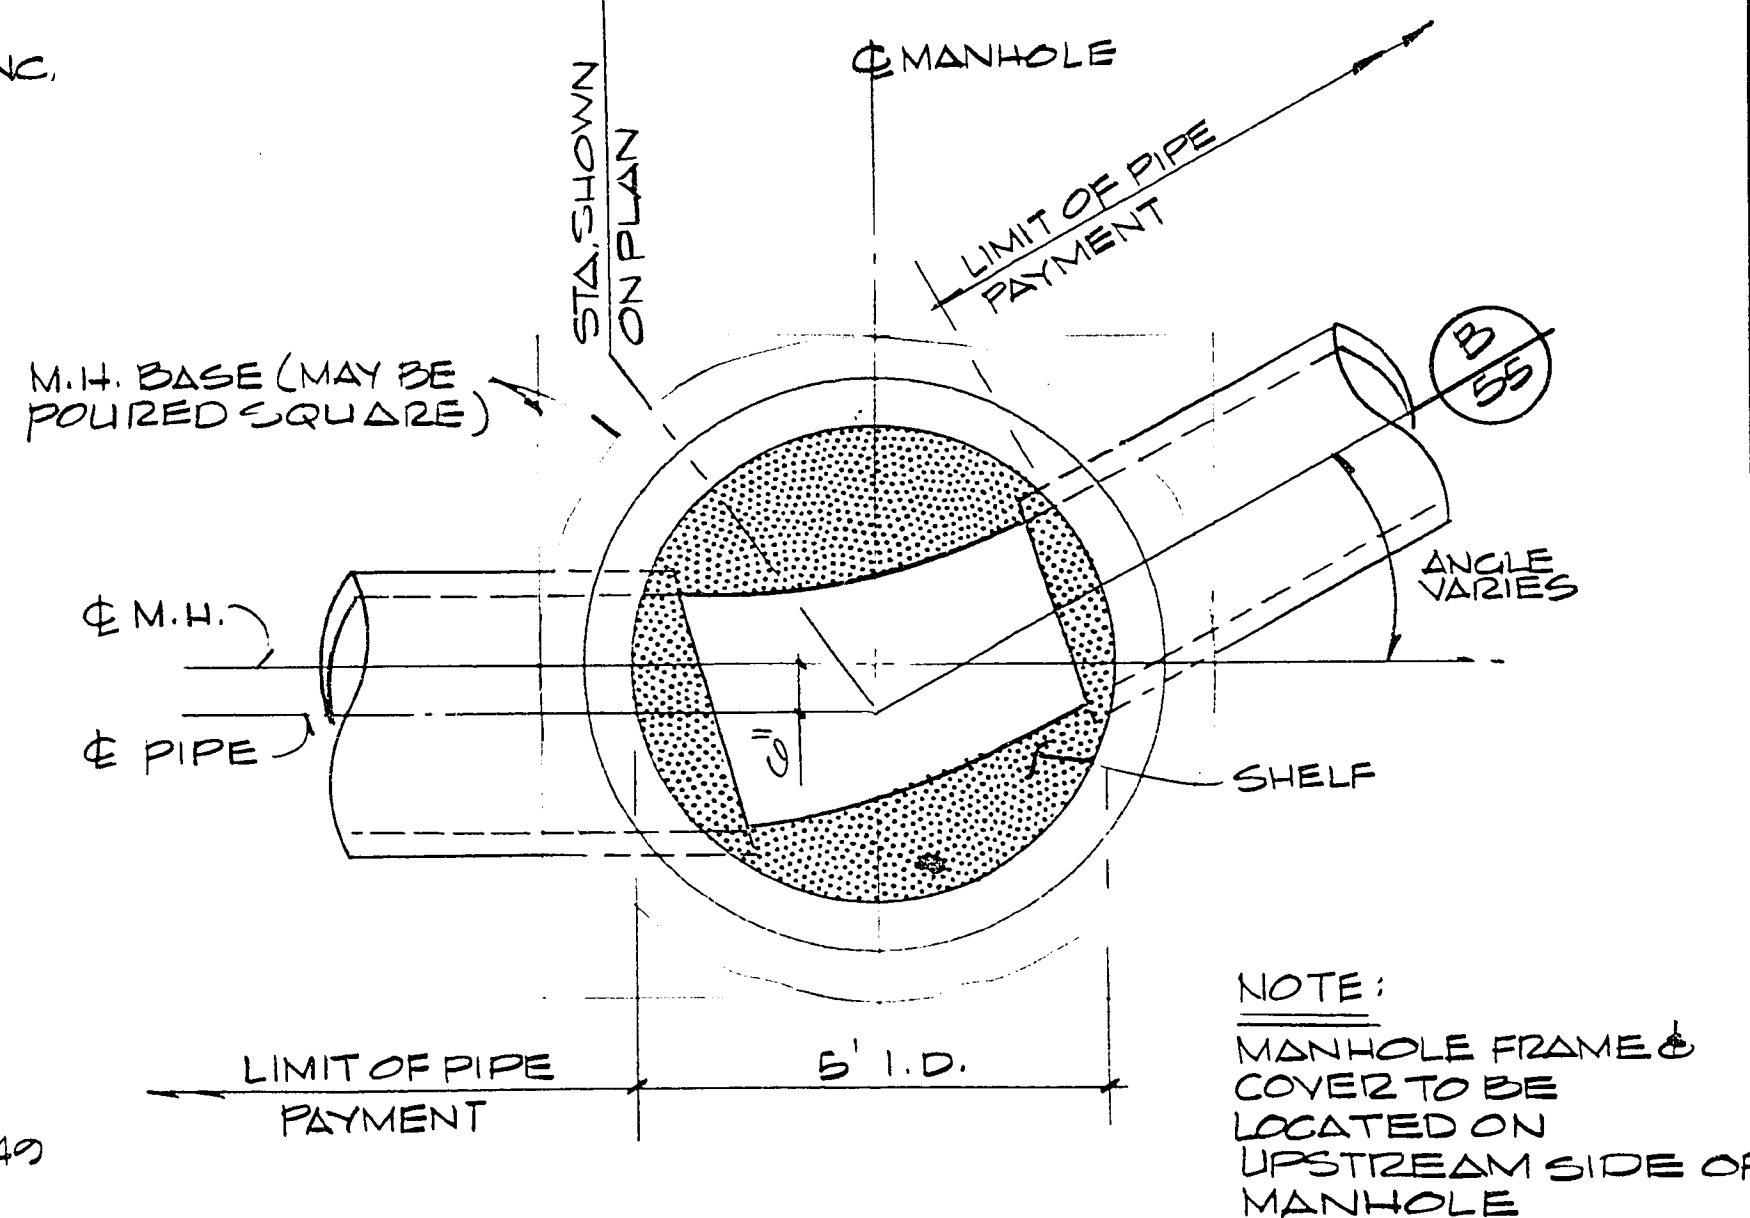


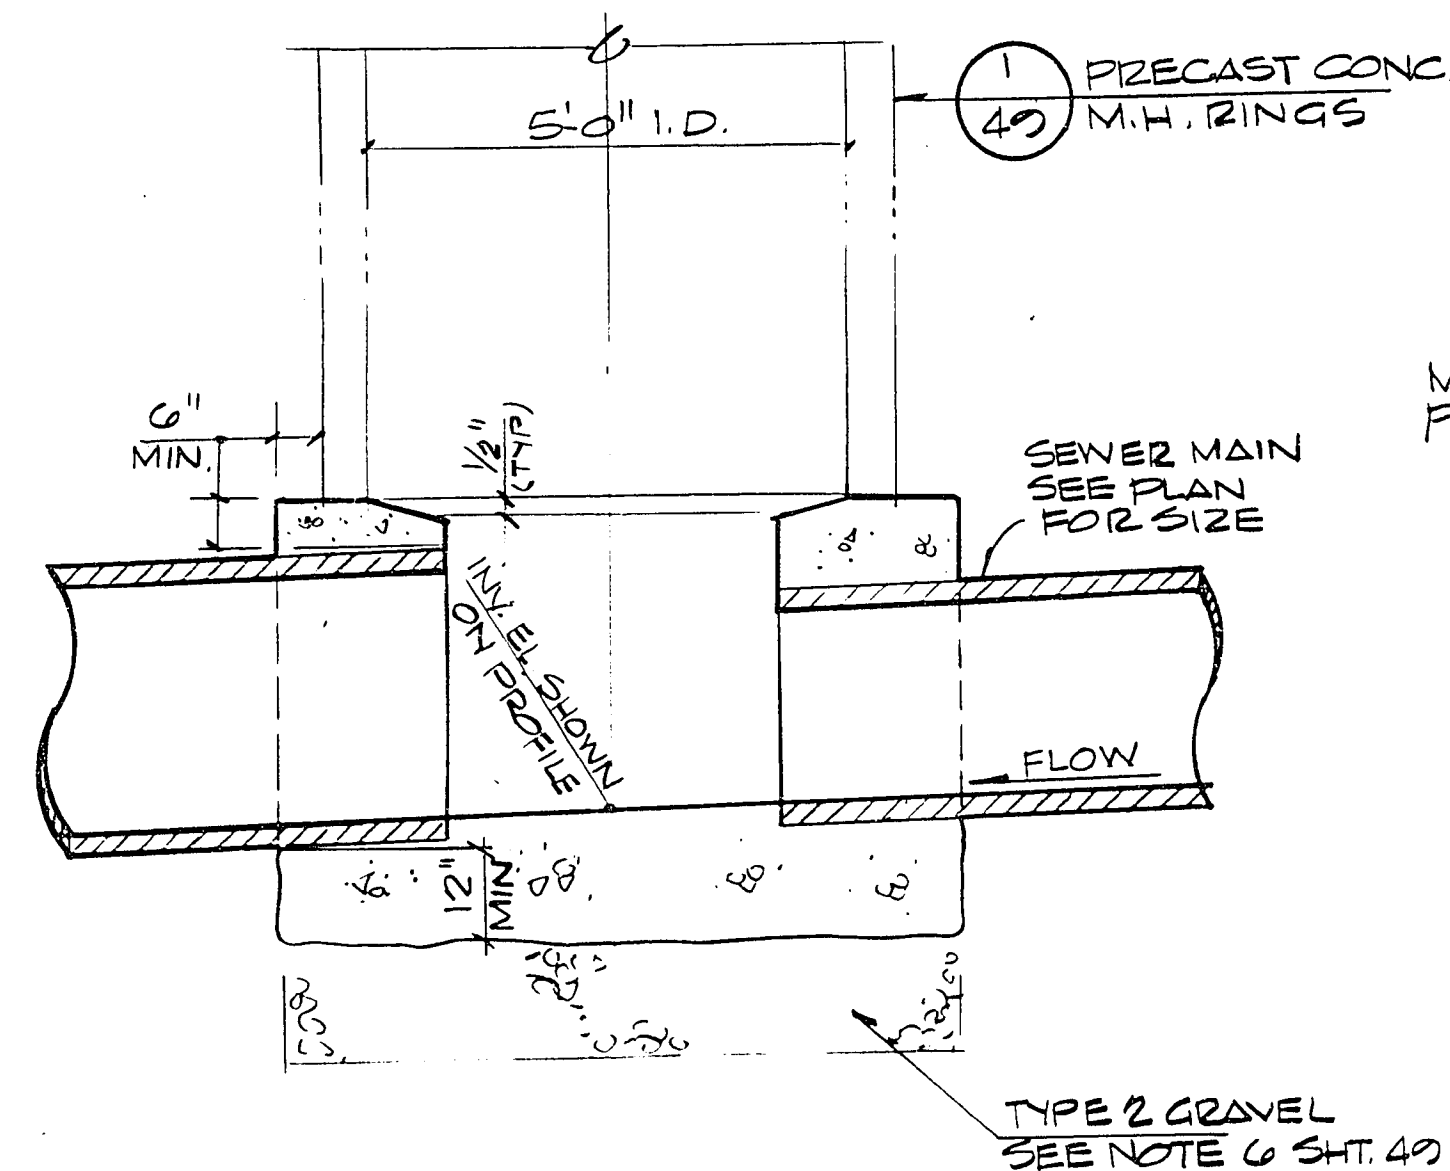


SECTION

B
55

"O" TYPE MANHOLE

M.H. #S S.O. 8, 9, 11, 12, 13, 19, 20, 22, 23, 42, 45, 46, 87 & 88


4
55

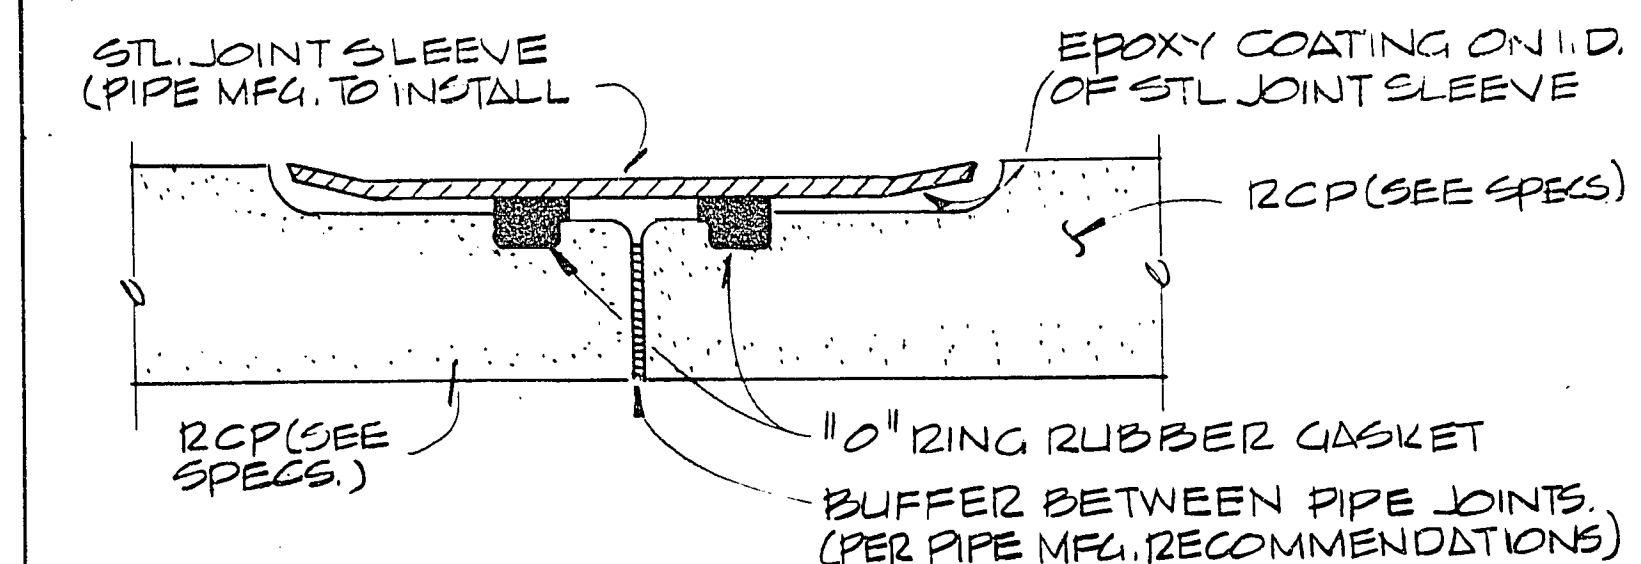

STEEL SLEEVE DETAIL

(FOR PIPE JOINTS WITHIN STEEL CASING ONLY)

3
55

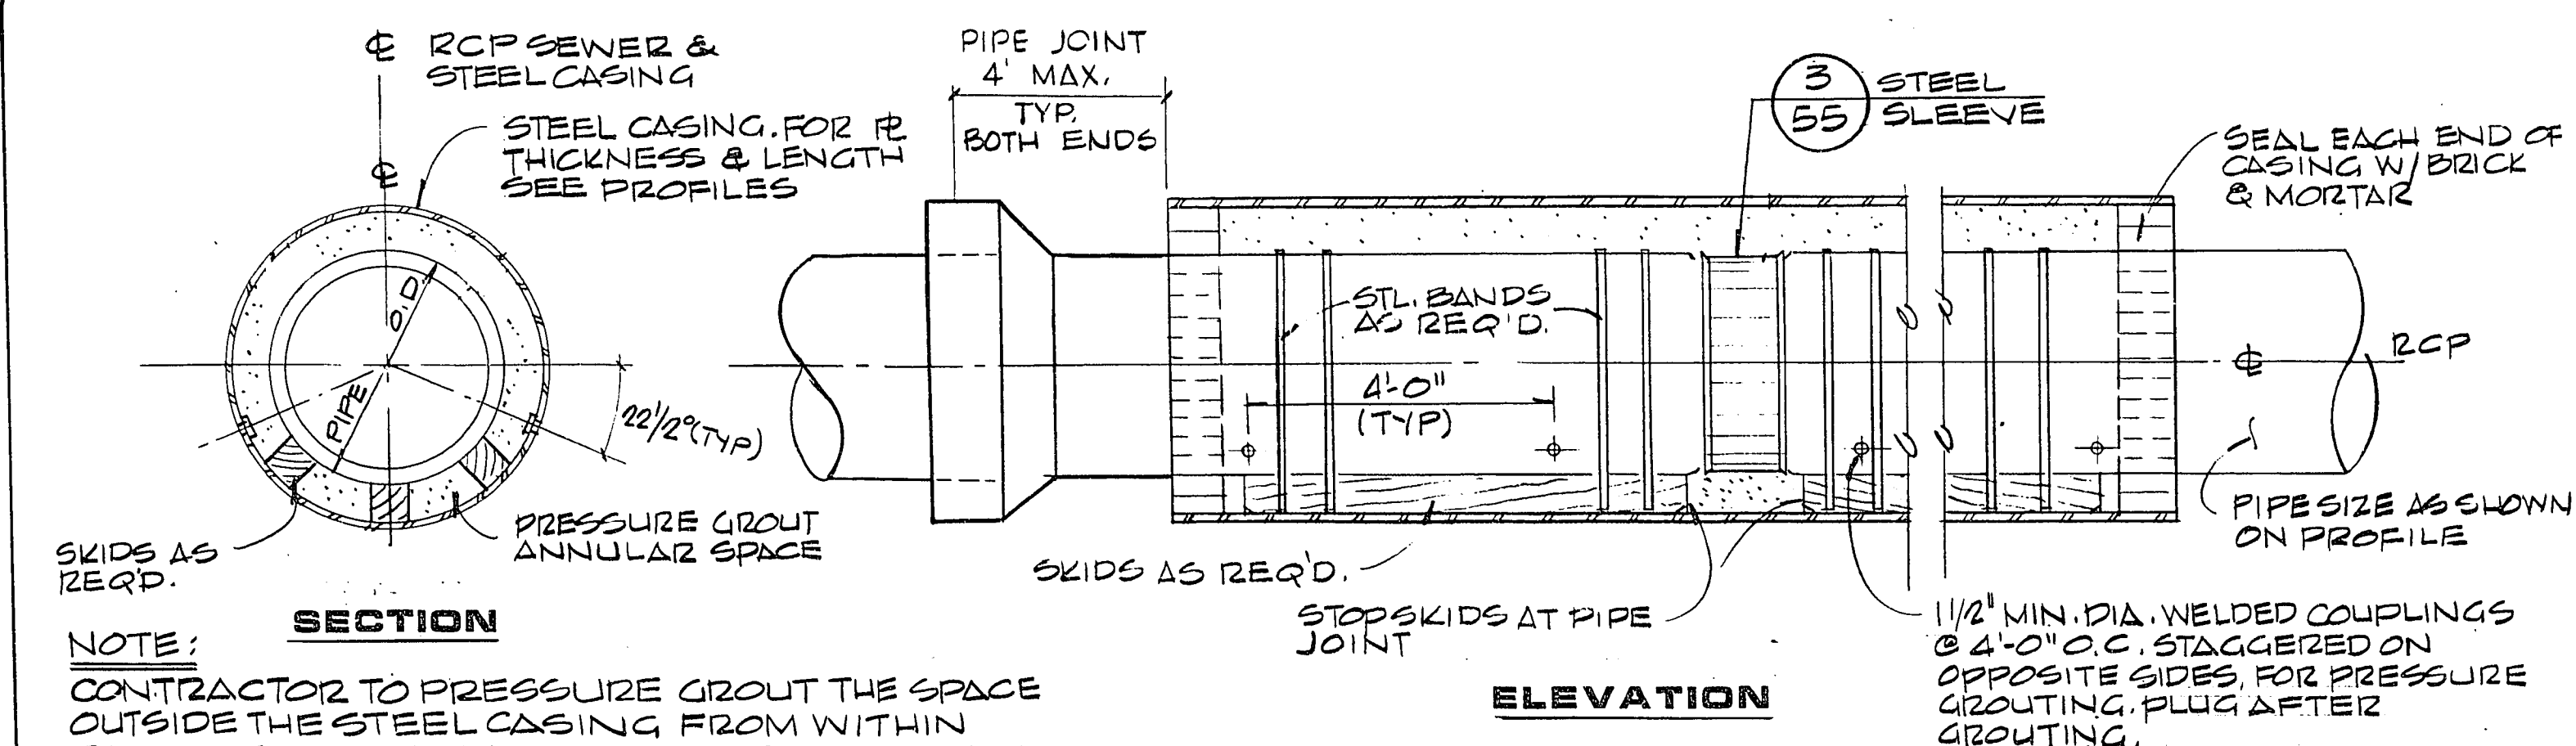


SECTION

NOTE: CONTRACTOR TO PRESSURE GROUT THE SPACE OUTSIDE THE STEEL CASING FROM WITHIN CASING TO FILL ANY VOIDS CAUSED WHEN CASING IS JACKED. GROUTING TO BE DONE @ CONTRACTOR'S EXPENSE.

ELEVATION


2
55

JACKED CASING DETAIL

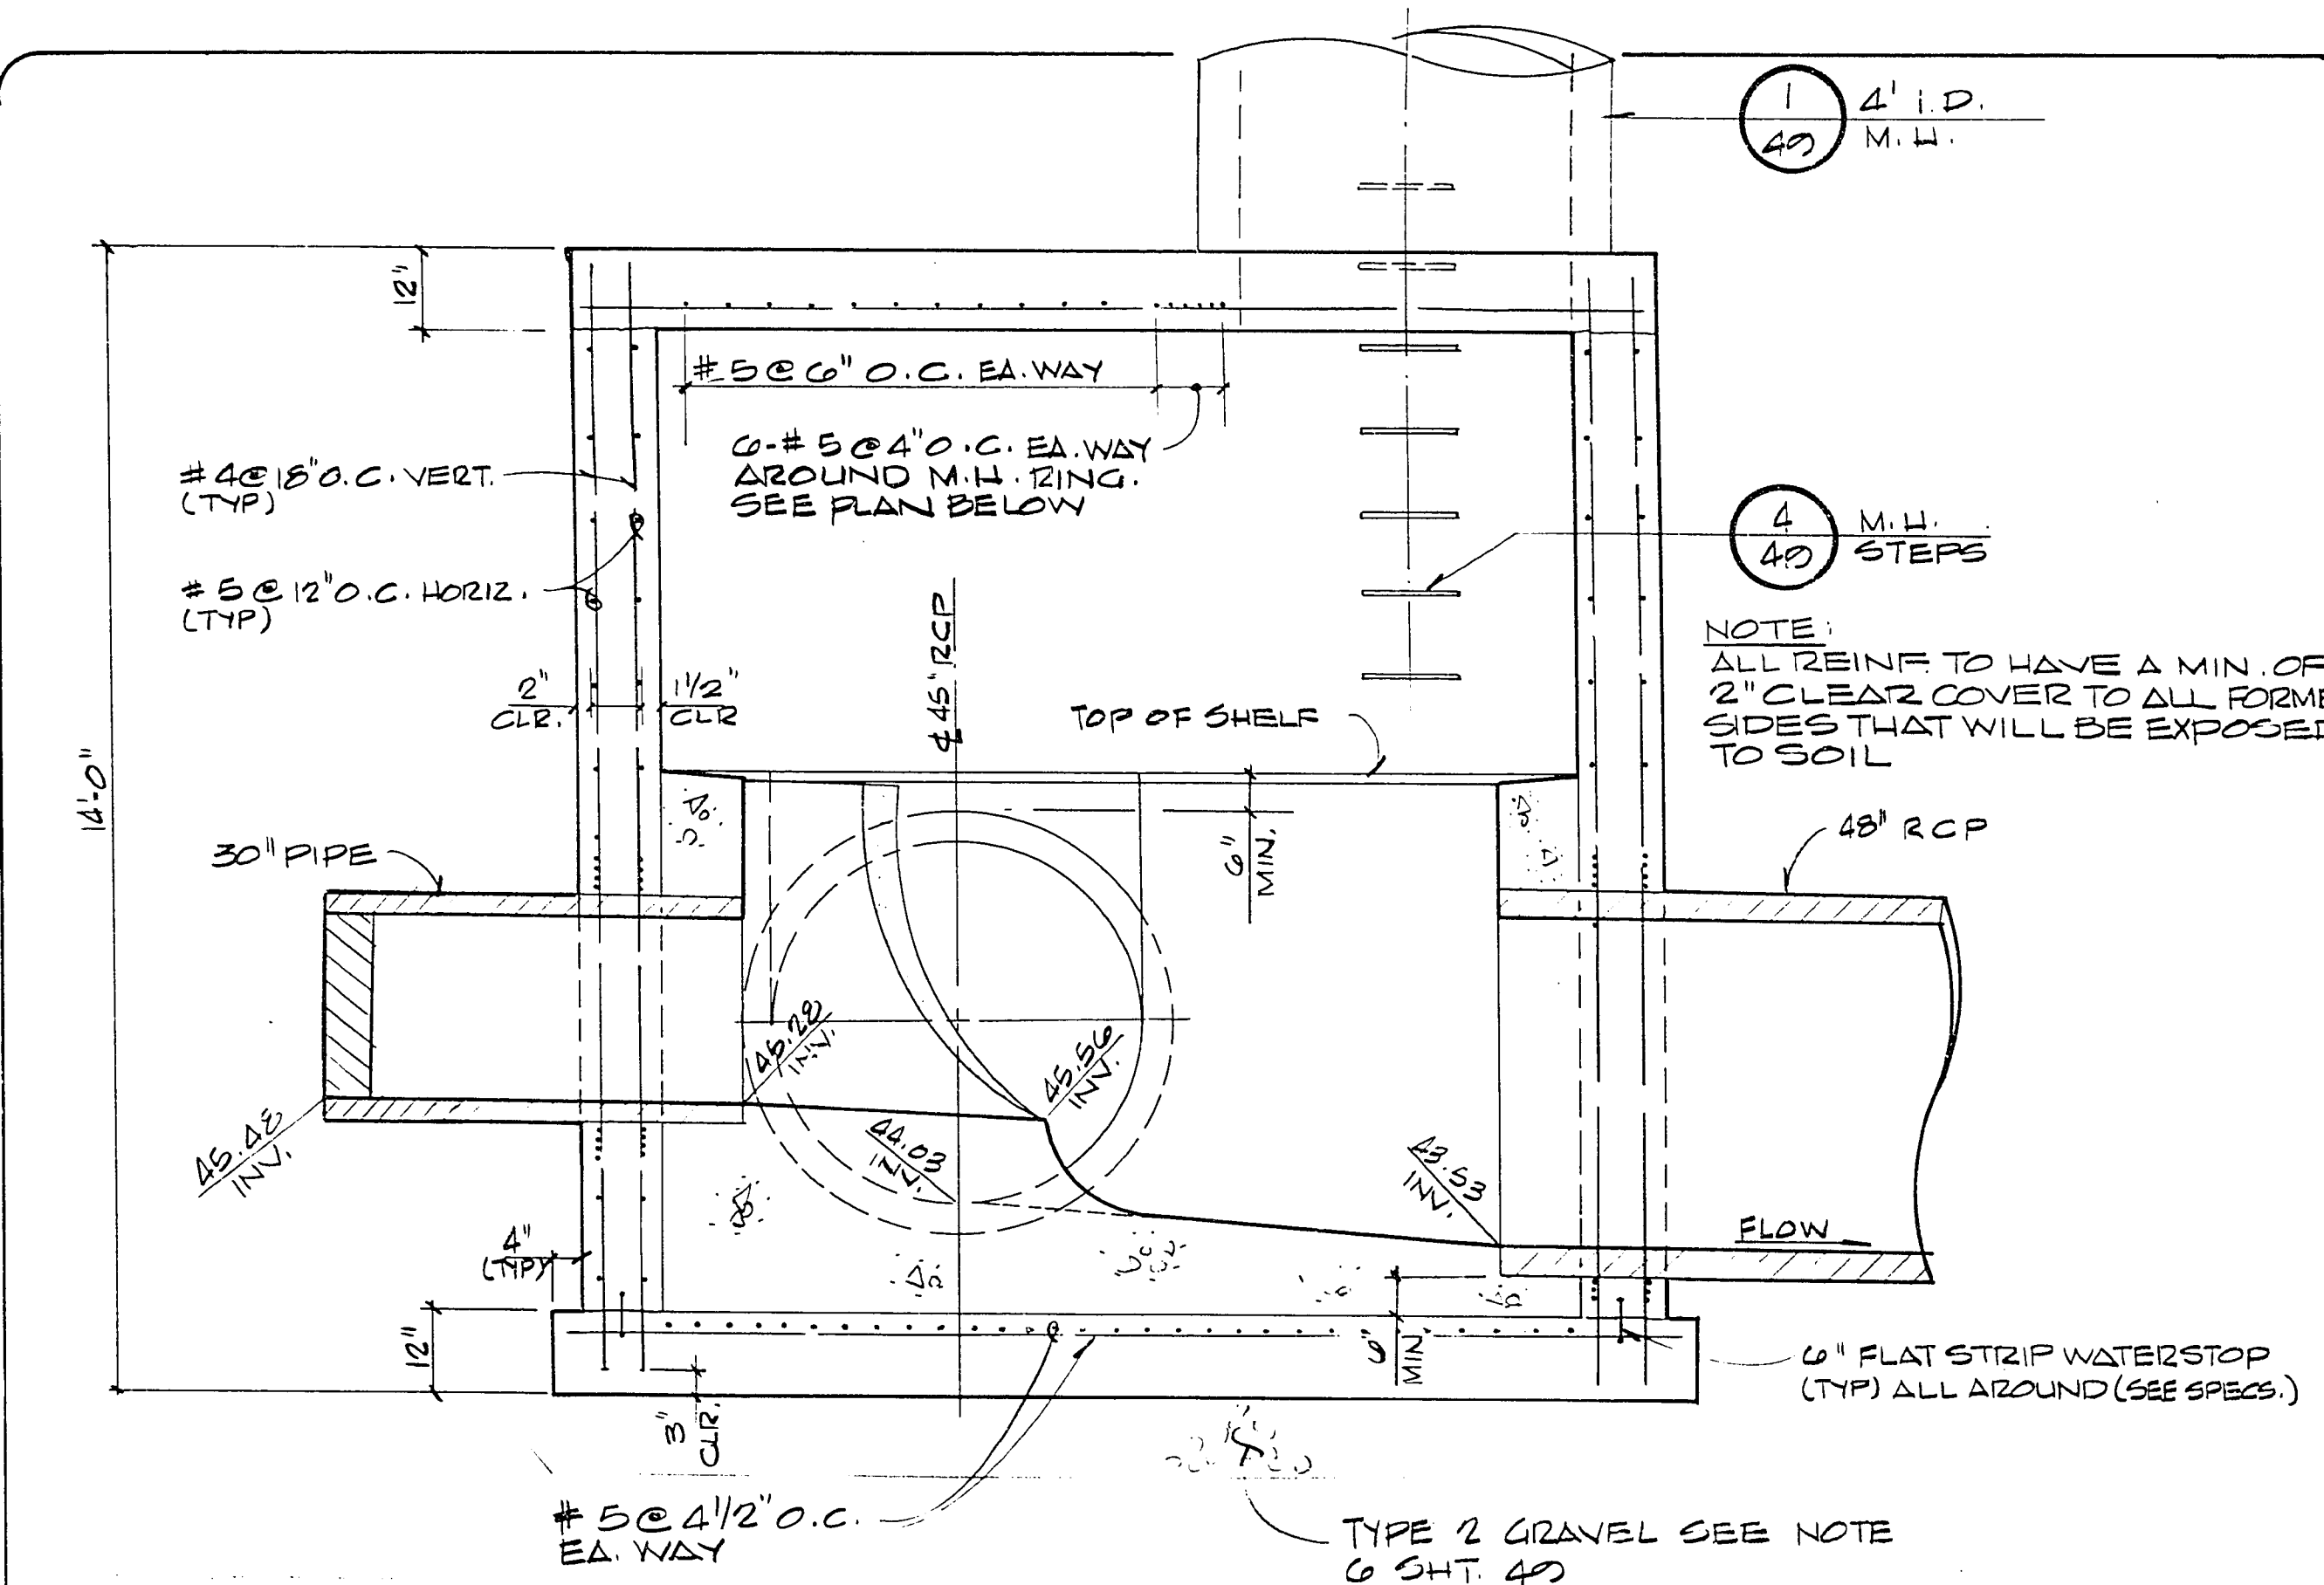

SECTION

A
55

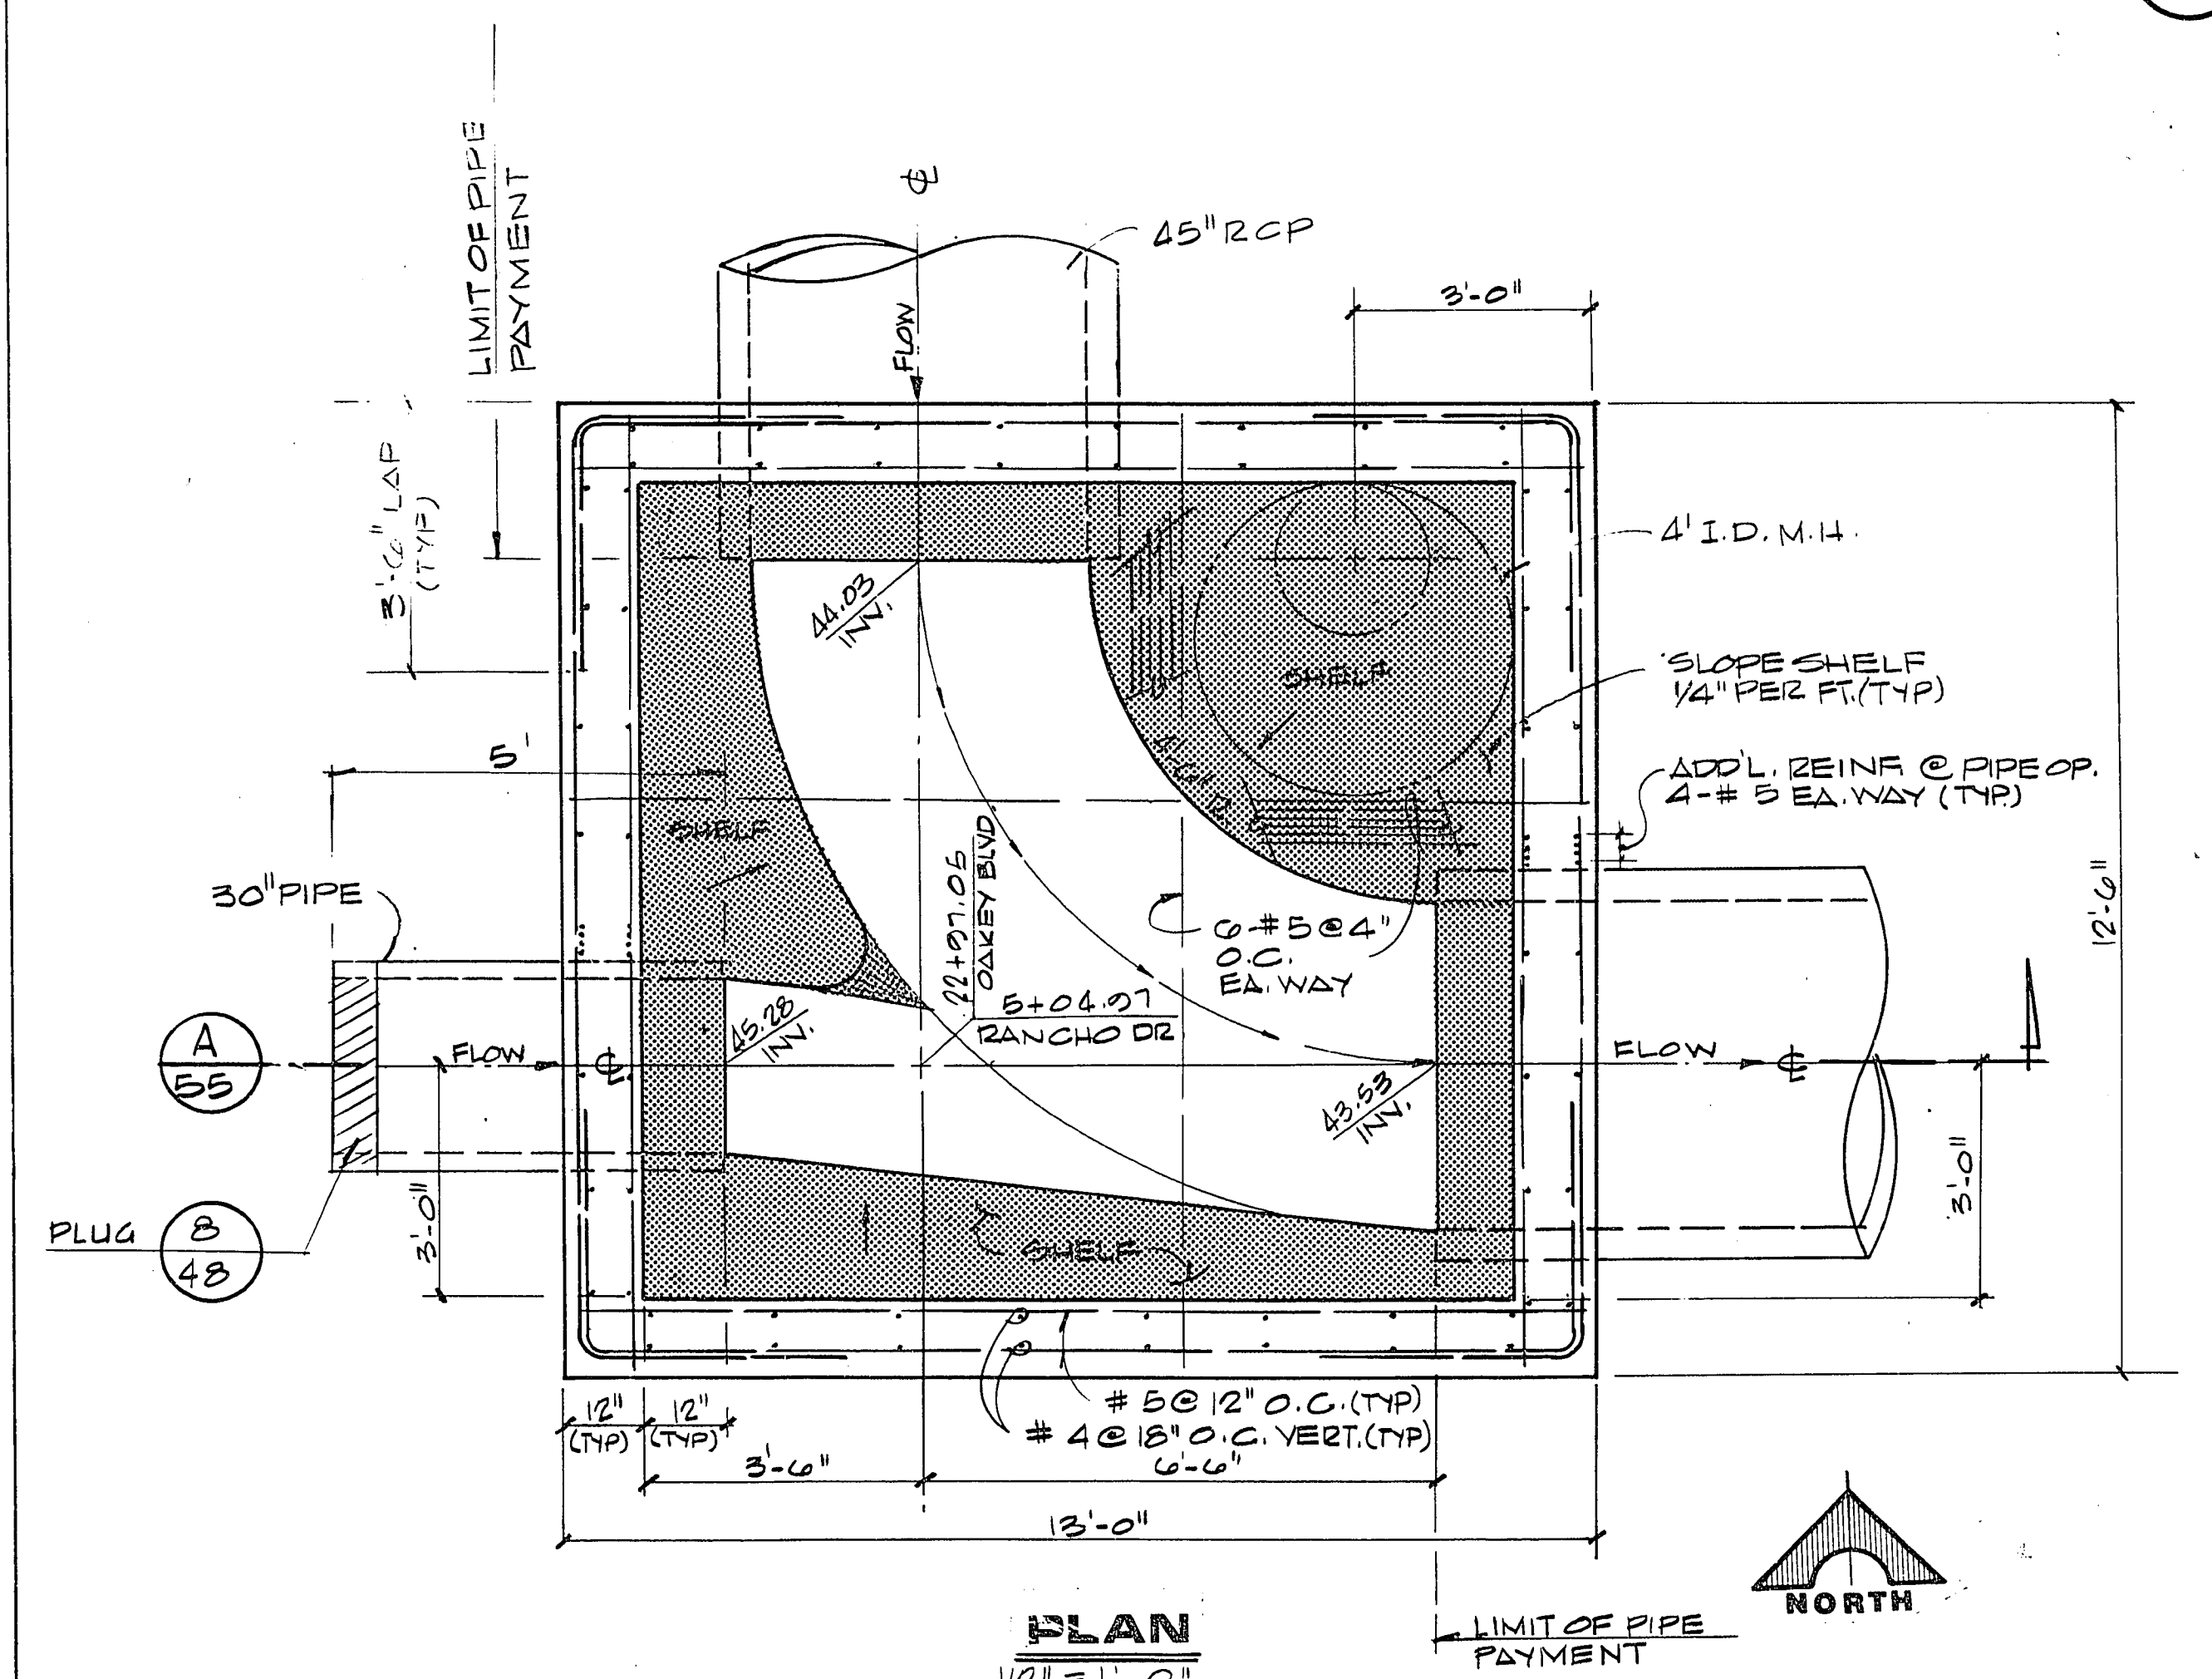

PLAN

1/2" = 1'-0"

"M" TYPE MANHOLE

M.H. # S.O. 2

1
55

AS BUILT DRAWING

REVISION	DATE	DESCRIPTION
1	4/10/88	AS BUILT - NO REVISIONS
2	7/25/88	DATE
3		R.E. NO.
4		DATE

G.C. WALLACE
Consulting Engineers, Inc.
1100 East Sahara Ave. • Las Vegas, Nevada 89104 • 735-3330

Department of Public Services
SAHARA-OAKLEY SEWER INTERCEPTOR
MANHOLE TYPE "M" DETAILS

SHEET
55
OF 65 SHEETS