


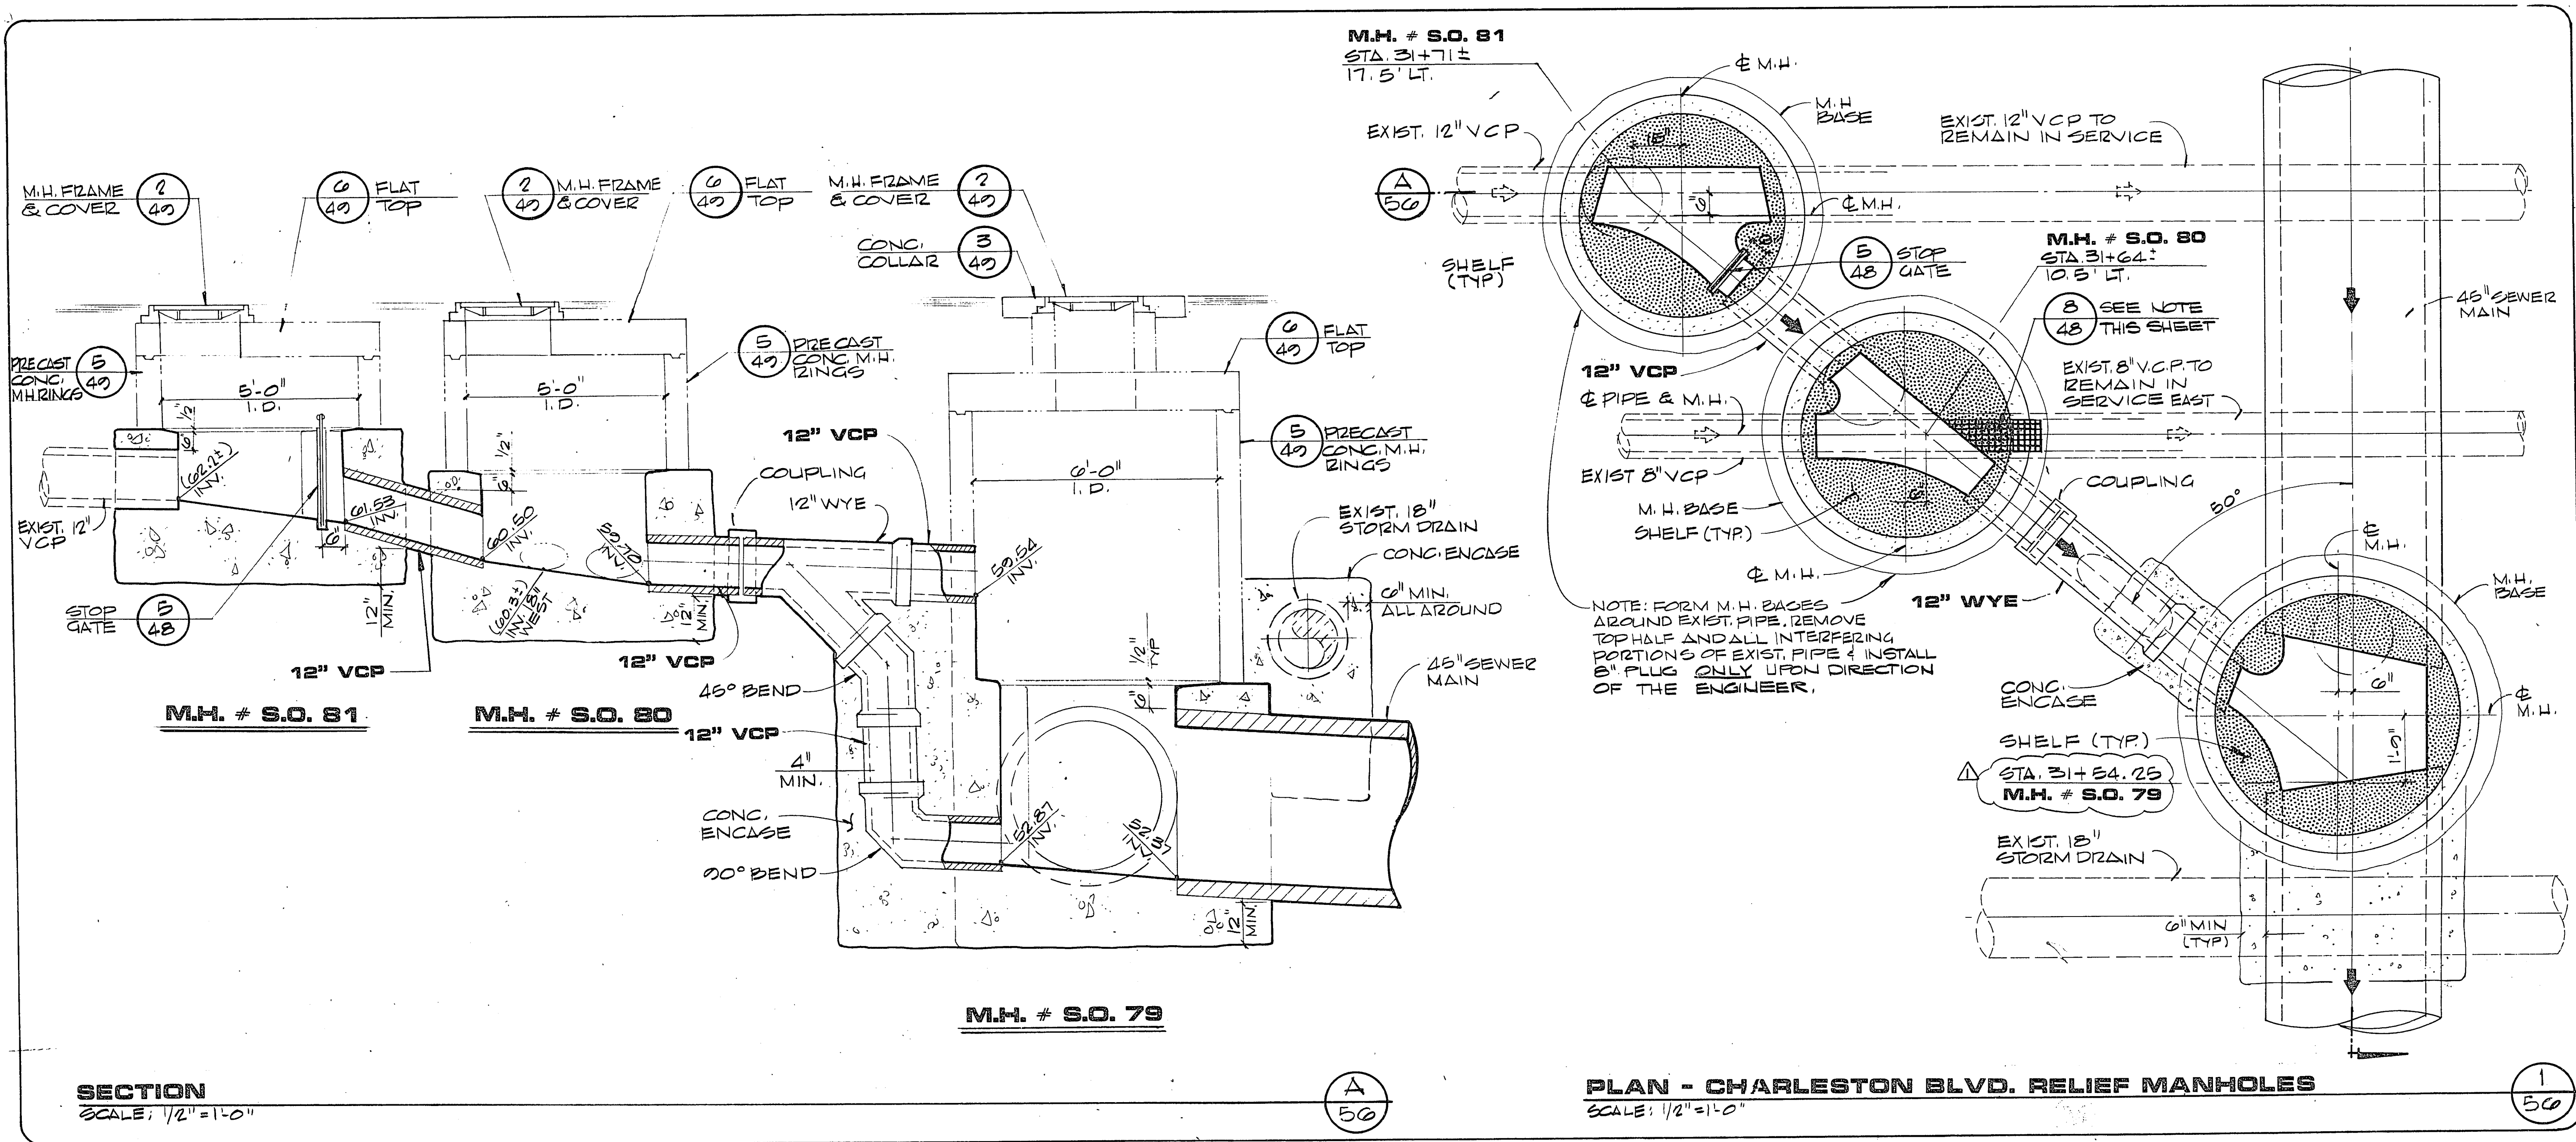

REV	DATE	DESCRIPTION
1	1/20/83	AS BUILT

RECEIVED
CITY OF LAS VEGAS
DEPARTMENT OF PUBLIC SERVICES
SAHARA-OAKEY SEWER INTERCEPTOR
CHARLESTON BLVD. RELIEF
MANHOLES

G. C. WALLACE
Consulting Engineers, Inc.
1100 East Sahara Ave. • Las Vegas, Nevada 89104 • 732-3330

SHEET
56
OF 62 SHEETS