
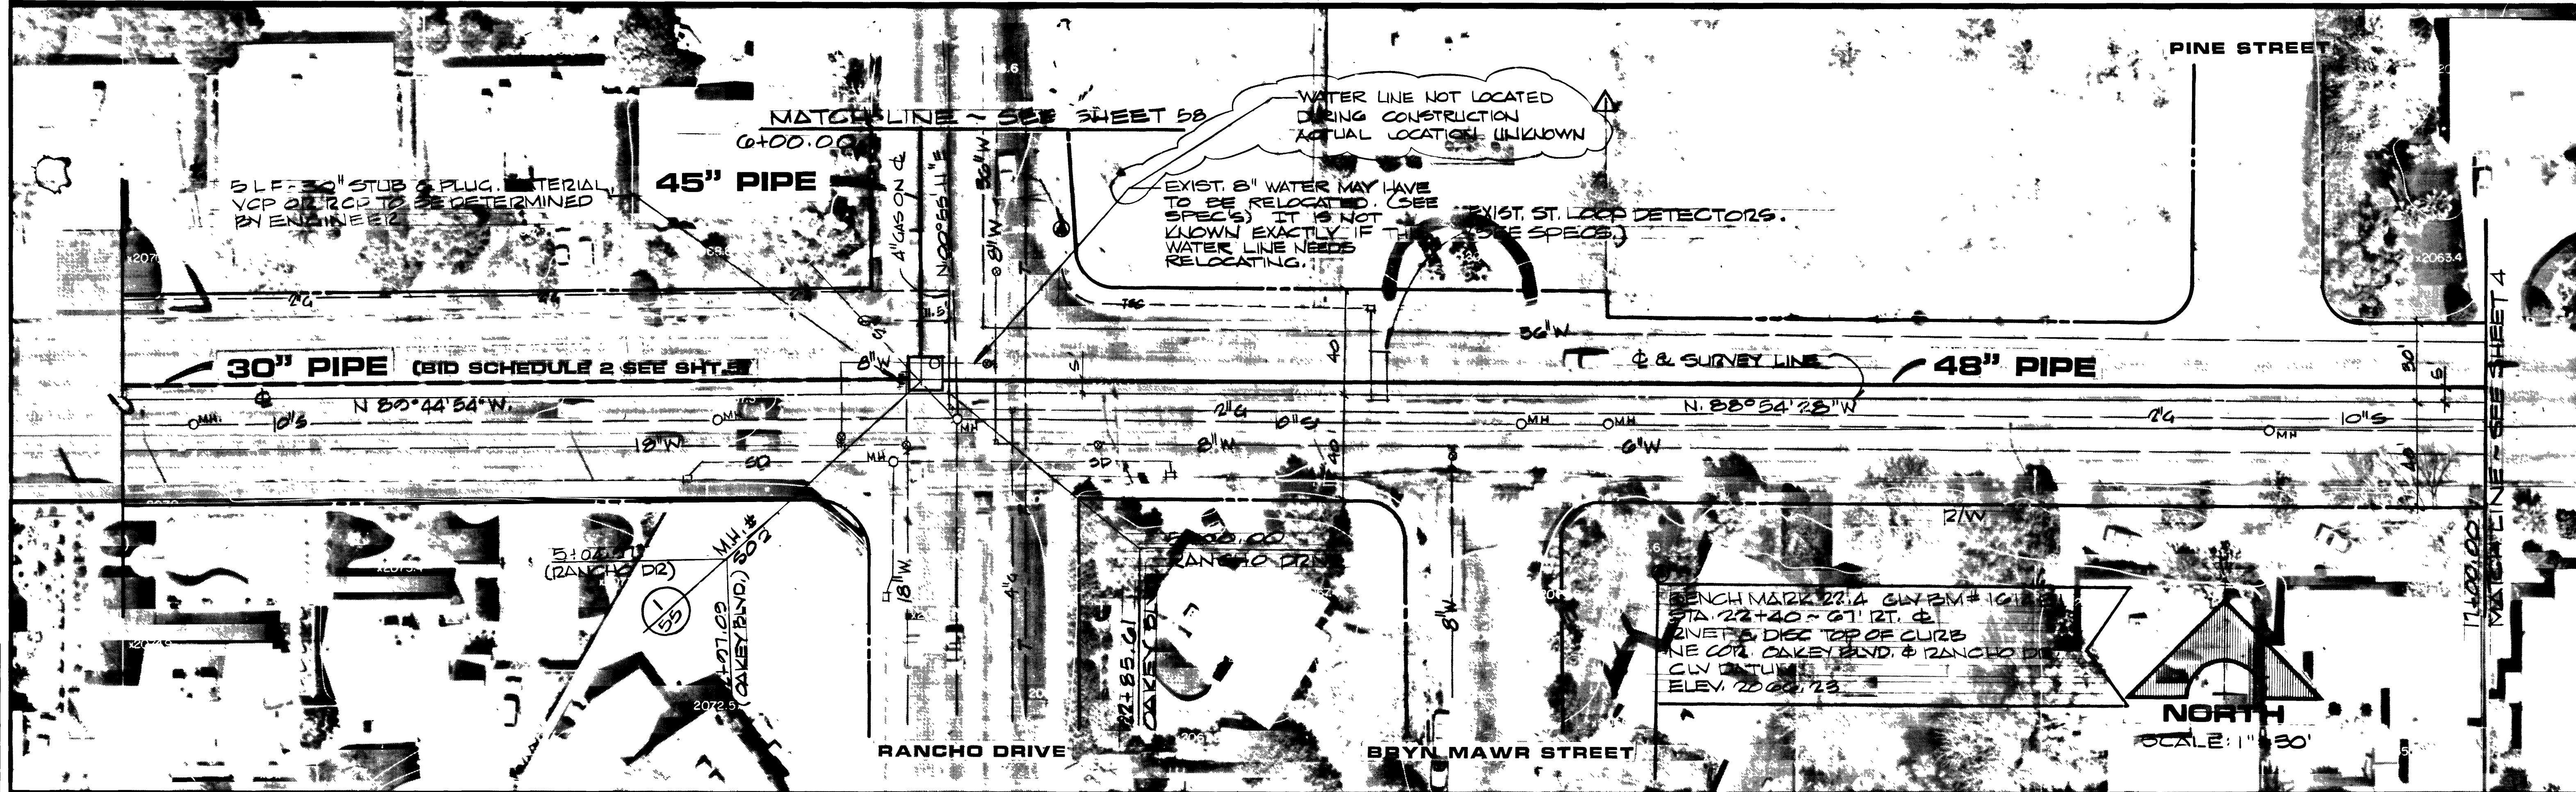


JOB NO. 412.140

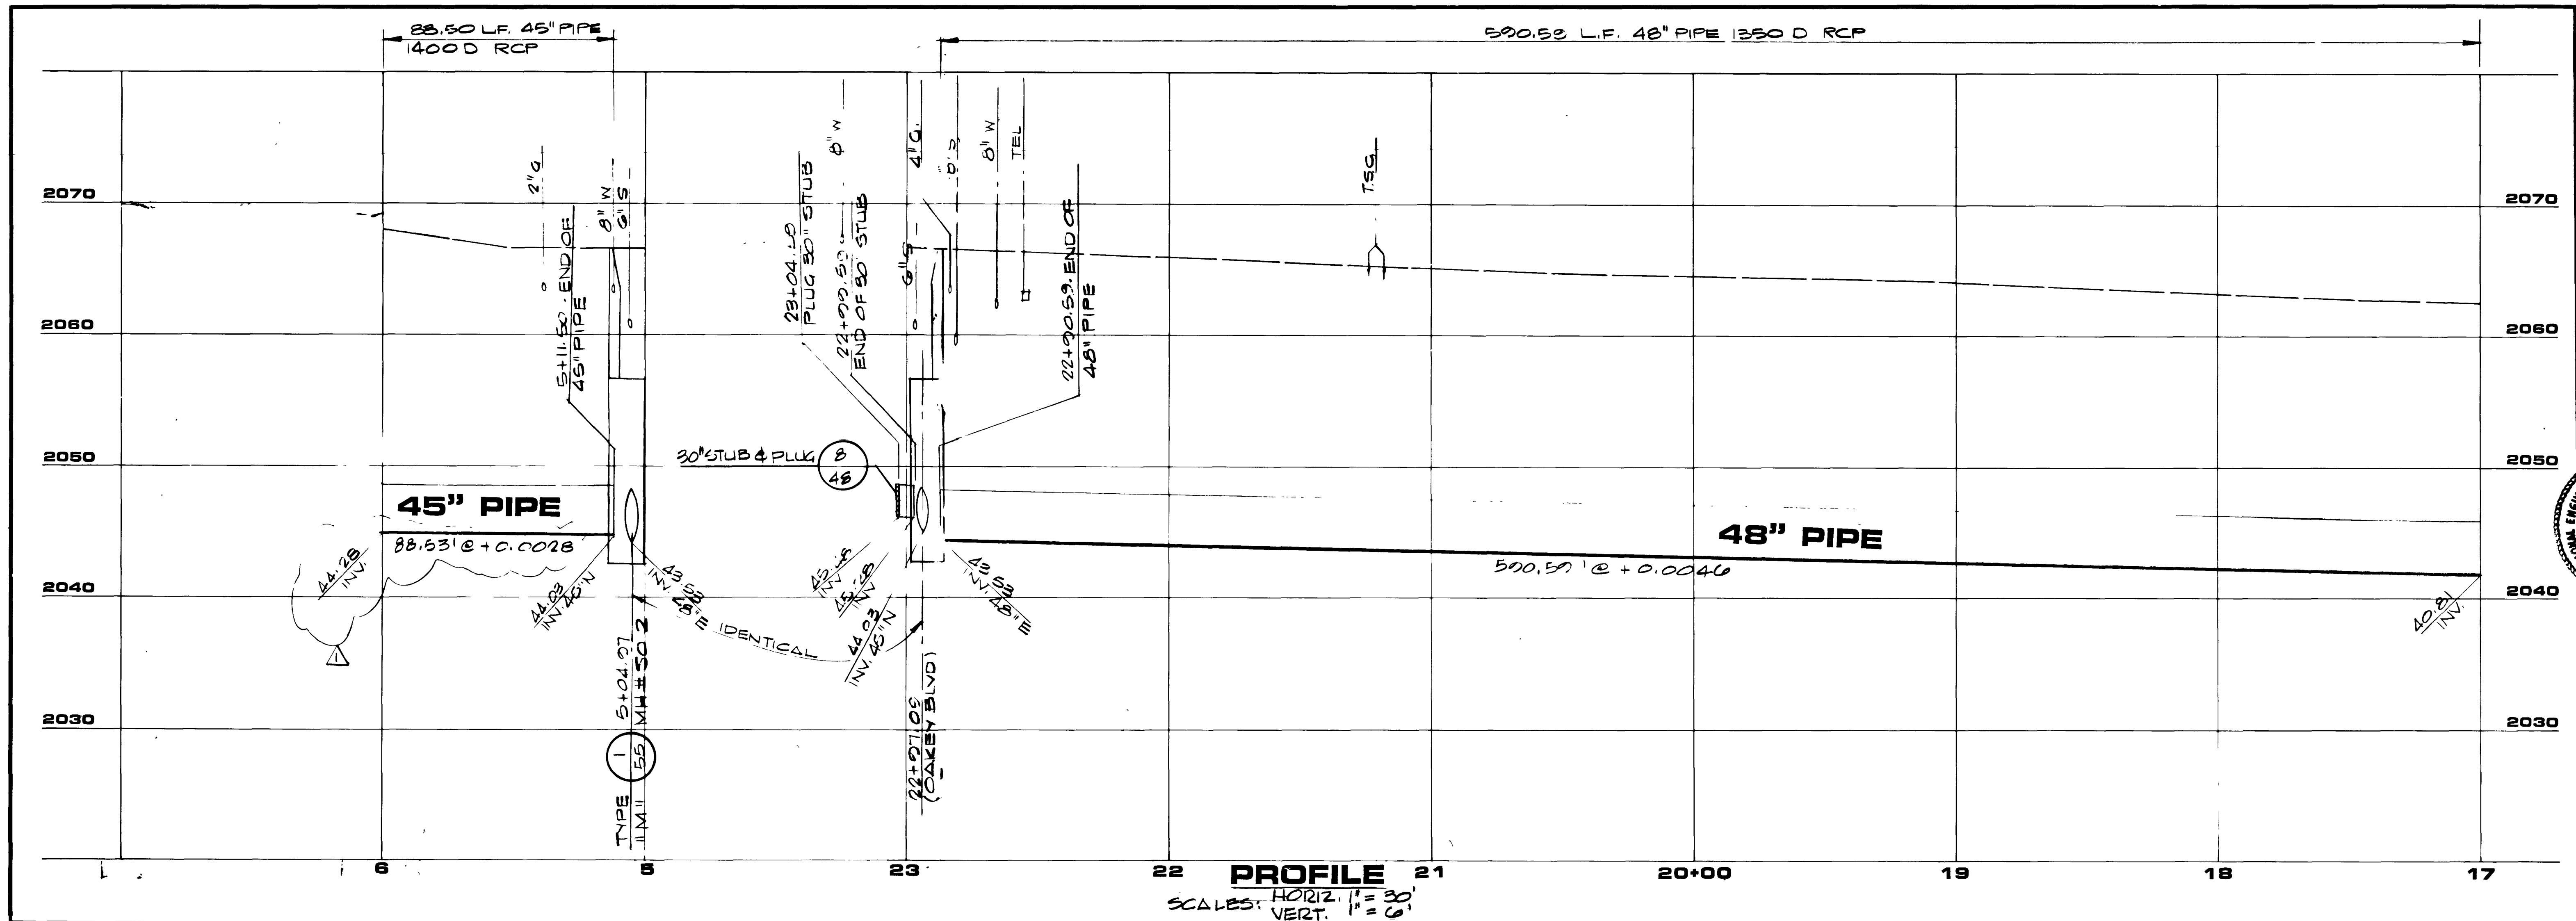


REV	DATE	DESCRIPTION
1	7/20/88	ISSUED FOR RFP
2	7/20/88	AS BUILT

ENGINEER: G. C. WALLACE
CONSULTING ENGINEERS, INC.
1100 East Sahara Ave., Las Vegas, Nevada 89104 • 732-3330

Department of Public Services
SAHARA-OAKLEY SEWER INTERCEPTOR
PLAN & PROFILE OAKLEY BLVD.
17+00 TO 23+05
RANCHO DR. 5+00 TO 6+00

SHEET
57
OF 65 SHEETS

RS 417 307-V563 287-135

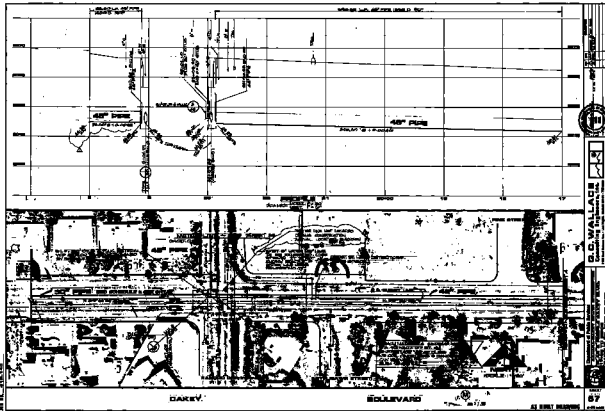

G. D. WALLACE
 Consulting Engineer, Inc.
 1000 15th Street, N.W.
 Washington, D.C. 20004

PROJECT NO. 67
DATE 10/1/55
BY G.D.W.
CHECKED G.D.W.

67