


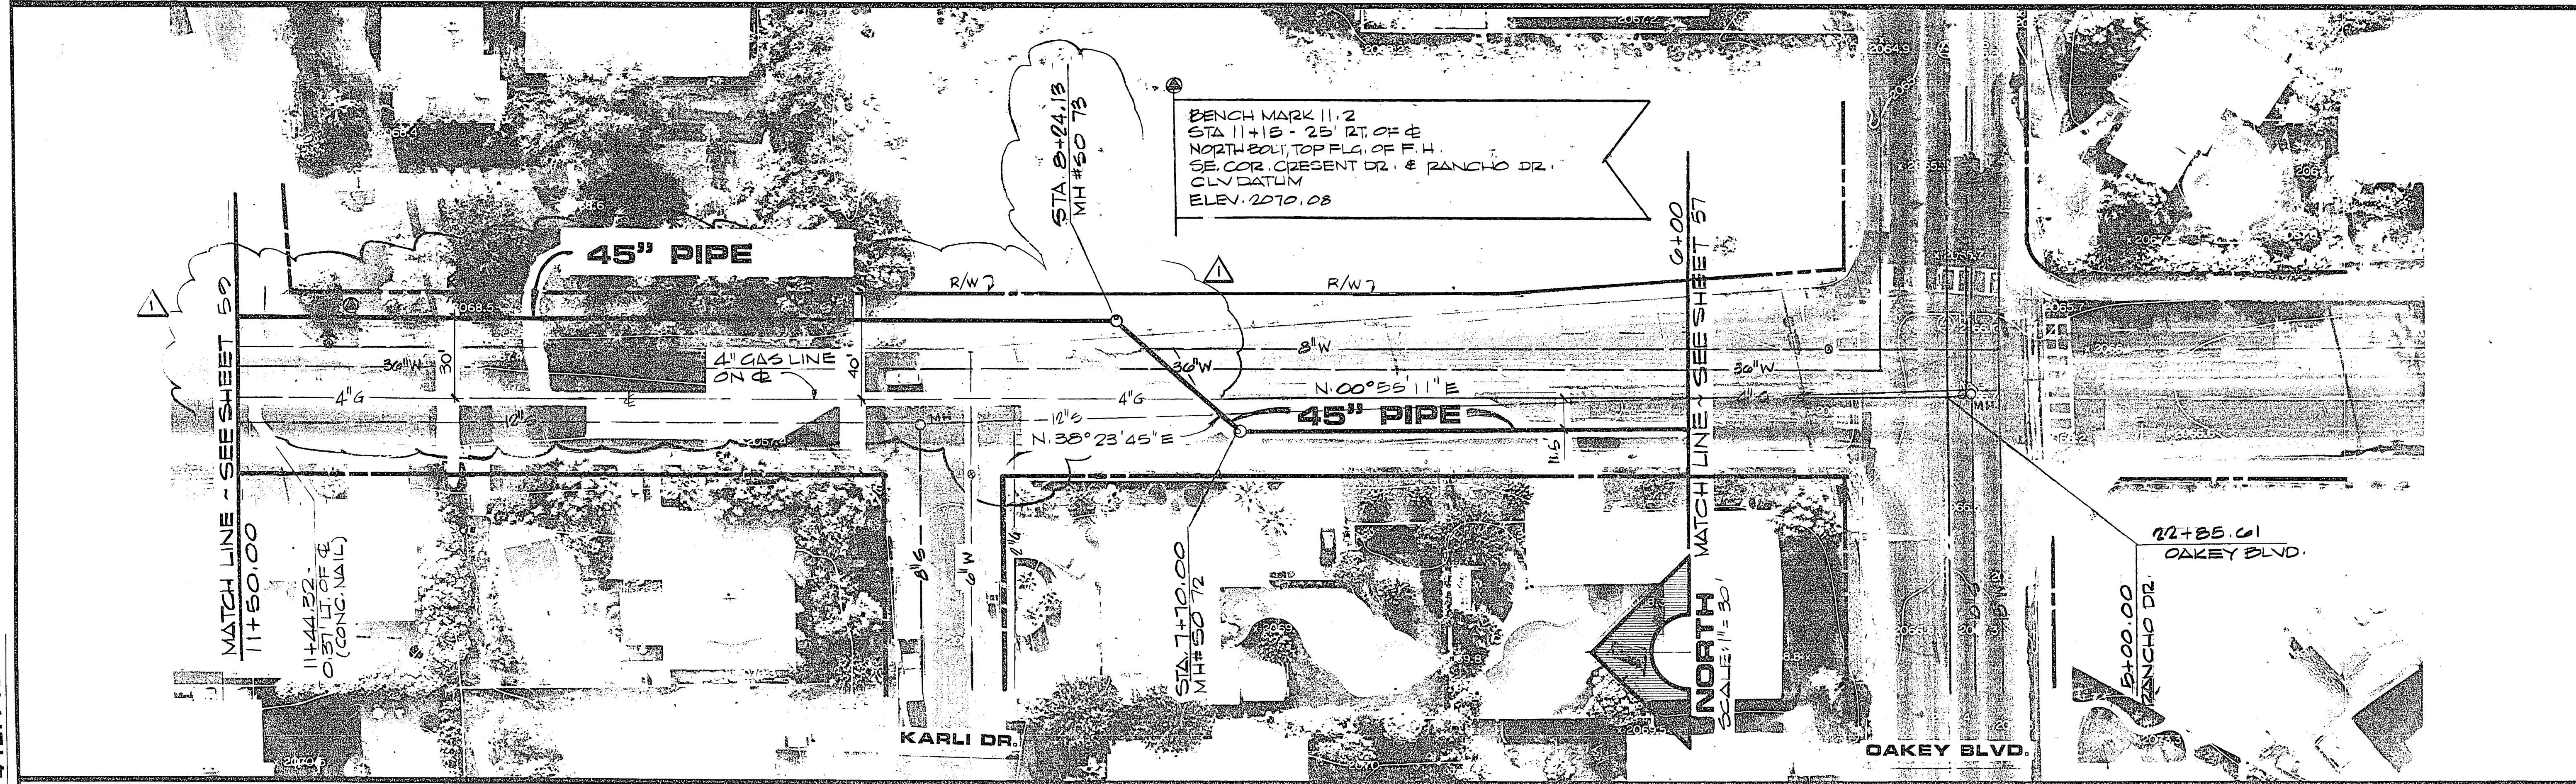


RANCHO

DRIVE



AS BUILT DRAWING

SHEET
58
OF 65 SHEETS

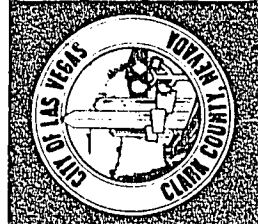


Department of Public Services
SAHARA-OAKLEY SEWER INTERCEPTOR
PLAN & PROFILE
RANCHO DR. STA. 6+00 TO 11+50

G.C. WALLACE
Consulting Engineers, Inc.
1100 East Sahara Ave. • Las Vegas, Nevada 89104 • 732-3330

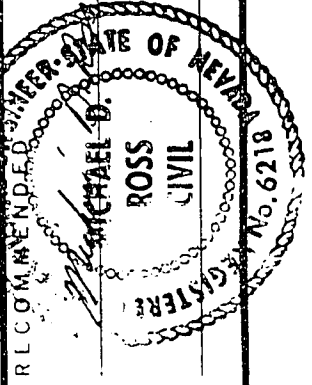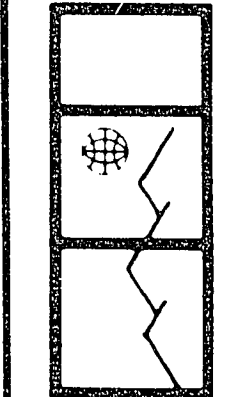

REV	DATE	DESCRIPTION
1	10/14/04	CHANGED PIPE AND EAST ROW
2	4/25/03	DESIGN
3	4/25/03	AS BUILT - NO REVISIONS

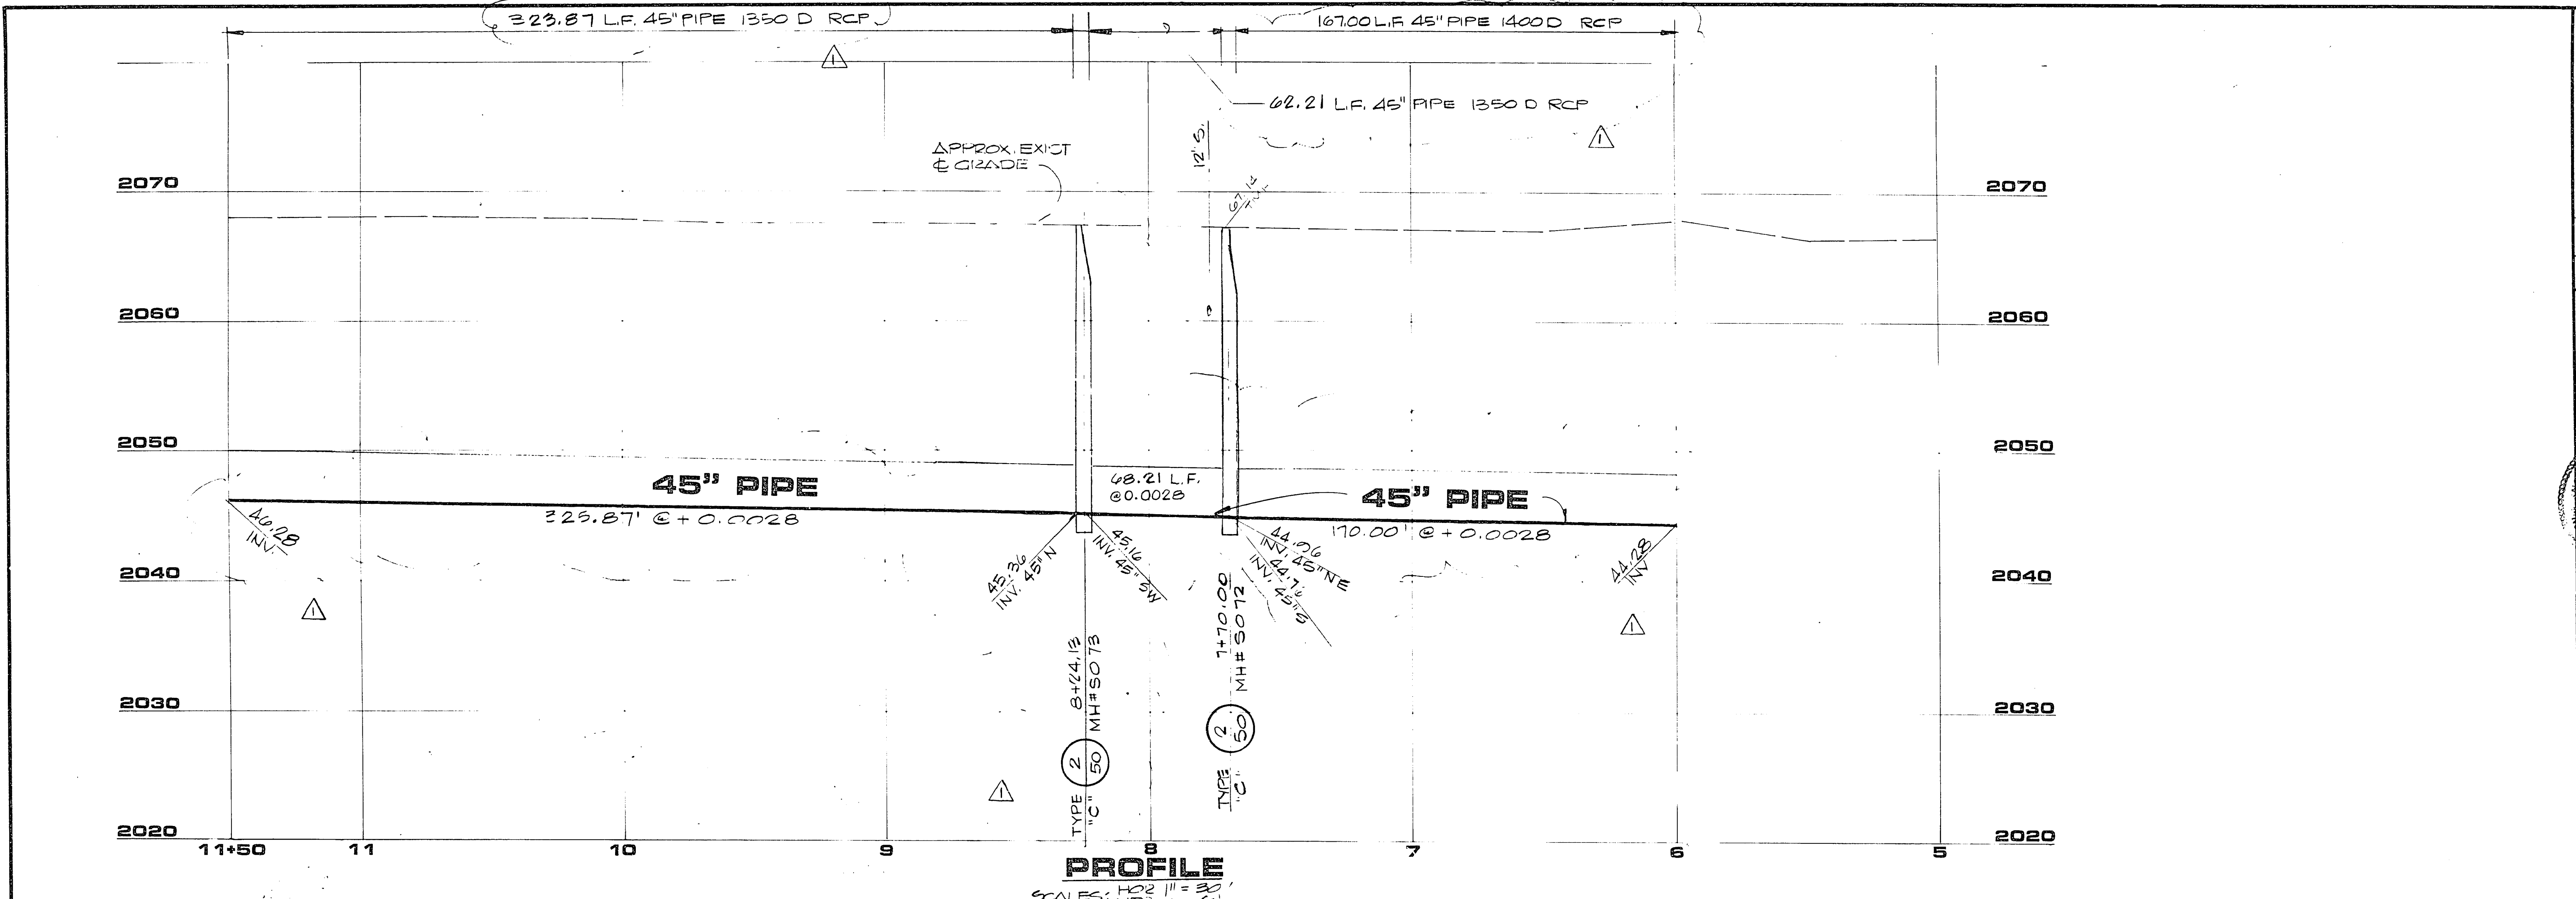

PROFILE
SCALES: HORIZ. 1" = 30'
VERT. 1" = 6'