
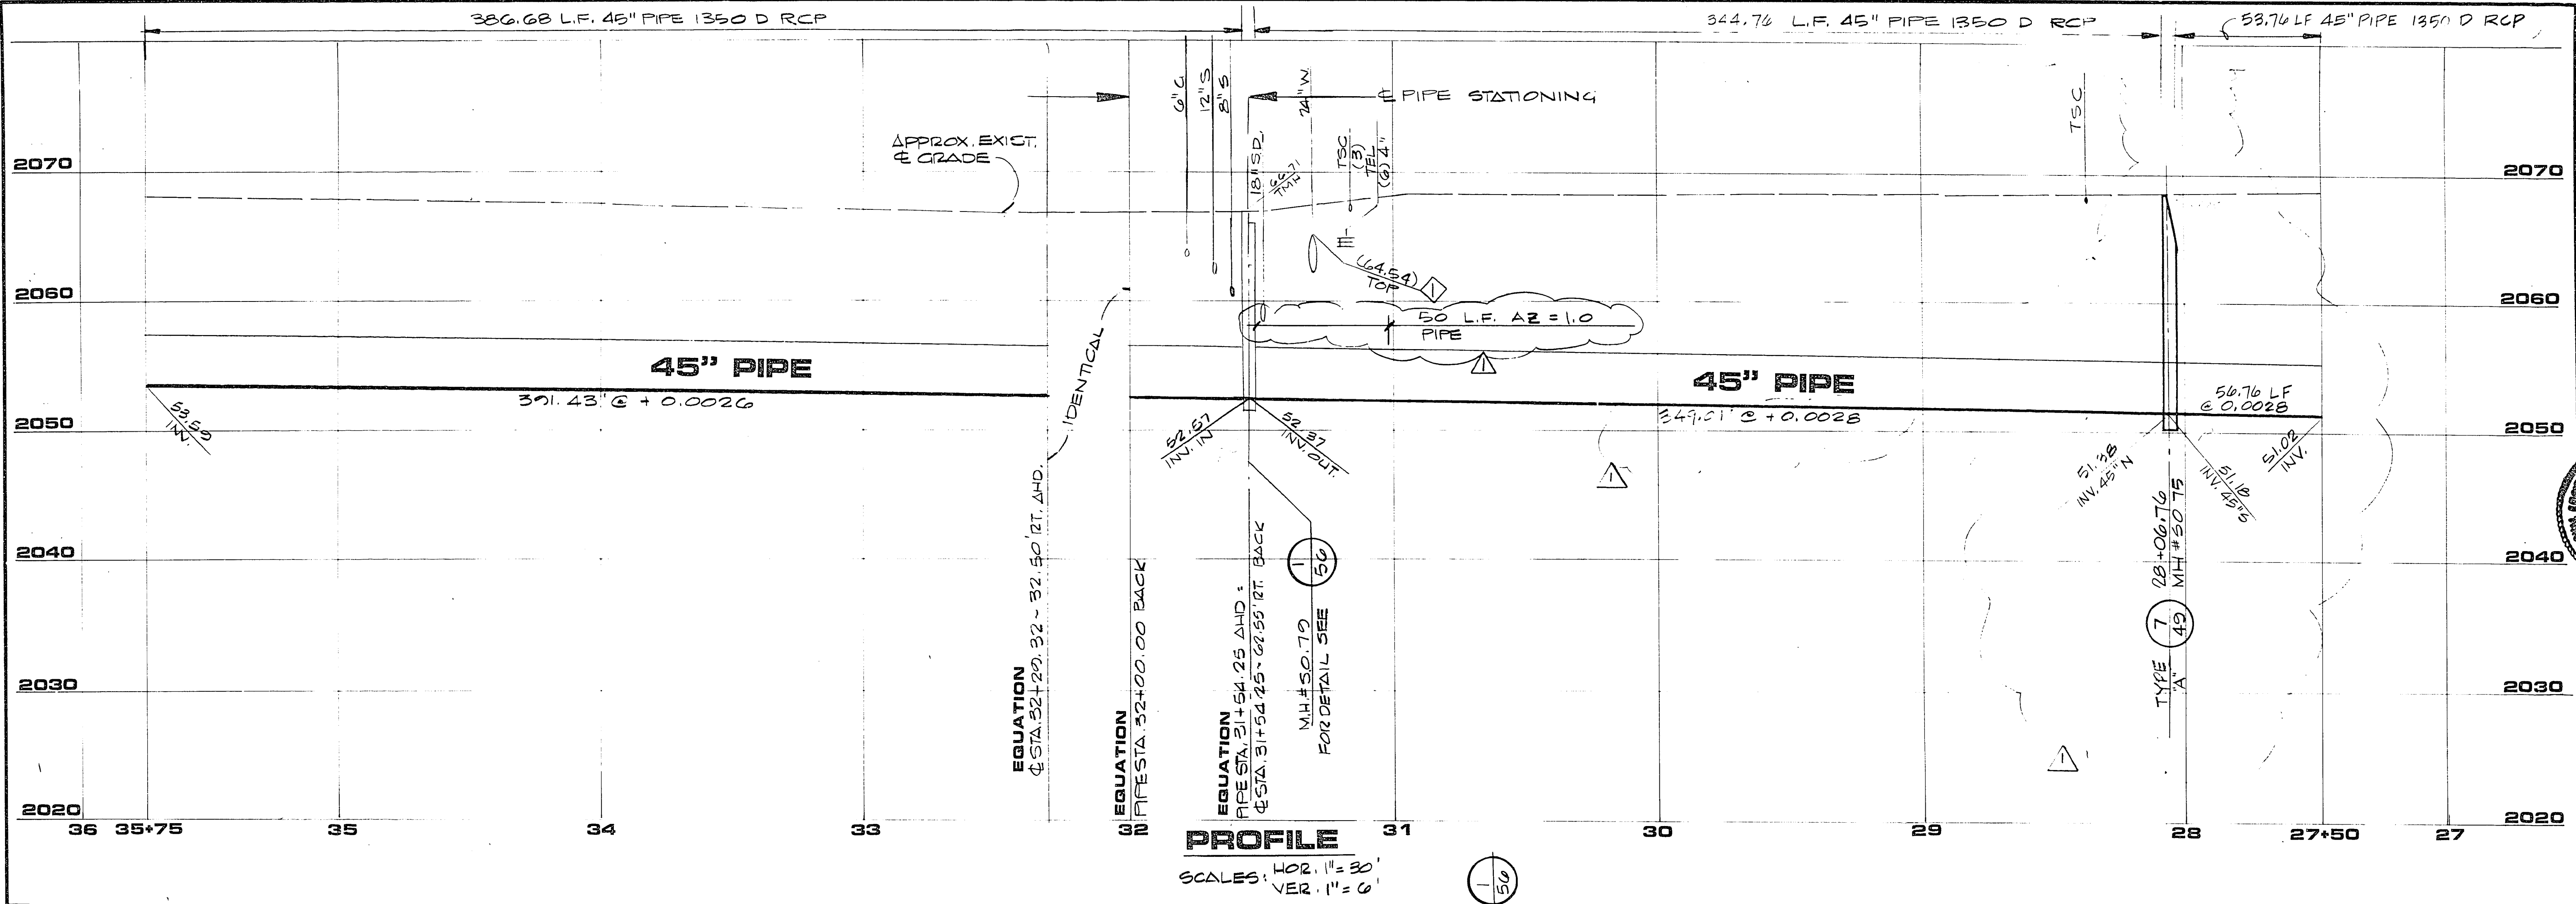


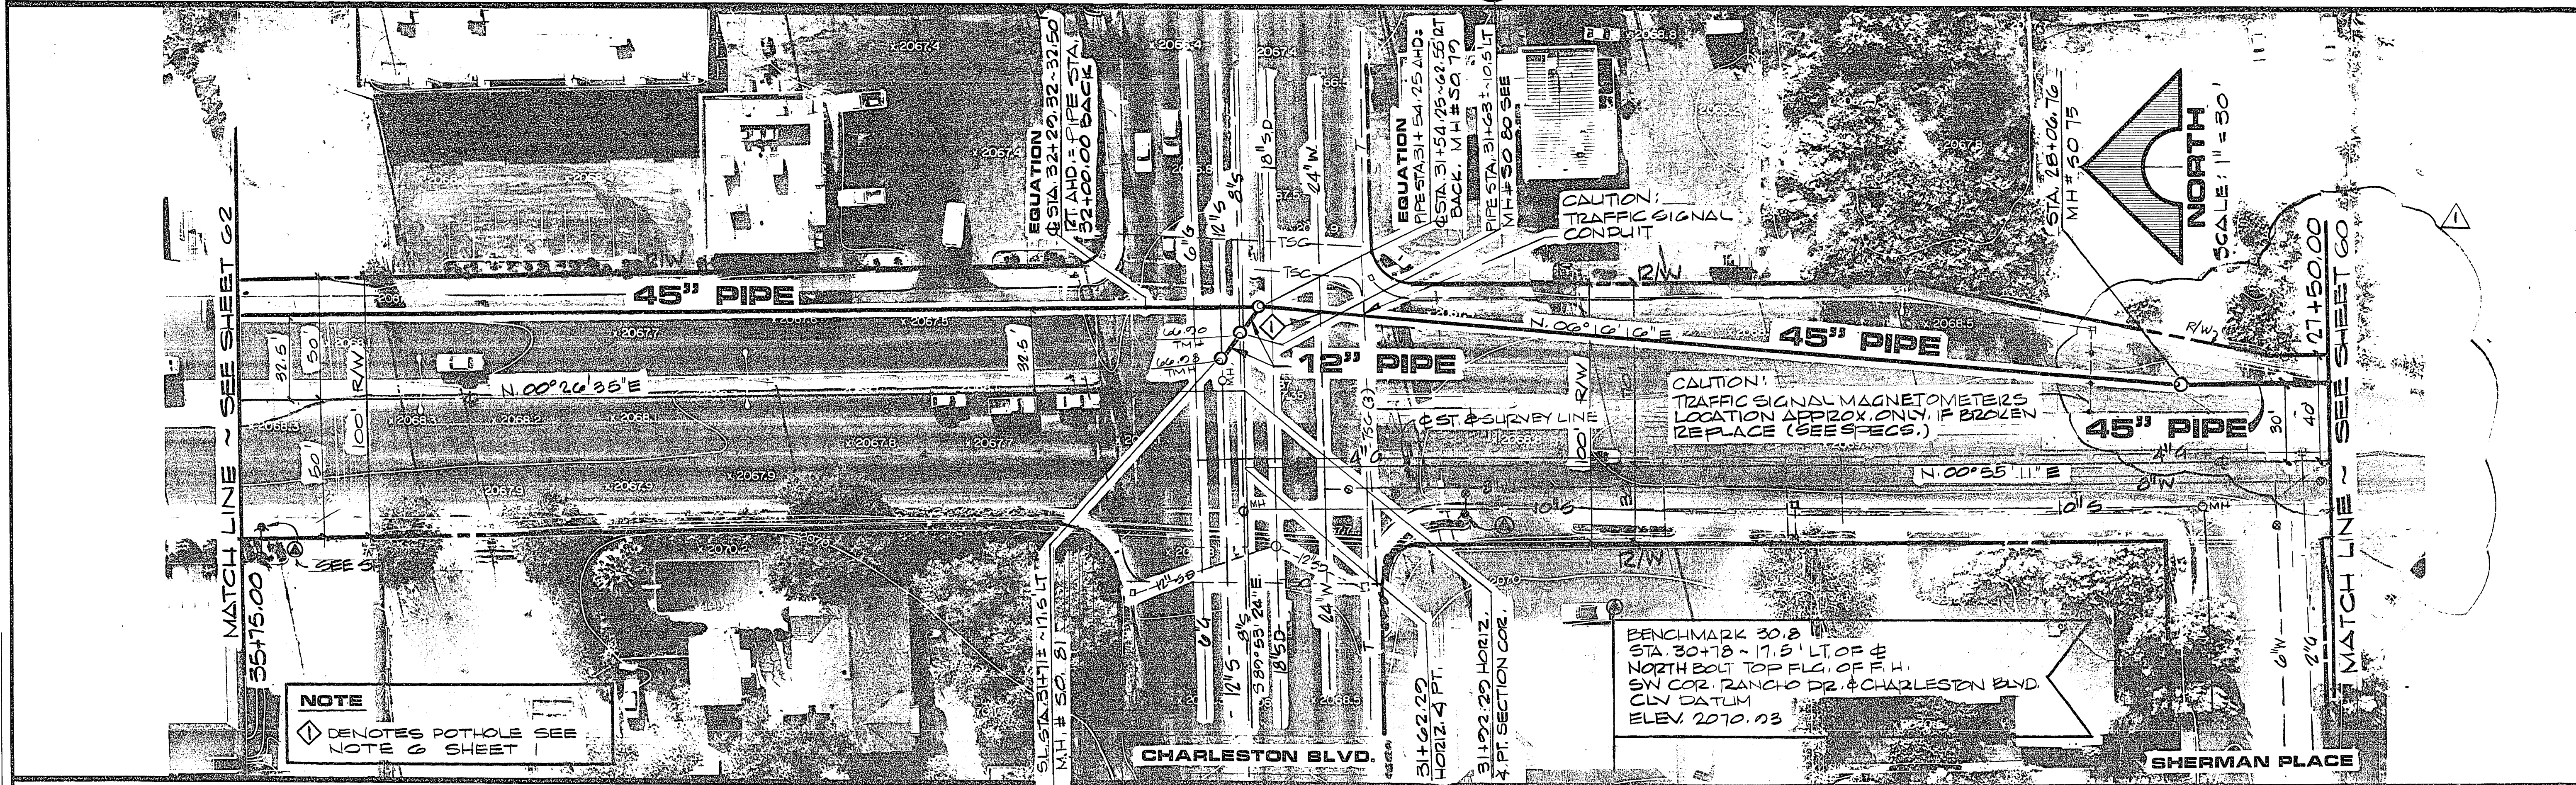

REVISIONS		DESCRIPTION
REV	DATE	
1	10/01/04	MOVED "SEWER" & "RW"
2	11/06/04	"AS BUILT"
PROJECT NO. 722-3330		DATE 11/06/04
R.E. NO. 722-3330		
G.C. WALLACE Consulting Engineers, Inc. 1100 East Sahara Ave. - Las Vegas, Nevada 89104 - 732-3330		
Department of Public Services SAHARA-DAKEY SEWER INTERCEPTOR PLAN & PROFILE RANCHO DR. STA. 27+50 TO 35+75		
SHEET 61 OF 65 SHEETS		

AS BUILT DRAWING