
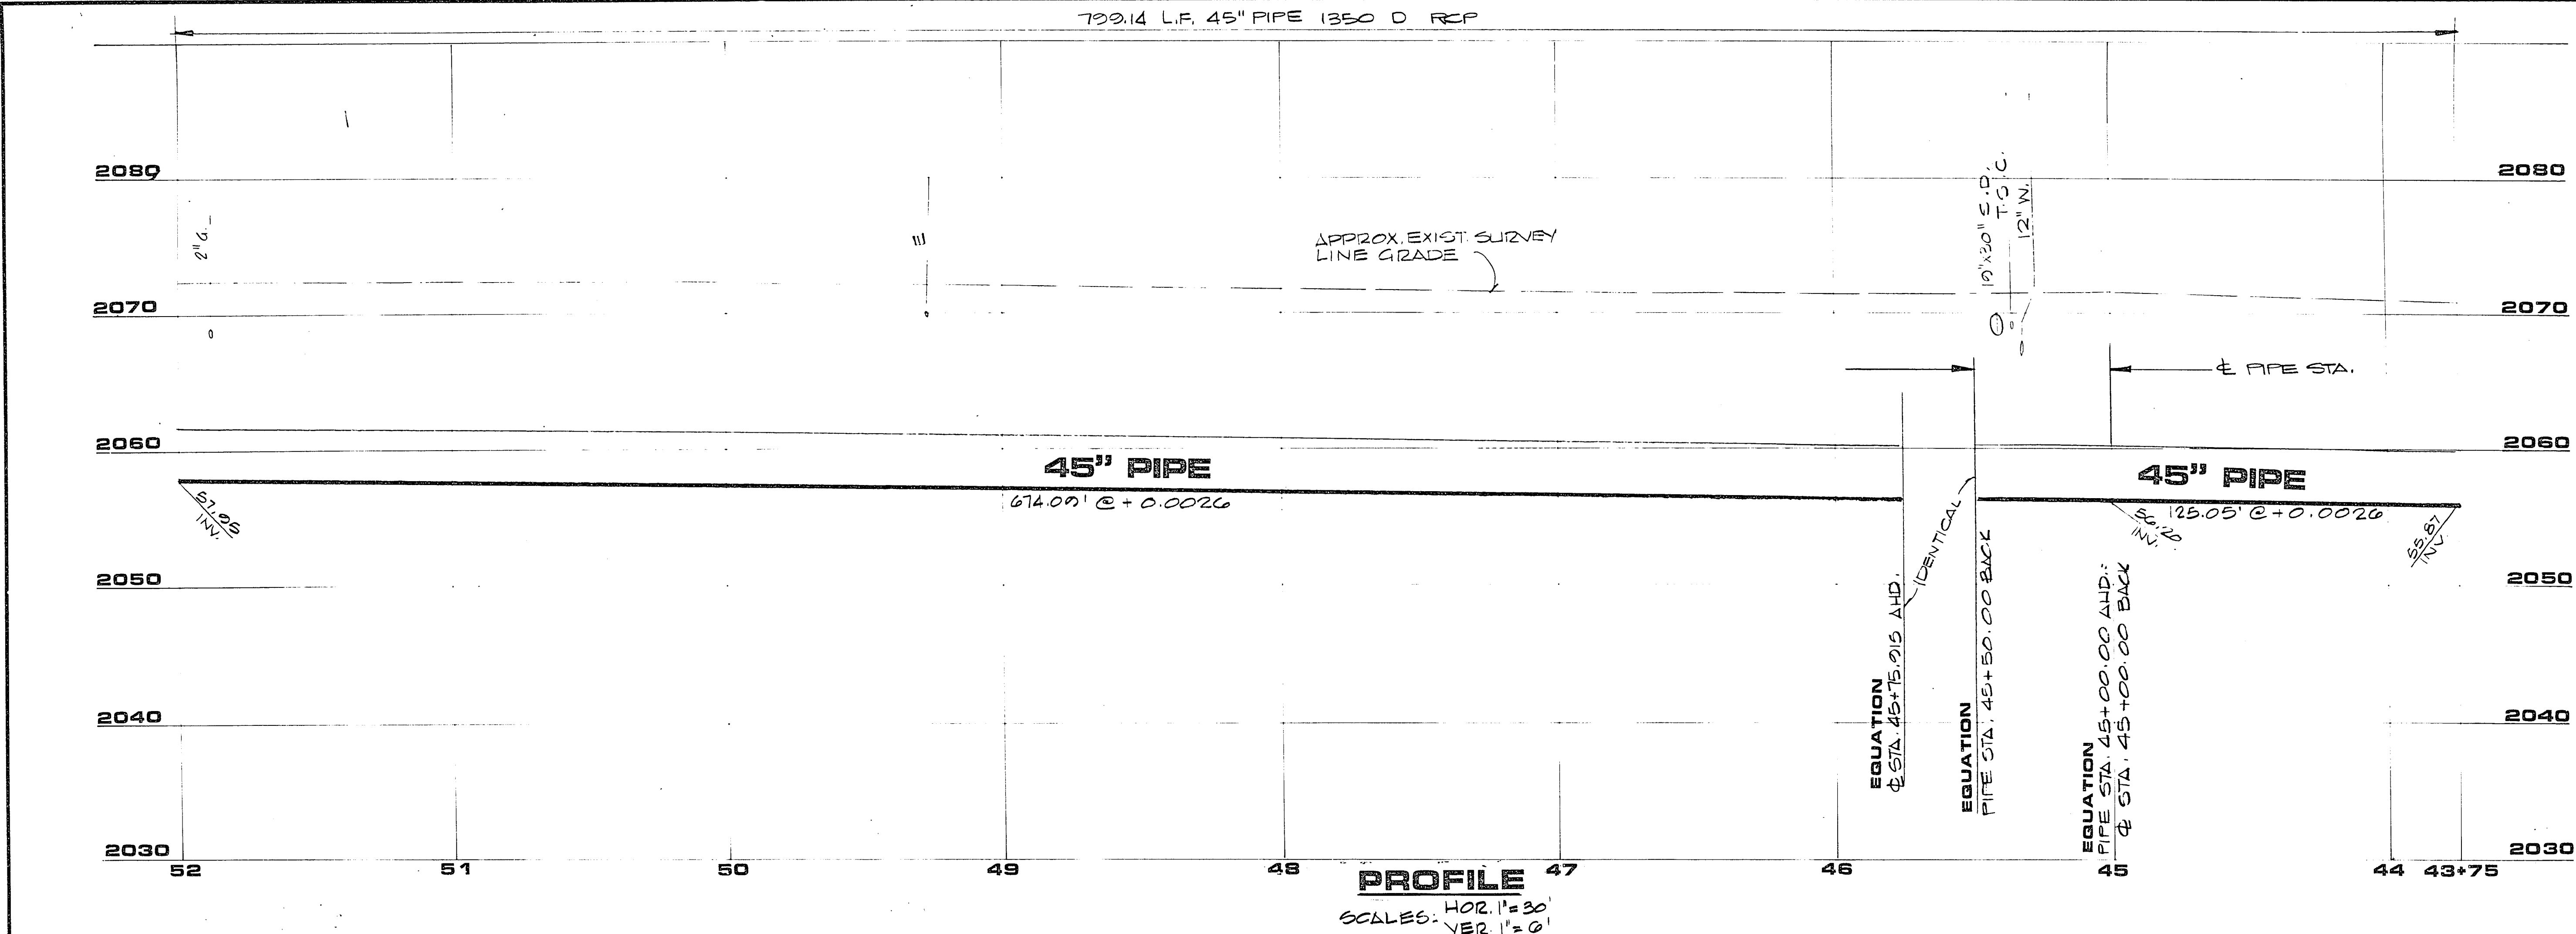


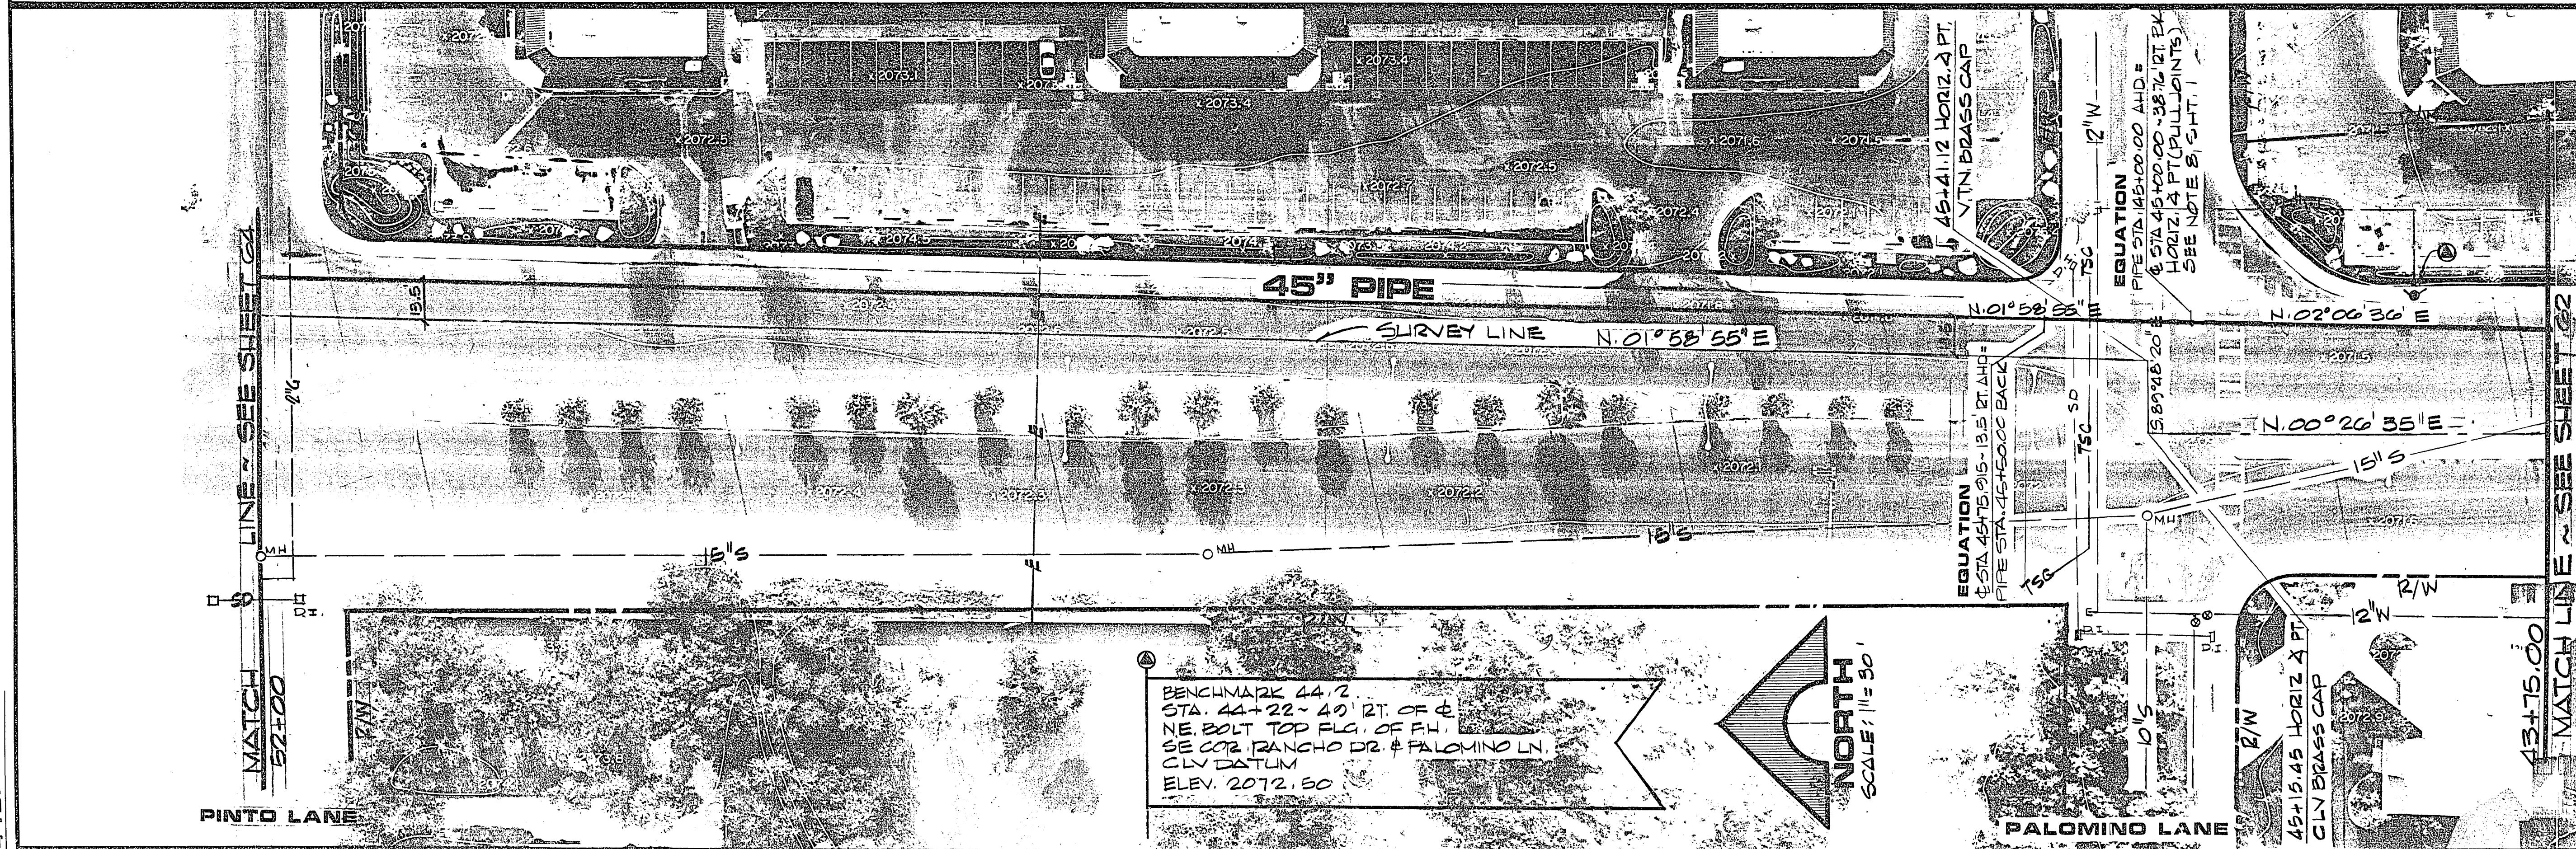

REV	DATE	DESCRIPTION
1	7/25/23	AS BUILT - L&S REVISIONS

7/25/23
R.E. NO. DATE

G.C. WALLACE
Consulting Engineers, Inc.
1100 East Sahara Ave. • Las Vegas, Nevada 89104 • 732-3330

Department of Public Services
SAHARA-OAKLEY SEWER INTERCEPTOR
PLAN & PROFILE
RANCHO DR. STA. 43+75 TO 52+00

SHEET
63
OF 65 SHEETS