
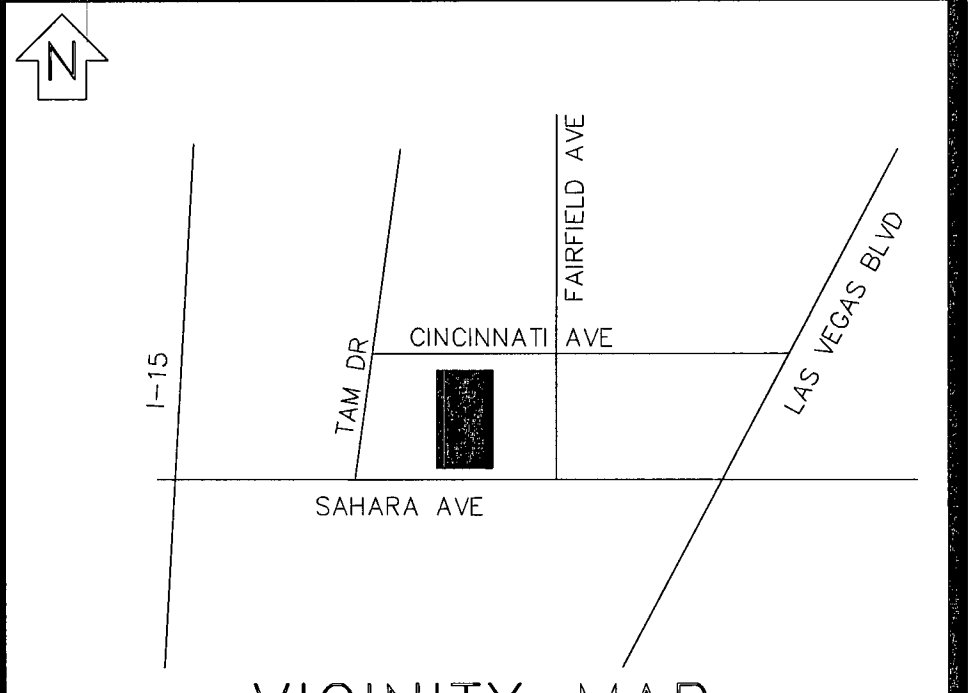


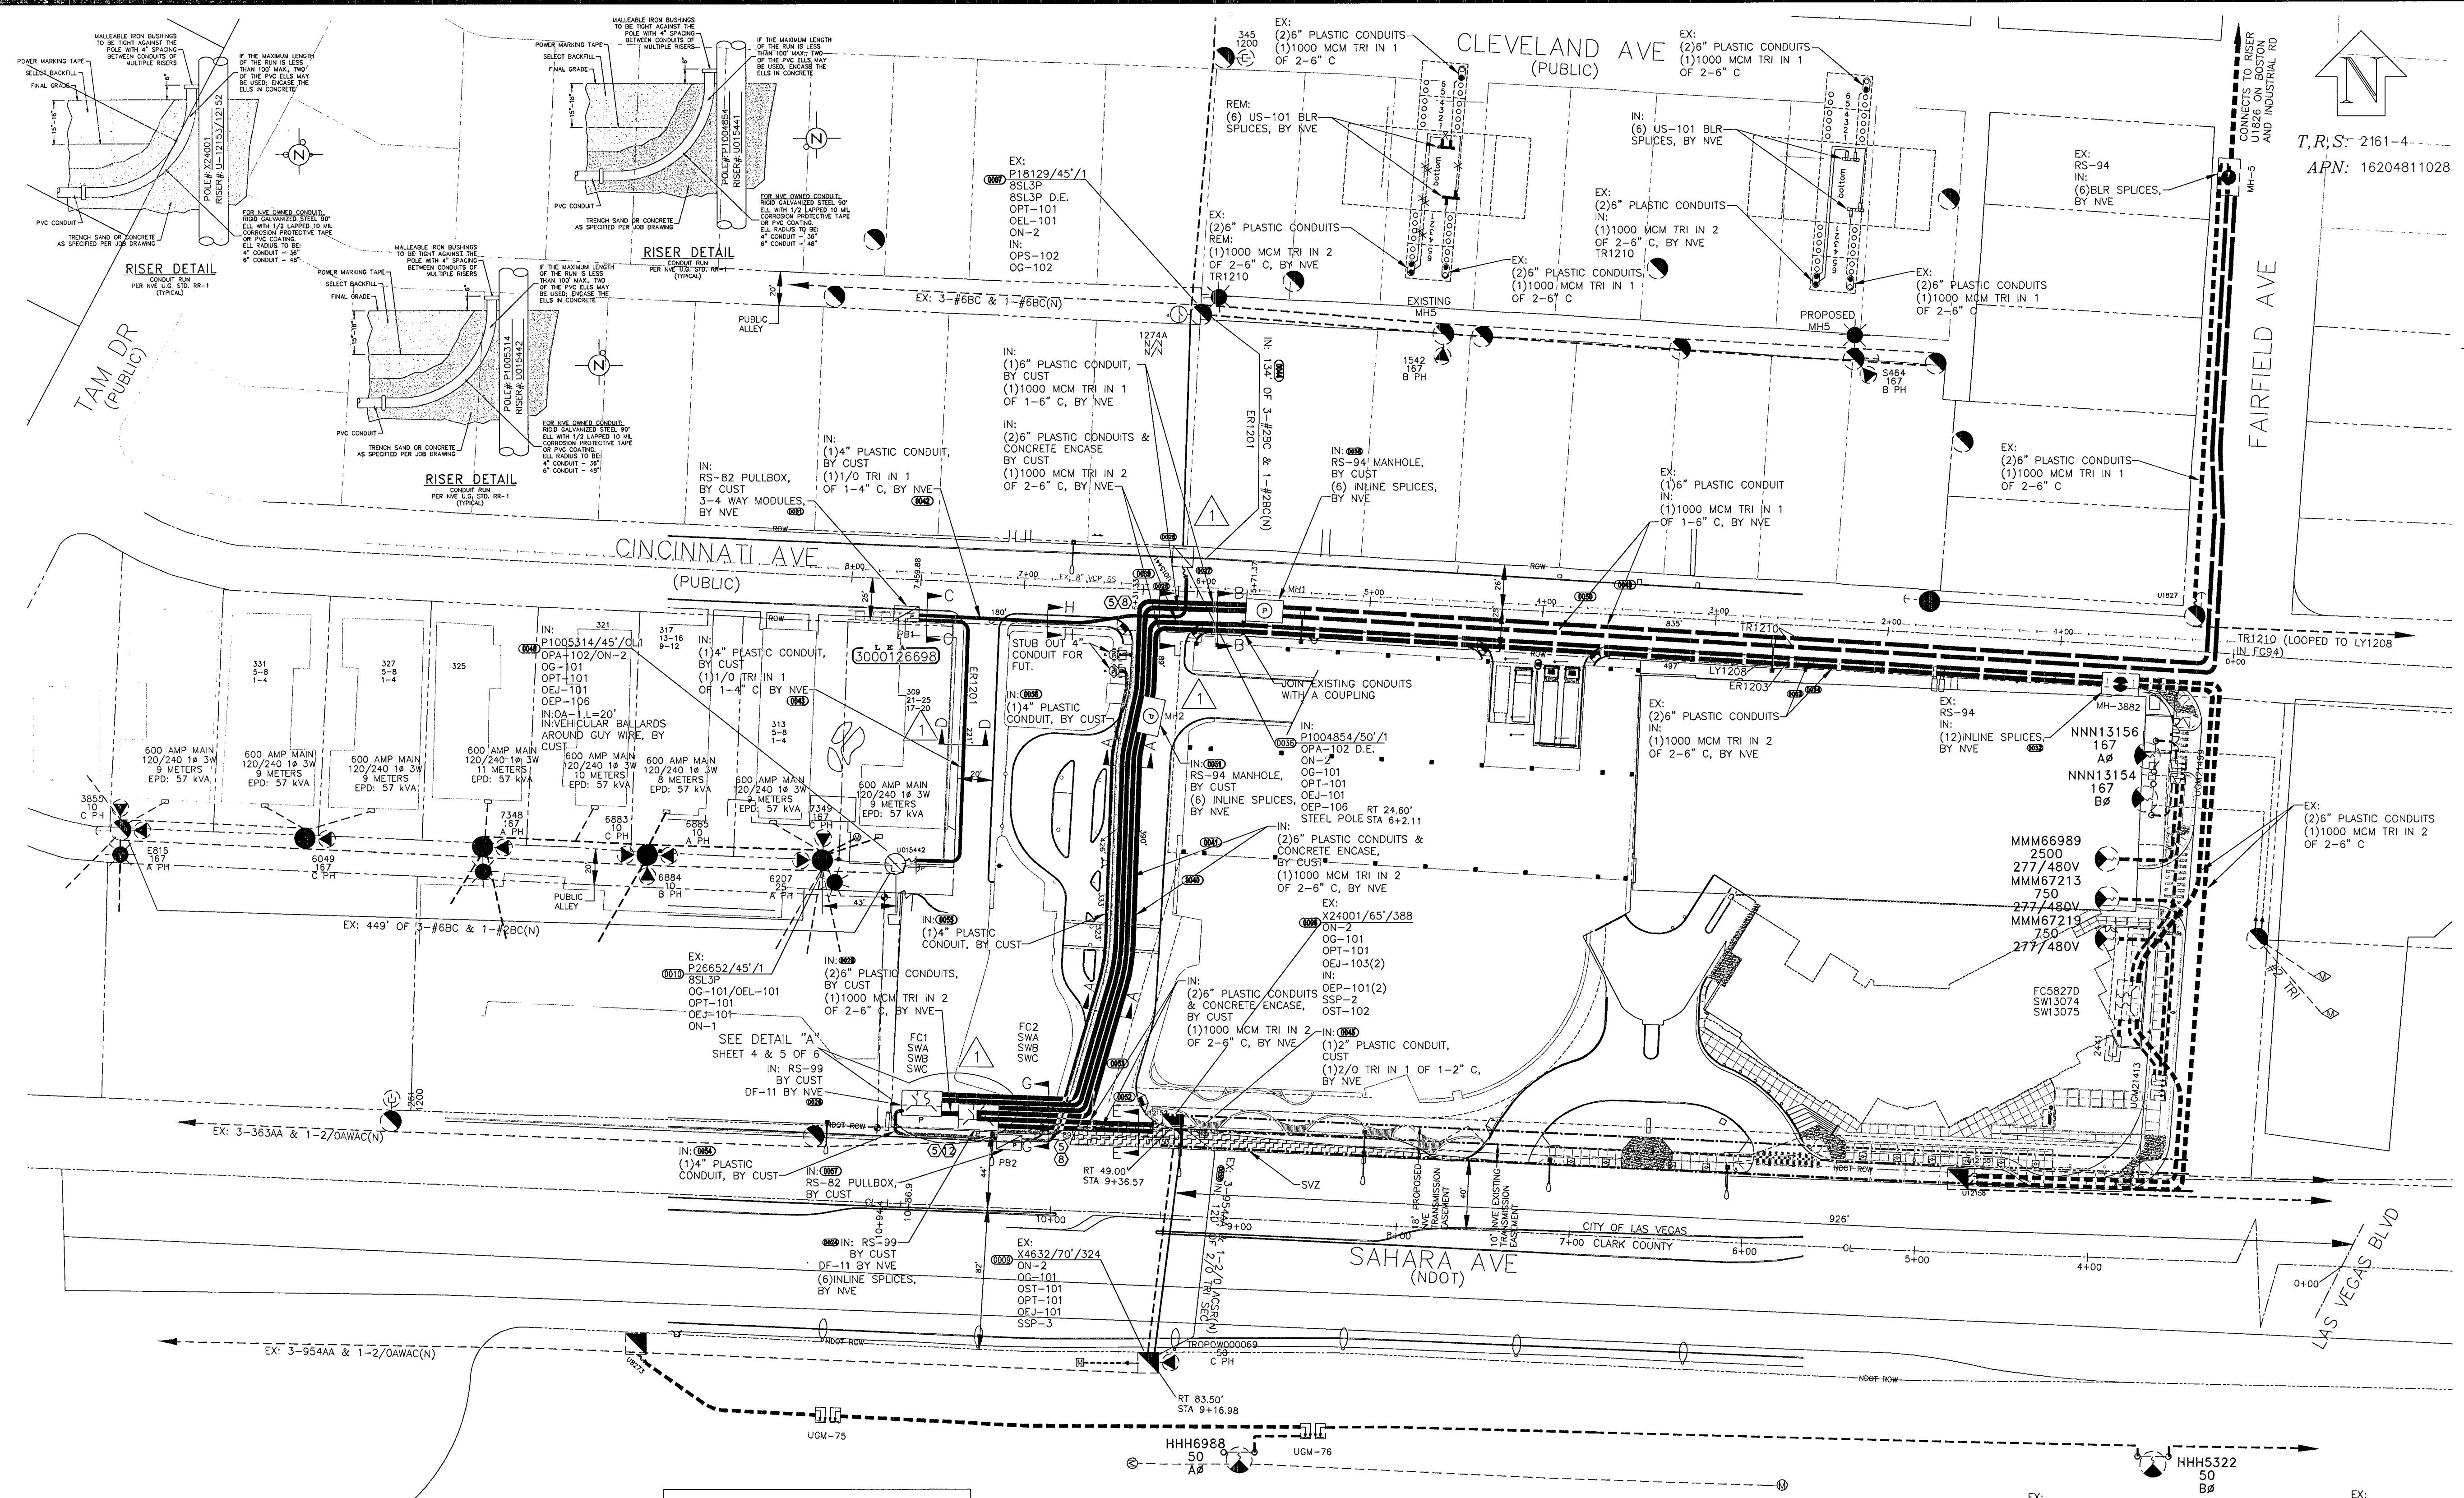

VICINITY MAP
(NOT TO SCALE)

EVERY EFFORT HAS BEEN MADE TO IDENTIFY ALL NVE FACILITIES. THE CUSTOMER SHALL CONFIRM THE EXISTENCE AND LOCATION OF THESE FACILITIES.

AVOID HITTING OVERHEAD POWER LINES. IT'S COSTLY.

Call before you Dig
Call 811
1-800-227-2800
CLARK COUNTY ROAD OPERATIONS
1-702-455-7544

NO.	DESCRIPTION	DATE	G.A.
1	RELOCATE SWITCHES FROM CINCINNATI TO SAHARA. MOVE POLE TO NORTH SIDE OF CINCINNATI PER CUST REQUEST, BY DT	04/17/2014	PK
2	MOVE SWITCHES TO SIT PARALLEL WITH SAHARA PER CUST. REQUEST, BY DT. ADD STA. AND OFFSET	07/24/2014	
3	CHANGE SPACING BETWEEN 6" CONDUIT TRENCHES FROM 48" TO 24" (SHT 4 OF 6).	07/30/2014	

TYPE OF EASEMENT:	JPA NOTES:
☐ AERIAL STANDARD	☐ EMBARK CONTACT: LEN BELLOWS
☐ R/W-31 UNDERGROUND	☐ PHONE NUMBER: 244-7290
☐ AS BUILT UNDERGROUND	☐ DATE OF CONTACT: 05/09/2012
☐ R.O.E./R/W-5-COM	☐ NVE TO SET NEW POLES
☐ 3rd PARTY UNDERGROUND BY EXHIBIT	☐ NVE TO STAKE NEW POLES
☐ (N-DOT) PERMIT	☐ NVE TO PROVIDE 2 POLES
☐ (BLM) PERMIT	☐ 1 30' FT. CLASS STEEL
☐ RAILROAD-UPRR-PERMIT	☐ 1 45' FT. CLASS 1
☐ SO. NEVADA WATER PERMIT	☐ 1 60' FT. CLASS
☐ NOT REQUIRED	☐ NVE TO DIS POLE HOLES
☐ Misc. Info.	☐ NVE TO REMOVE EX. POLES
	☐ REM: 5 EXISTING POLES FOR FUT. DEVELOP.
	JPA#: P201210902

EXHIBIT 'A'	
NVE INFORMATION:	
COORDINATOR:	DON JACKSON
PHONE:	402-6815
DESIGNER:	DARRYL THOMAS D.F.
DCA:	
INSPECTOR:	402-3008
STAND BY:	402-4117, 402-4116, 402-4118
DISTRICT:	LAS VEGAS NORTH
CUSTOMER INFORMATION:	
APPLICANT:	LUCKY DRAGON LLC
ENGINEER:	GC WALLACE
CONTACT:	ROY CLARK 804-2112
APPROVAL DATE:	09/20/2012
GOVERNMENT INFORMATION:	
AGENCY:	CITY OF LAS VEGAS
APPROVAL DATE:	07/09/2014

FOR EACH SERVICE POINT (POINT OF DELIVERY), ENERGY FOR EACH TENANT SPACE WILL BE MEASURED THROUGH ONE WATTHOUR METER. ENERGY FOR ALL NON-TENANT SPACE WILL BE MEASURED THROUGH ONE WATTHOUR METER. CONTACT NVE METER OPERATIONS FOR MULTIPLE RATE CLASS INSTALLATIONS

NV Energy

LUCKY DRAGON
RELOCATIONS/REMOVALS
SAHARA/FAIRFIELD

107V6191-PLWR

PROJ. ID: 3000126698 SCALE: 1" = 50'

SHEET #: 3 OF 6 DATE: 03/29/2012

- RTC NOTES:**
BACKFILL AND RIGHT OF WAY RESTORATION SHALL CONFORM TO CLARK COUNTY UNIFORM STANDARD DRAWINGS
- 500.1 0 TO 5 YEARS PAVEMENT RESTORATION LONGITUDINAL CUT
 - 500.2 0 TO 5 YEARS PAVEMENT RESTORATION TRANSVERSE CUT
 - 500.3 OVER 5 YEARS PAVEMENT RESTORATION LONGITUDINAL CUT, GREATER THAN 60" R.O.W
 - 500.4 OVER 5 YRS PAVEMENT RESTORATION LONGITUDINAL CUT, 60" R.O.W OR LESS
 - 500.5 OVER 5 YRS PAVEMENT RESTORATION TRANSVERSE ALL R.O.W WIDTHS
 - 501 TYPICAL UNDERGROUND UTILITY LOCATIONS IN RESIDENTIAL STREETS 60' OR LESS R.O.W.
 - 501.1 TYPICAL UTILITY UNDERGROUND LOCATIONS IN STREETS WITH GREATER THAN 60' R.O.W.
 - 503 METHOD B FOR RIGID AND FLEXIBLE PIPE TRENCH BACKFILL - PAVED AREAS
 - 503.1 METHOD A FOR FLEXIBLE PIPE TRENCH BACKFILL - PAVED AREAS
 - 503.2 METHOD A FOR RIGID PIPE TRENCH BACKFILL - PAVED AREAS
 - BACKFILL IN UNPAVED AREA AS REQUIRED BY LOCAL CODE OR AS APPROVED BY AGENCY.
 - 234 SIDEWALK

CIRCUIT LEGEND

---	LY1208
---	ER1203
---	TR1210

INSTALL SHEET

PURPOSE OF PROJECT:
RELOCATE EXISTING NVE FACILITIES FOR FUTURE DEVELOPMENT

APPROVED FOR CONSTRUCTION
THIS APPROVAL IS FOR WORK IN CLV R/W & EASEMENT ONLY. OBTAINING PERMISSIONS OR EASEMENTS FOR WORK SHOWN ON PRIVATE PROPERTY IS THE RESPONSIBILITY OF THE UTILITY.

APPROVAL _____ DATE _____

SEE SHEET 6 OF 6 FOR TRENCH DETAILS

CLARK COUNTY PUBLIC WORKS PERMIT REQUIRED
DEVELOPER/CONTRACTOR SHALL OBTAIN A COUNTY PERMIT BEFORE ANY EXCAVATION WORK WITHIN CLARK COUNTY RIGHT-OF-WAY.
DATE _____

APPROVED FOR PERMITTING
THIS APPROVAL IS FOR WORK IN CC R/W & EASEMENT ONLY. OBTAINING PERMISSIONS OR EASEMENTS FOR WORK SHOWN ON PRIVATE PROPERTY IS THE RESPONSIBILITY OF THE UTILITY.

NIGHT WORK: ☐ YES ☐ NO
ENCROACHMENT PERMIT # _____

APPROVAL BY: _____ DATE _____

CIVIL LINETYPE LEGEND

	PROPOSED	EXISTING
CENTERLINE	---	---
PROPERTY LINE/ROW	---	---
CURB	---	---
EDGE OF PAVEMENT	---	---
EDGE OF SIDEWALK	---	---
SEWER LINE	---	---
WATER LINE	---	---
GAS LINE	---	---
TELEPHONE LINE	---	---
CABLE TV LINE	---	---
STORM DRAIN LINE	---	---
FIRE HYDRANT	---	---
STREET LIGHT	---	---
STREET LIGHT SERVICE	---	---

* LINETYPES UTILIZED WHERE CONFLICT OCCURS WITH NVE FACILITIES.