



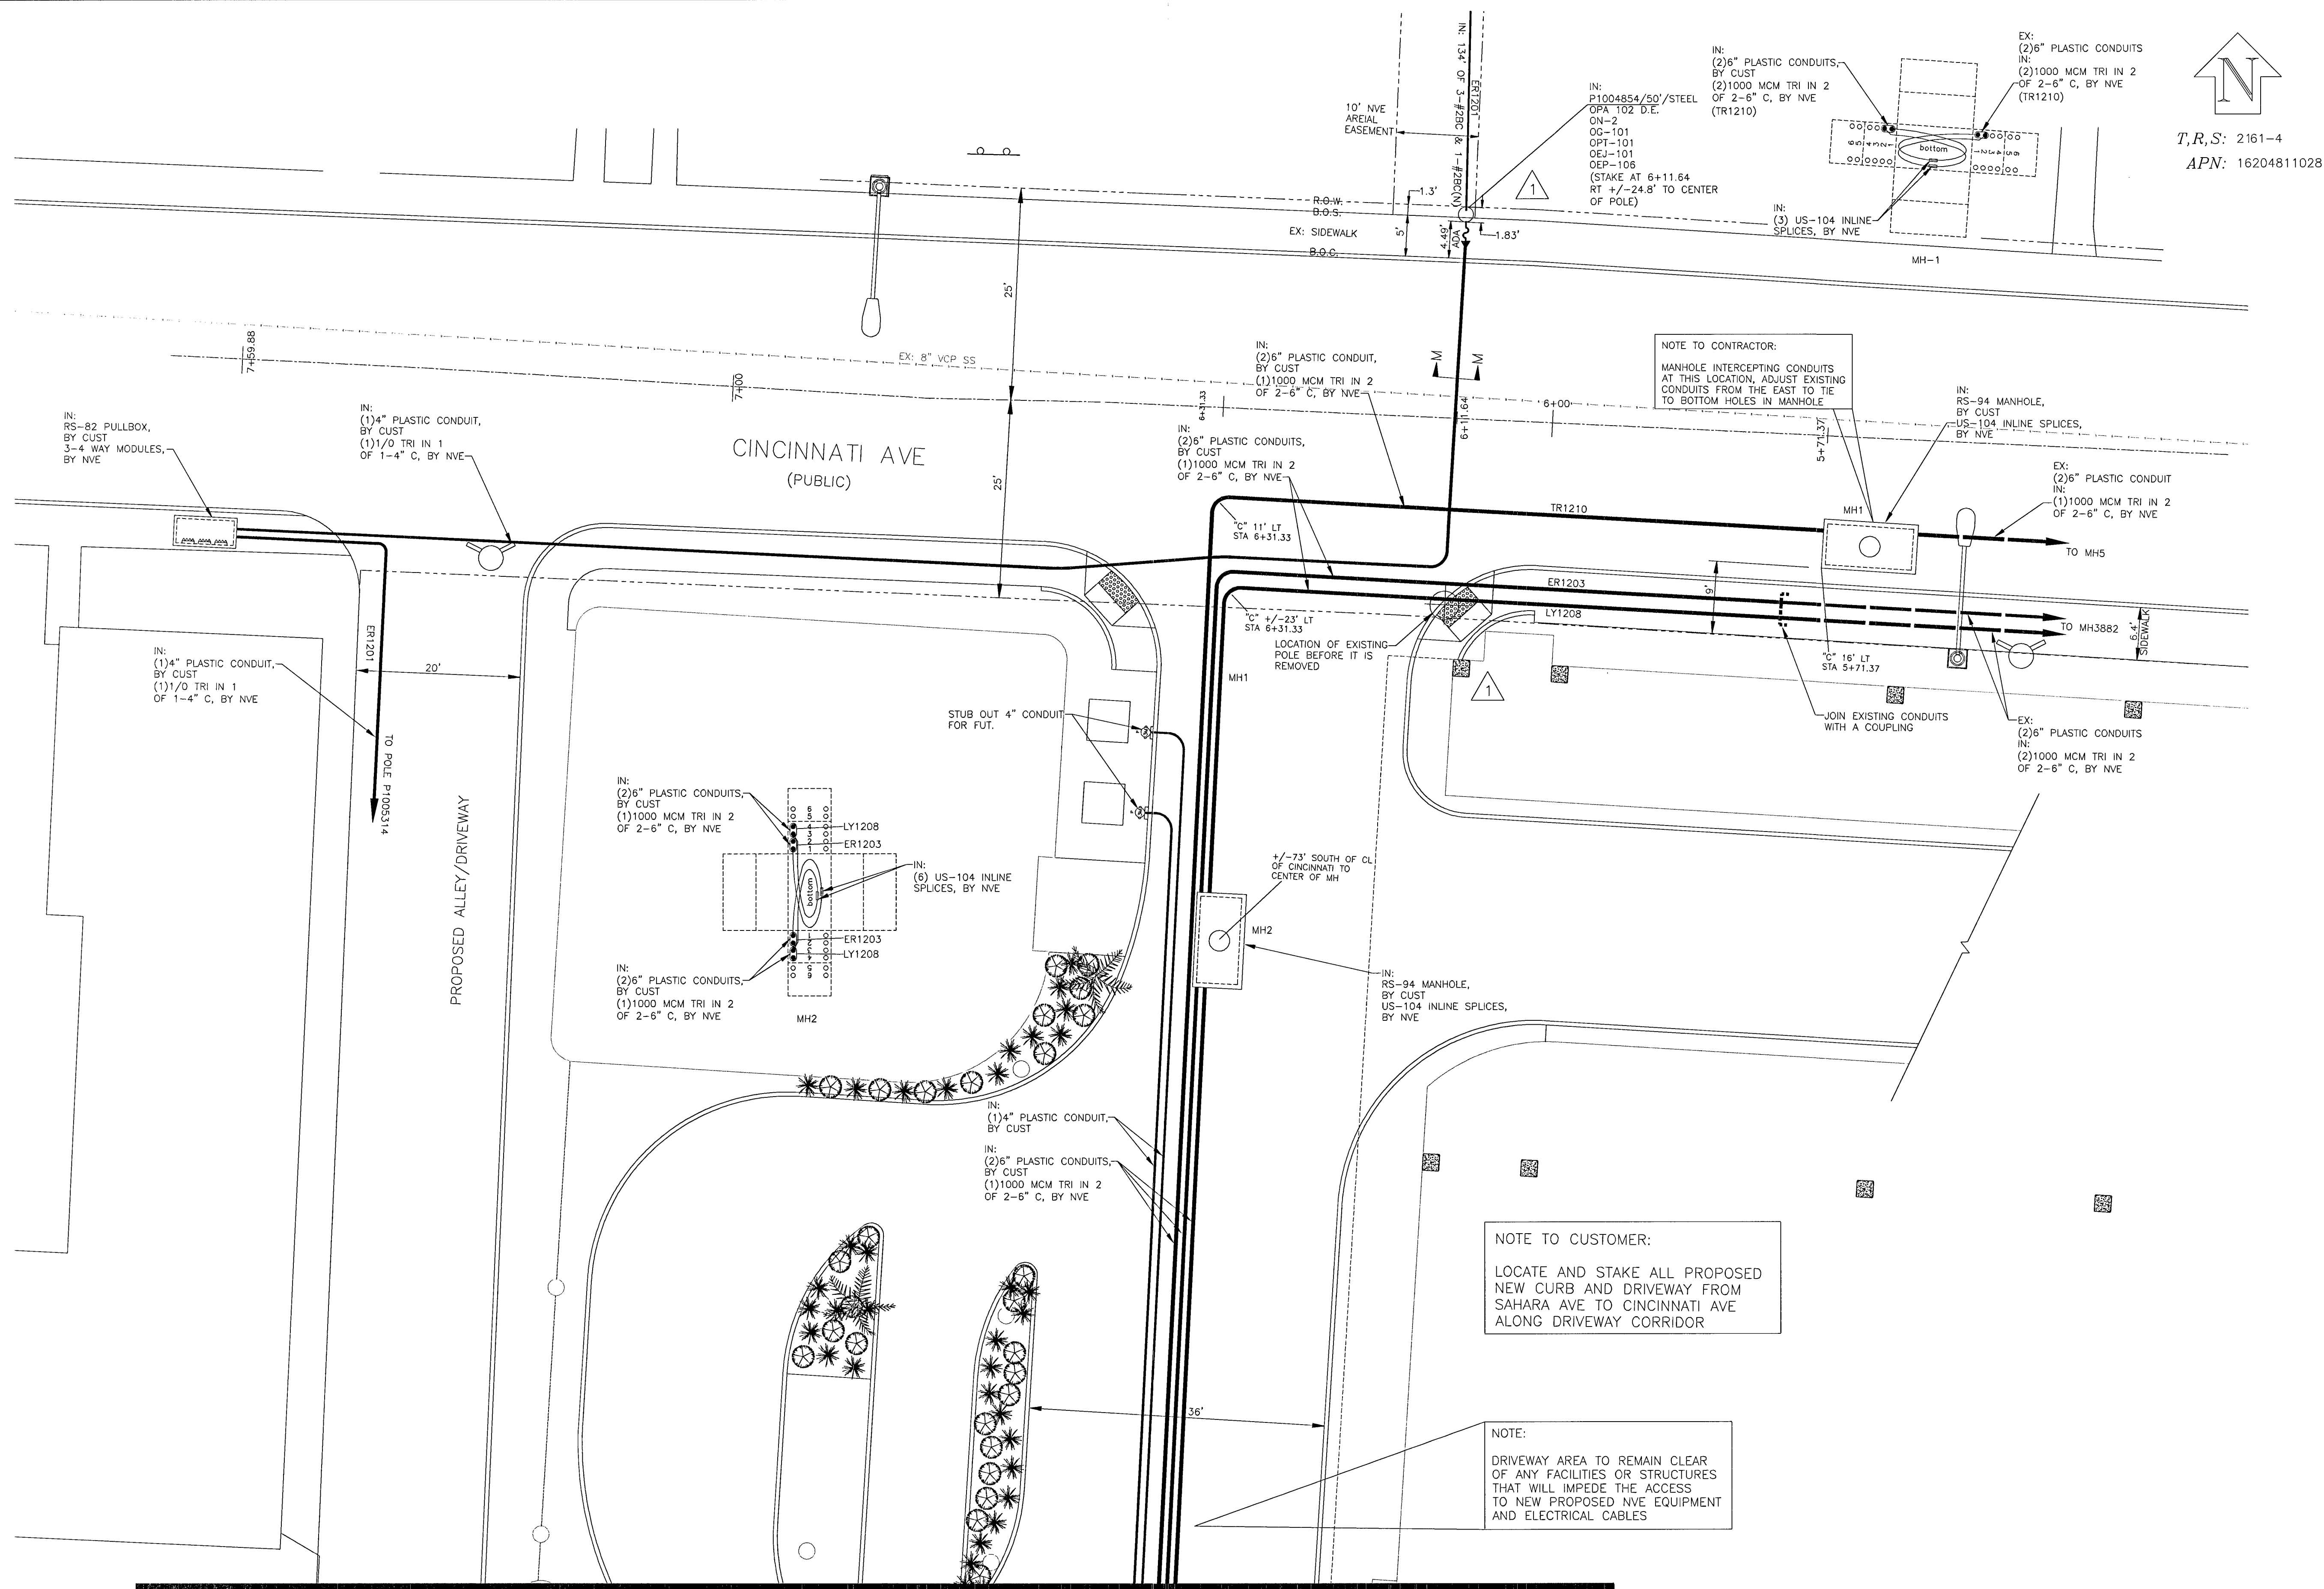

T.R.S: 2161-4
APN: 16204811028

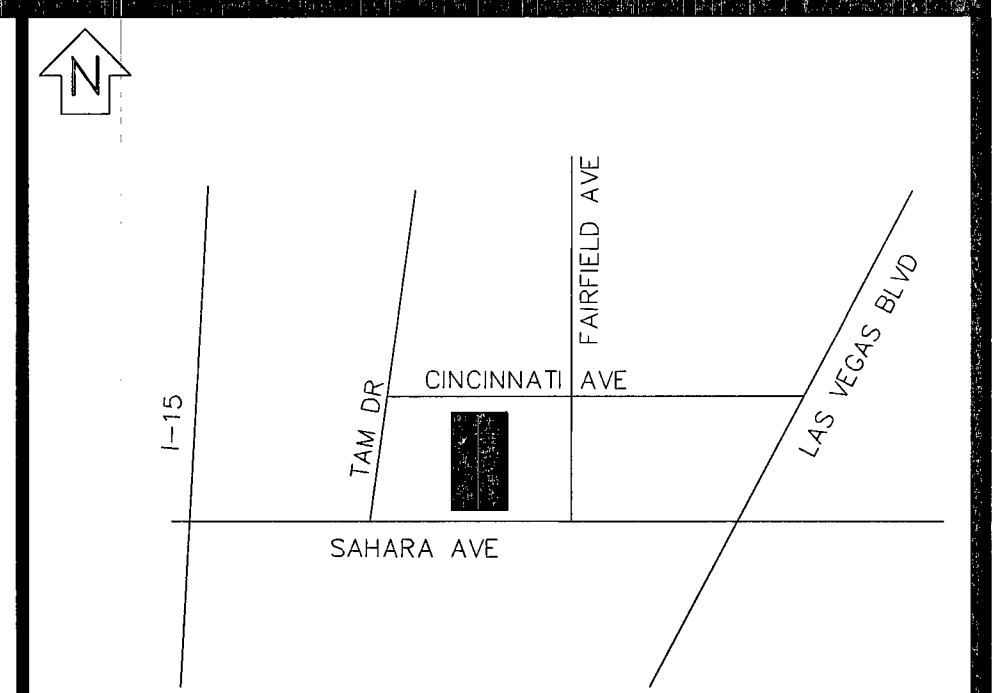

VICINITY MAP
(NOT TO SCALE)

EVERY EFFORT HAS BEEN MADE TO IDENTIFY ALL NVE FACILITIES. THE CUSTOMER SHALL CONFIRM THE EXISTENCE AND LOCATION OF THESE FACILITIES.

Call before you Dig
Avoid hitting overhead power lines. It's costly. Call 811 before you dig. It's the right way.

Call 811
OR
1-800-227-2600
AND
CLARK COUNTY TRAFFIC OPERATIONS
1-702-455-7544

REVISIONS				
NO.	DESCRIPTION	DATE	G.A.	
1	RELOCATE SWITCHES FROM CINCINNATI TO SAHARA / MOVE POLE TO NORTH SIDE OF CINCINNATI PER CUST REQUEST. BY DT	04/17/2014	RY	
2	MOVE SWITCHES TO ST PARALLEL WITH SAHARA PER CUST REQUEST. BY DT ADD STA AND OFFSET	07/24/2014		
3	CHANGE SPACING BETWEEN 6" CONDUIT TRENCHES FROM 48" TO 24" (SHT 4 OF 6).	07/30/2014	K2-14	

TYPE OF EASEMENT: AERIAL ☐ STANDARD ☐ R/W-31 ☐ UNDERGROUND ☐ AS BUILT UNDERGROUND ☐ R.O.E./R/W-5-COM ☐ 3rd PARTY ☐ UNDERGROUND BY EXHIBIT (N-DOT) PERMIT ☐ (BLM) PERMIT ☐ RAILROAD-UPRR-PERMIT ☐ SO. NEVADA WATER PERMIT ☐ NOT REQUIRED ☐ Misc. Info. ☐	JPA NOTES: ☐ EMBARK CONTACT: LEN BELLOWS ☐ PHONE NUMBER: 244-7290 ☐ DATE OF CONTACT: 05/09/2012 ☐ NVE TO SET NEW POLES ☐ NVE TO STAKE NEW POLES ☐ NVE TO PROVIDE 2 POLES ☐ 1 50' FT. CLASS STEEL ☐ 1 45' FT. CLASS 1 ☐ FT. CLASS ☐ TO REMOVE EX. POLES ☐ REM: 5 EXISTING POLES FOR FUT. DEVELOP. ☐ JPA#: P201210902
--	---

EXHIBIT 'A'

NVE INFORMATION:

COORDINATOR: DON JACKSON
PHONE: 402-6815
DESIGNER: DARRYL THOMAS D.F.
DCA:
INSPECTOR: 402-3008
STAND BY: 402-4117, 402-4116, 402-4118
DISTRICT: LAS VEGAS NORTH

CUSTOMER INFORMATION:

APPLICANT: LUCKY DRAGON LLC
ENGINEER: GC WALLACE
CONTACT: ROY CLARK 804-2112
APPROVAL DATE: 09/20/2012

GOVERNMENT INFORMATION:

AGENCY: CITY OF LAS VEGAS
APPROVAL DATE: 07/09/2014

FOR EACH SERVICE POINT (POINT OF DELIVERY), ENERGY FOR EACH TENANT SPACE WILL BE MEASURED THROUGH ONE WATTHOUR METER. ENERGY FOR ALL NON-TENANT SPACE WILL BE MEASURED THROUGH ONE WATTHOUR METER. CONTACT NVE METER OPERATIONS FOR MULTIPLE RATE CLASS INSTALLATIONS

LUCKY DRAGON
RELOCATIONS/REMOVALS
SAHARA/FAIRFIELD

107V 6/9/1-PWR

PROJ. ID: 3000126698
SHEET #: 4 OF 6

SCALE: 1" = 50'
DATE: 03/29/2012

CITY OF LAS VEGAS
PERMIT REQUIRED*

CONTACT CLV LAND DEVELOPMENT (223-4371)
CLV CONSTRUCTION SERVICES MUST BE NOTIFIED 24 HOURS PRIOR TO COMMENCING CONSTRUCTION (223-4337)

HANDEN: _____ DATE: _____

*NVE INSPECTOR MUST BE NOTIFIED BY FAX 48 HOURS PRIOR TO COMMENCING CONSTRUCTION & WILL VERIFY CITY PERMIT FOR WORK DONE IN STREETS OR SIDEWALK.
FAX PERMIT TO:
LAS VEGAS NORTH (RYAN CENTER): 402-4354
LAS VEGAS SOUTH (BELTWAY CENTER): 402-6864

APPROVED FOR CONSTRUCTION

THIS APPROVAL IS FOR WORK IN CLV R/W & EASEMENT ONLY. OBTAINING PERMISSIONS OR EASEMENTS FOR WORK SHOWN ON PRIVATE PROPERTY IS THE RESPONSIBILITY OF THE UTILITY.

APPROVAL: _____ DATE: _____

CLARK COUNTY
PUBLIC WORKS
PERMIT REQUIRED*

DEVELOPER/CONTRACTOR SHALL OBTAIN A COUNTY PERMIT BEFORE ANY EXCAVATION WORK WITHIN CLARK COUNTY RIGHT-OF-WAY

HTE: _____ DATE: _____

*NVE INSPECTOR WILL VERIFY COUNTY PERMIT FOR WORK DONE WITHIN COUNTY RIGHT-OF-WAY

ENERGIZING AND SETTING OF ELECTRIC METER MAY BE DELAYED IF OFF-SITE RESTORATION IS NOT COMPLETED TO THE SATISFACTION OF CLARK COUNTY INSPECTOR

APPROVED FOR PERMITTING

THIS APPROVAL IS FOR WORK IN CC R/W & EASEMENT ONLY. OBTAINING PERMISSIONS OR EASEMENTS FOR WORK SHOWN ON PRIVATE PROPERTY IS THE RESPONSIBILITY OF THE UTILITY.

NIGHT WORK: ☐ YES ☐ NO
ENCROACHMENT PERMIT # _____

APPROVAL BY: _____ DATE: _____

CIVIL LINETYPE LEGEND

	PROPOSED	EXISTING
CENTERLINE	---	---
PROPERTY LINE/ROW	---	---
CURB	---	---
EDGE OF PAVEMENT	---	---
EDGE OF SIDEWALK	---	---
SEWER LINE	---	---
WATER LINE	---	---
GAS LINE	---	---
TELEPHONE LINE	---	---
CABLE TV LINE	---	---
STORM DRAIN LINE	---	---
FIRE HYDRANT	---	---
STREET LIGHT	---	---
STREET LIGHT SERVICE	---	---

* LINETYPES UTILIZED WHERE CONFLICT OCCURS WITH NVE FACILITIES.