
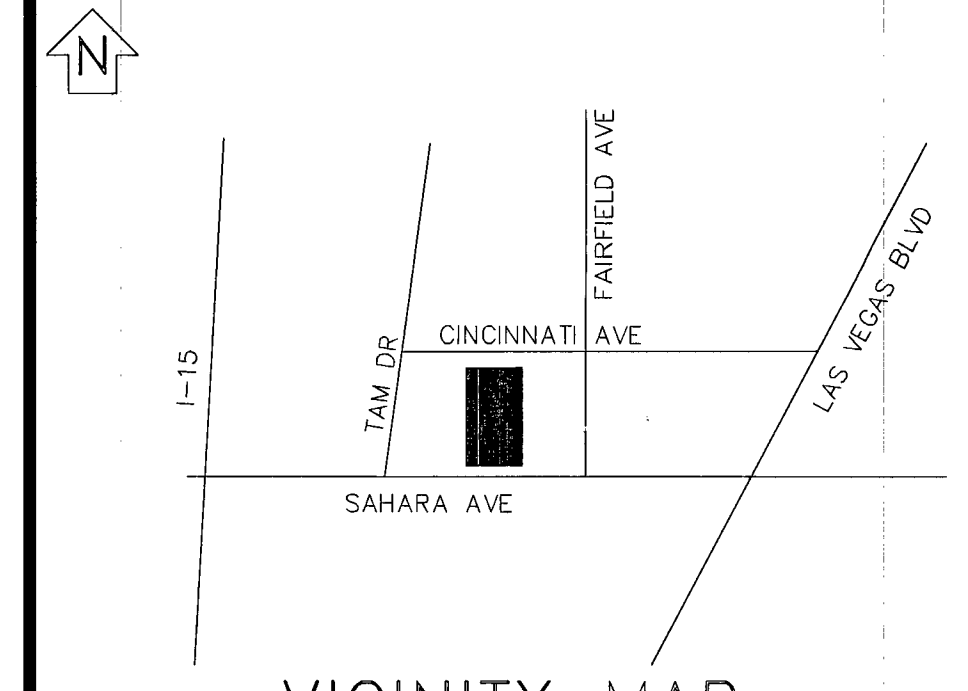


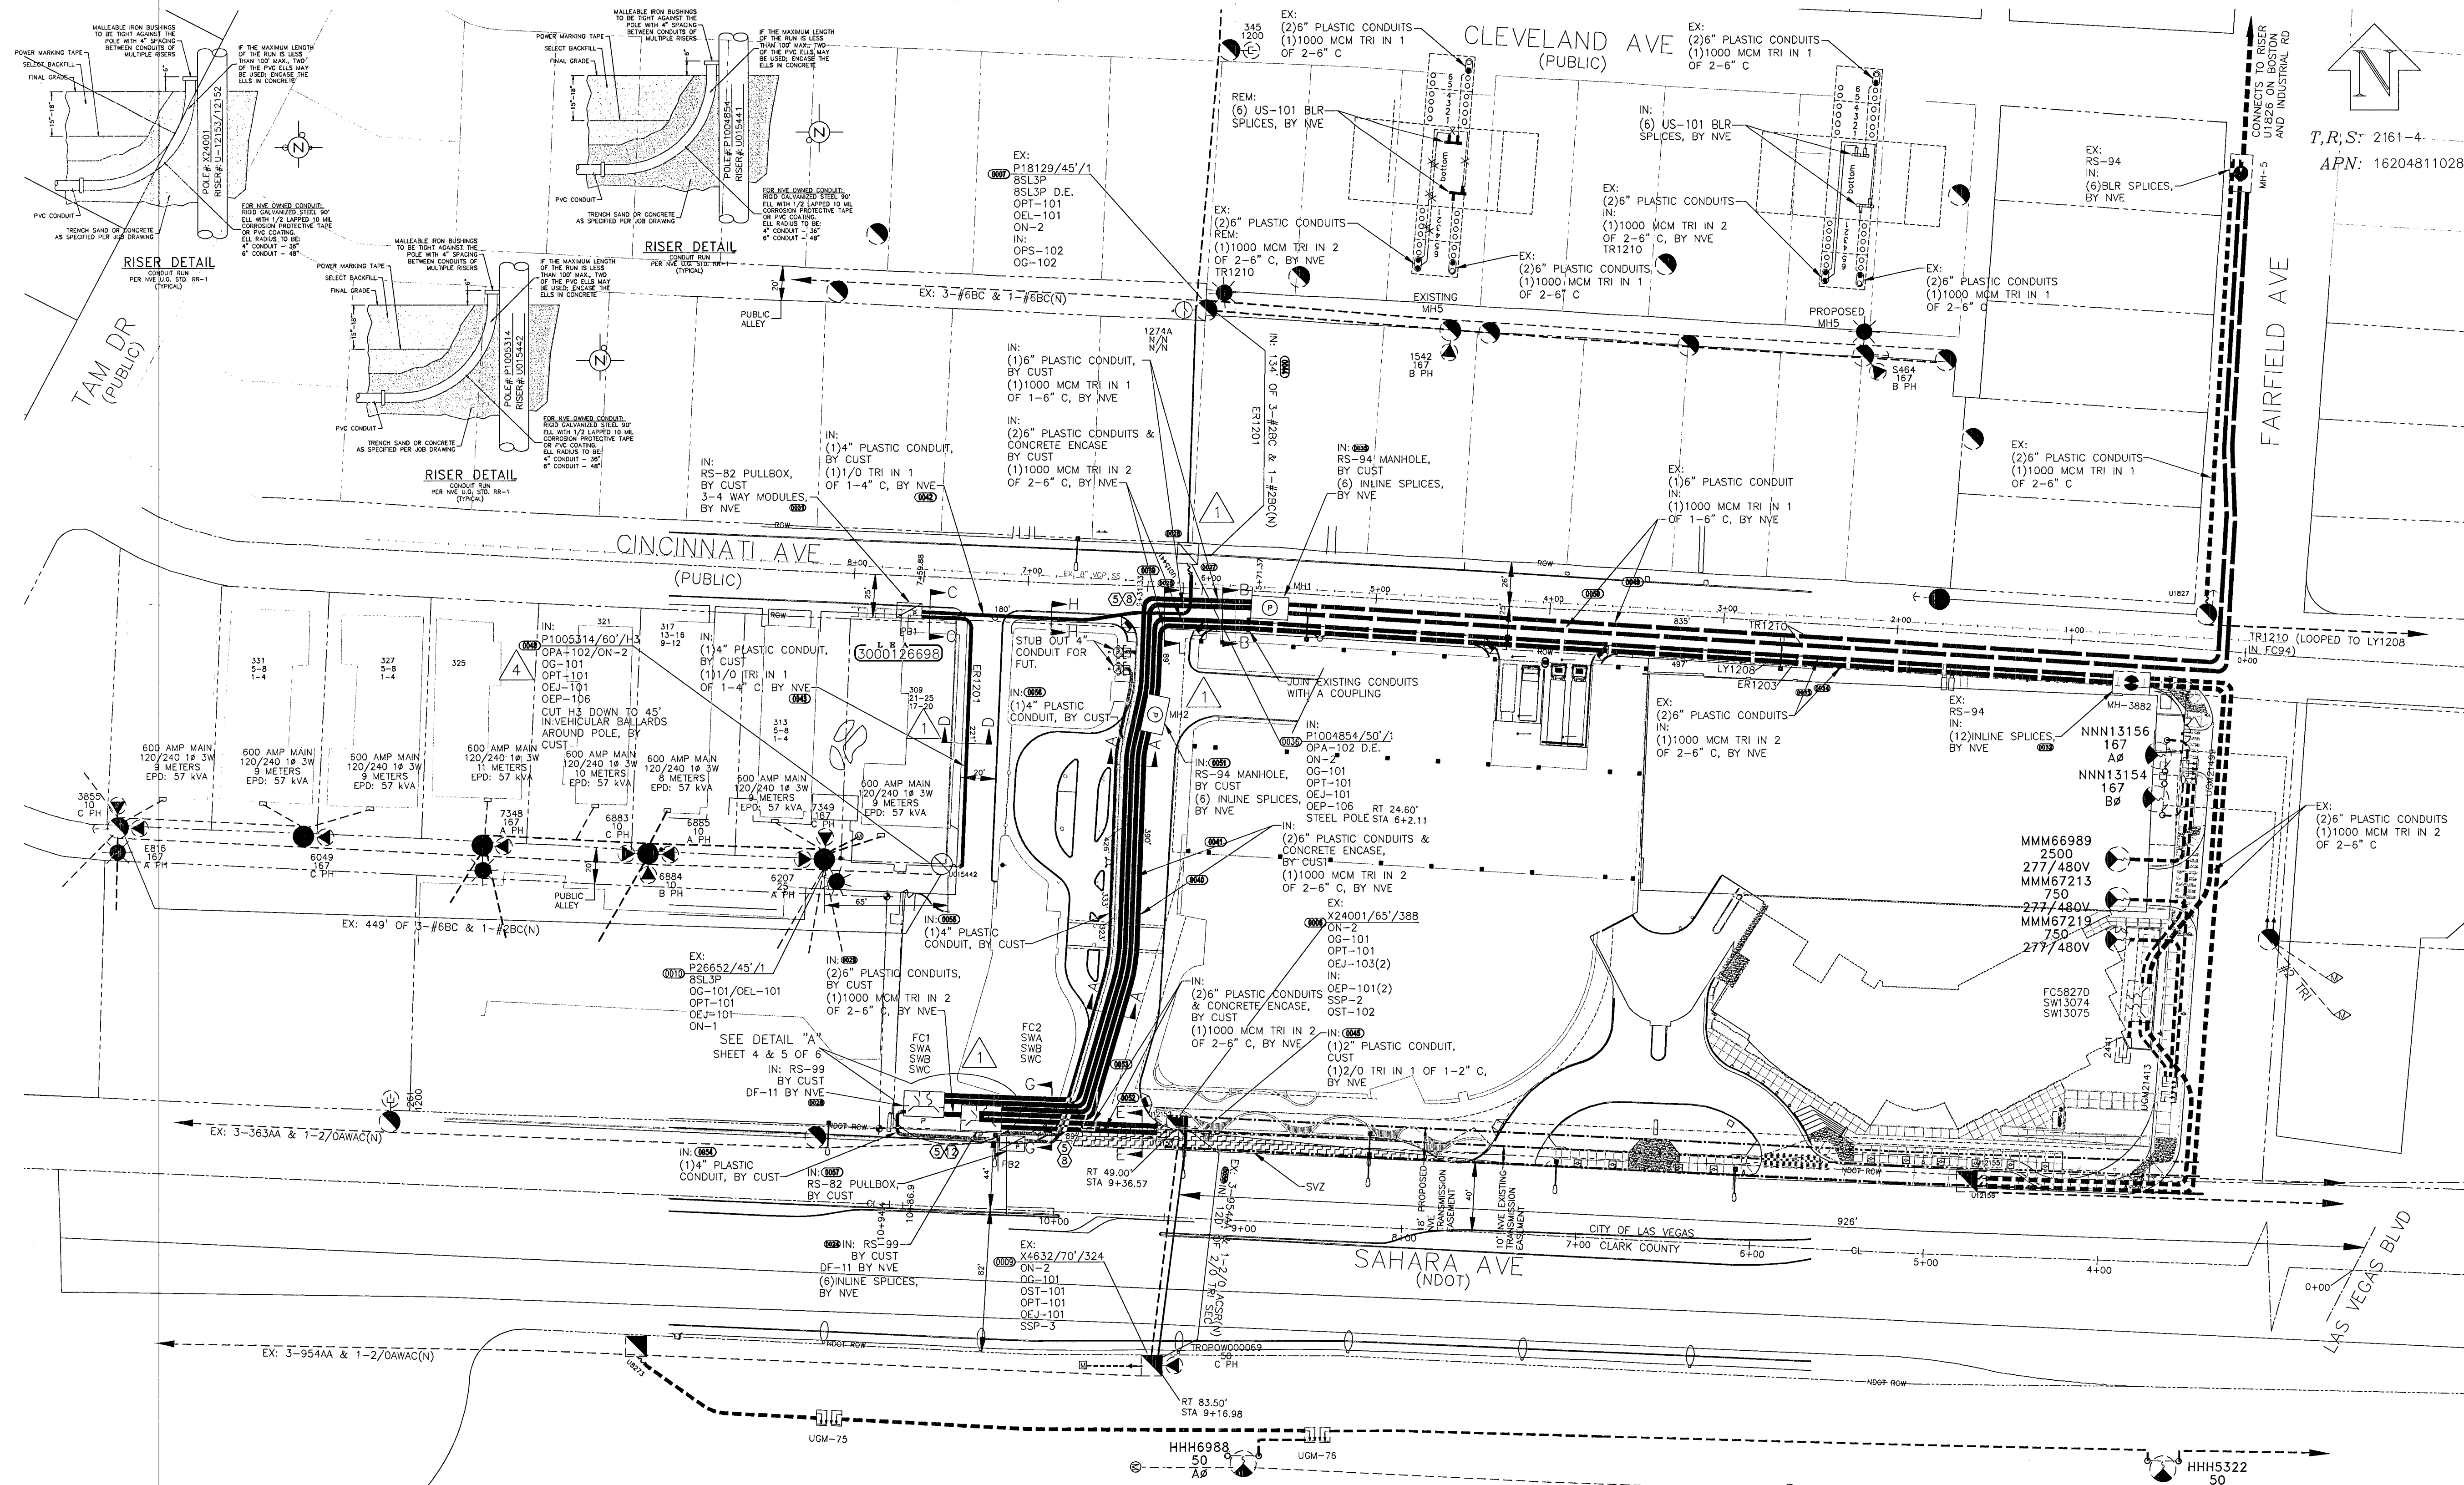

EVERY EFFORT HAS BEEN MADE TO IDENTIFY ALL NVE FACILITIES. THE CUSTOMER SHALL CONFIRM THE EXISTENCE AND LOCATION OF THESE FACILITIES.

Call before you Dig  
811  
1-800-227-2600  
CLARK COUNTY PUBLIC OPERATIONS  
1-702-455-7544

| NO. | DESCRIPTION                                                                                                 | DATE       | G.A.    |
|-----|-------------------------------------------------------------------------------------------------------------|------------|---------|
| 1   | RELOCATE SWITCHES FROM CINCINNATI TO SAHARA / MOVE POLE TO NORTH SIDE OF CINCINNATI PER CUST REQUEST, BY DT | 04/17/2014 |         |
| 2   | MOVE SWITCHES TO SIT PARALLEL WITH SAHARA PER CUST. REQUEST, BY DT. ADD STA. AND OFFSET                     | 07/24/2014 | PK      |
| 3   | CHANGE SPACING BETWEEN 6" CONDUIT TRENCHES FROM 48" TO 24" (SHT 4 OF 6).                                    | 07/30/2014 | 10-2-14 |
| 4   | CHANGEOUT POLE FROM CL4 TO H3 TO NOT HAVE TO USE AN ANCHOR FOR BETTER TRAFFIC CLEARANCE, BY DT              | 09/16/2014 |         |

| TYPE OF EASEMENT:       | JPA NOTES:                  |
|-------------------------|-----------------------------|
| AERIAL                  | EMBARQ CONTACT: LEN BELLOW  |
| STANDARD                | PHONE NUMBER: 244-7290      |
| R/W-31                  | DATE OF CONTACT: 05/09/2012 |
| UNDERGROUND             | NVE TO SET NEW POLES        |
| AS BUILT UNDERGROUND    | NVE TO STAKE NEW POLES      |
| R.O.E./R/W-5-COM        | NVE TO PROVIDE 2 POLES      |
| 3rd PARTY               | 1 50' FT. CLASS STEEL       |
| UNDERGROUND BY EXHIBIT  | 1 45' FT. CLASS 1           |
| (N-DOT) PERMIT          | TO DIG POLE HOLES           |
| (BLM) PERMIT            | NVE TO REMOVE EX. POLES     |
| RAILROAD-UPRR-PERMIT    | NOT REQUIRED                |
| SO. NEVADA WATER PERMIT | REM: 5 EXISTING POLES FOR   |
| NOT REQUIRED            | FUT. DEVELOP.               |
| Misc. Info.             | JPA#: P201210902            |

| EXHIBIT 'A'             |                              |
|-------------------------|------------------------------|
| NVE INFORMATION:        |                              |
| COORDINATOR:            | DON JACKSON                  |
| PHONE:                  | 402-6815                     |
| DESIGNER:               | DARRYL THOMAS D.F.           |
| DCA:                    |                              |
| INSPECTOR:              | 402-3008                     |
| STAND BY:               | 402-4117, 402-4116, 402-4118 |
| DISTRICT:               | LAS VEGAS NORTH              |
| CUSTOMER INFORMATION:   |                              |
| APPLICANT:              | LUCKY DRAGON LLC             |
| ENGINEER:               | GC WALLACE                   |
| CONTACT:                | ROY CLARK 804-2112           |
| APPROVAL DATE:          | 09/20/2012                   |
| GOVERNMENT INFORMATION: |                              |
| AGENCY:                 | CITY OF LAS VEGAS            |
| APPROVAL DATE:          | 07/09/2014                   |

FOR EACH SERVICE POINT (POINT OF DELIVERY), ENERGY FOR EACH TENANT SPACE WILL BE MEASURED THROUGH ONE WATTHOUR METER. ENERGY FOR ALL NON-TENANT SPACE WILL BE MEASURED THROUGH ONE WATTHOUR METER. CONTACT NVE METER OPERATIONS FOR MULTIPLE RATE CLASS INSTALLATIONS

**NVEnergy**

LUCKY DRAGON  
RELOCATIONS/REMOVALS  
SAHARA/FAIRFIELD  
107V6191-DWR

PROJ. ID: 3000126698 SCALE: 1" = 50'  
SHEET #: 3 OF 6 DATE: 03/29/2012

- RTC NOTES:**  
BACKFILL AND RIGHT OF WAY RESTORATION SHALL CONFORM TO CLARK COUNTY UNIFORM STANDARD DRAWINGS
- 500.1 0 TO 5 YEARS PAVEMENT RESTORATION LONGITUDINAL CUT
  - 500.2 0 TO 5 YEARS PAVEMENT RESTORATION TRANSVERSE CUT
  - 500.3 OVER 5 YEARS PAVEMENT RESTORATION LONGITUDINAL CUT, GREATER THAN 60' R.O.W
  - 500.4 OVER 5 YRS PAVEMENT RESTORATION LONGITUDINAL CUT, 60' R.O.W OR LESS
  - 500.5 OVER 5 YRS PAVEMENT RESTORATION TRANSVERSE ALL R.O.W WIDTHS
  - 501 TYPICAL UNDERGROUND UTILITY LOCATIONS IN RESIDENTIAL STREETS 60' OR LESS R.O.W.
  - 501.1 TYPICAL UTILITY UNDERGROUND LOCATIONS IN STREETS WITH GREATER THAN 60' R.O.W.
  - 503 METHOD B FOR RIGID AND FLEXIBLE PIPE TRENCH BACKFILL - PAVED AREAS
  - 503.1 METHOD A FOR FLEXIBLE PIPE TRENCH BACKFILL - PAVED AREAS
  - 503.2 METHOD A FOR RIGID PIPE TRENCH BACKFILL - PAVED AREAS
  - BACKFILL IN UNPAVED AREA AS REQUIRED BY LOCAL CODE OR AS APPROVED BY AGENCY.
  - 234 SIDEWALK

**CIRCUIT LEGEND**

|     |        |
|-----|--------|
| --- | LY1208 |
| --- | ER1203 |
| --- | TR1210 |

SEE SHEET 6 OF 6  
FOR TRENCH DETAILS

**INSTALL SHEET**

PURPOSE OF PROJECT:  
RELOCATE EXISTING NVE FACILITIES FOR FUTURE DEVELOPMENT

**APPROVED FOR CONSTRUCTION**  
THIS APPROVAL IS FOR WORK IN CLV R/W & EASEMENT ONLY. OBTAINING PERMISSIONS OR EASEMENTS FOR WORK SHOWN ON PRIVATE PROPERTY IS THE RESPONSIBILITY OF THE UTILITY.

APPROVAL \_\_\_\_\_ DATE \_\_\_\_\_

**CITY OF LAS VEGAS PERMIT REQUIRED\***  
CONTACT CLV LAND DEVELOPMENT (228-4371)  
CLV CONSTRUCTION SERVICES MUST BE NOTIFIED 48 HOURS PRIOR TO COMMENCING CONSTRUCTION (228-4307)

WASSEL \_\_\_\_\_ DATE \_\_\_\_\_

\*NVE INSPECTOR MUST BE NOTIFIED BY FAX 48 HOURS PRIOR TO COMMENCING CONSTRUCTION. A VULN IDENTITY CITY PERMIT FOR WORK DONE IN STREETS OR SIDEWALKS.  
LAS VEGAS NORTH (FROM CENTER): 402-4154  
LAS VEGAS SOUTH (BETWEEN CENTER): 402-6864

**CLARK COUNTY PUBLIC WORKS PERMIT REQUIRED\***  
DEVELOPER/CONTRACTOR SHALL OBTAIN A COUNTY PERMIT BEFORE ANY EXCAVATION WORK WITHIN CLARK COUNTY RIGHT-OF-WAY

HTE \_\_\_\_\_ DATE \_\_\_\_\_

\*NVE INSPECTOR WILL VERIFY COUNTY PERMIT FOR WORK DONE WITHIN COUNTY RIGHT-OF-WAY  
EMERGENCY AND SETTING OF ELECTRIC METER MAY BE DELAYED IF OFF-SITE RESTORATION IS NOT COMPLETED TO THE SATISFACTION OF CLARK COUNTY INSPECTOR

**APPROVED FOR PERMITTING**  
THIS APPROVAL IS FOR WORK IN CC R/W & EASEMENT ONLY. OBTAINING PERMISSIONS OR EASEMENTS FOR WORK SHOWN ON PRIVATE PROPERTY IS THE RESPONSIBILITY OF THE UTILITY.

NIGHT WORK: ☐ YES ☐ NO  
ENCROACHMENT PERMIT # \_\_\_\_\_

APPROVAL BY: \_\_\_\_\_ DATE \_\_\_\_\_

