


SEE MATCHLINE A
SHEET 4 OF 6

T,R,S: 2161-4
APN: 16204811028

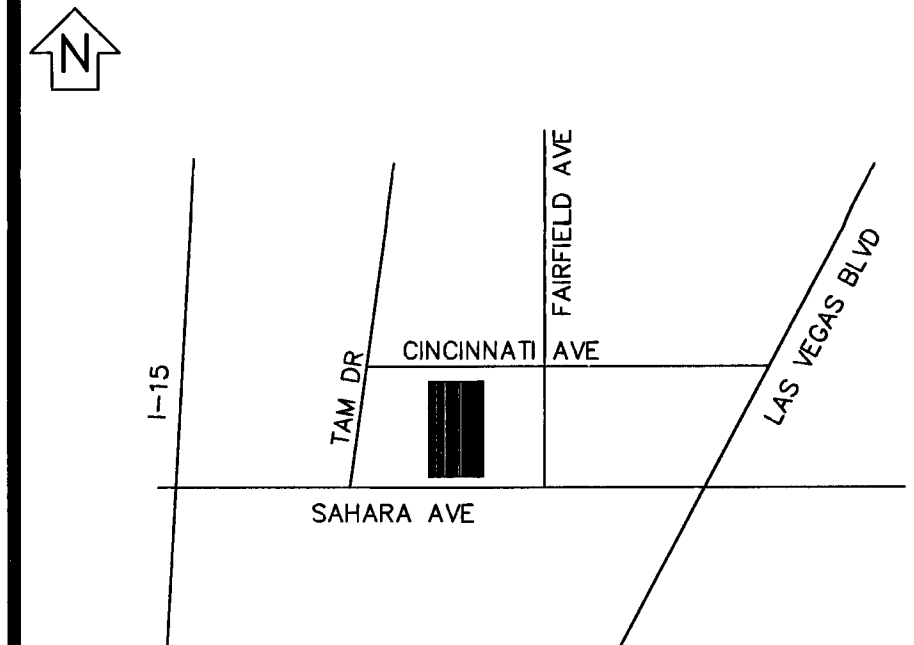

VICINITY MAP
(NOT TO SCALE)

EVERY EFFORT HAS BEEN MADE TO IDENTIFY ALL NVE FACILITIES. THE CUSTOMER SHALL CONFIRM THE EXISTENCE AND LOCATION OF THESE FACILITIES.

Call before you Dig
Call 811
1-800-227-2600
CLARK COUNTY TRAFFIC OPERATIONS
1-702-455-7544

REVISIONS

NO.	DESCRIPTION	DATE	G.A.
1	RELOCATE SWITCHES FROM CINCINNATI TO SAHARA / MOVE POLE TO NORTH SIDE OF CINCINNATI PER CUST REQUEST, BY DT	04/17/2014	
2	MOVE SWITCHES TO SIT PARALLEL WITH SAHARA PER CUST. REQUEST, BY DT ADD STA. AND OFFSET	07/24/2014	
3	CHANGE SPACING BETWEEN 6" CONDUIT TRENCHES FROM 48" TO 24" (SHT 4 OF 6).	07/30/2014	
4	CHANGEOUT POLE FROM CL4 TO H3 TO NOT HAVE TO USE AN ANCHOR FOR BETTER TRAFFIC CLEARANCE, BY DT	09/16/2014	
5	ADDITION OF CENTERLINE ALONG SAHARA APART FROM THE SECTION LINE THAT WAS ORIGINALLY SHOWN, BY DT	10/09/2014	

TYPE OF EASEMENT:	JPA NOTES:
AERIAL	☐ EMBARK CONTACT: LEN BELLOWS
STANDARD	PHONE NUMBER: 244-7290
R/W-31	DATE OF CONTACT: 05/09/2012
UNDERGROUND	☐ NVE TO SET NEW POLES
AS BUILT UNDERGROUND	☐ NVE TO STAKE NEW POLES
R.O.E./R/W-5-COM	☐ NVE TO PROVIDE 2 POLES
3rd PARTY	☐ 1 50' FT. CLASS STEEL
UNDERGROUND BY EXHIBIT	☐ 1 45' FT. CLASS 1
(N-DOT) PERMIT	☐ FT. CLASS
(SLW) PERMIT	☐ TO DIG POLE HOLES
RAILROAD-UPRR-PERMIT	☐ NVE TO REMOVE EX. POLES
SO. NEVADA WATER PERMIT	☐ REM. 5 EXISTING POLES FOR
NOT REQUIRED	☐ FUT. DEVELOP.
Misc. Info.	JPA#: P201210902

EXHIBIT 'A'


NVE INFORMATION:
COORDINATOR: DON JACKSON
PHONE: 402-6815
DESIGNER: DARRYL THOMAS D.F. KL
DCA:
INSPECTOR: 402-3008
STAND BY: 402-4117, 402-4116, 402-4118
DISTRICT: LAS VEGAS NORTH
CUSTOMER INFORMATION:
APPLICANT: LUCKY DRAGON LLC
ENGINEER: GC WALLACE
CONTACT: ROY CLARK 804-2112
APPROVAL DATE: 09/20/2012
GOVERNMENT INFORMATION:
AGENCY: CITY OF LAS VEGAS
APPROVAL DATE: 07/09/2014

FOR EACH SERVICE POINT (POINT OF DELIVERY), ENERGY FOR EACH TENANT SPACE WILL BE MEASURED THROUGH ONE WATT/OUR METER. ENERGY FOR ALL NON-TENANT SPACE WILL BE MEASURED THROUGH ONE WATT/OUR METER. CONTACT NVE METER OPERATIONS FOR MULTIPLE RATE CLASS INSTALLATIONS



LUCKY DRAGON
RELOCATIONS/REMOVALS
SAHARA/FAIRFIELD

107V 6191-PWR
PROJ. ID: 3000126698 SCALE: 1" = 50'
SHEET #: 5 OF 6 DATE: 03/29/2012

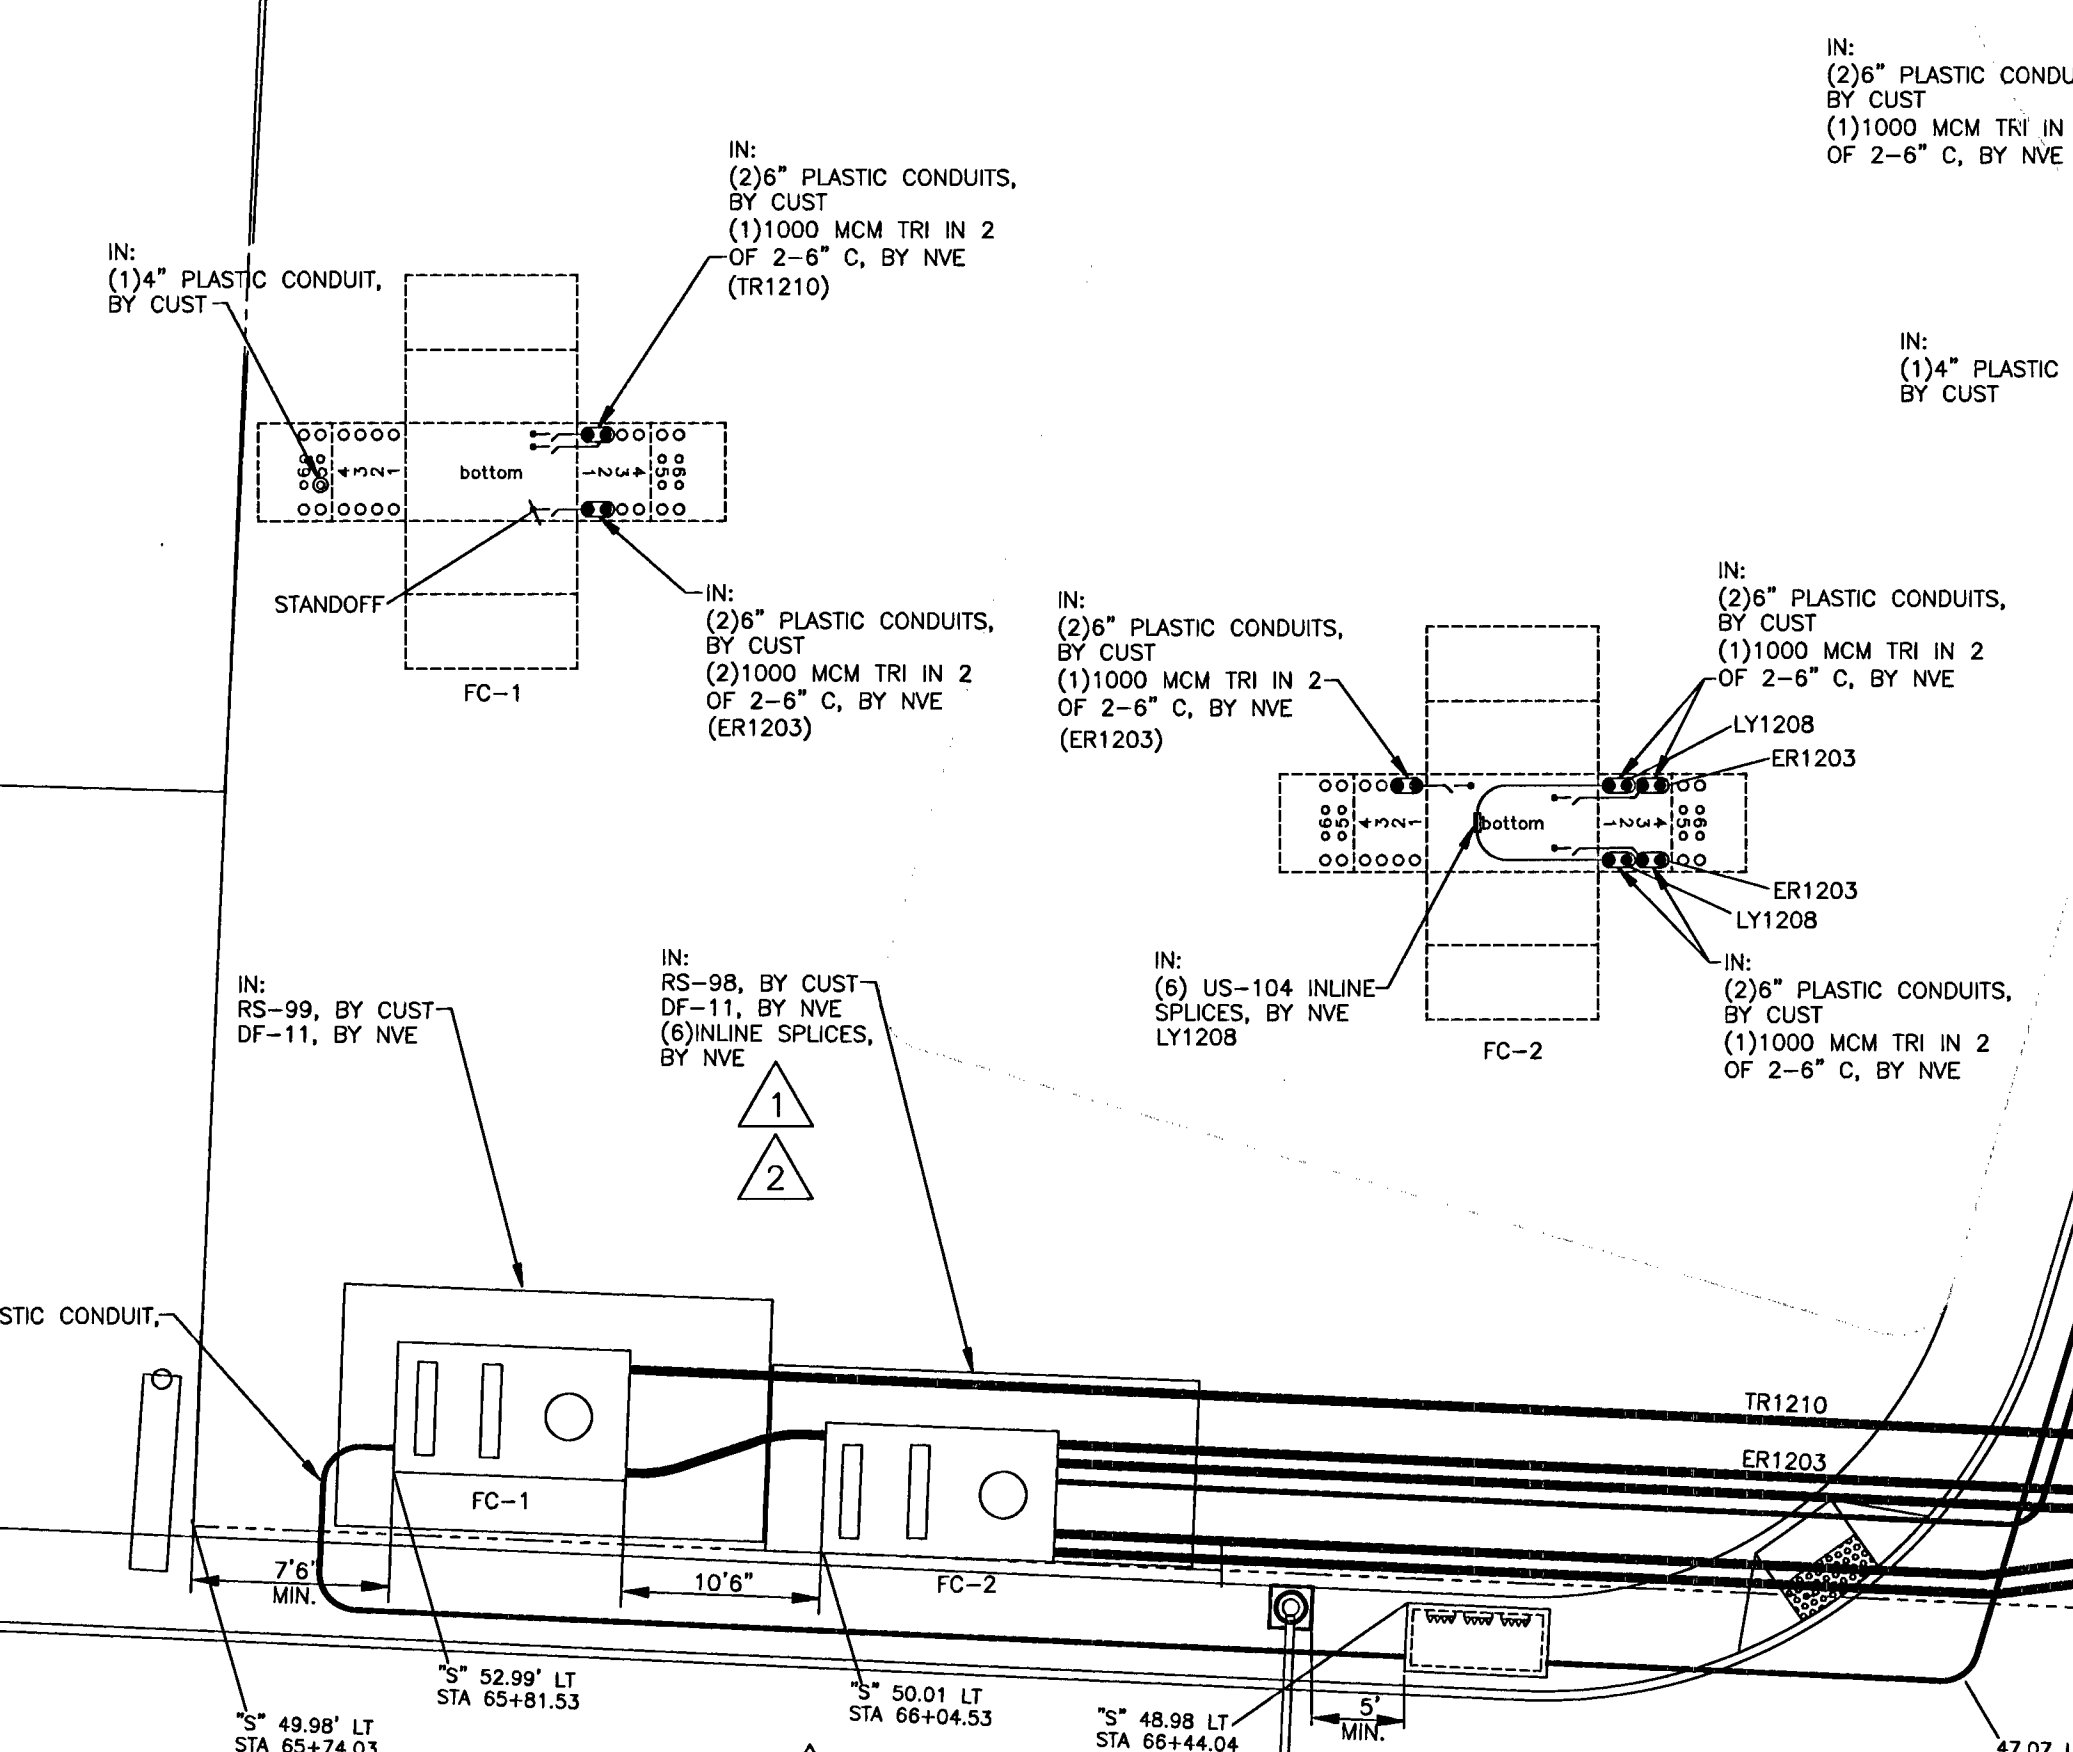

NOTE:
DRIVEWAY AREA TO REMAIN CLEAR OF ANY FACILITIES OR STRUCTURES THAT WILL IMPEDE THE ACCESS TO NEW PROPOSED NVE EQUIPMENT AND ELECTRICAL CABLES

NDOT NOTE:
CUSTOMER PLANNING TO INSTALL WIRE IN 4" CONDUIT AND RS-82 WITHIN 12 MONTH PERIOD ON FUTURE PID #3000298548.

CITY OF LAS VEGAS
PERMIT REQUIRED*
CONTACT CLV/DEV/PLANNING (228-4371)
CLV CONSTRUCTION SERVICES MUST BE NOTIFIED 24 HOURS PRIOR TO COMMENCING CONSTRUCTION (228-4337)
HENSEN DATE
*NVE INSPECTOR MUST BE NOTIFIED BY FAX 48 HOURS PRIOR TO COMMENCING CONSTRUCTION & WILL VERIFY CITY PERMIT FOR WORK DONE IN STREETS OR SIDEWALK
FAX PERMIT TO:
LAS VEGAS NORTH (RYAN CENTER): 402-4364
LAS VEGAS SOUTH (BELTWAY CENTER): 402-4684

APPROVED FOR CONSTRUCTION
THIS APPROVAL IS FOR WORK IN CLV R/W & EASEMENT ONLY. OBTAINING PERMISSIONS OR EASEMENTS FOR WORK SHOWN ON PRIVATE PROPERTY IS THE RESPONSIBILITY OF THE UTILITY.
APPROVAL DATE

CLARK COUNTY
PUBLIC WORKS
PERMIT REQUIRED*
DEVELOPER/CONTRACTOR SHALL OBTAIN A COUNTY PERMIT BEFORE ANY EXCAVATION WORK WITHIN CLARK COUNTY RIGHT-OF-WAY
HTE DATE
*NVE INSPECTOR WILL VERIFY COUNTY PERMIT FOR WORK DONE WITHIN COUNTY RIGHT-OF-WAY
ENERGIZING AND SETTING OF ELECTRIC METER MAY BE DELAYED IF OFF-SITE RESTORATION IS NOT COMPLETED TO THE SATISFACTION OF CLARK COUNTY INSPECTOR

APPROVED FOR PERMITTING
THIS APPROVAL IS FOR WORK IN CC R/W & EASEMENT ONLY. OBTAINING PERMISSIONS OR EASEMENTS FOR WORK SHOWN ON PRIVATE PROPERTY IS THE RESPONSIBILITY OF THE UTILITY.
NIGHT WORK: YES NO
ENCROACHMENT PERMIT #
APPROVAL BY: DATE

CIVIL LINETYPE LEGEND

	PROPOSED	EXISTING
CENTERLINE	---	---
PROPERTY LINE/R/W	---	---
CURB	---	---
EDGE OF PAVEMENT	---	---
SEWER LINE	---	---
WATER LINE	---	---
GAS LINE	---	---
TELEPHONE LINE	---	---
CABLE TV LINE	---	---
STORM DRAIN LINE	---	---
FIRE HYDRANT	---	---
STREET LIGHT	---	---
STREET LIGHT SERVICE	---	---

* LINETYPES UTILIZED WHERE CONFLICT OCCURS WITH NVE FACILITIES.