



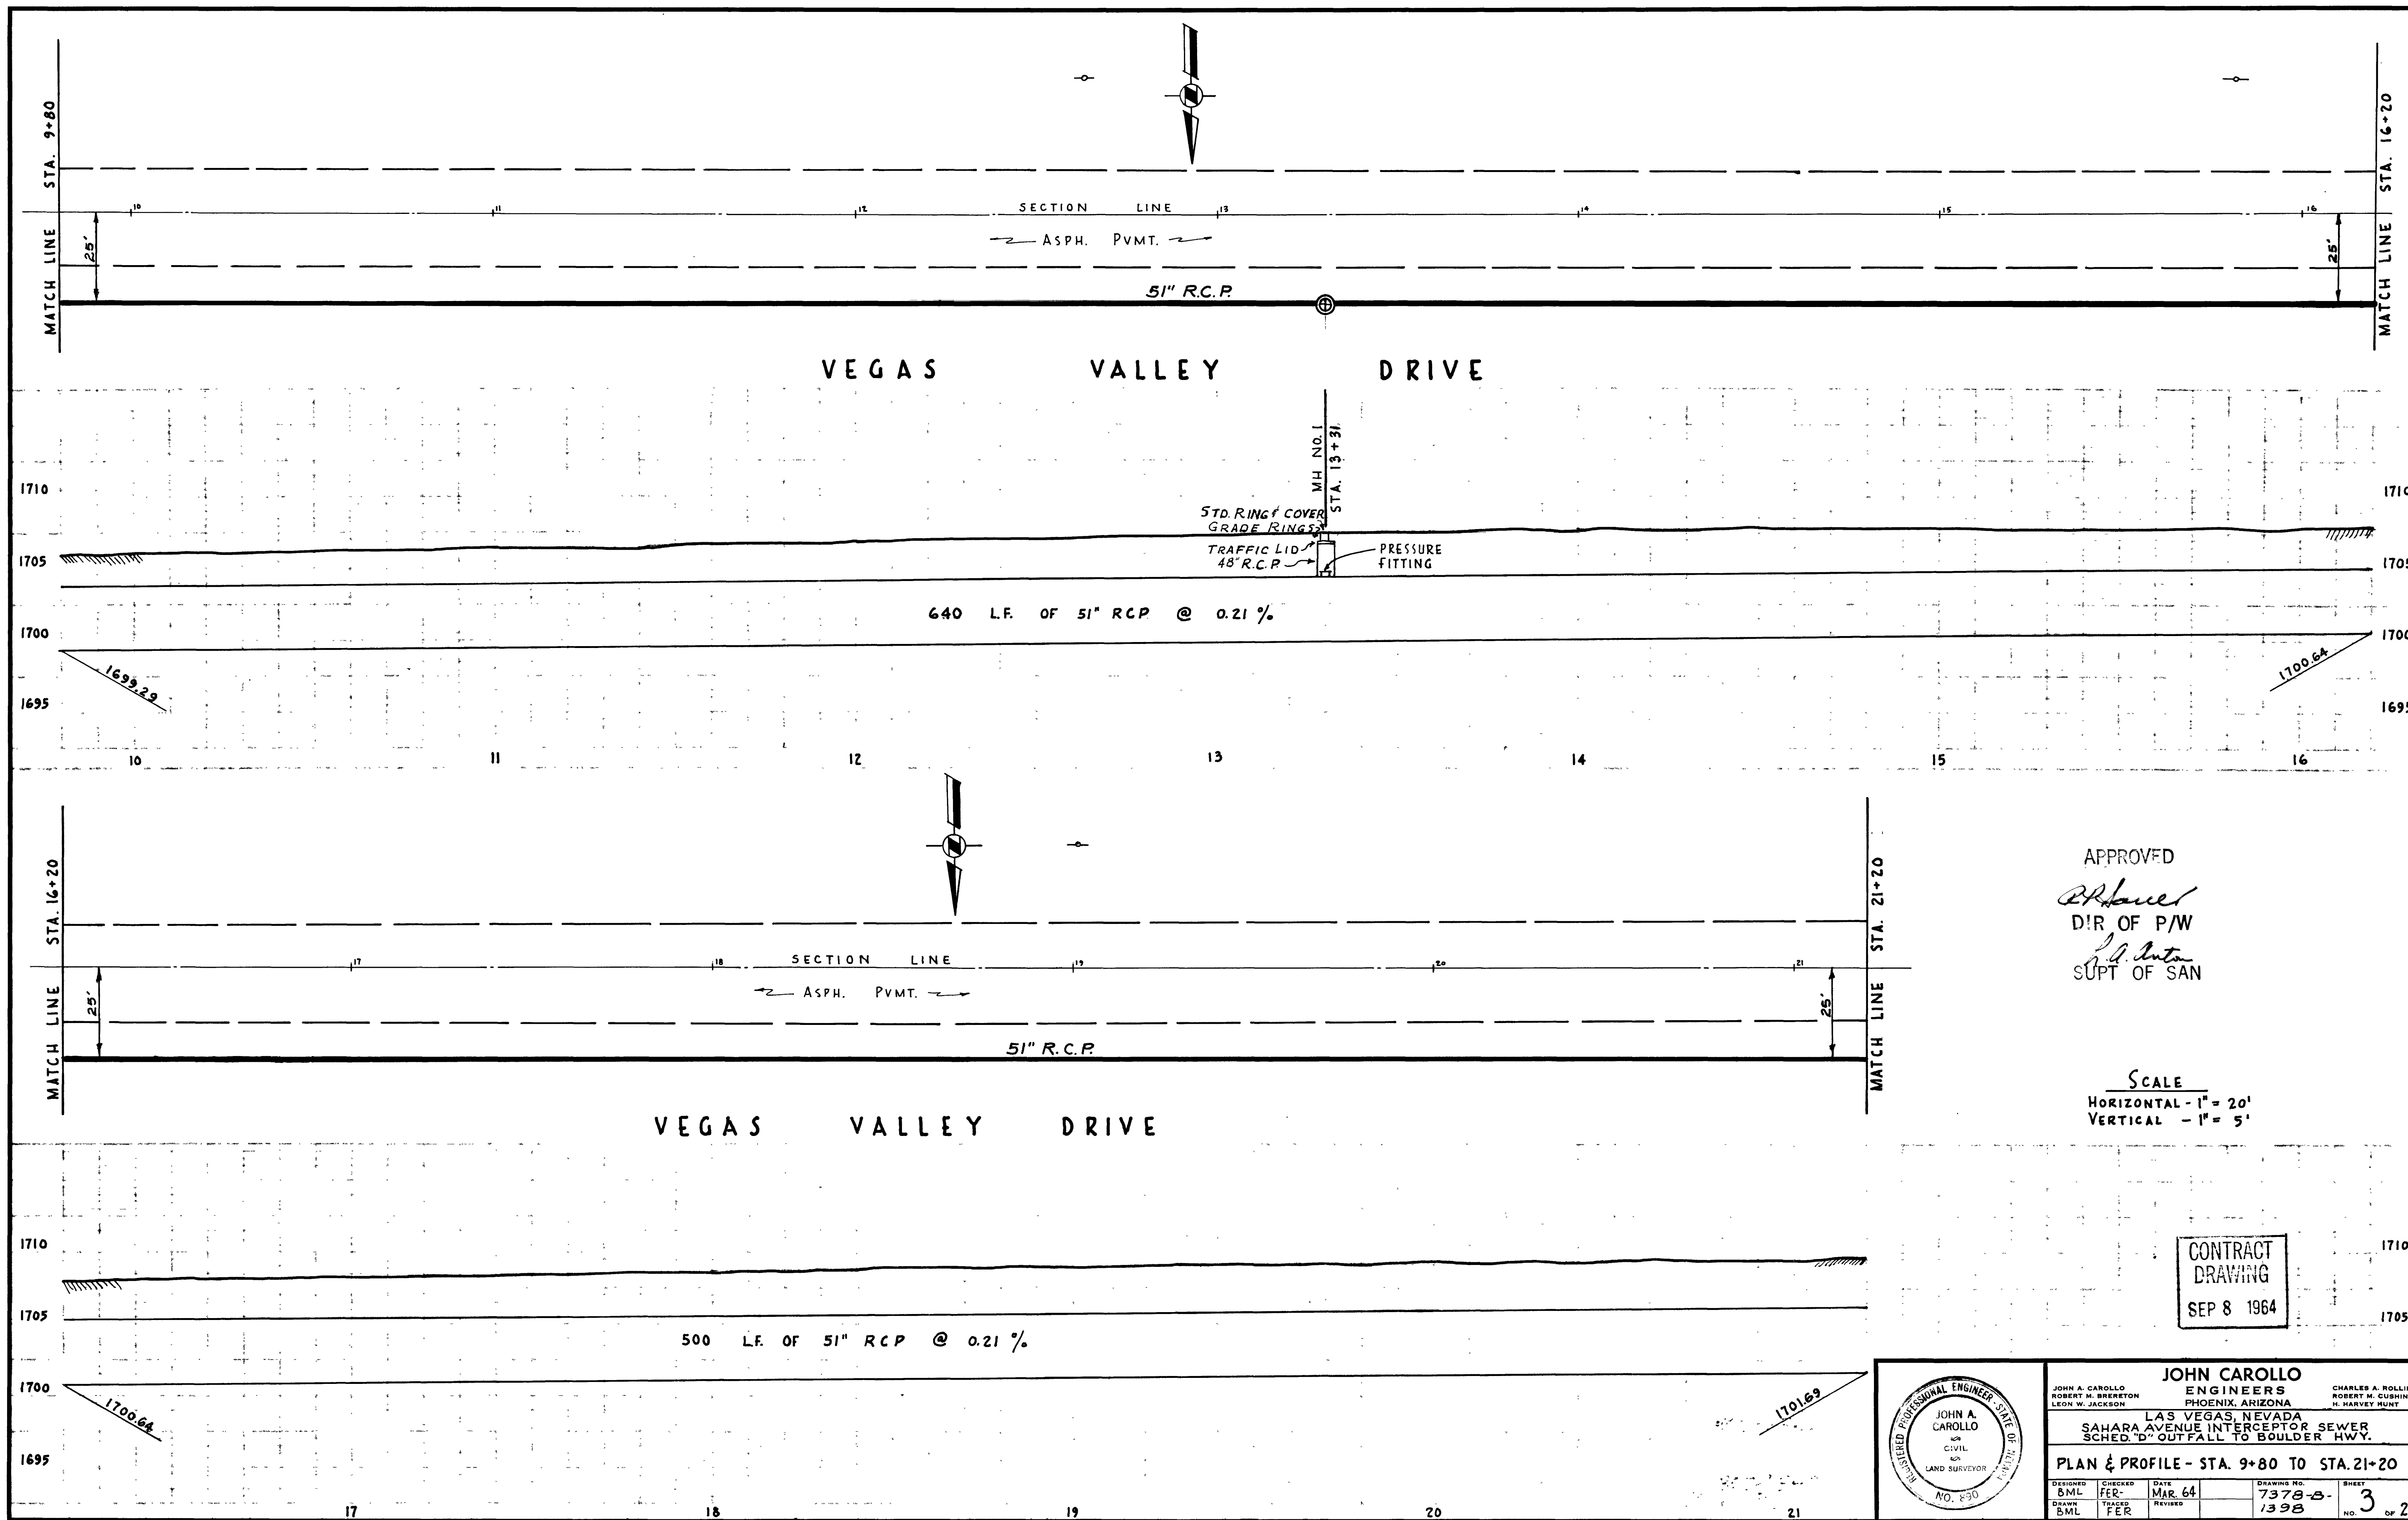

APPROVED
[Signature]
 D/R OF P/W
[Signature]
 Supt. of SAN

SCALE
 HORIZONTAL - 1" = 20'
 VERTICAL - 1" = 5'

CONTRACT
 DRAWING
 SEP 8 1964

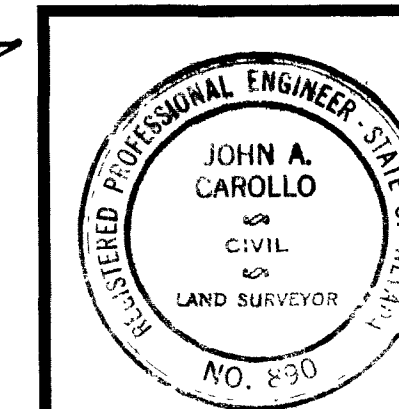

JOHN CAROLLO ENGINEERS PHOENIX, ARIZONA		CHARLES A. ROLLINS ROBERT M. CUSHING H. HARVEY HUNT
LAS VEGAS, NEVADA		
SAHARA AVENUE INTERCEPTOR SEWER SCH. D. OUTFALL TO BOULDER HWY.		
PLAN & PROFILE - STA. 9+80 TO STA. 21+20		
DESIGNED BML	CHECKED FER	DATE MAR. 64
DRAWN BML	TRACED FER	REVIEWED
DRAWING NO. 7378-B-1398		SHEET 3 OF 20

AS BUILT 3-65

307-V342

307-V-342 0

