



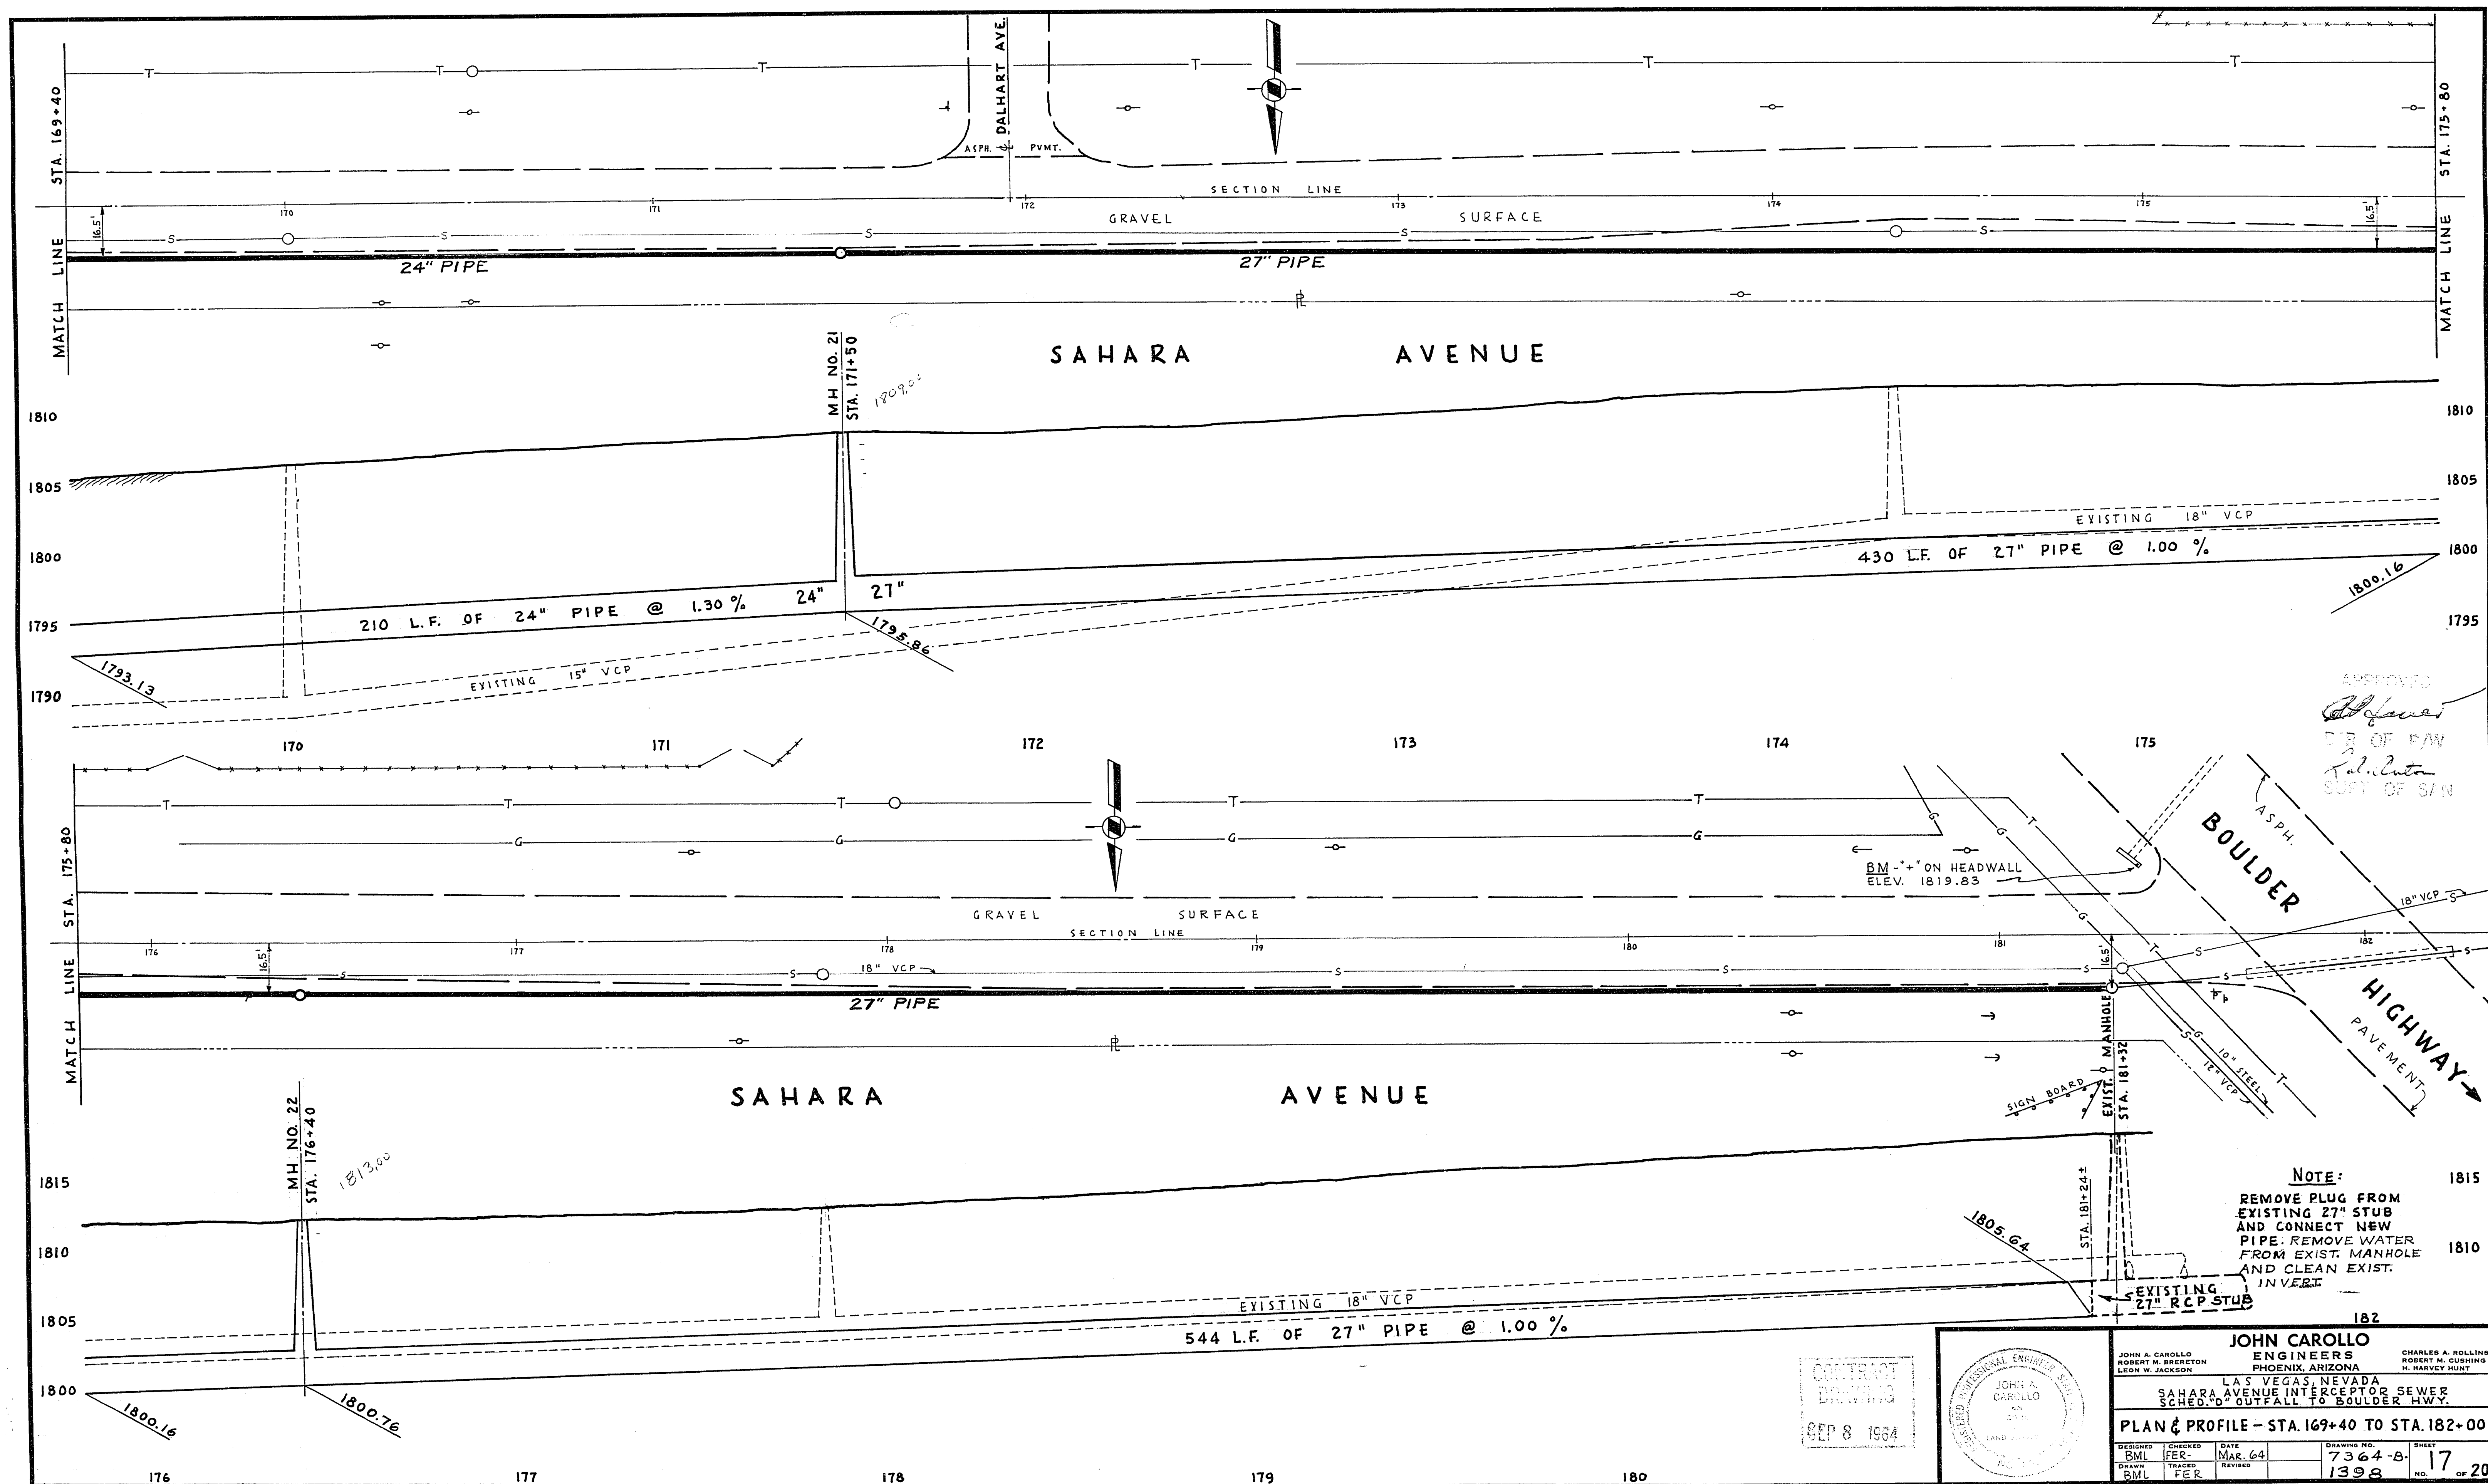

CONTRACT  
DRAWING  
SEP 8 1964

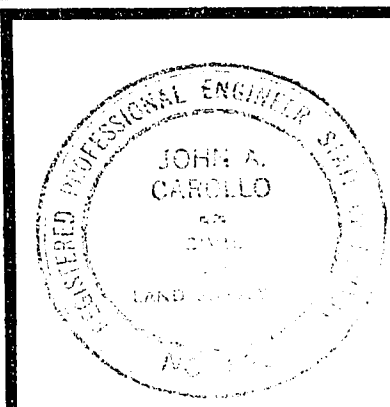

|                                                                                                                                |                |                 |                       |
|--------------------------------------------------------------------------------------------------------------------------------|----------------|-----------------|-----------------------|
| <b>JOHN CAROLLO</b><br>ENGINEERS<br>LAS VEGAS, NEVADA<br>SAHARA AVENUE INTERCEPTOR SEWER<br>SCHED. "D" OUTFALL TO BOULDER HWY. |                |                 |                       |
| DESIGNED<br>BML                                                                                                                | CHECKED<br>FER | DATE<br>MAR. 64 | DRAWING NO.<br>7364-B |
| DRAWN<br>BML                                                                                                                   | TRACED<br>FER  | REVISED         | SHEET<br>17 OF 20     |

AS BUILT 3-65

307-V-342