



5-2-82

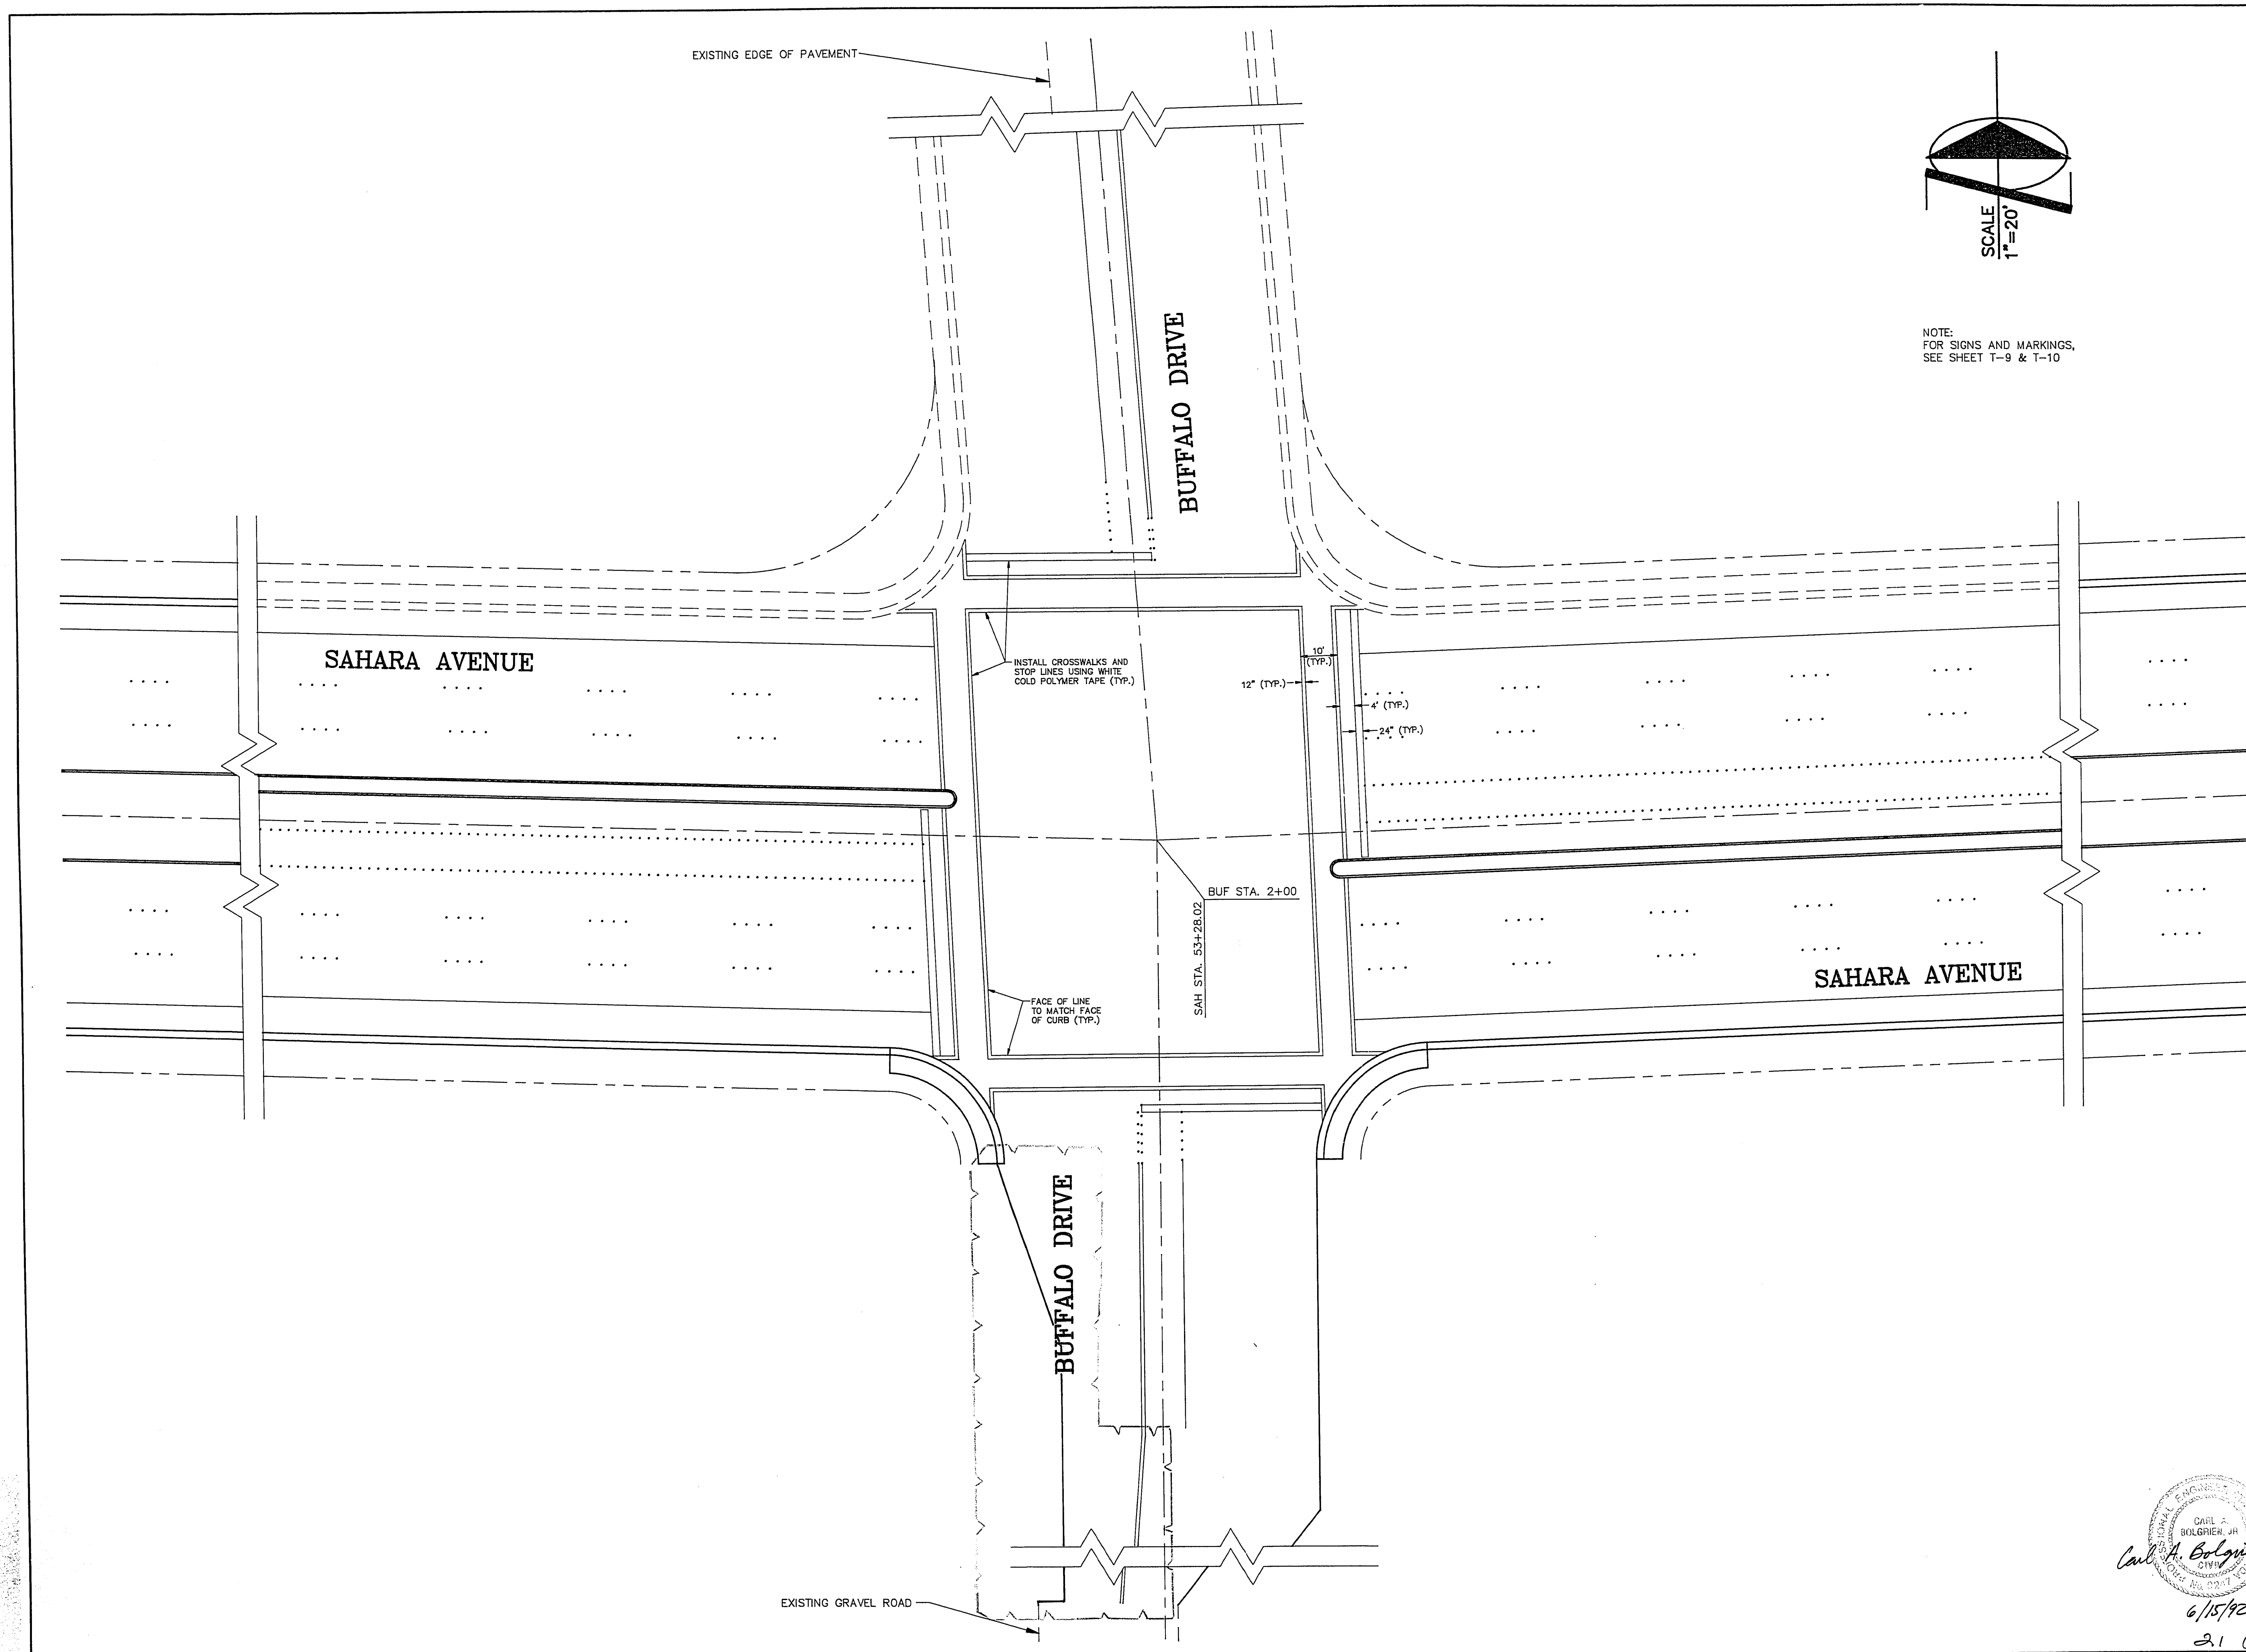

NOTE:
FOR SIGNS AND MARKINGS,
SEE SHEET T-9 & T-10

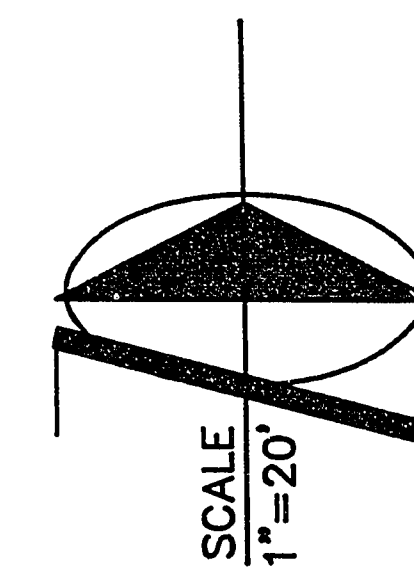

**ENGINEERS &
SURVEYORS, INC.**
7018
ARLINGTON BLVD.
LAS VEGAS, NEVADA 89117

SUBMITTED BY:

REGISTERED CIVIL ENGINEER OF NEW JERSEY

No. 08906

6/23/92

**CROSSWALKS AND STOP LINES
SAHARA AVENUE AT BUFFALO DRIVE**

SAHARA AVENUE

W.O. #	L1S117
BY:	J.D.T./C.A.B.
DATE:	06/15/92
SCALE:	1" = 20'

C.L.V. DRAWING NO. 107-V-2036	T-5 37 4
-------------------------------------	----------------

"As Built" 107-V2036