
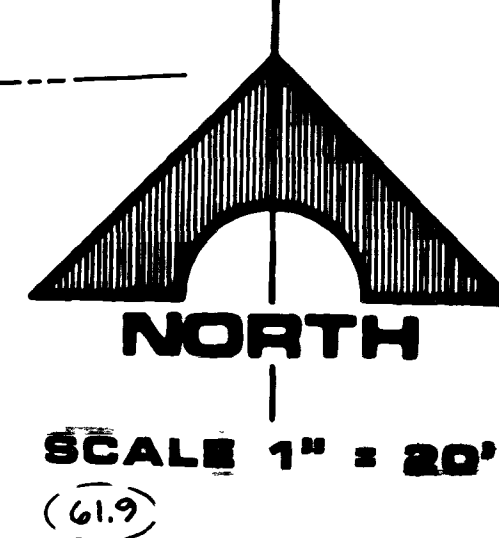


JOB NO. 1074-4019

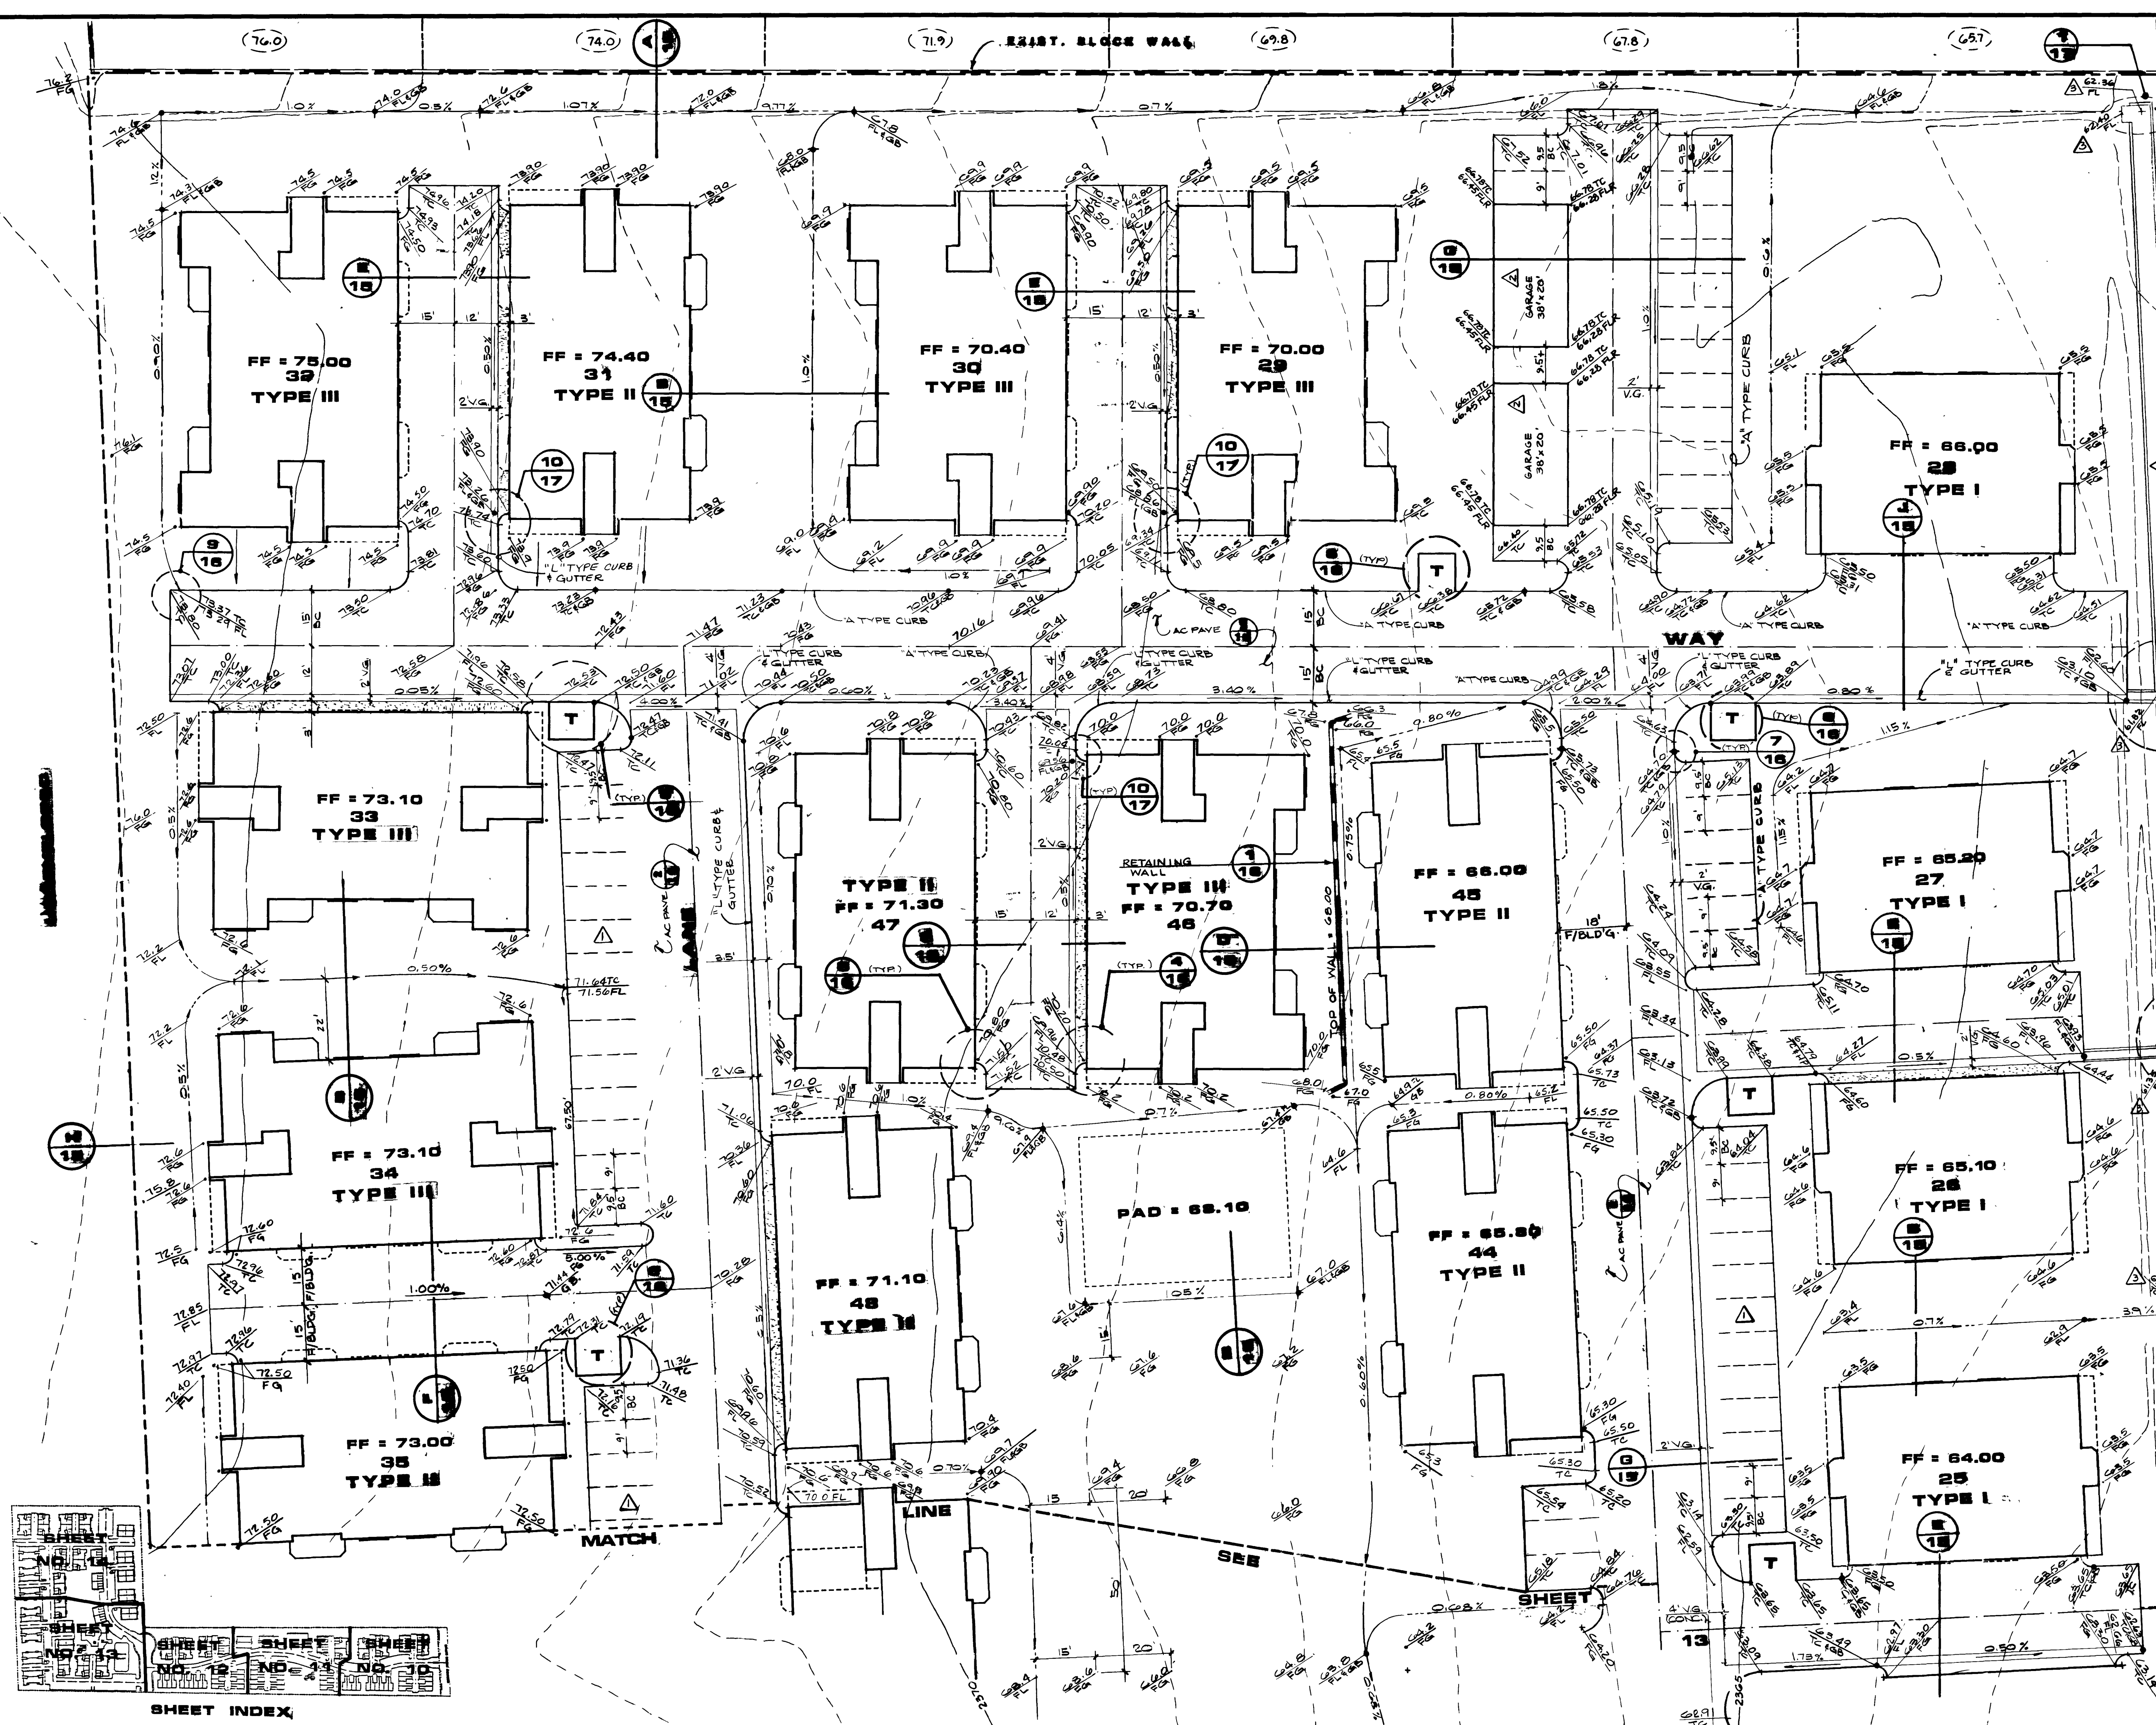

EXIST. LEWIS HOMES
SAHARA RAINBOW 18

EXIST. BLOCK WALL

EXIST. BLOCK WALL

REVISION	DATE	DESCRIPTION
1	6/1/89	REMOVE GARAGE FOR PARKING
2	6/1/89	INSTALL GARAGE
3	6/1/89	REVISE DRAINAGE GRADE

RECOMMENDED BY
DAVID H. WALLACE
G.C. WALLACE, INC.
Engineering/Architecture
1555 SOUTH RAINBOW BLVD., LAS VEGAS, NEVADA 89102

LEWIS HOMES OF NEVADA
SAHARA WEST CONDOMINIUMS
GRADING PLAN

SHEET
14
OF 19 SHEETS

6052

14-9-11

1074-4019

