


PLAN	DATE
NO.	
NOTE BOOK	
ALIGNED CHECKED	
AT. OF THE CHIEF	

PROFILE	DATE
NO.	
NOTE BOOK	
GRADE CHECKED	
AT. OF THE CHIEF	

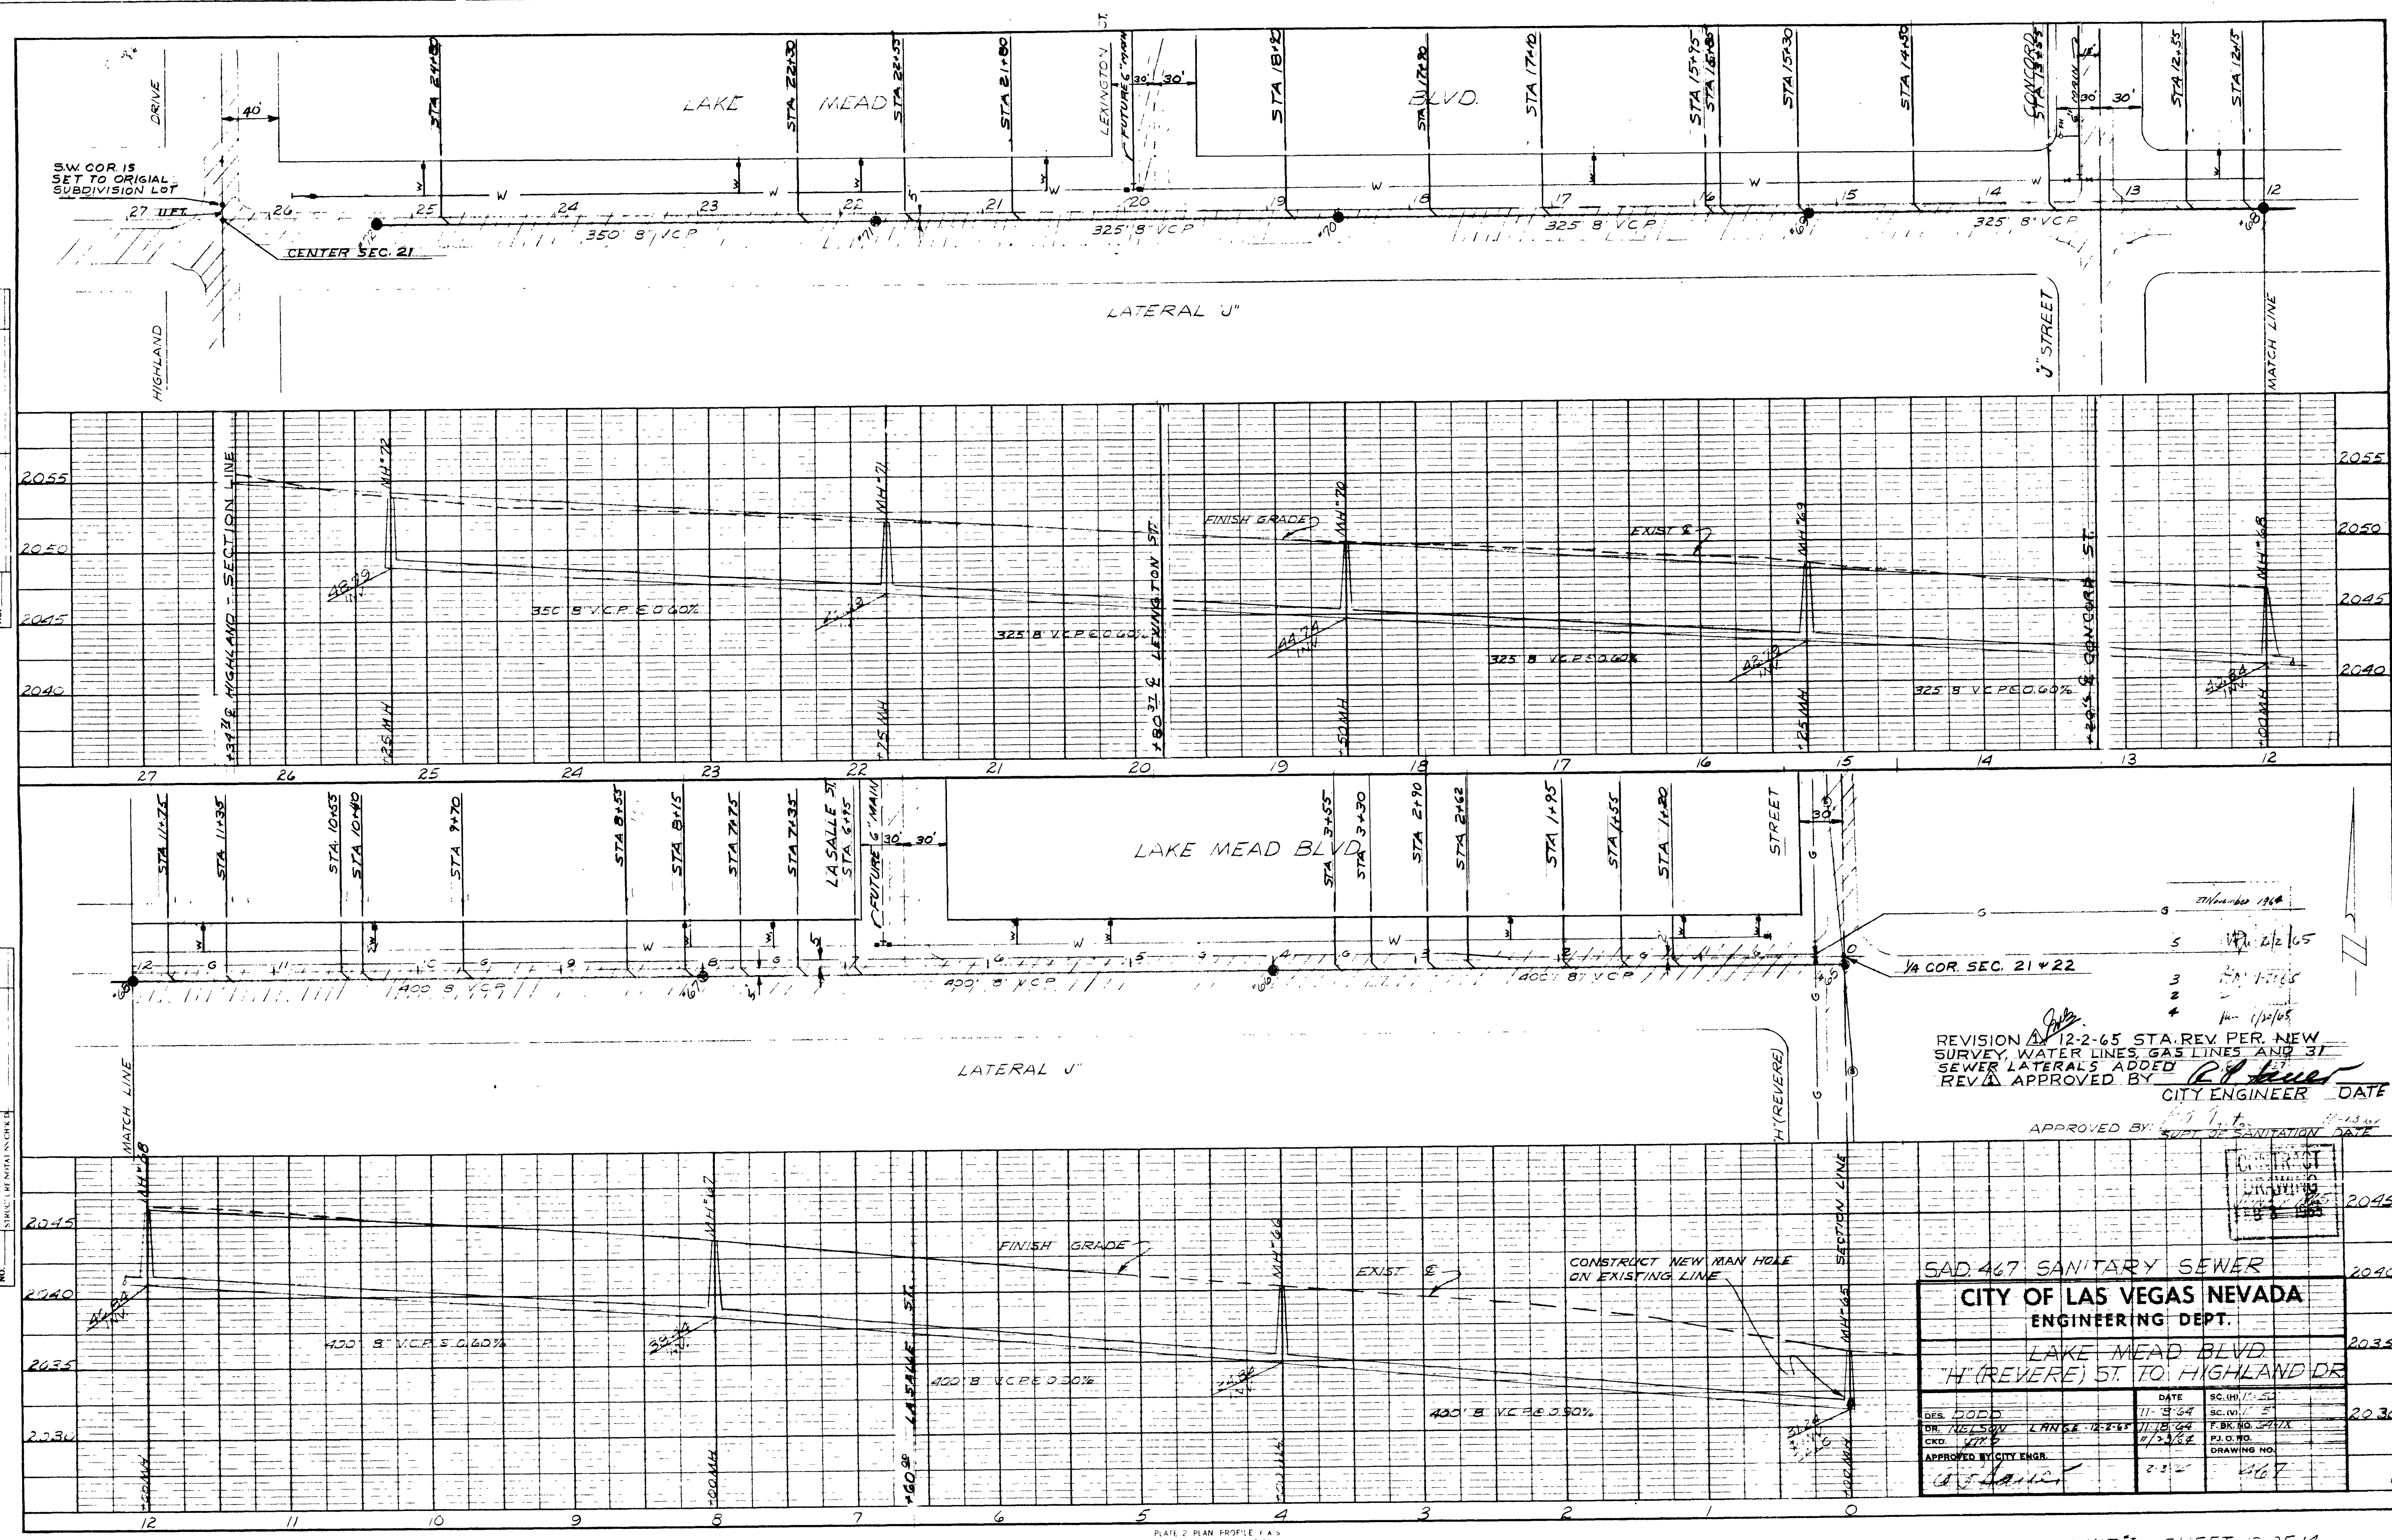

REVISION 12-2-65 STA. REV. PER NEW SURVEY. WATER LINES, GAS LINES AND ST. SEWER LATERALS ADDED. REV. APPROVED BY [Signature] CITY ENGINEER DATE 12-1-65

SAD 467 SANITARY SEWER

CITY OF LAS VEGAS NEVADA

ENGINEERING DEPT.

LAKE MEAD BLVD

"H" (REVERE) ST. TO HIGHLAND DR

DES. DODD	DATE 11-8-64	SC. (H) 11-8-64
DR. NELSON	DATE 11-8-64	SC. (V) 11-8-64
CKD. [Signature]	DATE 11-8-64	FILE NO. 467
APPROVED BY CITY ENGR.	DATE 12-1-65	DRAWING NO. 467

