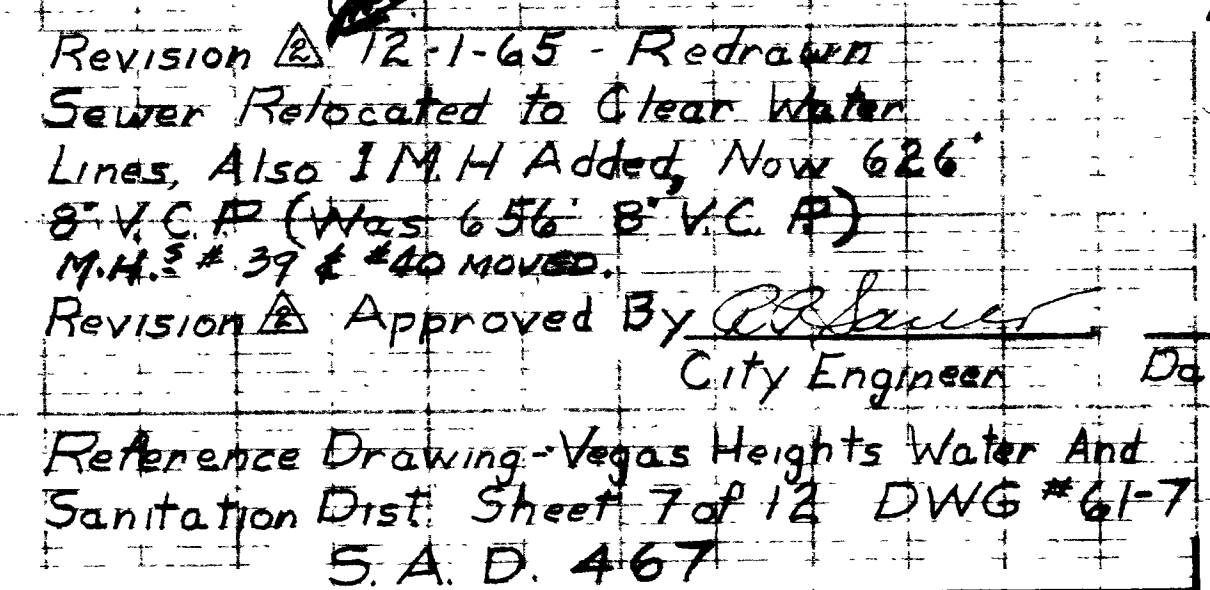
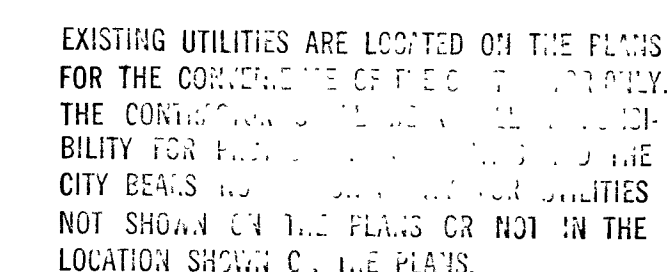


SCALE 1"=30'



CITY OF LAS VEGAS NEVADA
ENGINEERING DEPT.

CONCORD CIRCLE
REVISED SEWER DESIGN

DES. <u>GREIG</u>	DATE <u>11-30-65</u>	SG. NO. <u>1" 30'</u>
DR. <u>LANGE</u>		CG. NO. <u>1" 50'</u>
CKD. <u>[Signature]</u>	<u>12-1-61</u>	F.B.K. NO. <u>64-120</u>
APPROVED BY CITY ENGINEER <u>[Signature]</u>		P.J.O. NO. DRAWING NO. <u>467</u>

UNIT I SHEET 9A OF 14

307-V8

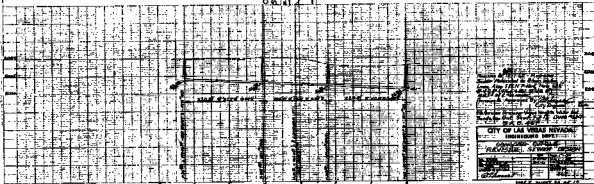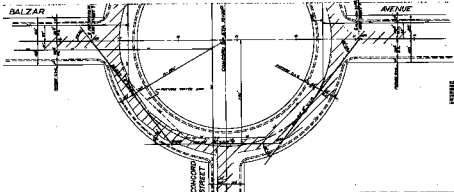

City of Las Vegas, Nevada
 Engineer's Office
 1000 Las Vegas Blvd. S.
 Las Vegas, Nevada
 Project No. 1000
 Date of Survey, 1929
 Date of Plan, 1929
 City of Las Vegas, Nevada
 Engineer's Office
 1000 Las Vegas Blvd. S.
 Las Vegas, Nevada
 Project No. 1000
 Date of Survey, 1929
 Date of Plan, 1929