


PLAN	SURVEYED	DATE
	NOTE BOOK	NO.
PROFILE	SURVEYED	DATE
	NOTE BOOK	NO.

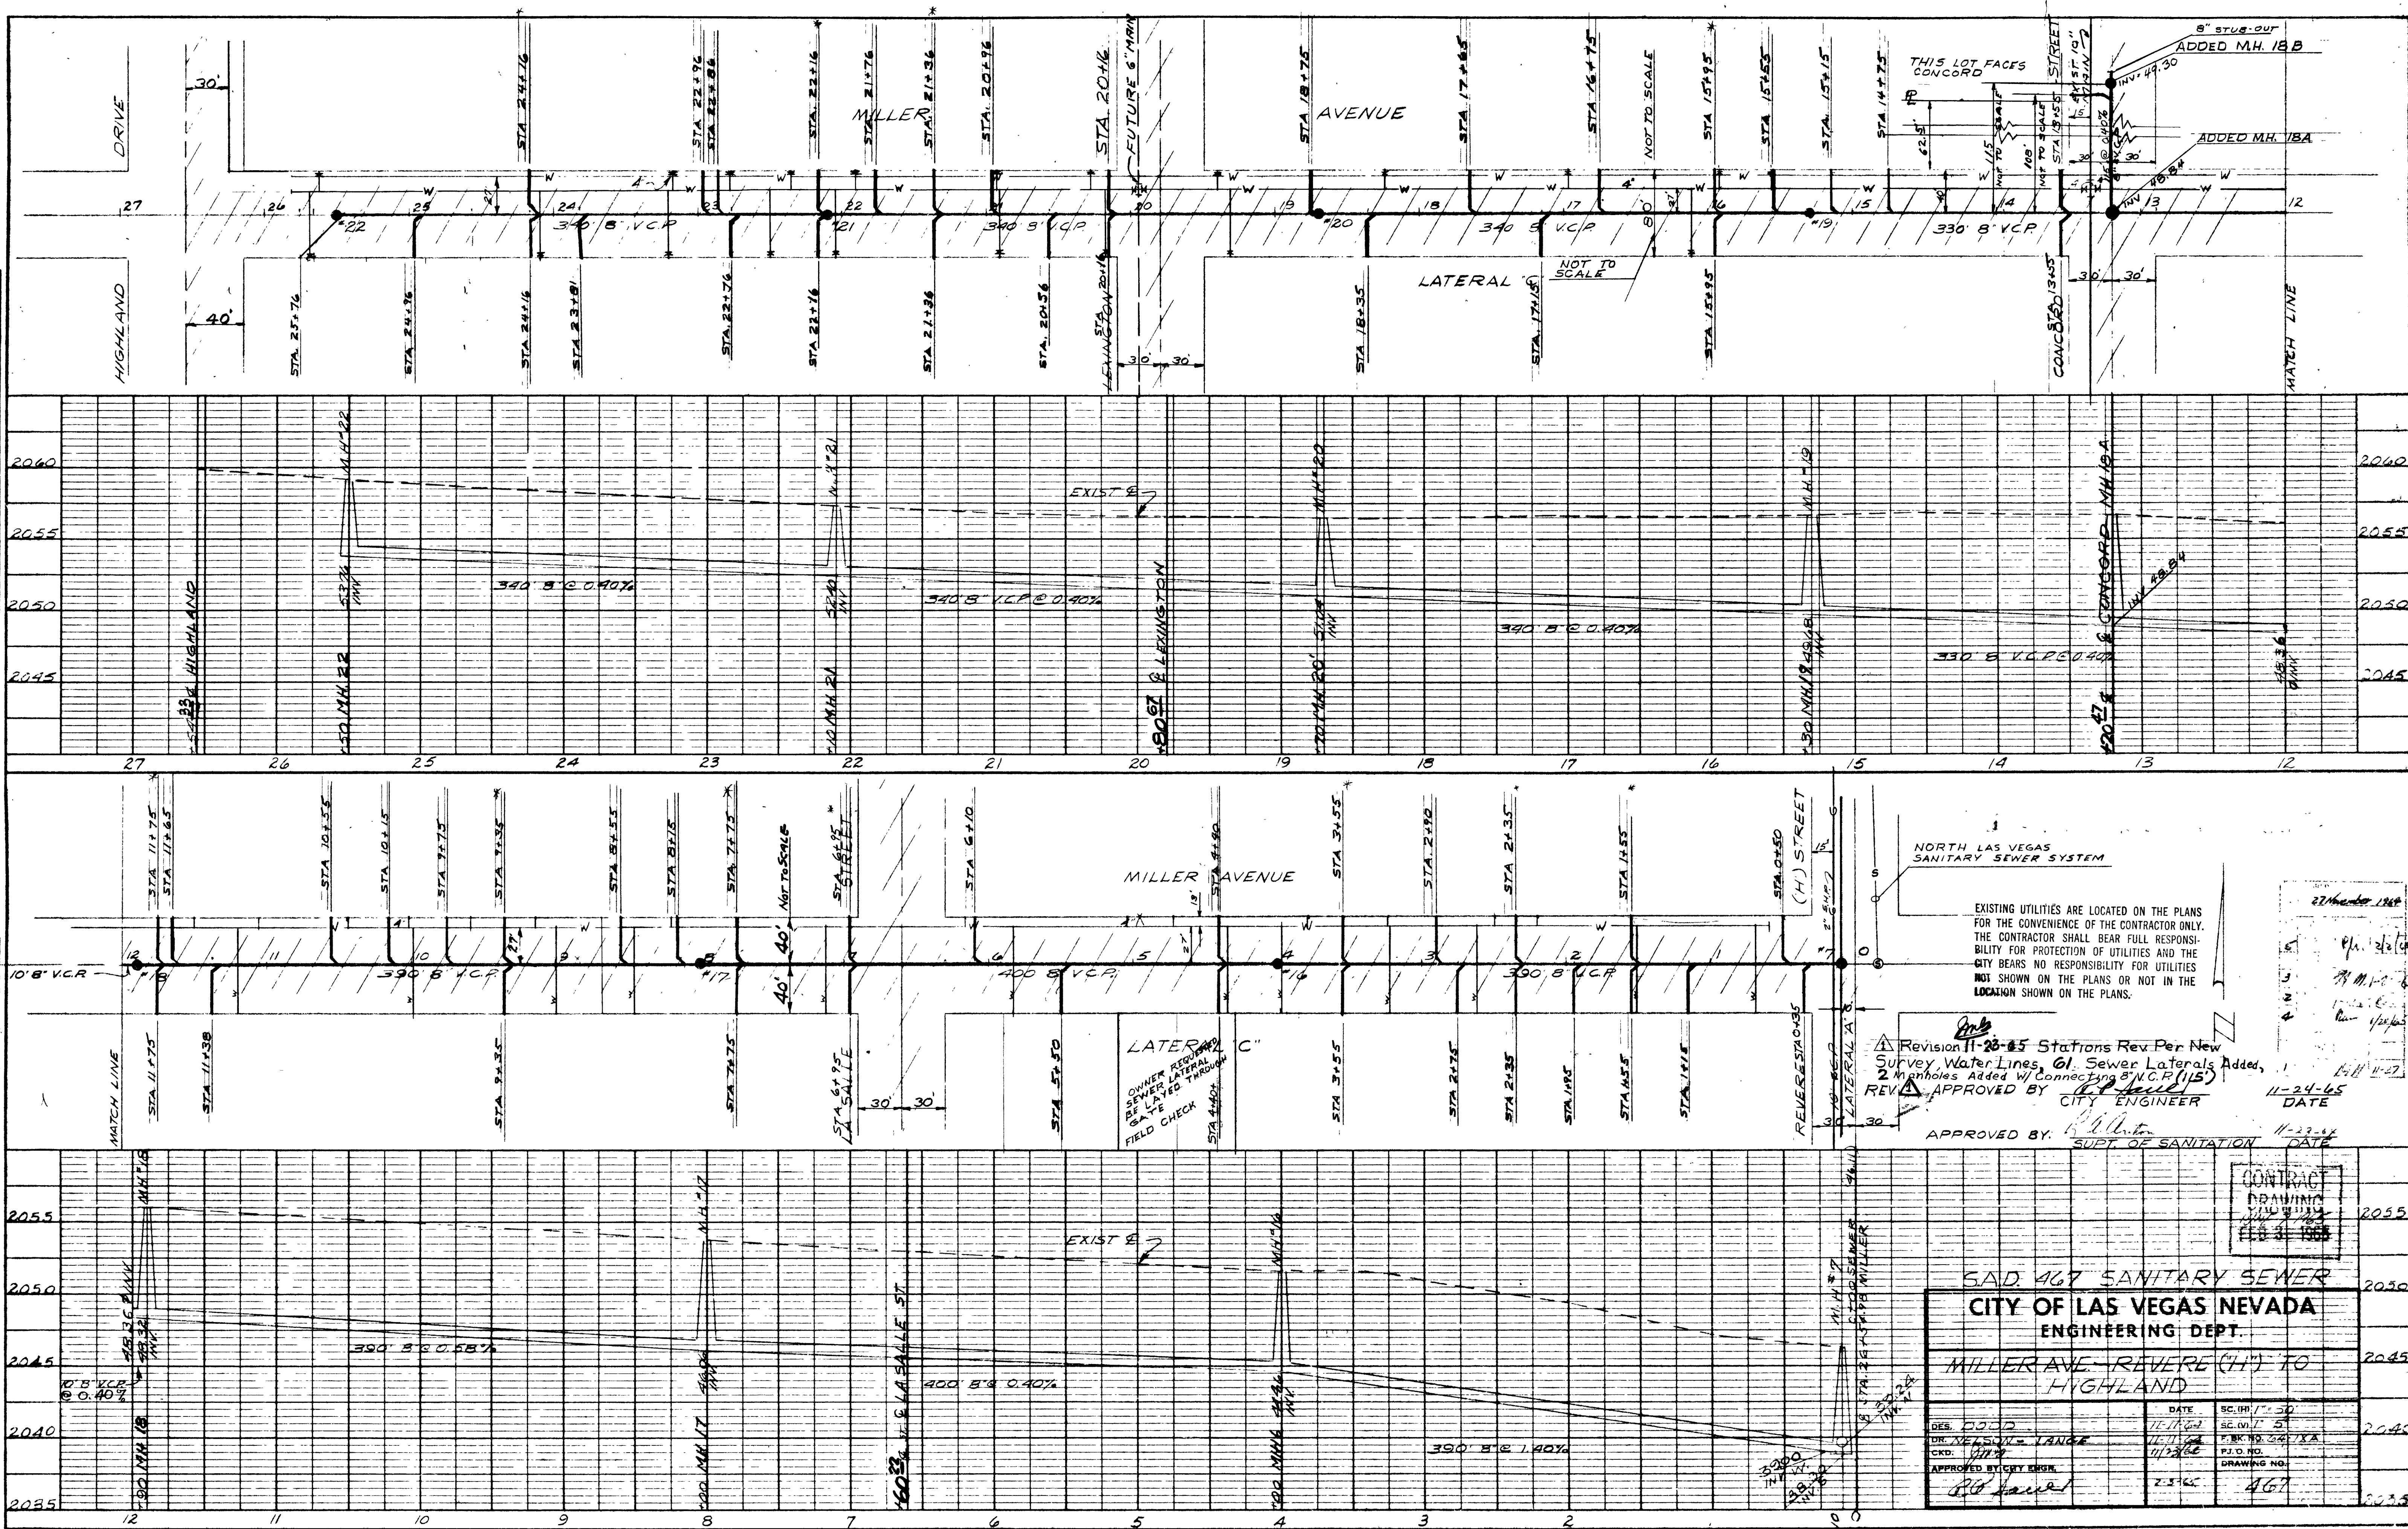

27th March 1968

Revision 11-25-65 Stations Rev Per New Survey Water Lines, 61. Sewer Laterals Added, 2 Manholes Added W/ Connecting 8" V.C.P. (115')

REV'D APPROVED BY *[Signature]* CITY ENGINEER 11-24-65 DATE


APPROVED BY *[Signature]* SUPT. OF SANITATION 11-23-65 DATE

CONTRACT DRAWING NO. 467 FEB 31 1968

SAD 467 SANITARY SEWER CITY OF LAS VEGAS NEVADA ENGINEERING DEPT. MILLER AVE REVERE (11') TO HIGHLAND

DES. 2032	DATE 11/1/65	SC. (H) 17-50
CHKD. 11/1/65	DATE 11/1/65	SC. (H) 51
APPROVED BY CRY BUSH	DATE 11/23/65	P.J. O. NO.
	DATE 11/23/65	DRAWING NO.

467

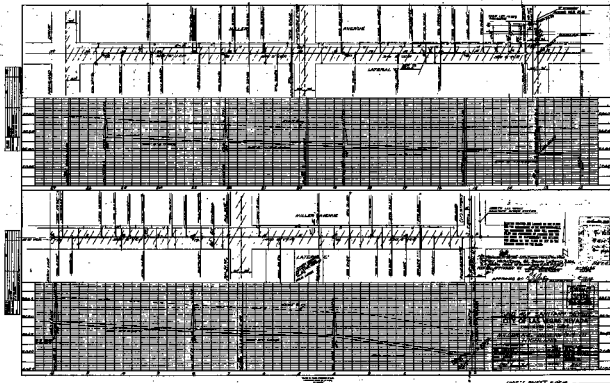

APPROVED BY: [Signature]
 CITY OF LOS ANGELES
 DEPARTMENT OF PUBLIC WORKS
 DIVISION OF BRIDGE ENGINEERING