
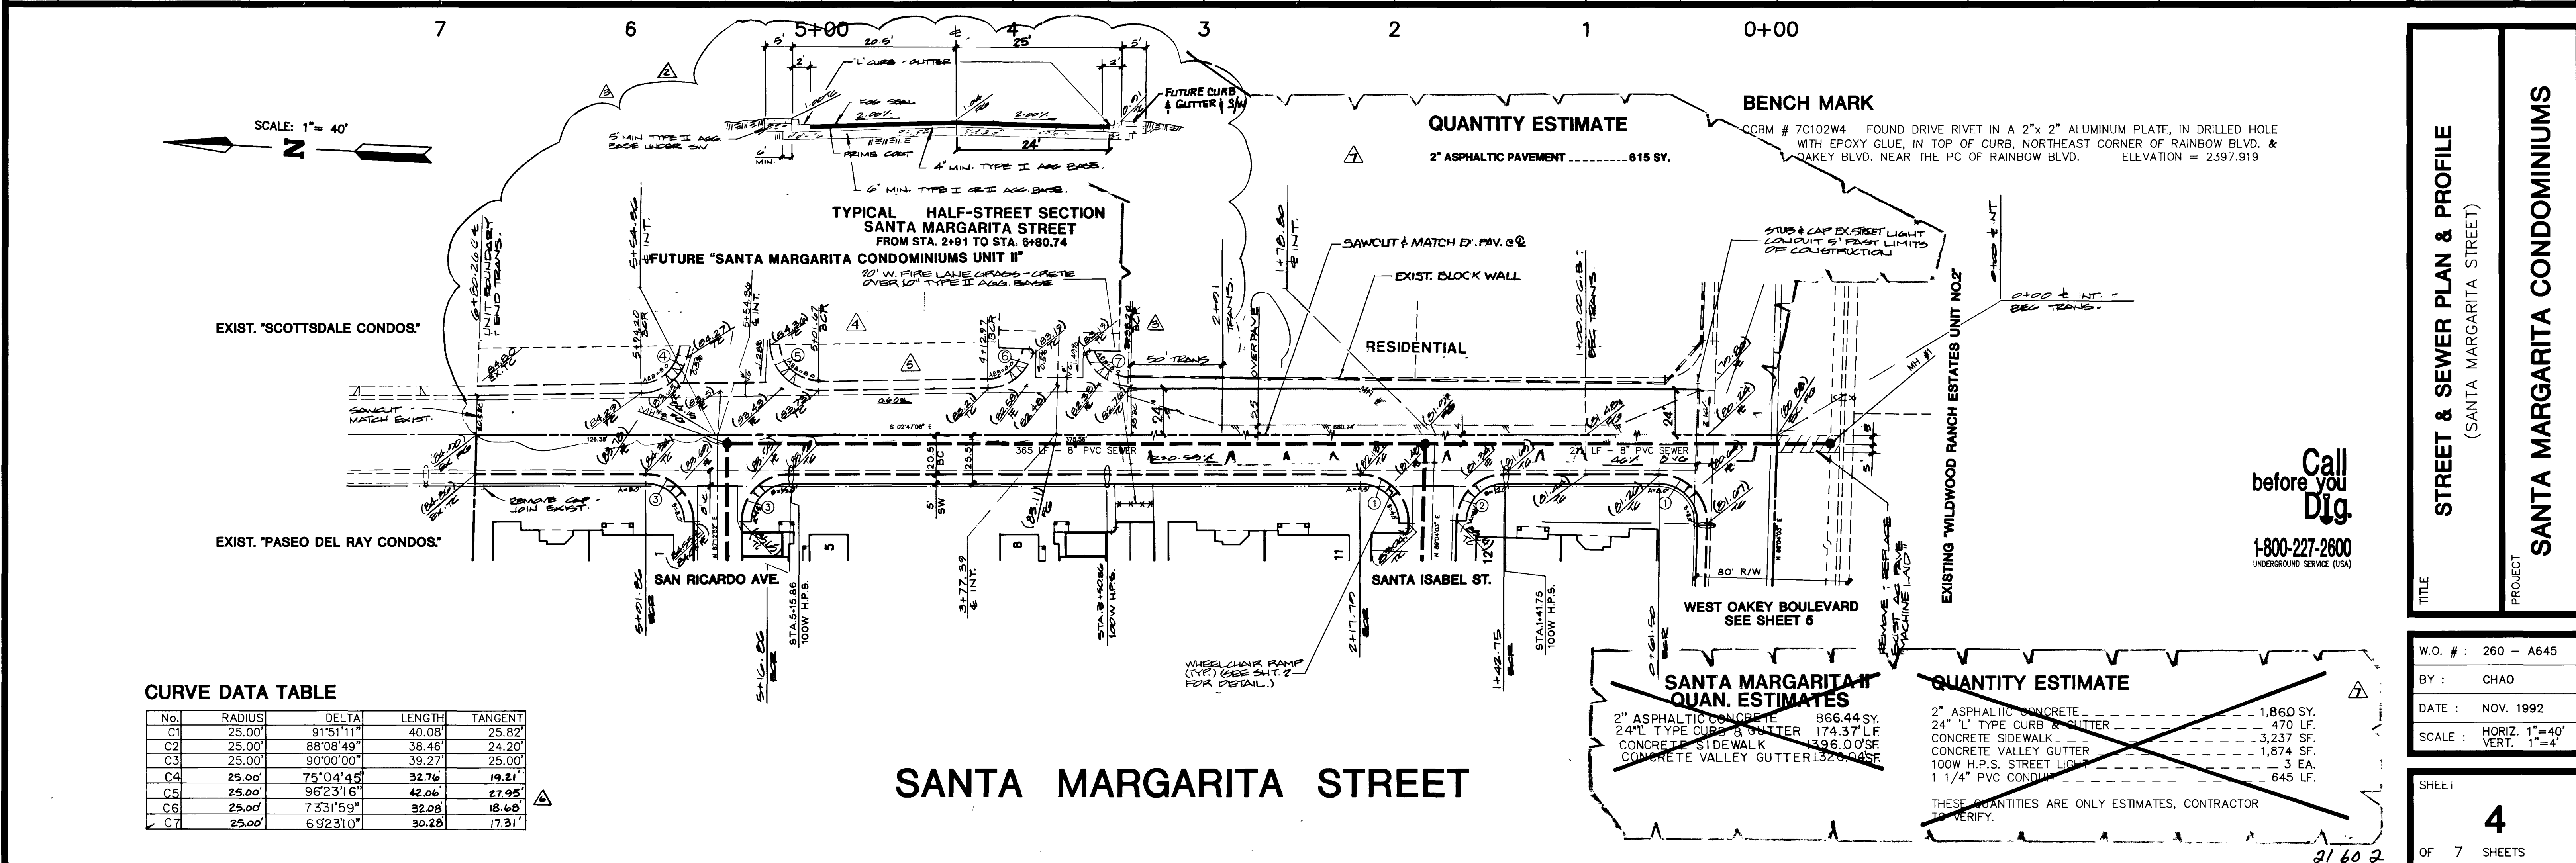


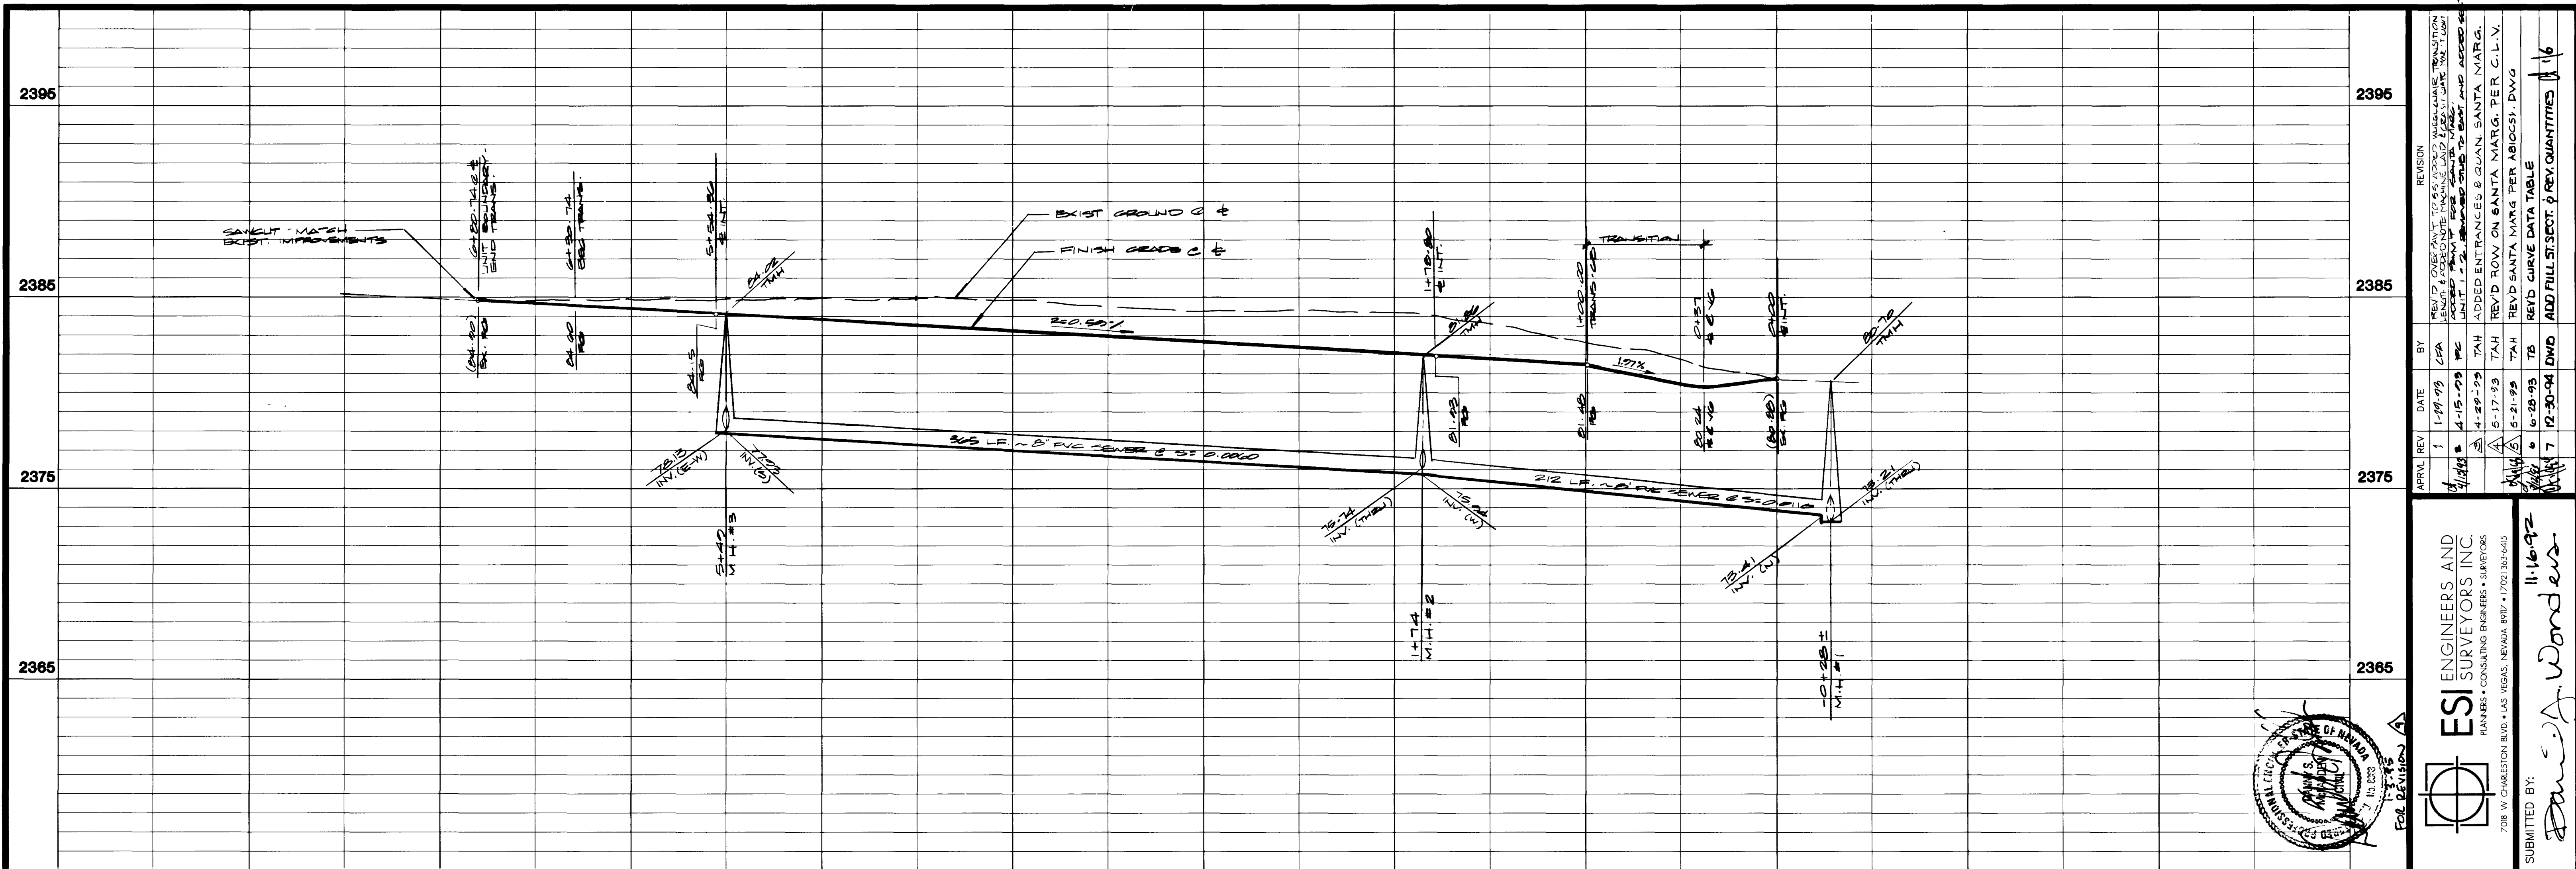

REVISION

NO.	DATE	BY	DESCRIPTION
1	1-19-99	LPA	REVISED OVERLAP TO 24" TYPE CURB & GUTTER
2	4-15-99	MC	ADDED 1/4" TYPE CURB & GUTTER
3	4-29-99	TAH	ADDED ENTRANCES & GUAN SANTA MARG.
4	5-17-99	TAH	REV'D ROW ON SANTA MARG. PER C.L.V.
5	5-21-99	TAH	REV'D SANTA MARG PER ABIGOSI, DWG
6	6-28-99	TAH	REV'D CURVE DATA TABLE
7	12-30-99	DWD	ADD FULL ST. SECT. & REV. QUANTITIES

ESI ENGINEERS AND SURVEYORS INC.
PLANNERS • CONSULTING ENGINEERS • SURVEYORS
708 W. CHARLESTON BLVD. • LAS VEGAS, NEVADA 89101 • 772.33.6415

SUBMITTED BY: *Danielle A. Wonders* 11-16-92

STREET & SEWER PLAN & PROFILE
(SANTA MARGARITA STREET)

PROJECT
SANTA MARGARITA CONDOMINIUMS

W.O. #: 260 - A645
BY: CHAO
DATE: NOV. 1992
SCALE: HORIZ. 1"=40'
VERT. 1"=4'

SHEET
4
OF 7 SHEETS

1357 10-27-54 1074-4249

