
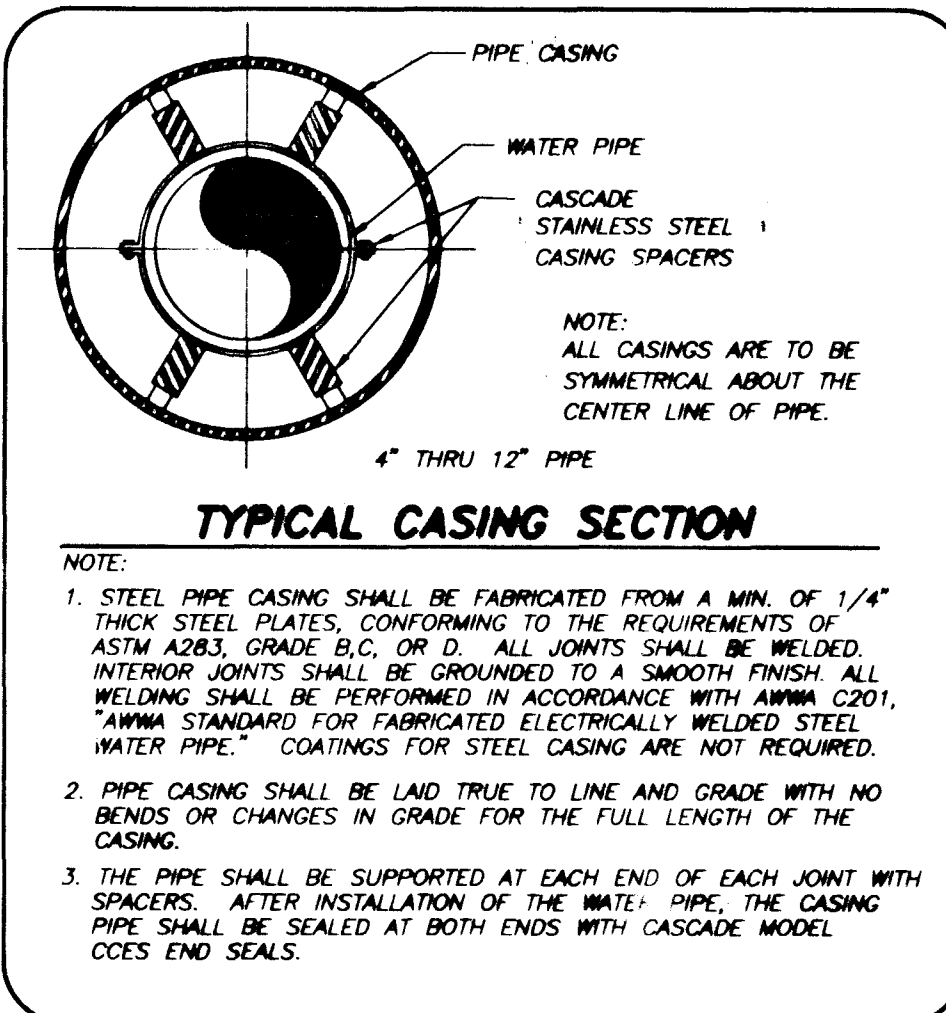
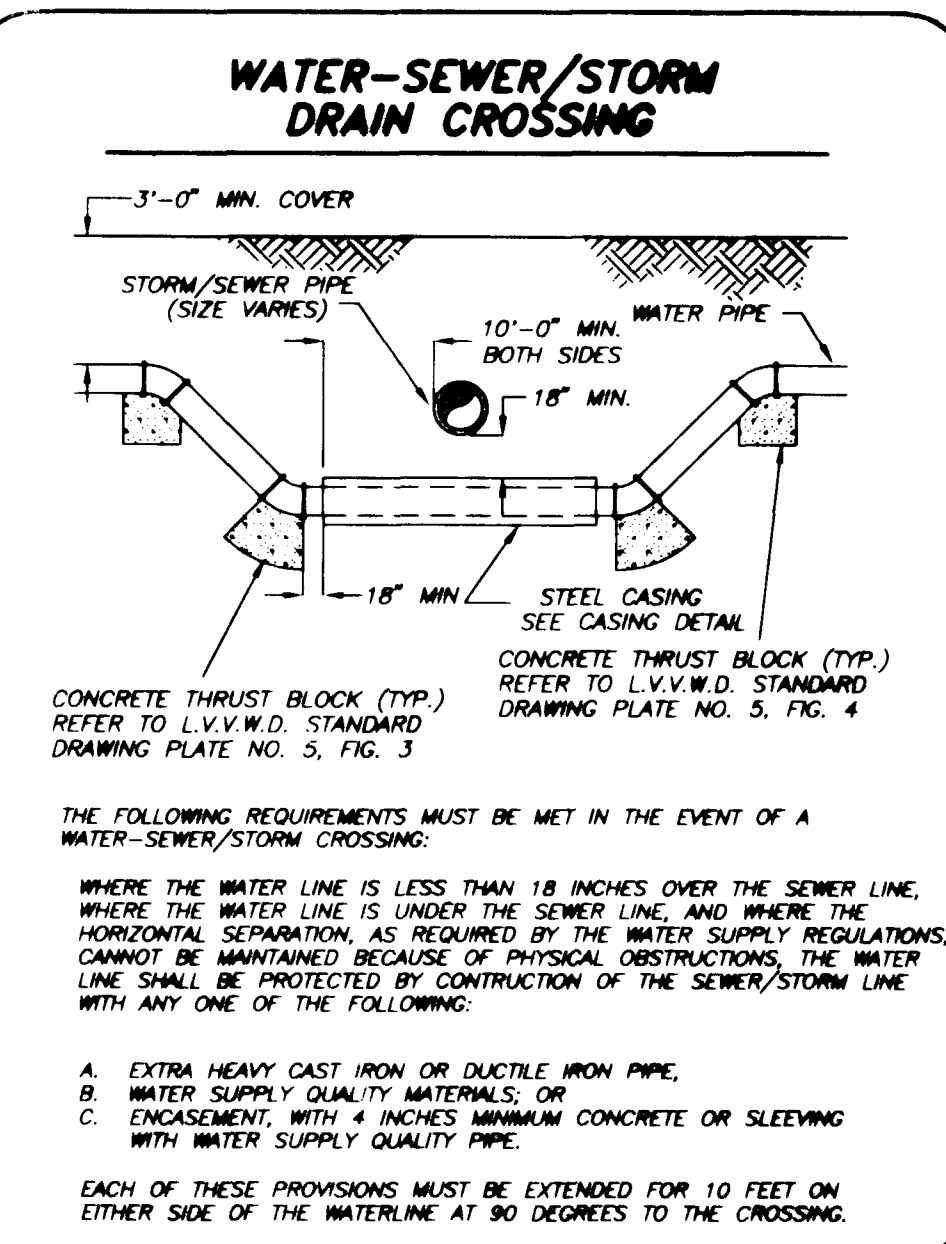
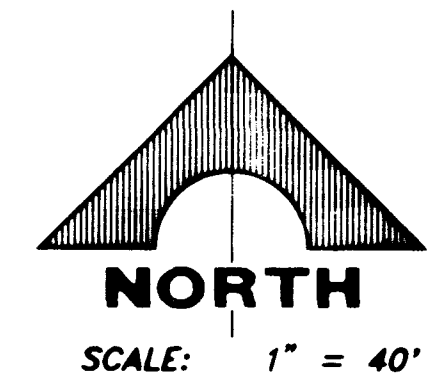


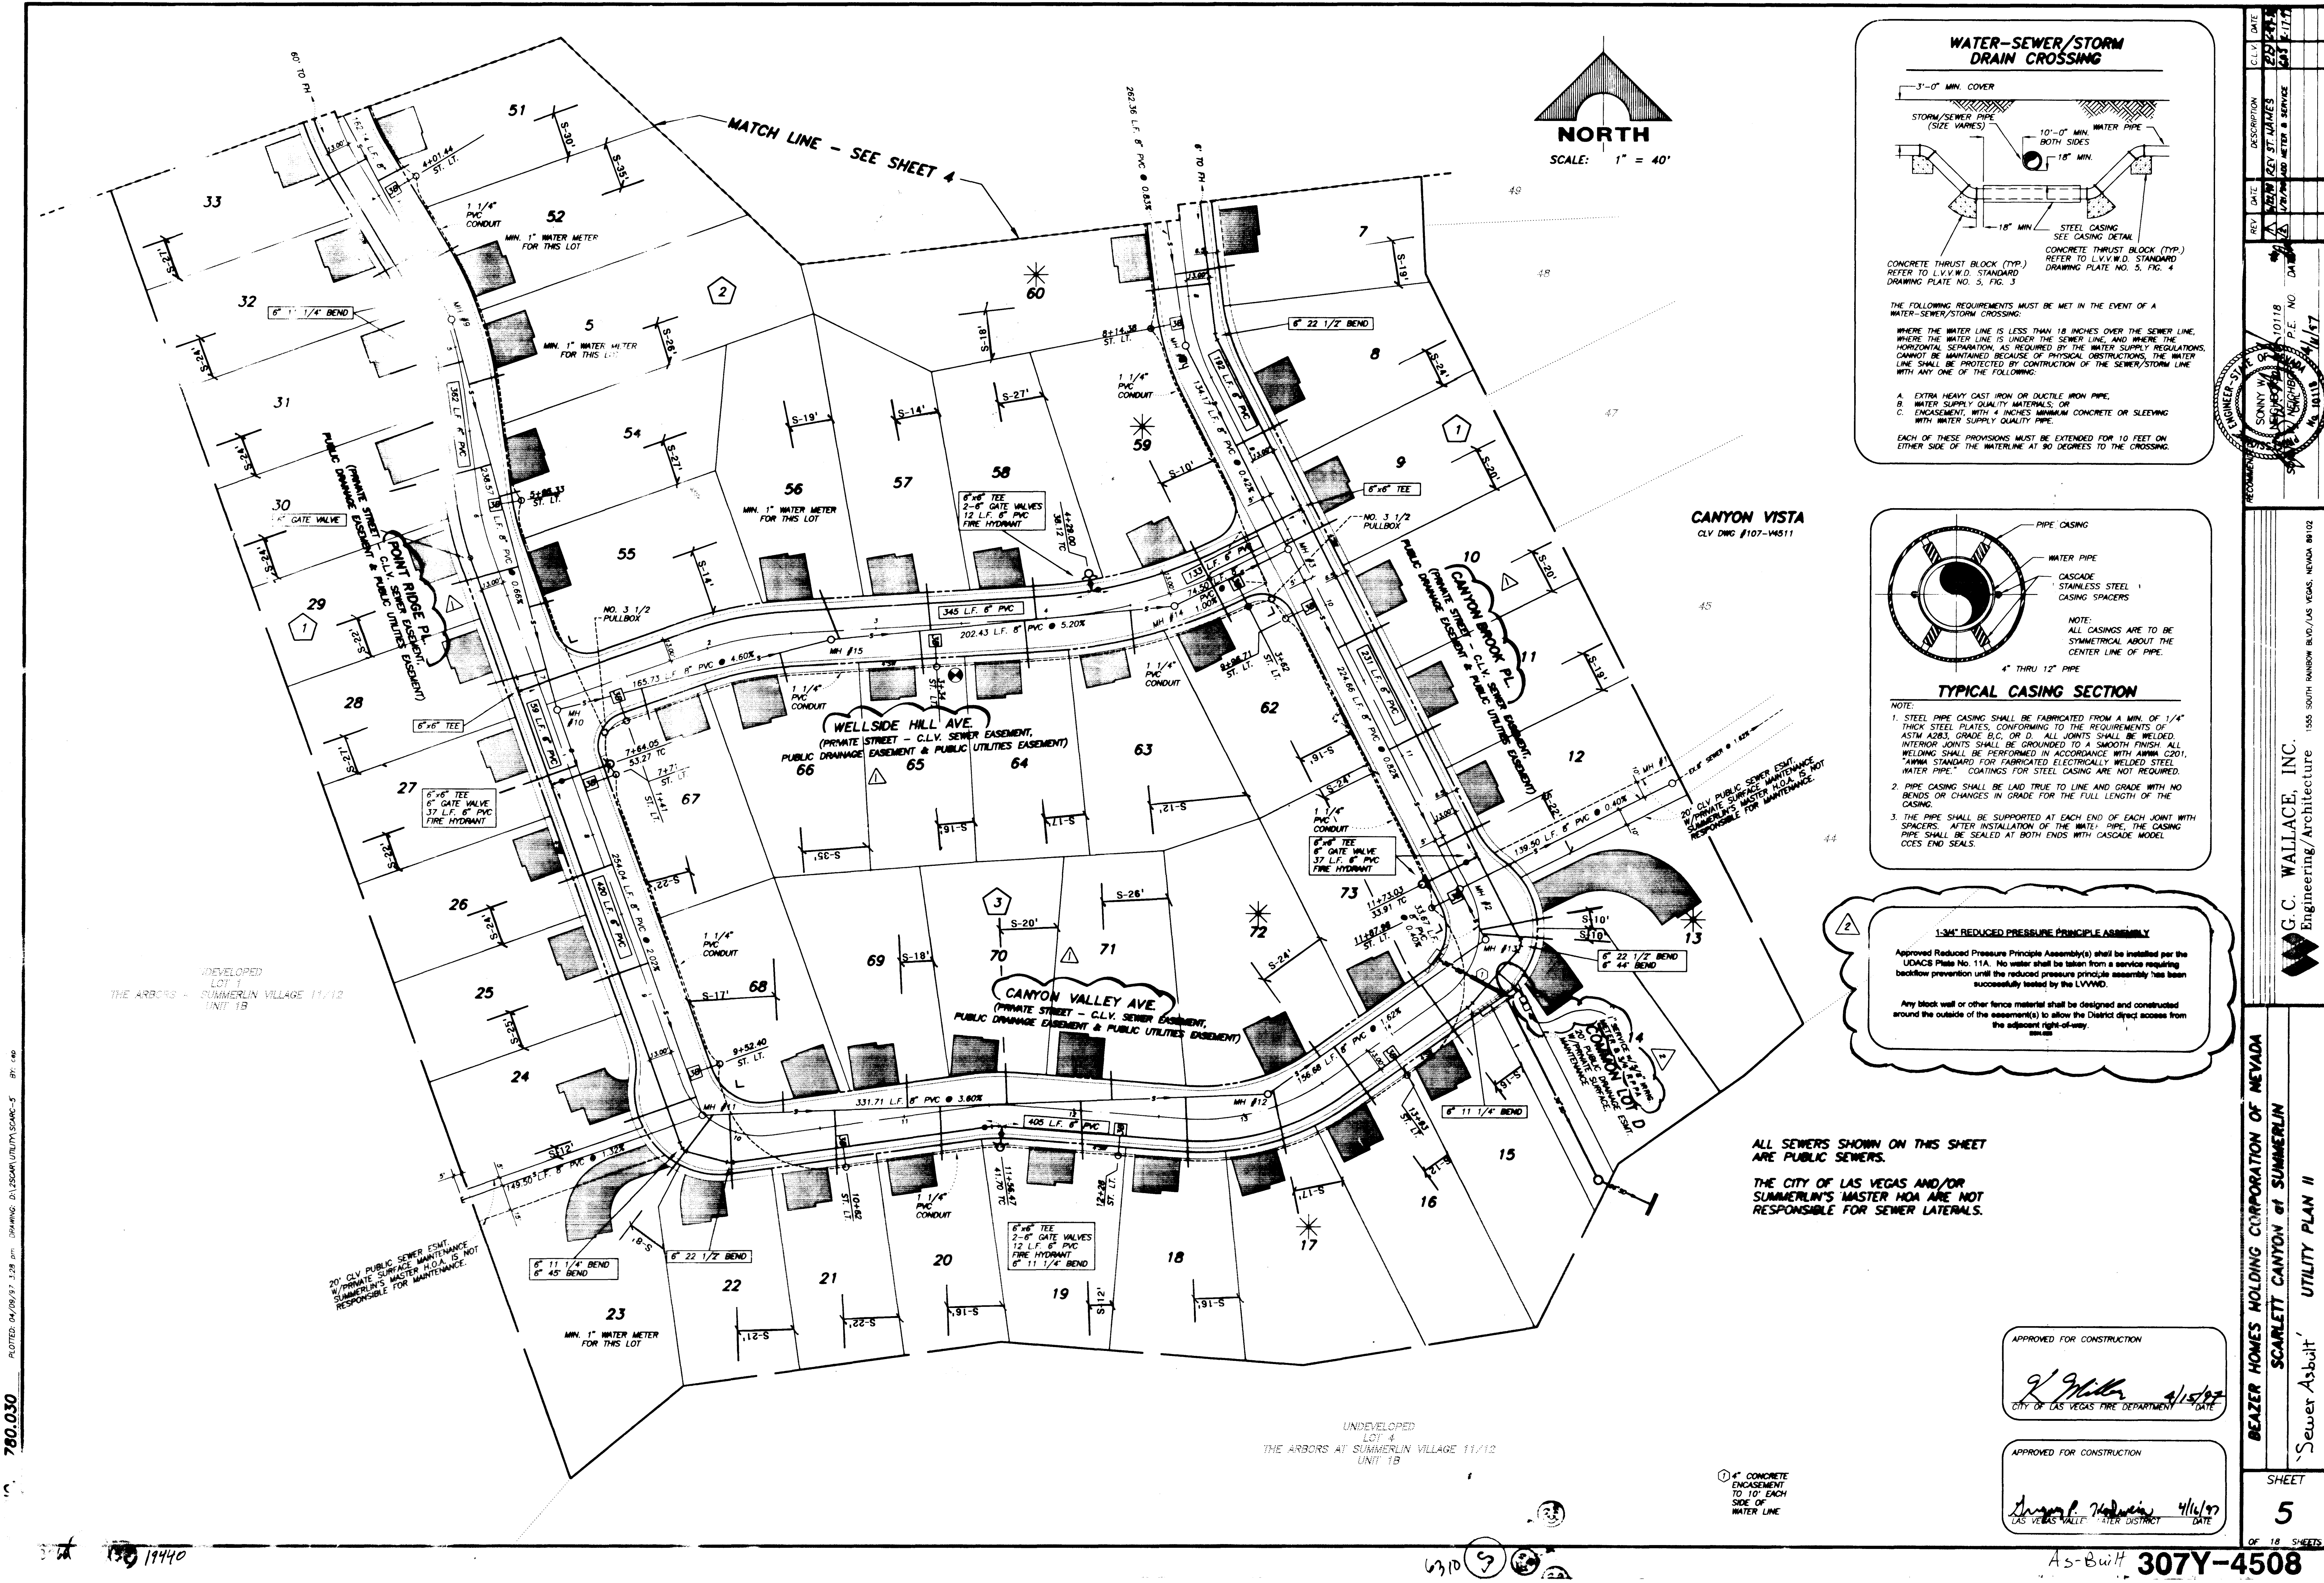

1-3/4" REDUCED PRESSURE PRINCIPLE ASSEMBLY

Approved Reduced Pressure Principle Assembly(s) shall be installed per the UDACs Plate No. 11A. No water shall be taken from a service requiring backflow prevention until the reduced pressure principle assembly has been successfully tested by the LVVWD.

Any block wall or other fence material shall be designed and constructed around the outside of the easement(s) to allow the District direct access from the adjacent right-of-way.

ALL SEWERS SHOWN ON THIS SHEET ARE PUBLIC SEWERS.

THE CITY OF LAS VEGAS AND/OR SUMMERLIN'S MASTER HOA ARE NOT RESPONSIBLE FOR SEWER LATERALS.

APPROVED FOR CONSTRUCTION

[Signature] 4/15/97
CITY OF LAS VEGAS FIRE DEPARTMENT DATE

APPROVED FOR CONSTRUCTION

[Signature] 4/16/97
LAS VEGAS WATER DISTRICT DATE

BEAZER HOMES HOLDING CORPORATION OF NEVADA
SCARLETT CANYON at SUMMERLIN
Sewer As-built UTILITY PLAN II

ENGINEER: SONNY WALLACE, INC.
1555 SOUTH RAINBOW BLVD./LAS VEGAS, NEVADA 89102

SHEET 5 OF 18 SHEETS

As-Built 307Y-4508

