


12-1-67



|      |                                                                                    |      |
|------|------------------------------------------------------------------------------------|------|
| PLAN | SURVISED<br>PLOTTED<br>NOTE BOOK<br>ALIGNMENT CHECKED<br>BY: OF HWY CHECKED<br>NO. | DATE |
|      |                                                                                    |      |

|         |                                                                                           |      |
|---------|-------------------------------------------------------------------------------------------|------|
| PROFILE | SURVISED<br>PLOTTED<br>NOTE BOOK<br>GRADES CHECKED<br>BY: STRUCTURE NOTATIONS CHVD<br>NO. | DATE |
|         |                                                                                           |      |

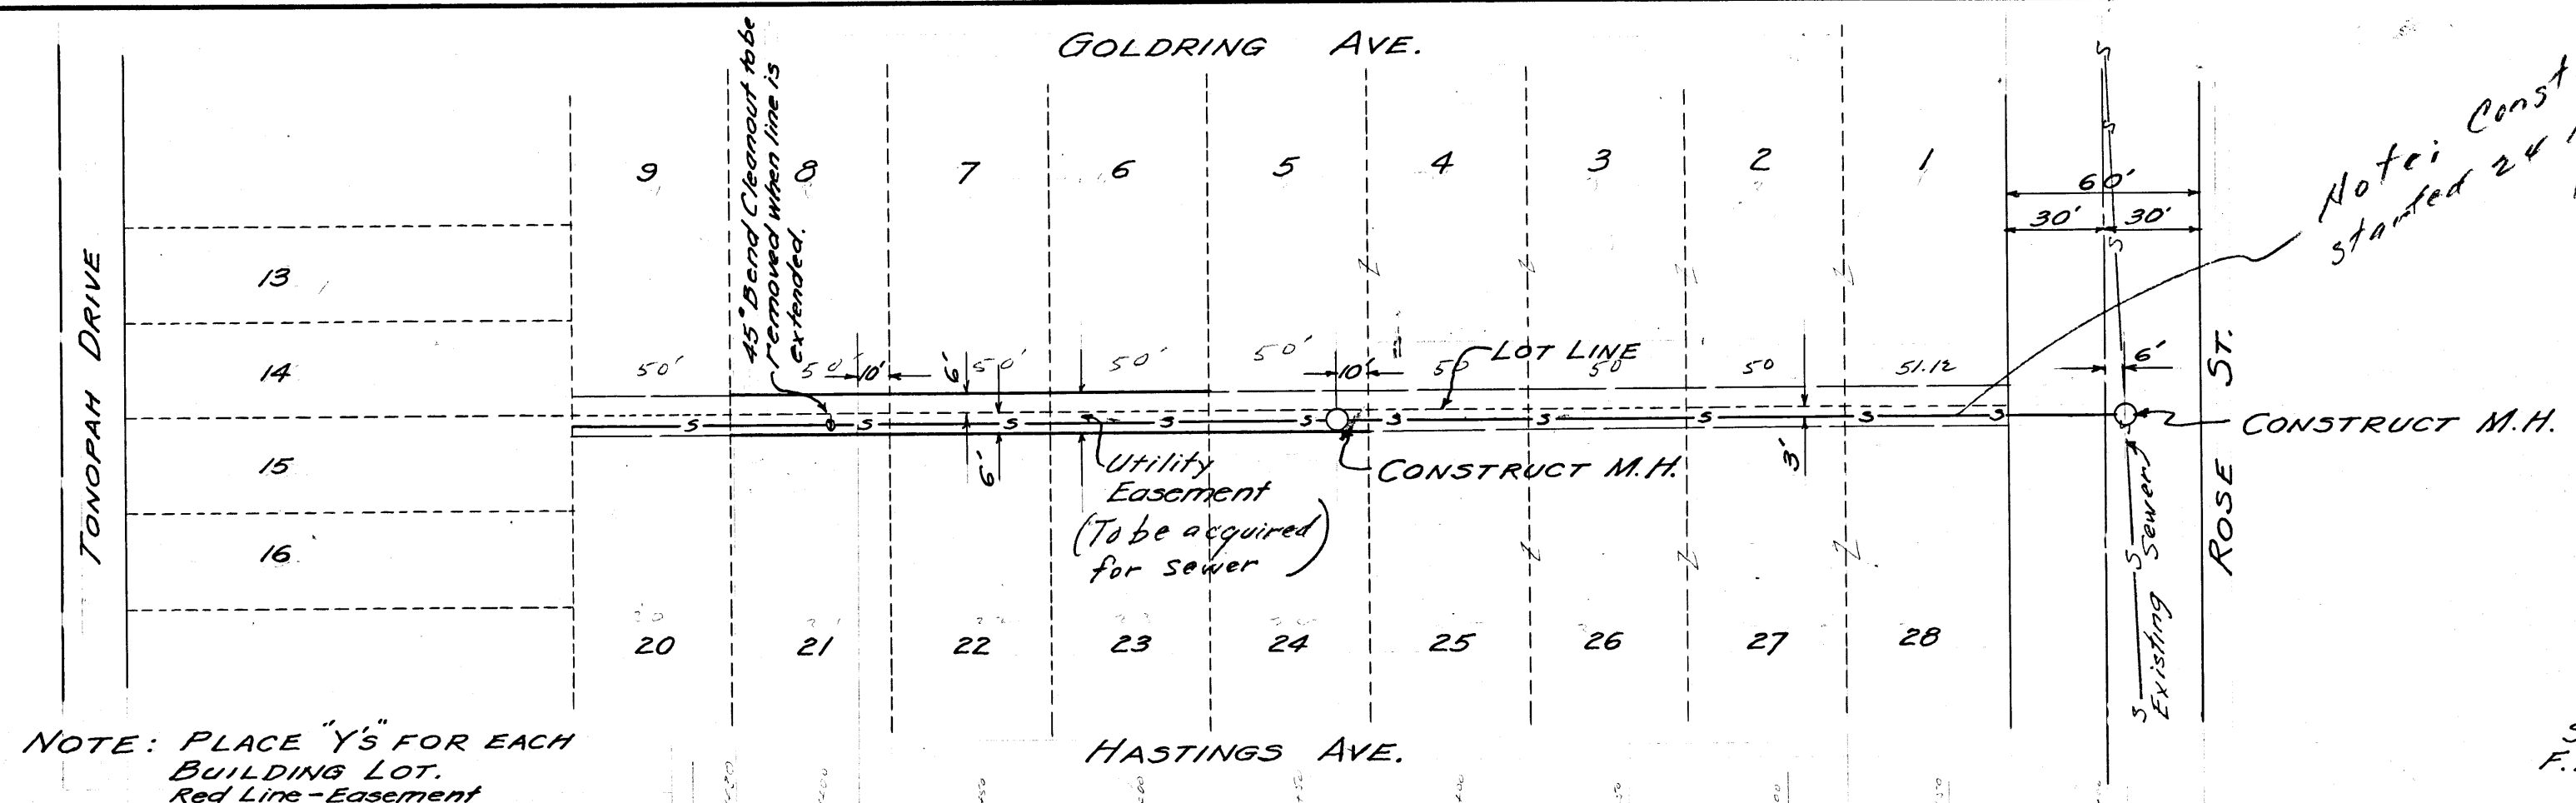

NOTE: PLACE 'Y'S FOR EACH BUILDING LOT. Red Line - Easement

SCALE 1"=50'  
F.B. 1055-26

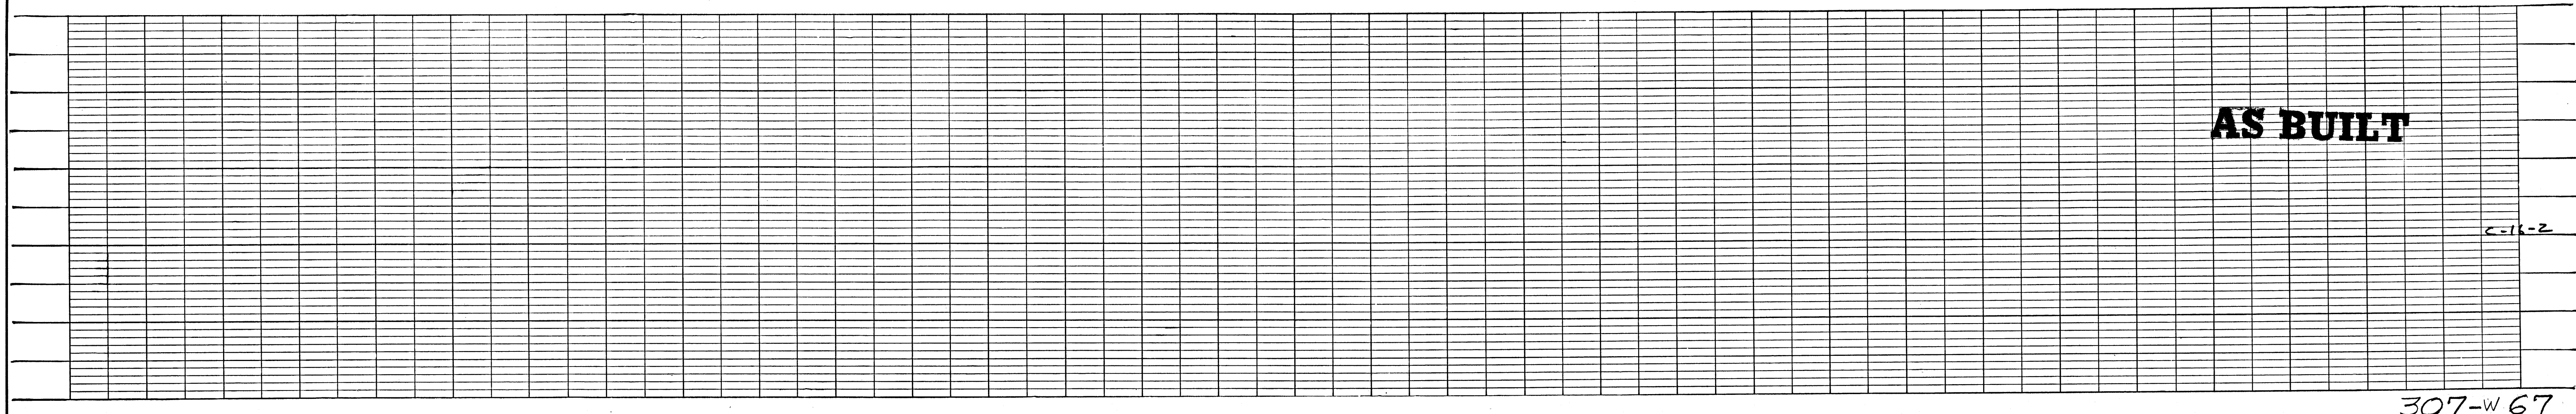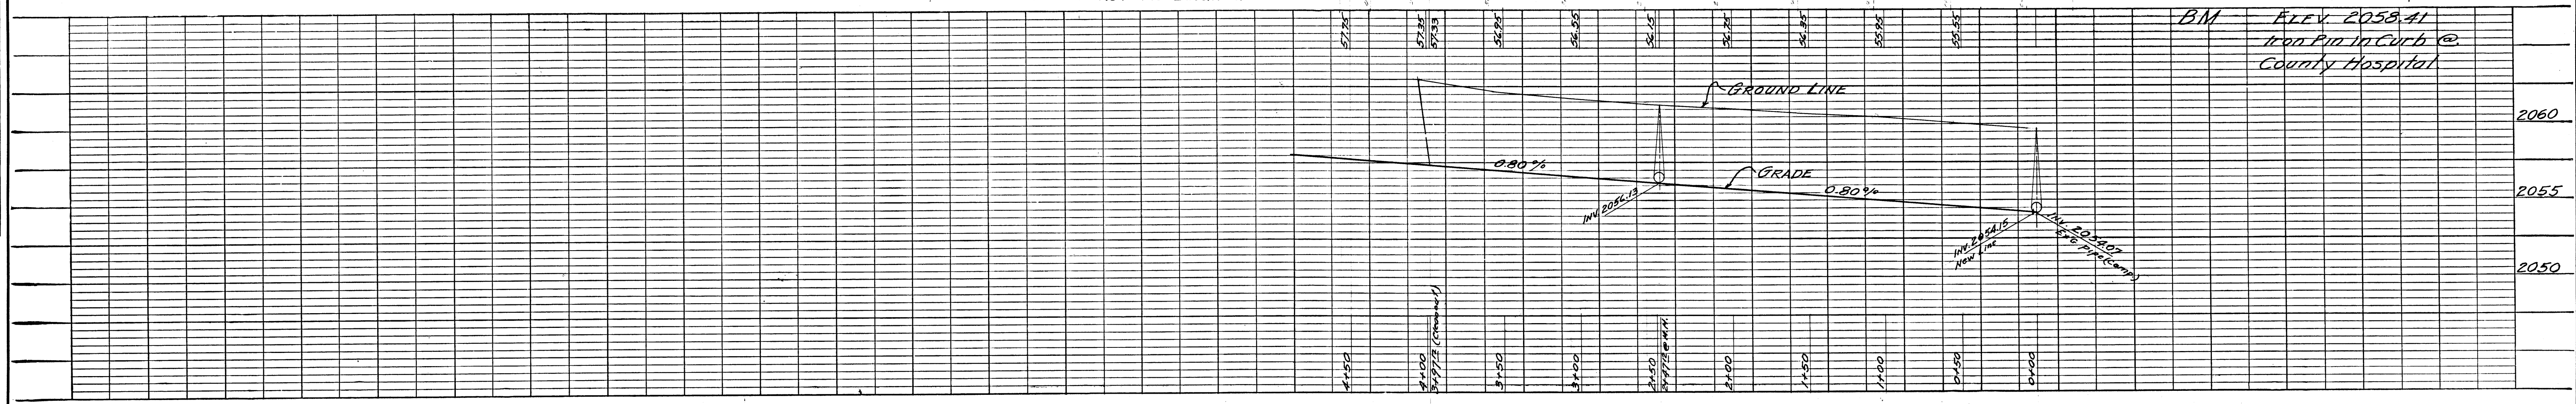

AS BUILT

C-16-2

307-W 67

IN EASEMENT - BETWEEN HASTINGS & GOLDRING AVE'S - WEST OF ROSE ST.