


CONSTRUCT MANHOLES AT STA.  
0+06, 3+50, 6+40


| CONSTRUCT 8" V.C.P. SEWER |         |
|---------------------------|---------|
| FROM STA.                 | TO STA. |
| 0+06                      | 3+50    |
| 3+50                      | 6+40    |

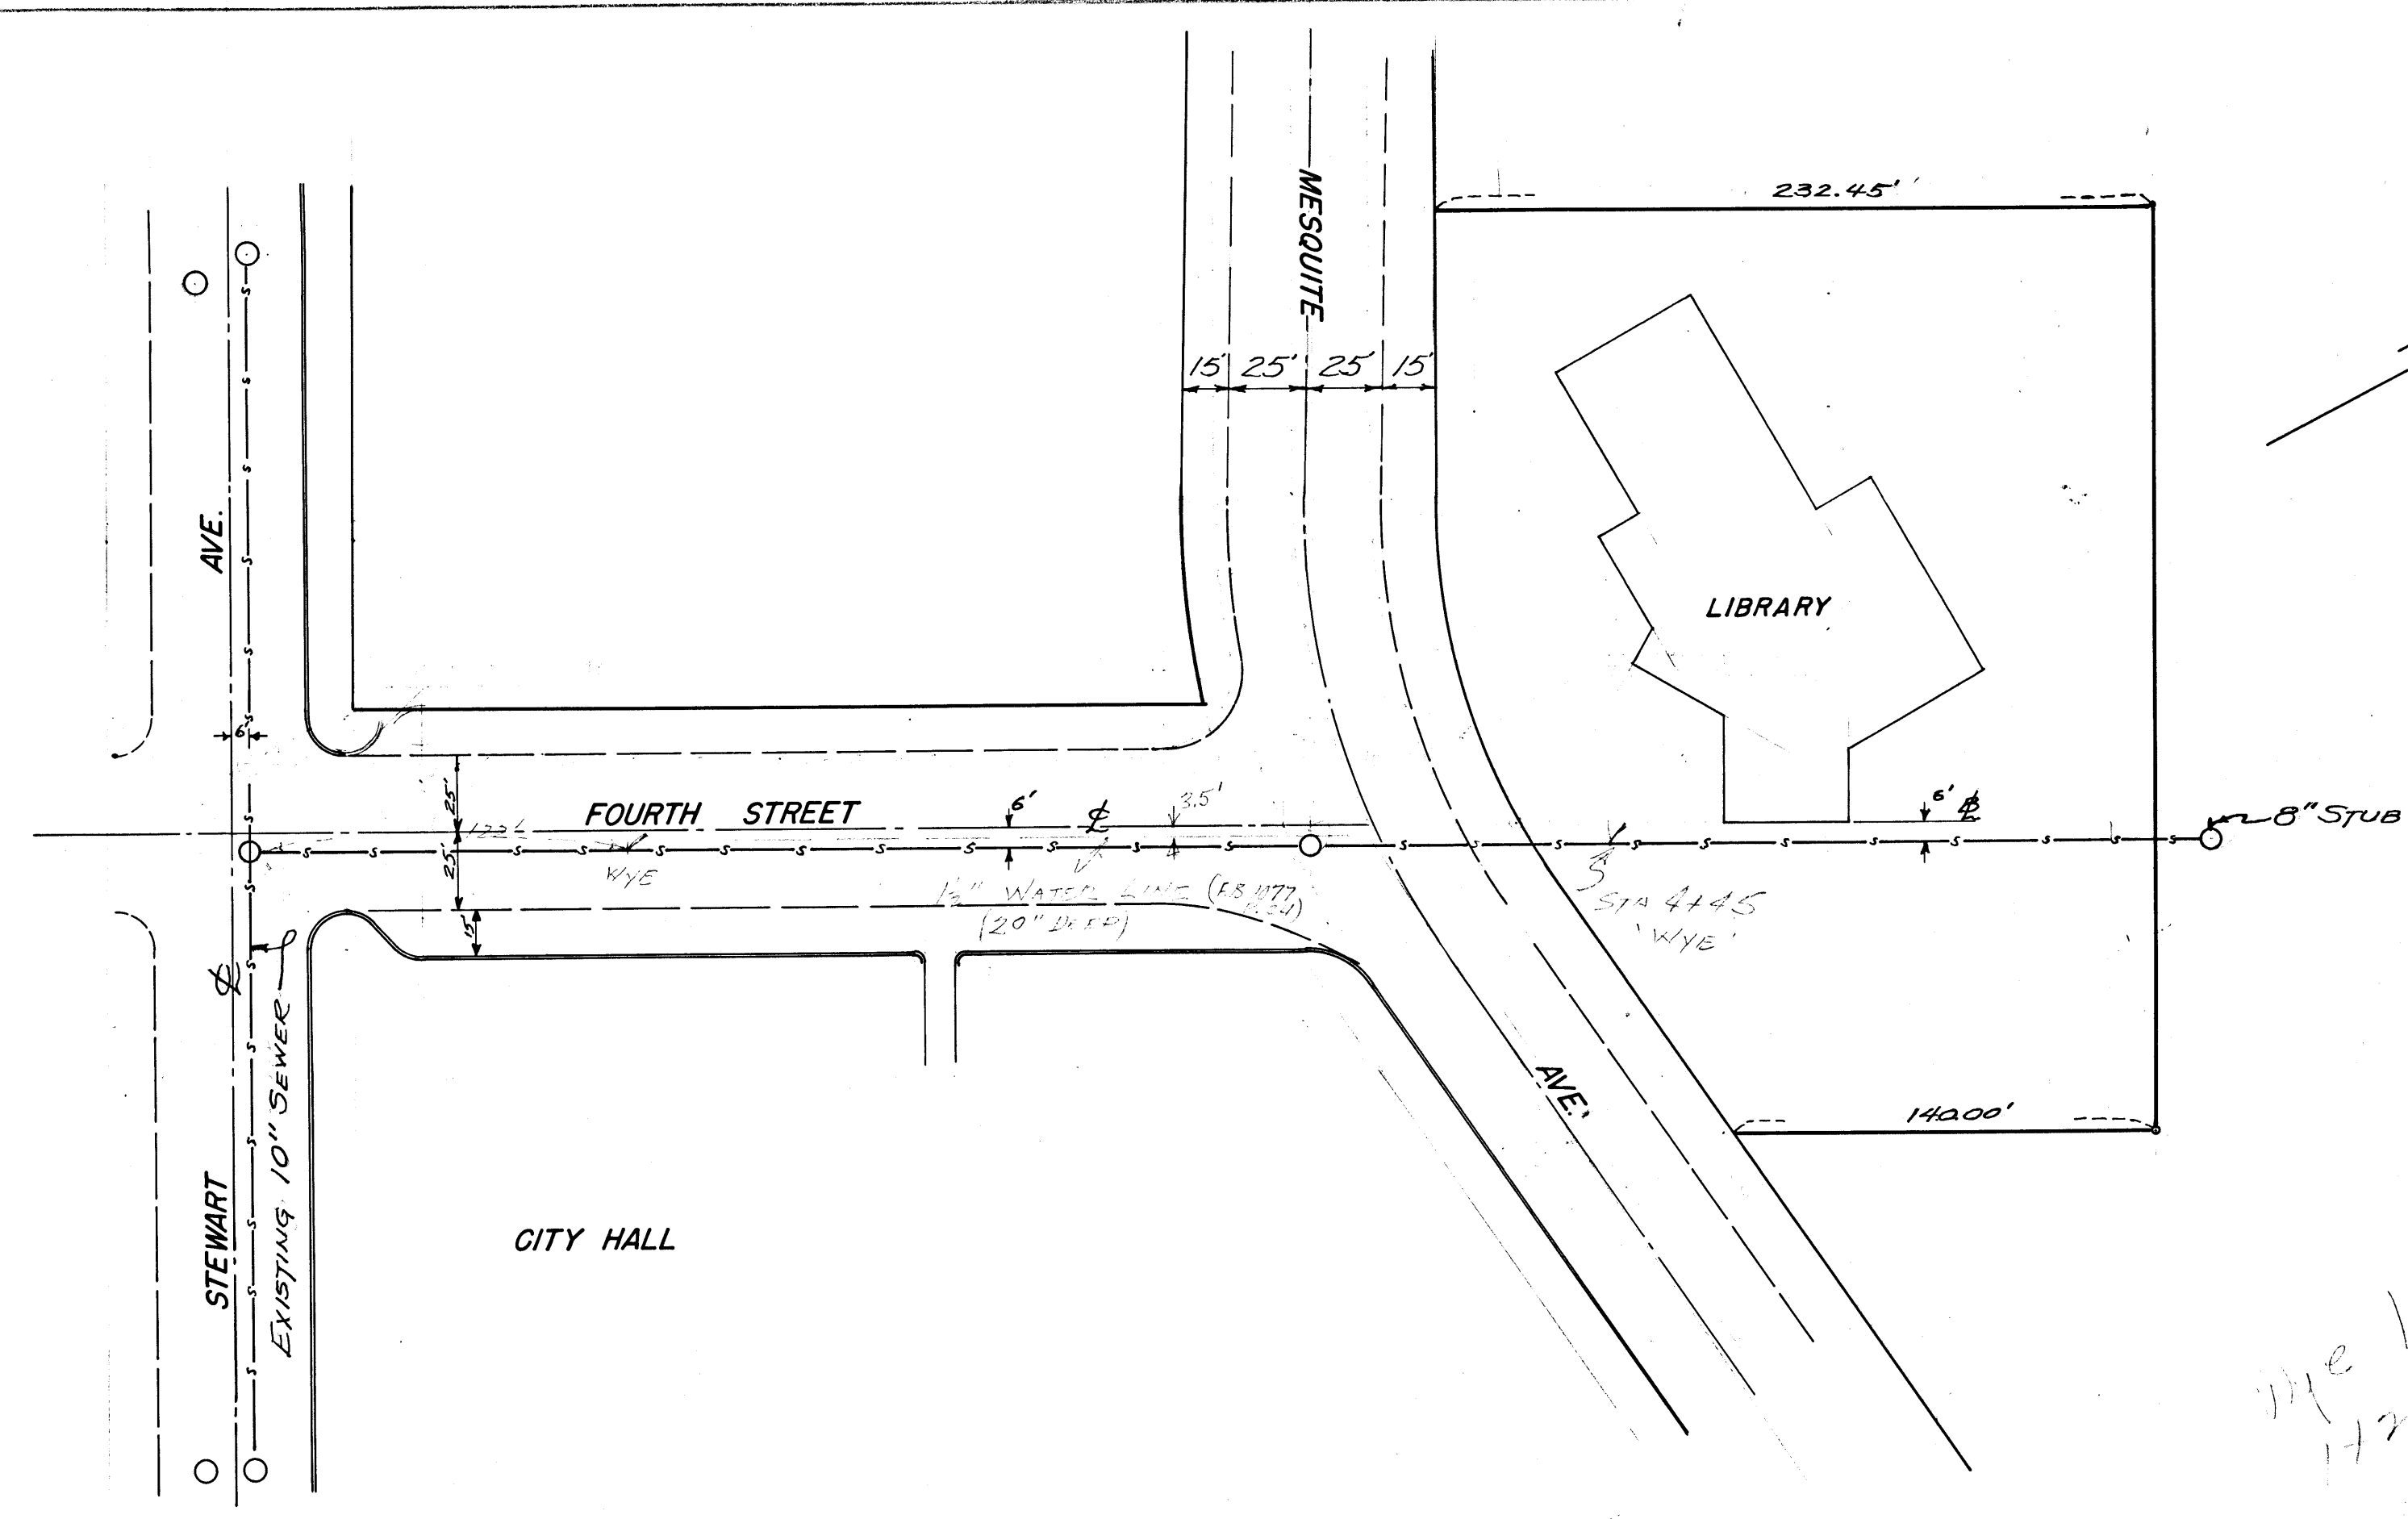

*the location STA  
1+28 & 2+45*

T.B. 1078-073  
**PROPOSED SEWER LINE  
STEWART AVE. TO CITY PARK  
OFFICE OF THE CITY ENGINEER  
LAS VEGAS, NEVADA.**  
B. M. Top Jones F.P.  
S. W. Cor. Alley bet. 5th & 6th Sts.  
on Linden Ave. Elev. 2002.98

0+00      1      2      3      4      5+00      6      7

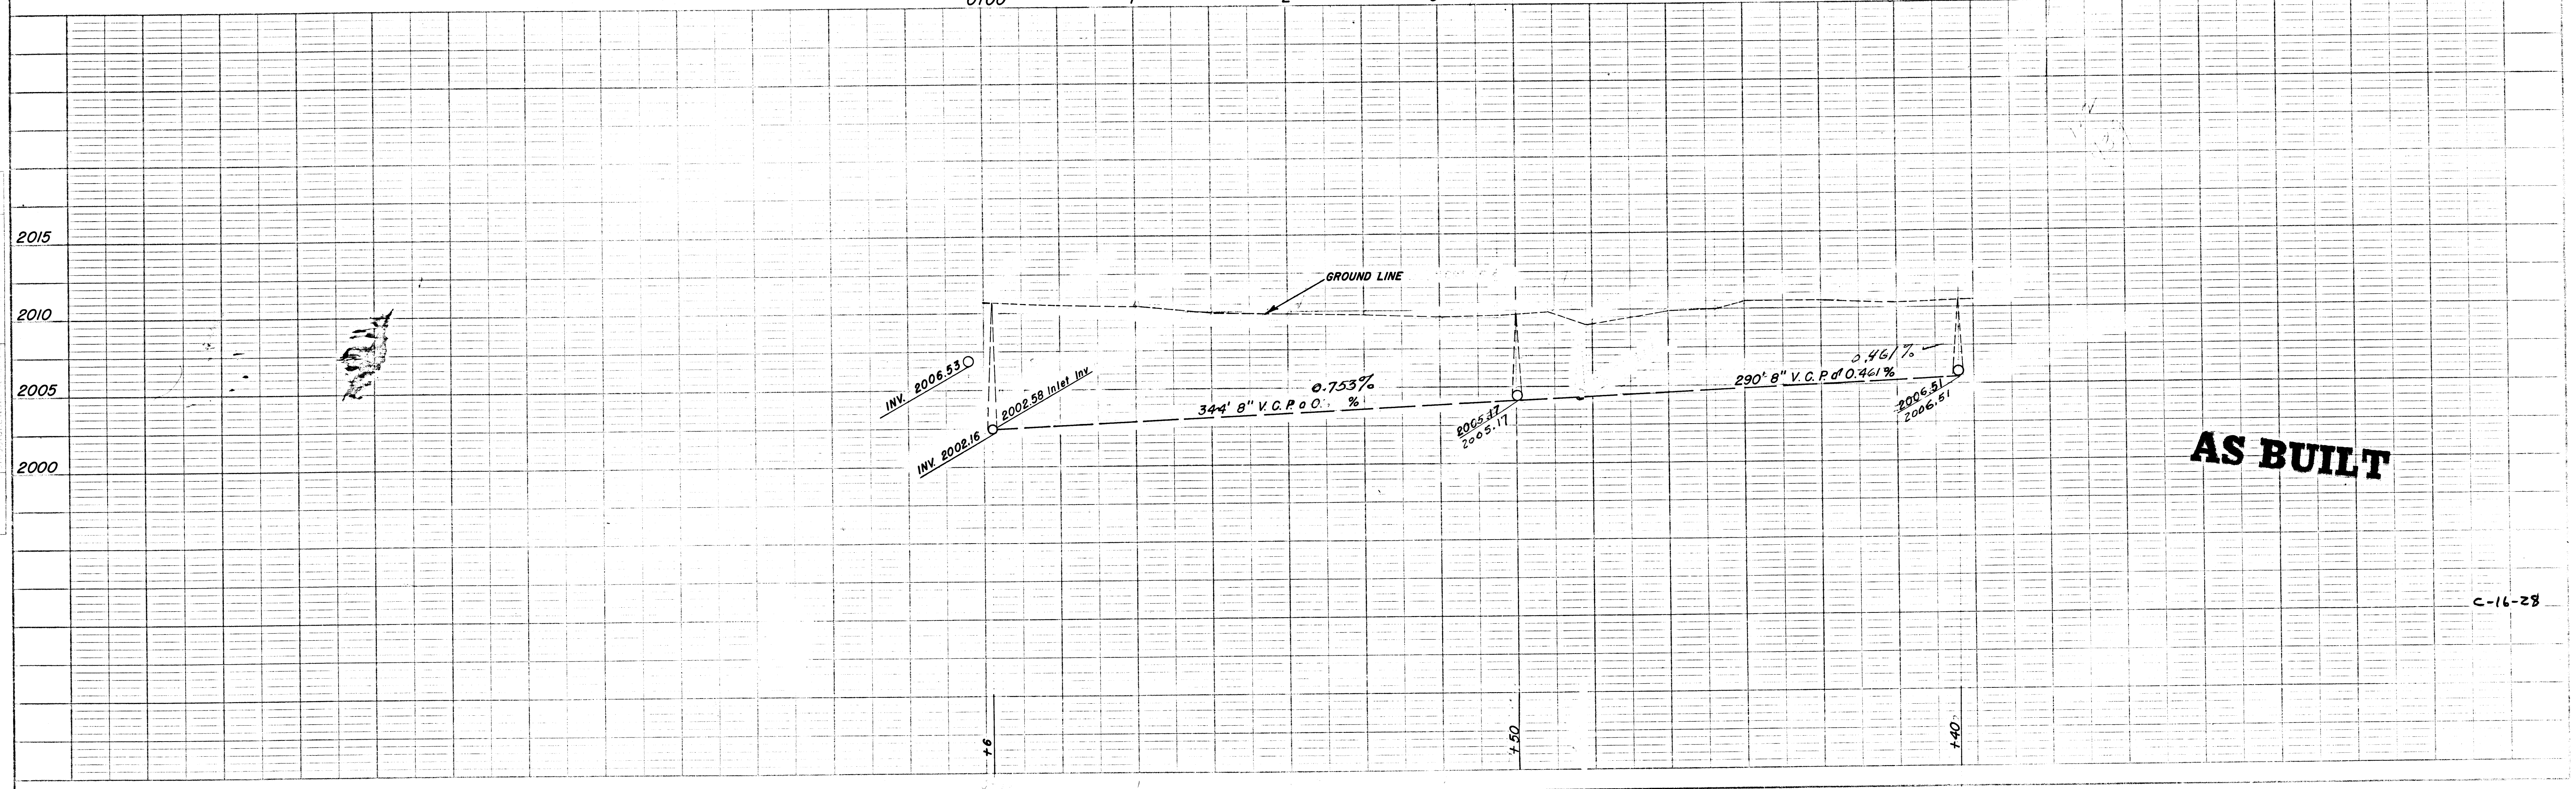

PLAN  
NOTE BOOK / ELEMENT CHECKED  
NO.

PROFILE  
NOTE BOOK / GRADES CHECKED  
NO.

*1201  
7-26  
5870  
601  
300  
15055  
11-2-10*