


PLAN	SURVEYED	DATE
	NOTE BOOK	BY
NO	ALIGNMENT CHECKED	
	RT OF WAY CHECKED	

PROFILE	SURVEYED	DATE
	NOTE BOOK	BY
NO	STRUCTURE NOTATION CHECKED	
	STRUCTURE NOTATION CHECKED	

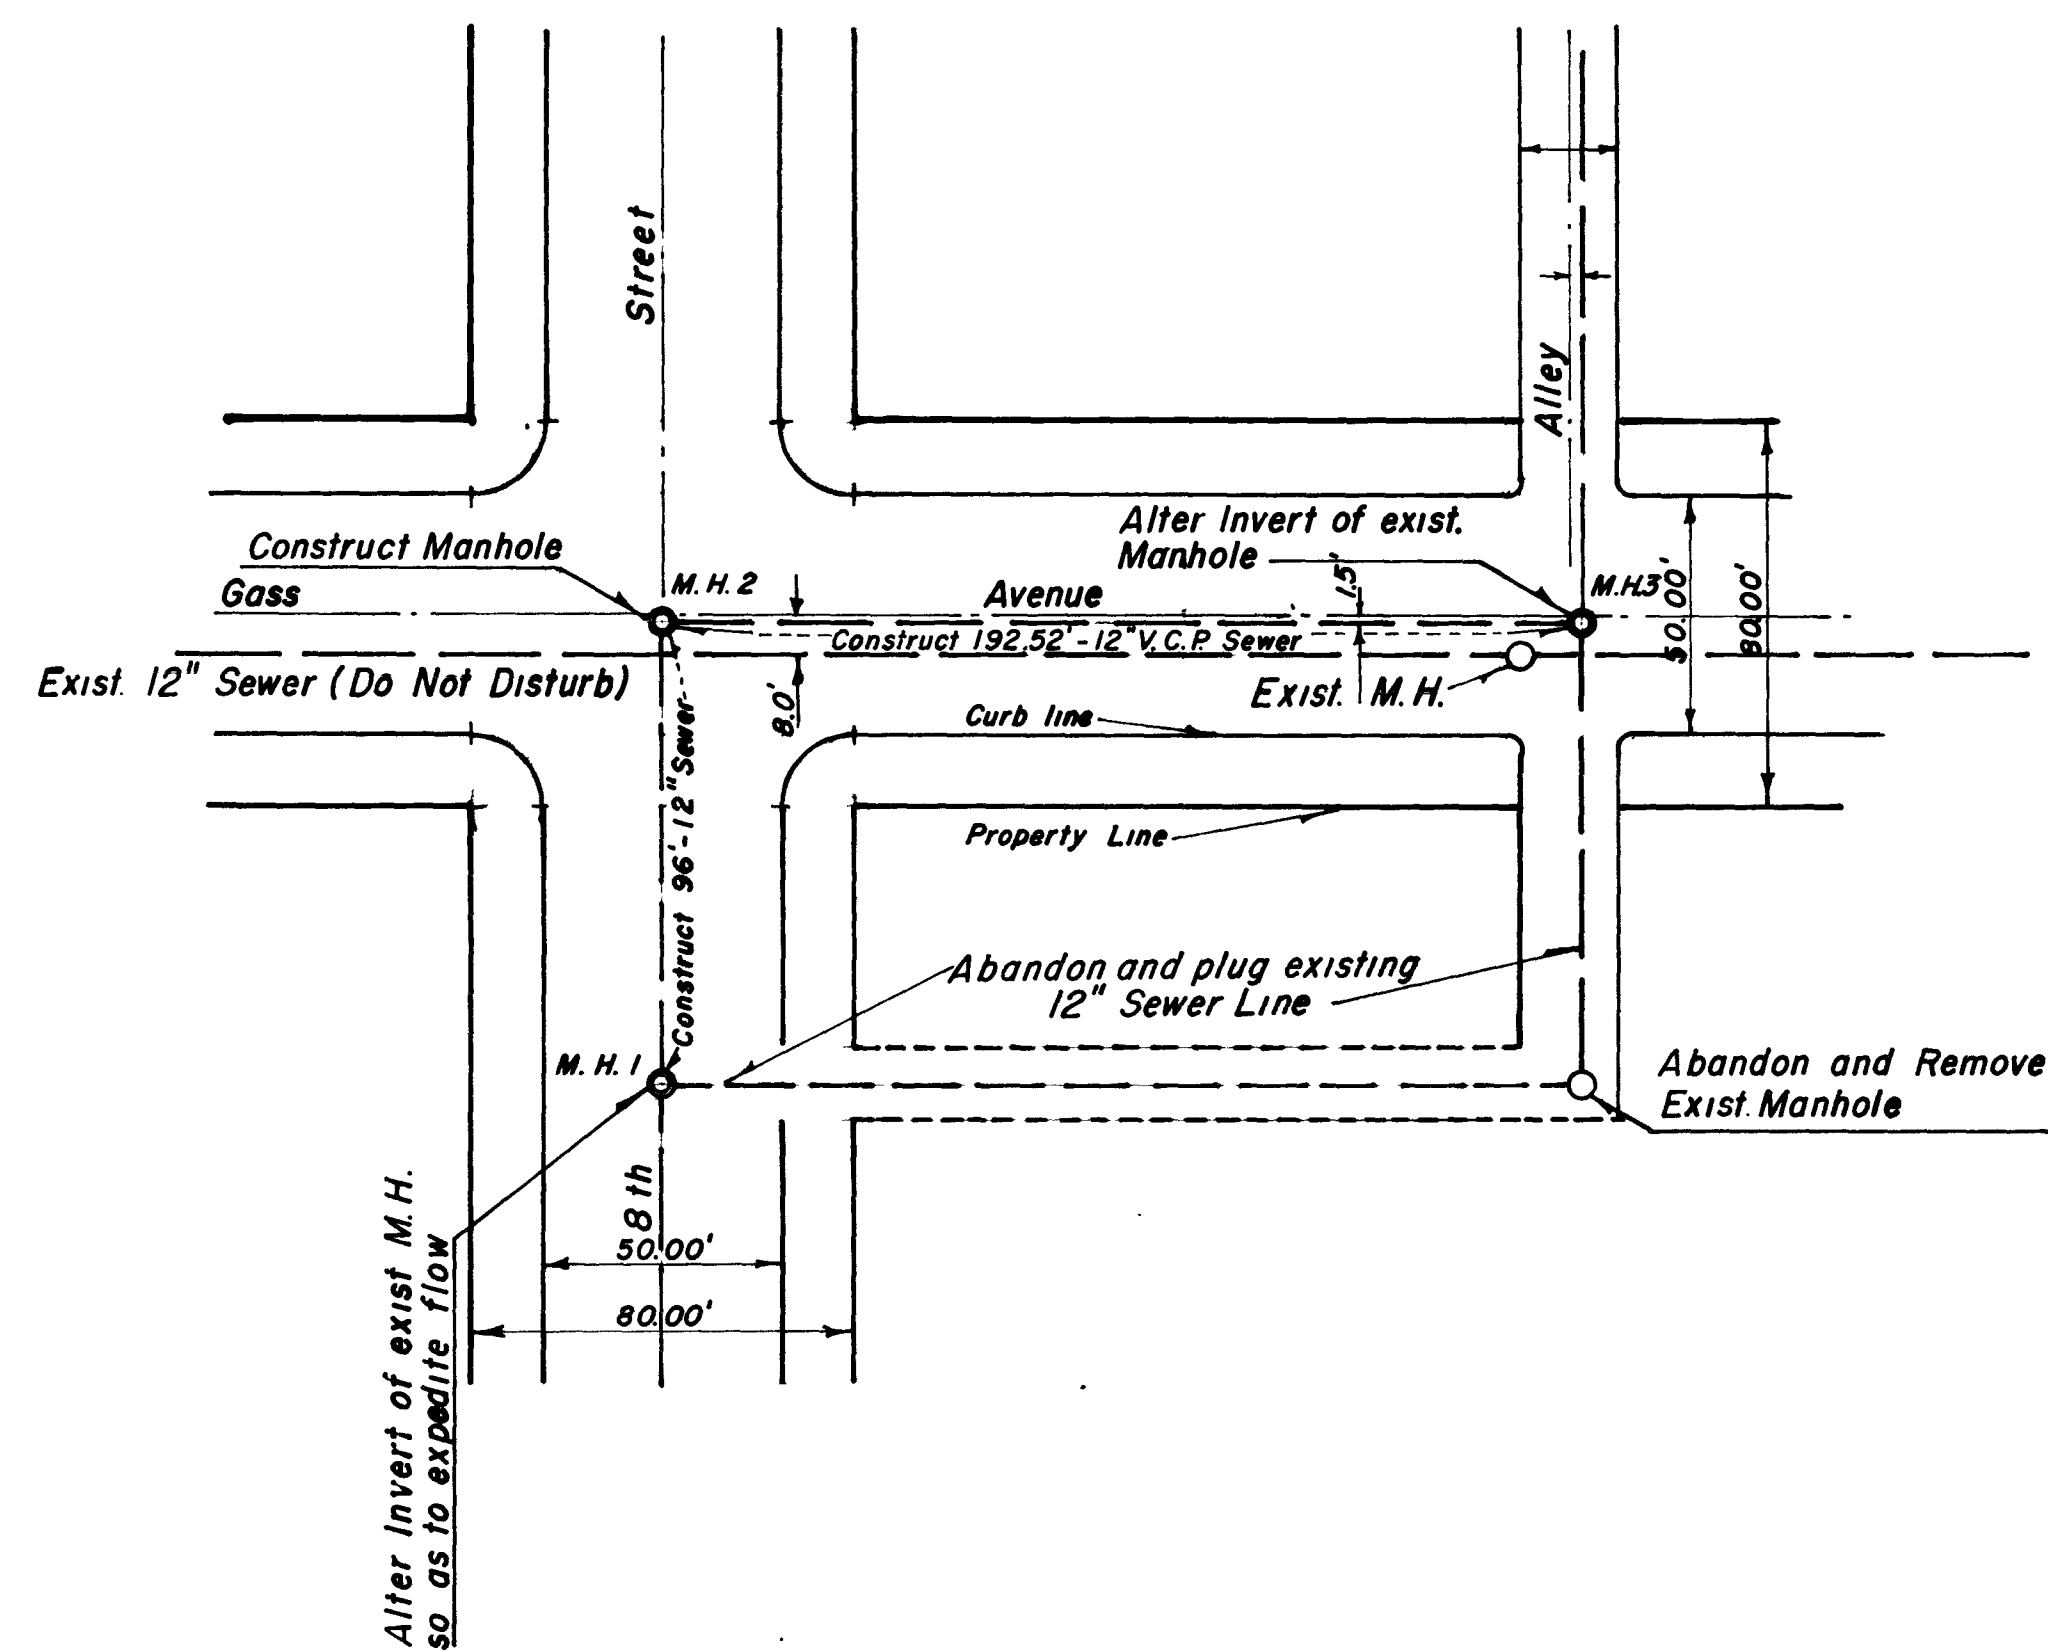

Horizontal Scale 1" = 40'
Vertical Scale 1" = 5'

Bench Mark = Copper Plate
NW Cor. 8th St. & Gass Ave.
Elevation = 2006.33

NOTE:
All Construction shall conform to
City of Las Vegas Standard Drawings and
Specifications.

SEWER RELOCATION

8th Street & Gass Ave.

R. A. Anton 8-23-61
APPROVAL SANITATION ENGINEER

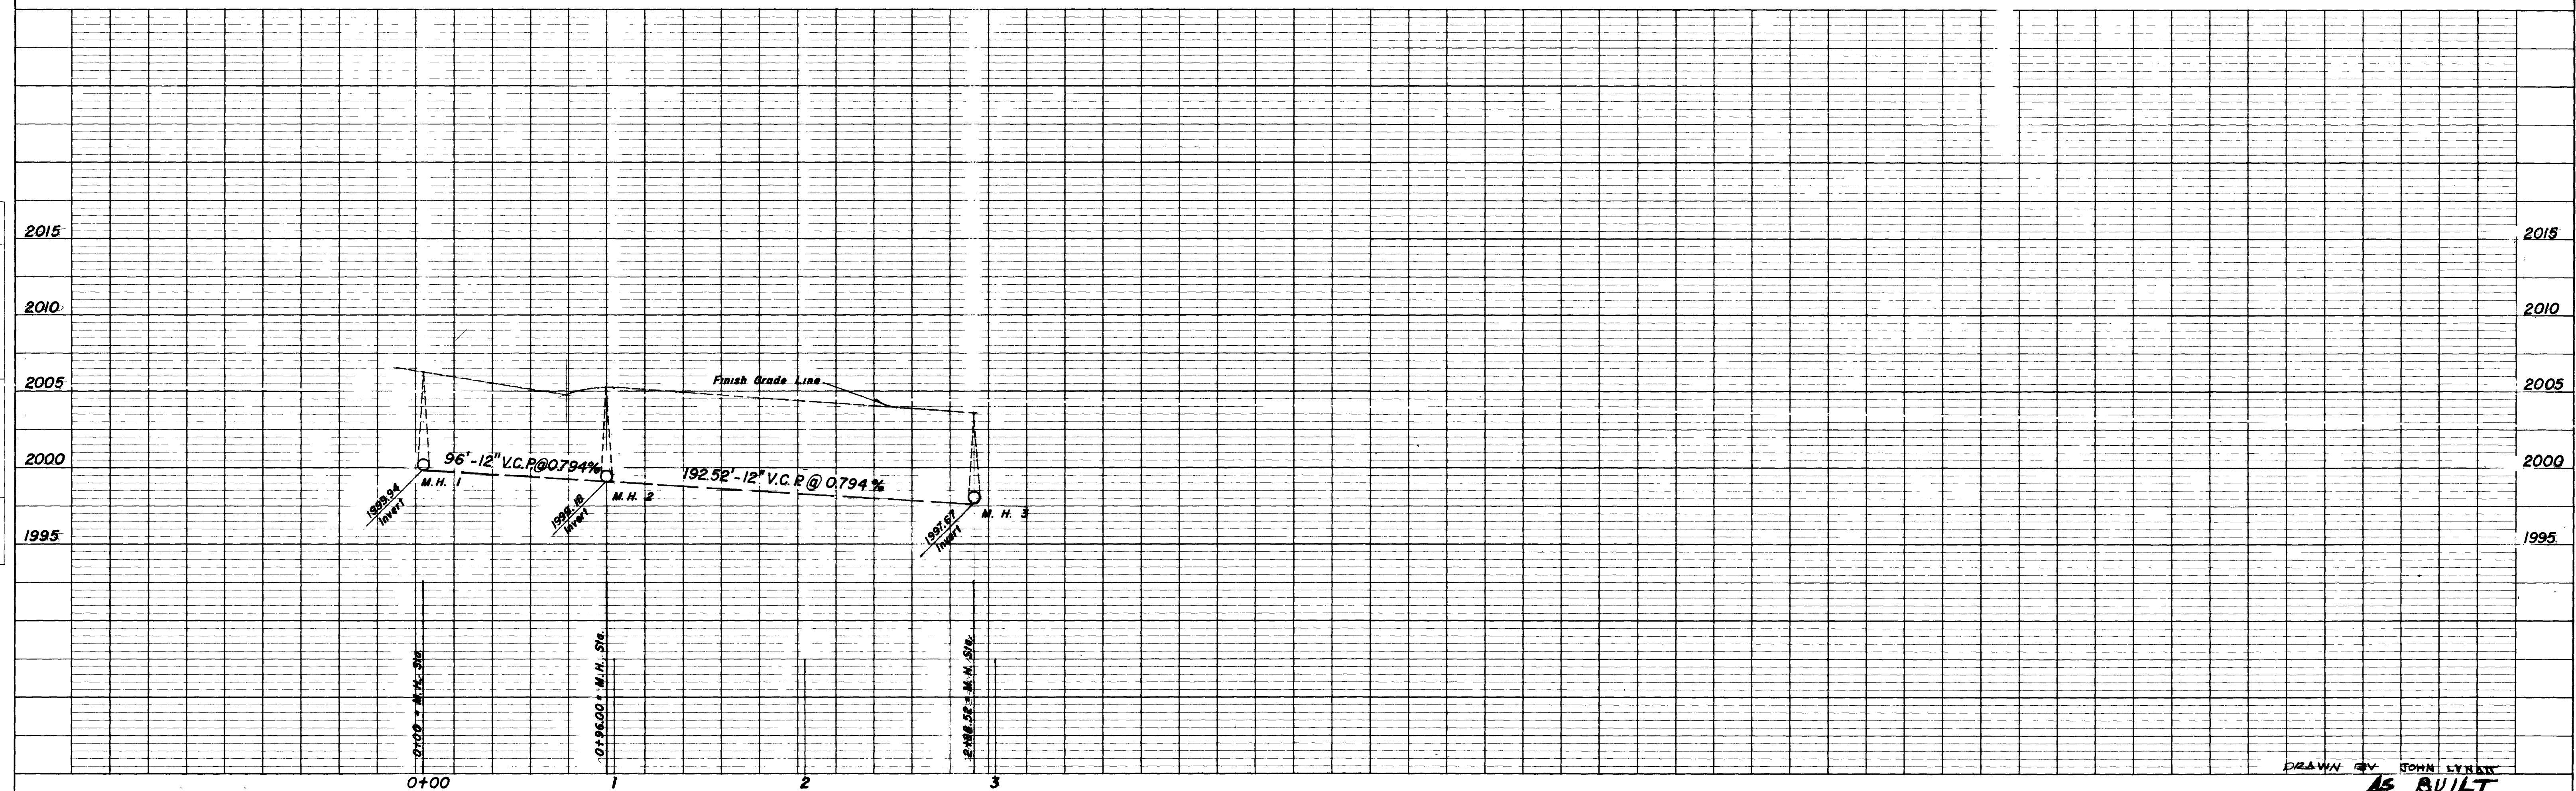


PLATE 1 - PLAN PROFILE
ELICO VEL TRACING PAPER
B. K. ELLIOTT CO. PITTSBURGH, CLEVELAND, DETROIT

DRAWN BY JOHN LYNN
AS BUILT

151-22
301-V 281

