
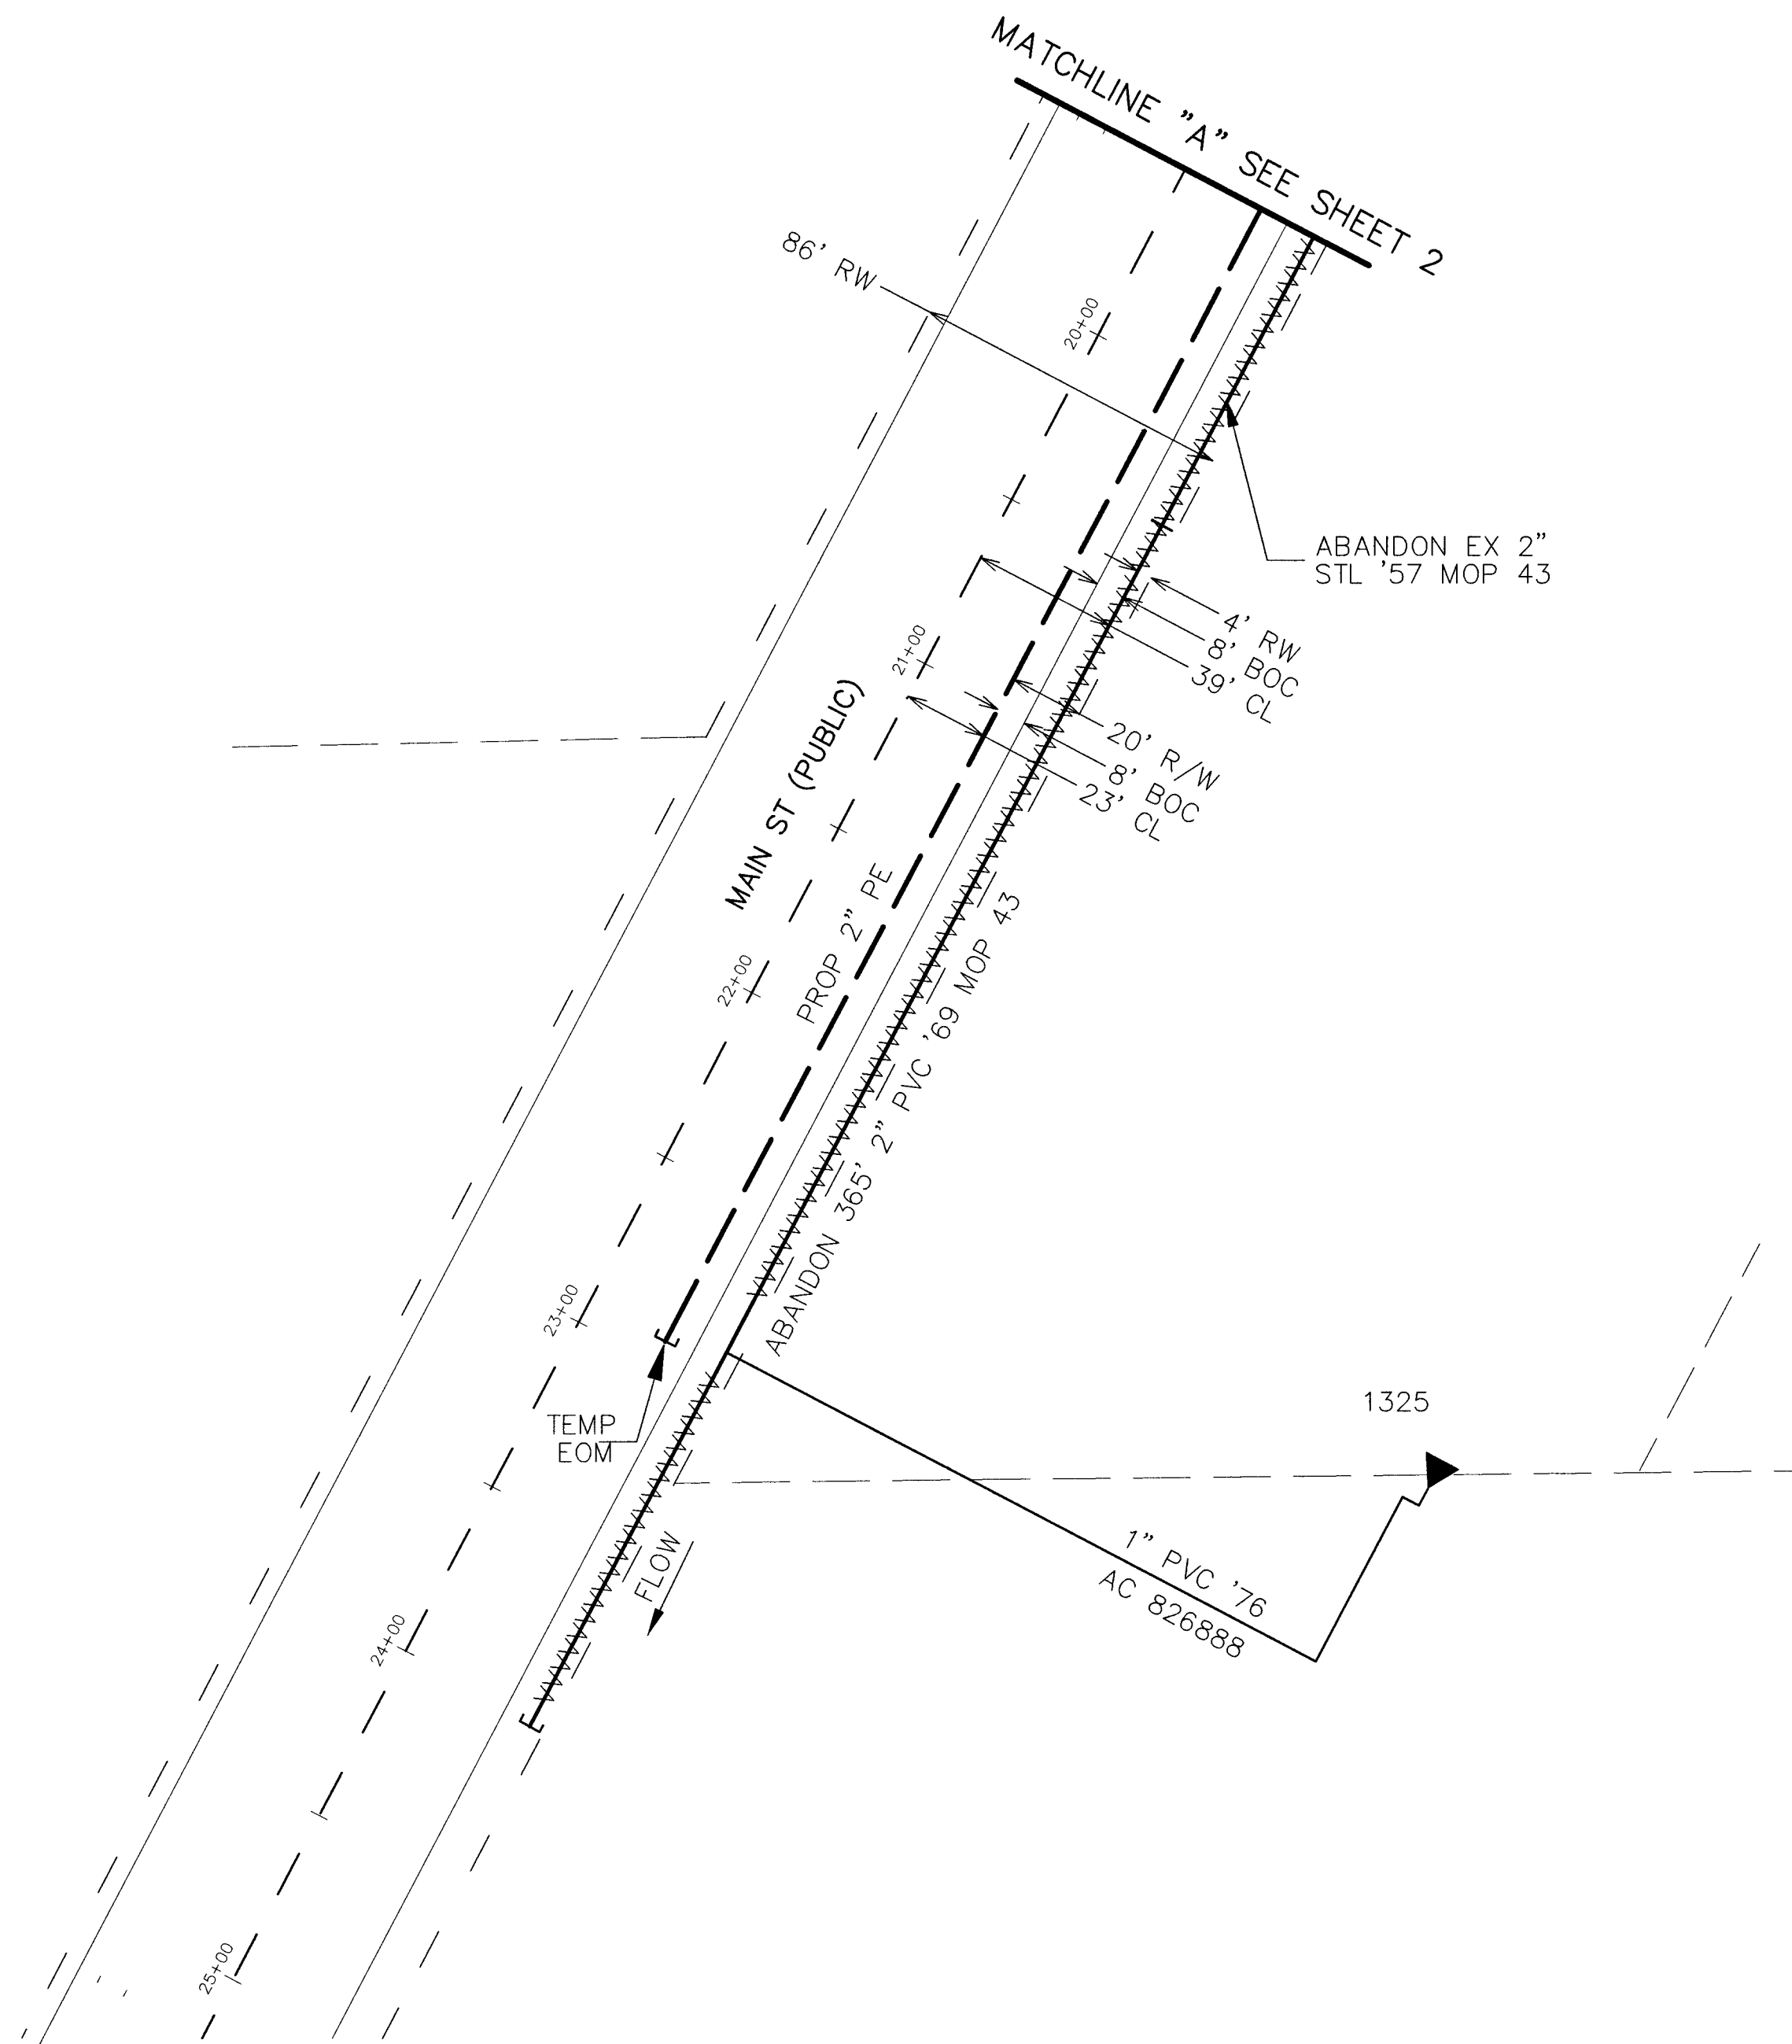


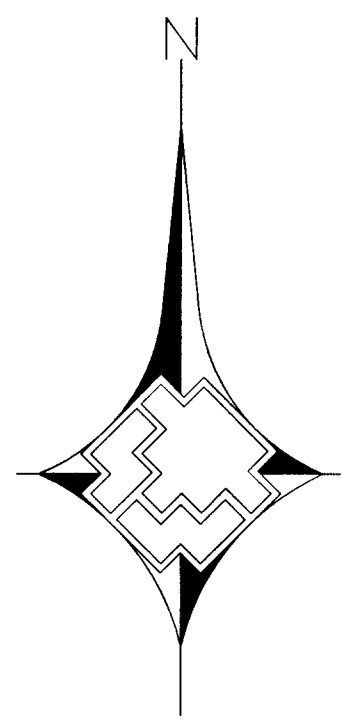

Call
before you
Dig.

1-800-227-2600
UNDERGROUND SERVICE (USA)
(48 HR. BEFORE IF POSSIBLE)

CUSTOMERS N/A CYCLE ROUTE AREA 3S LV 16

NO	REVISIONS	DESCRIPTION	BY	DATE	APPVD
1	REVISED MAIN PLACEMENT DUE TO SEWER CONFLICT		SP	6/24/08	

102035

 Southwest Gas Corporation

SEE SHEET 2									
UNIT NO	UNIT TYPE	INSTL	RET	INSTL	RET	COMPLETED			

SYSTEM <u>D_VALLEY_WIDE</u> DR NO <u>260-1-DR</u>	
SEGMENT M A O P <u>N/A</u> SYSTEM M A O P <u>43#</u>	
SYSTEM M O P <u>43#</u>	
AS-BUILT DRAWING-PRESSURE TEST DATA	
PIPE DIA _____	TEST MEDIUM ☐ AIR ☐ GAUGE
PIPE LENGTH _____	☐ NITROGEN ☐ CHART
PIPE TYPE _____	☐ WATER ☐ SOAP
MIN DURATION _____	GAUGE / PRESS REC SN# _____
TEST PRES (PSIG) _____	START _____ END _____
TIME _____	DATE _____
PERFORMED BY _____	
I REVIEWED THE PROCEDURES PERFORMED AND FOUND THEM:	
ADEQUATE() INADEQUATE()**	
**INADEQUATE COMMENTS _____	
SIGNATURE _____ DATE _____	
SIGNATURE _____ DATE _____	
VISUAL INSPECTION CERTIFICATION	
I HAVE VISUALLY INSPECTED ALL HEATED FUSIONS, SOLVENT CEMENT, MECHANICAL JOINTS, AND WELDS THAT I HAVE PERFORMED	
NAME _____ DATE _____	
AS-BUILTS ACCEPTED BY _____ DATE _____	
POSTED BY _____ DATE _____	
POSTING QC'D BY _____ DATE _____	

CONSTRUCTION	
INSPECTOR _____	
FOREMAN _____	
REVIEWED BY _____	
PERMIT INFORMATION	
Tax Code Area-02-0200 CITY OF LAS VEGAS	
ISOLATION AREA	W R NO
67	793268
LOCATION	TILE NO
T20S,R61E S27	x630y522

ACCOUNT REP	PHONE
PROJECT CONTACT SONAL PATNI	702-365-2108
SHEET NO 3 OF 3	SCALE 1" = 40'
DWN BY CME	CHKD BY BLA
DATE 02/04/08	APPVD BY
TITLE	
SI-CLV-FOREMASTER LN REPLACEMENT MAIN ST & FOREMASTER	

2-7737 SI-CLV-FOREMASTER LN REPLACEMENT JUN 26 2008