


TRENCH DETAIL
FOR IMPROVED AREAS ONLY
CLV

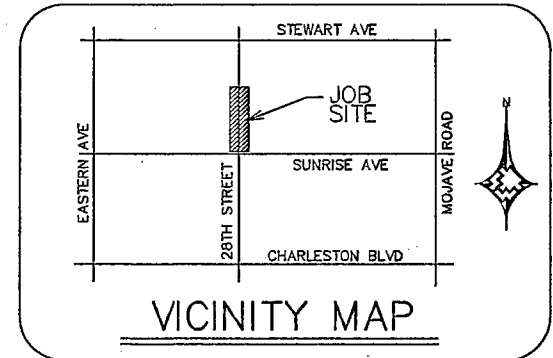

LEGEND:

---	EXISTING GAS LINE
---	PROPOSED MAIN GAS LINE
---	PROPOSED SERVICE GAS LINE
---	BOUNDARY LINE
---	RIGHT OF WAY LINE
---	STREET CENTERLINE
---	BACK OF CURB / LOT LINE
---	EX. BACK OF CURB / LOT LINE
S	SEWER LINE
W	WATER LINE
FD	FIRE HYDRANT
SD	STORM DRAIN LINE

- CONSTRUCTION NOTES:**
- SUGGESTED GAS LOCATIONS ARE TO CLEAR SUBSTRUCTURES. LOCATE IN FIELD.
 - ALL PIPELINE CONSTRUCTION SHALL CONFORM TO APPLICABLE JURISDICTION SPECIFICATIONS.
 - DO NOT SCALE THIS DRAWING.
 - GAS MAINS SHALL BE PURGED PER THE OPERATIONS MANUAL TEES, UNLESS OTHERWISE STATED.
 - ALL MAIN TIE-INS REQUIRING TEES ARE TO BE FULL FLOW TEES, UNLESS OTHERWISE STATED.
 - 28th ST IS PAVED, COMPLY WITH RTC STDS. 500BT & 504. SUNRISE AVE IS PAVED, COMPLY WITH RTC STDS. 500BL2 & 504.
 - CONTACT ENGINEERING FOR BY-PASS INFORMATION.

PURGE NOTE:

PURGE PLAN WAS COMPLETED IN ACCORDANCE WITH THE OPERATIONS MANUAL GUIDELINES BY:

Name _____ Date _____

REVISED

NOTE:
THERE IS 450' OF 2" PE IN THE CITY OF LAS VEGAS R/W.

APPROVED FOR CONSTRUCTION

THIS APPROVAL IS FOR WORK IN CLV R/W OR CLV EASEMENTS ONLY. OBTAINING PERMISSIONS OR EASEMENTS FOR WORK SHOWN ON PRIVATE PROPERTY IS THE RESPONSIBILITY OF THE UTILITY.

Approved on 12/3/2008

APPROVAL _____ DATE _____



SYSTEM D_VALLEY_WIDE

DR. NO. 395-1-DR SYSTEM M.A.O.P. 43#

SEGMENT M.A.O.P. N/A SYSTEM M.O.P. 43#

I REVIEWED THE PROCEDURES PERFORMED AND FOUND THEM ADEQUATE () INADEQUATE ()**

**INADEQUATE COMMENTS:

SIGNATURE: _____ DATE: _____

SIGNATURE: _____ DATE: _____

NO.	DESCRIPTION	BY	DATE	APPV.
1	MOVED PROP. GAS TO STREET, CHANGED TO 2"	OM	01/27/09	blm/af
2	ADDED DRIVEWAY	OM	10/3/08	blm/af

116333 REVISIONS

Southwest Gas Corporation

UNIT NO.	UNIT TYPE	INS'TL.	REF.	INS'TL.	REF.
		PROPOSED	COMPLETED		
3760202	2" STL		440'±		
3760102	2" PE	450'±	19'±		

AS-BUILT DRAWING-PRESSURE TEST DATA

PIPE DIA. _____ TEST MEDIUM _____ TEST METHOD _____

PIPE LENGTH _____ AIR GAUGE _____

PIPE TYPE _____ NITROGEN CHART _____

MIN. DURATION _____ WATER _____

TEST PRES. (PSIG) _____ START _____ END _____

TIME _____

DATE _____

PERFORMED BY _____

VISUAL INSPECTION CERTIFICATION

I HAVE VISUALLY INSPECTED ALL HEATED FUSIONS, SOLVENT CEMENT, MECHANICAL JOINTS, AND WELDS THAT I HAVE PERFORMED

NAME _____ DATE _____

AS-BUILTS ACCEPTED BY _____ DATE _____

POSTED BY _____ DATE _____

POSTING O'CD BY _____ DATE _____

CONSTRUCTION

INSPECTOR _____

FOREMAN _____

REVIEWED BY _____

PERMIT INFORMATION

Tax Code Area-02-0200

Tax Code Area-02-0207

CITY OF LAS VEGAS

CUSTOMERS _____ CYCLE _____ ROUTE _____ AREA 3S LV 21

ISOLATION AREA 99 W. R. NO. 886994

LOCATION _____ TILE NO. _____

T20S,R61E S36 x639y514

710-002 QB

ENG. TECH. BILL GRENNAN PHONE 365-2173

ACCOUNT REP. N/A PHONE N/A

PROJECT CONTACT OLIVER MONTENEGRO 702-365-2359

SHEET NO. 01 OF 01 SCALE 1" = 30' DATE 08/25/08

DWN. BY BLA CHKD. BY BLA APPV. BY _____

TITLE SI - CLV - VARIETY SCHOOL

SUNRISE AVE & 28TH STREET

107V5155-GAS

FEB 24 2009 3:36:17 SI-CLV-VARIETY SCHOOL-(GAS)