
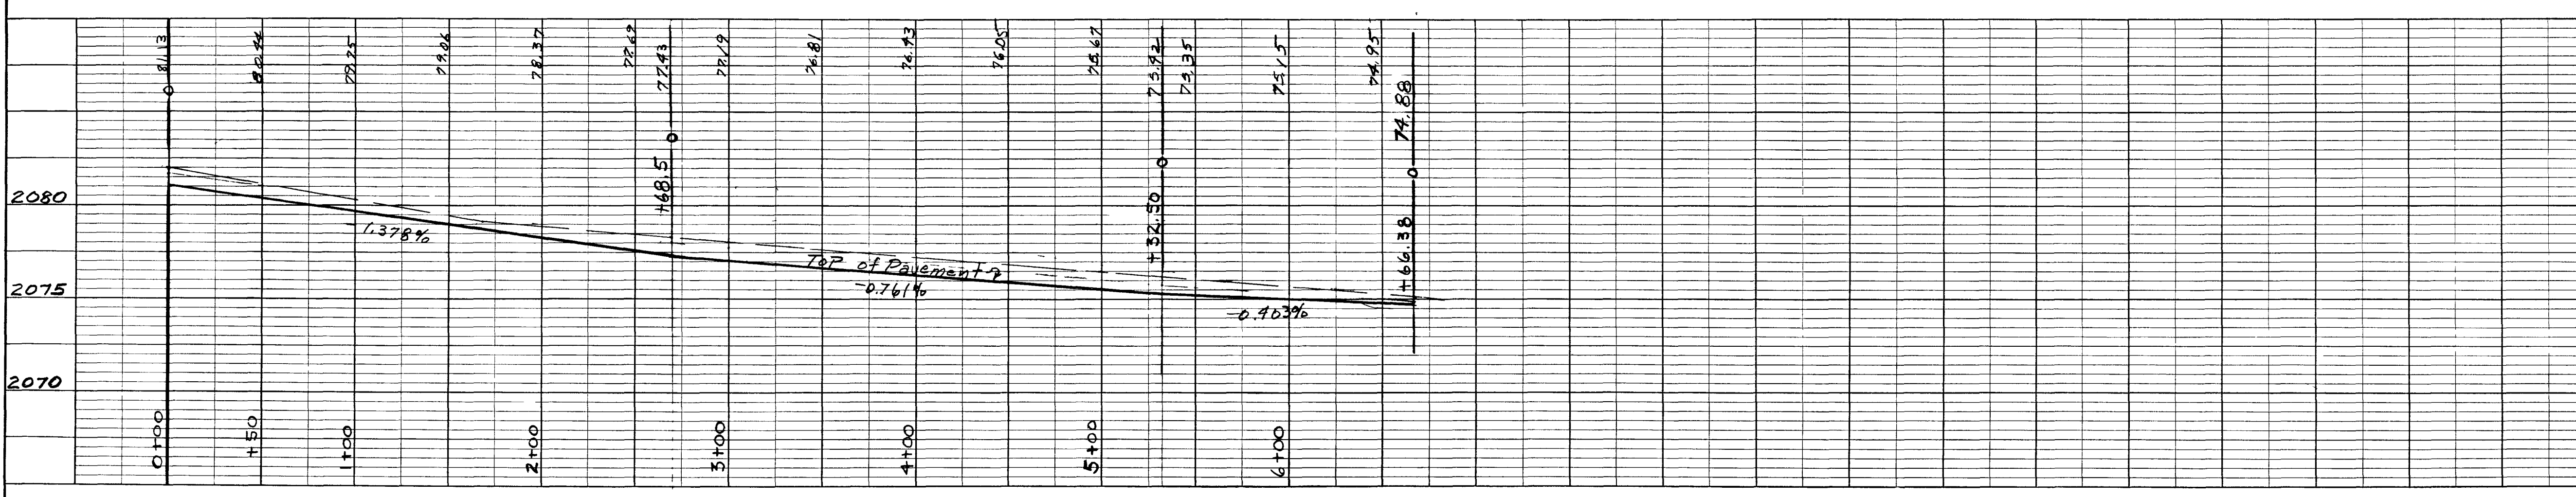
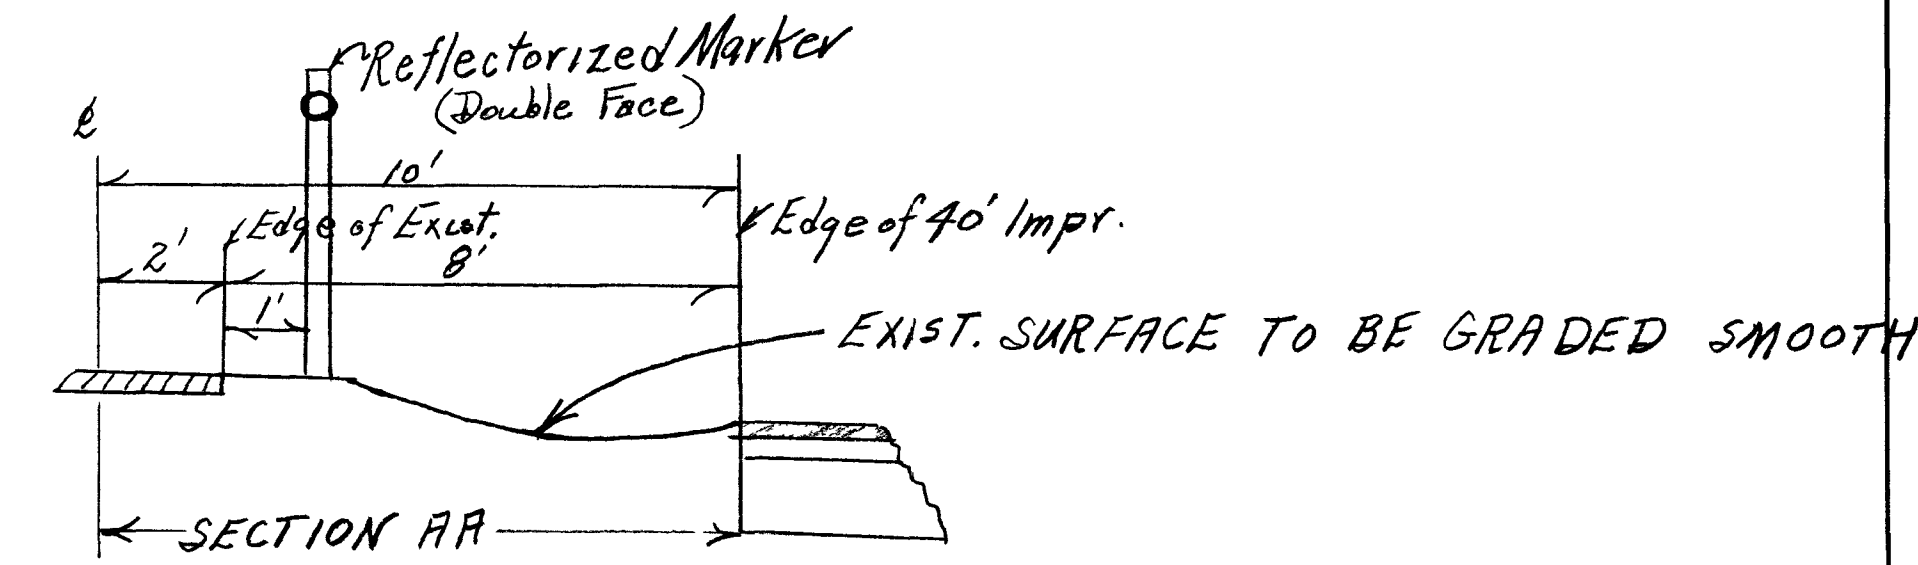
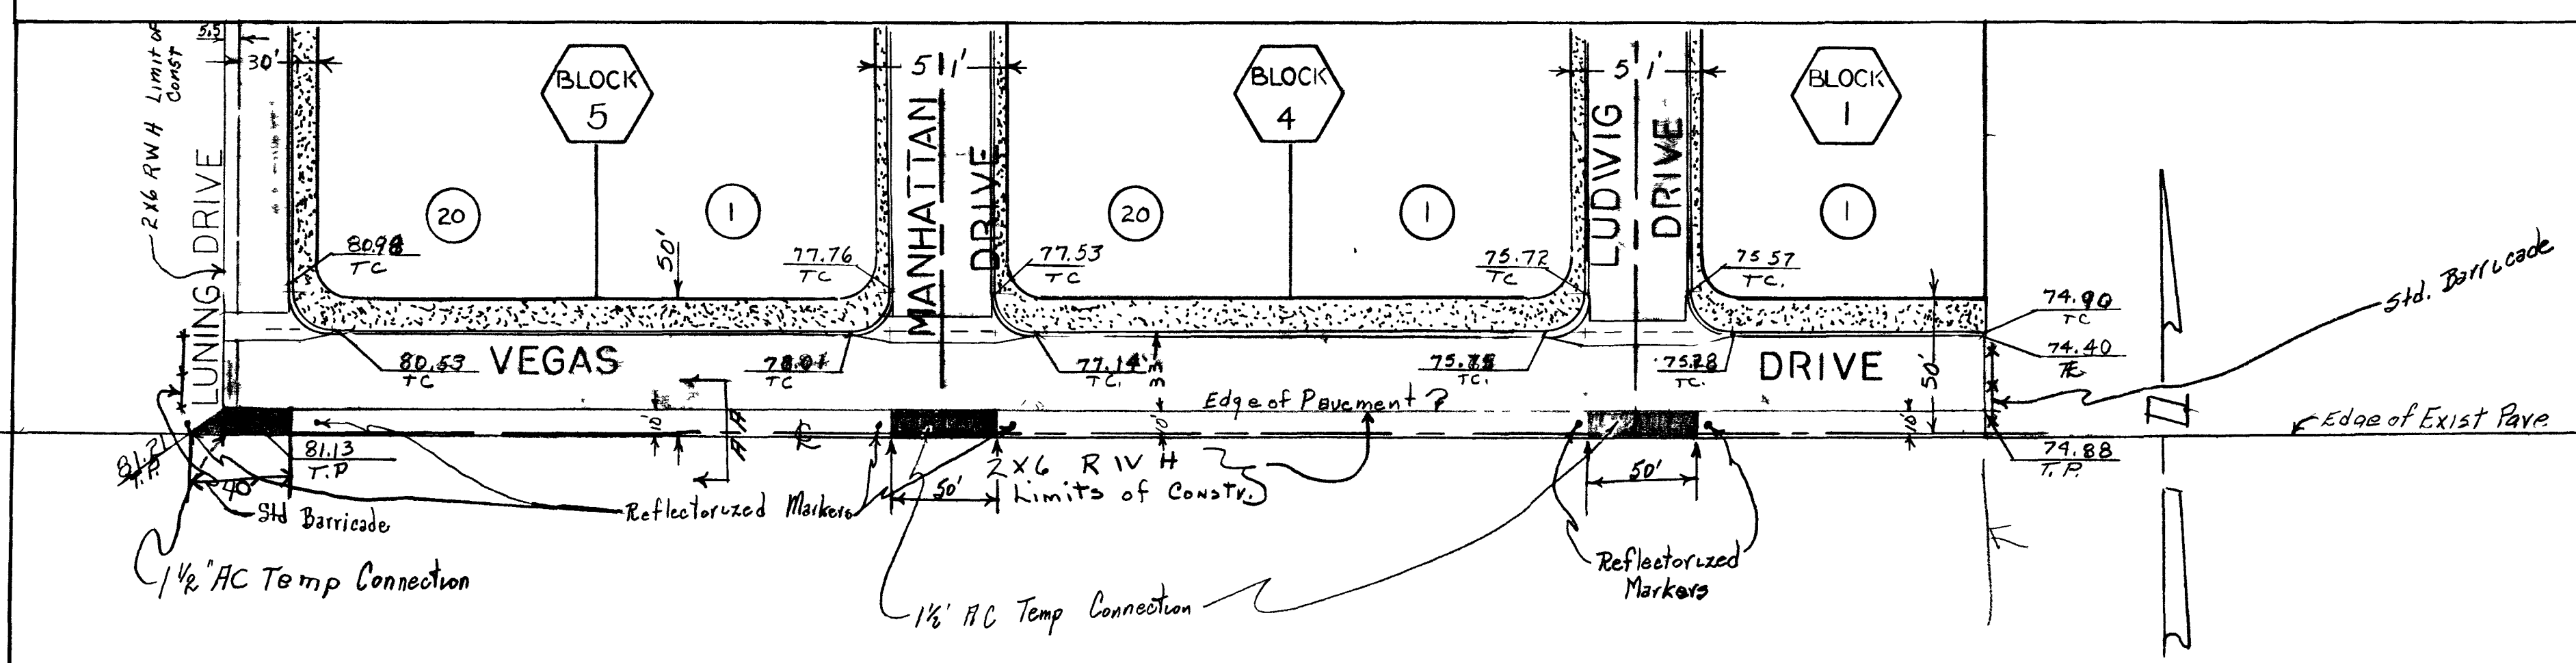
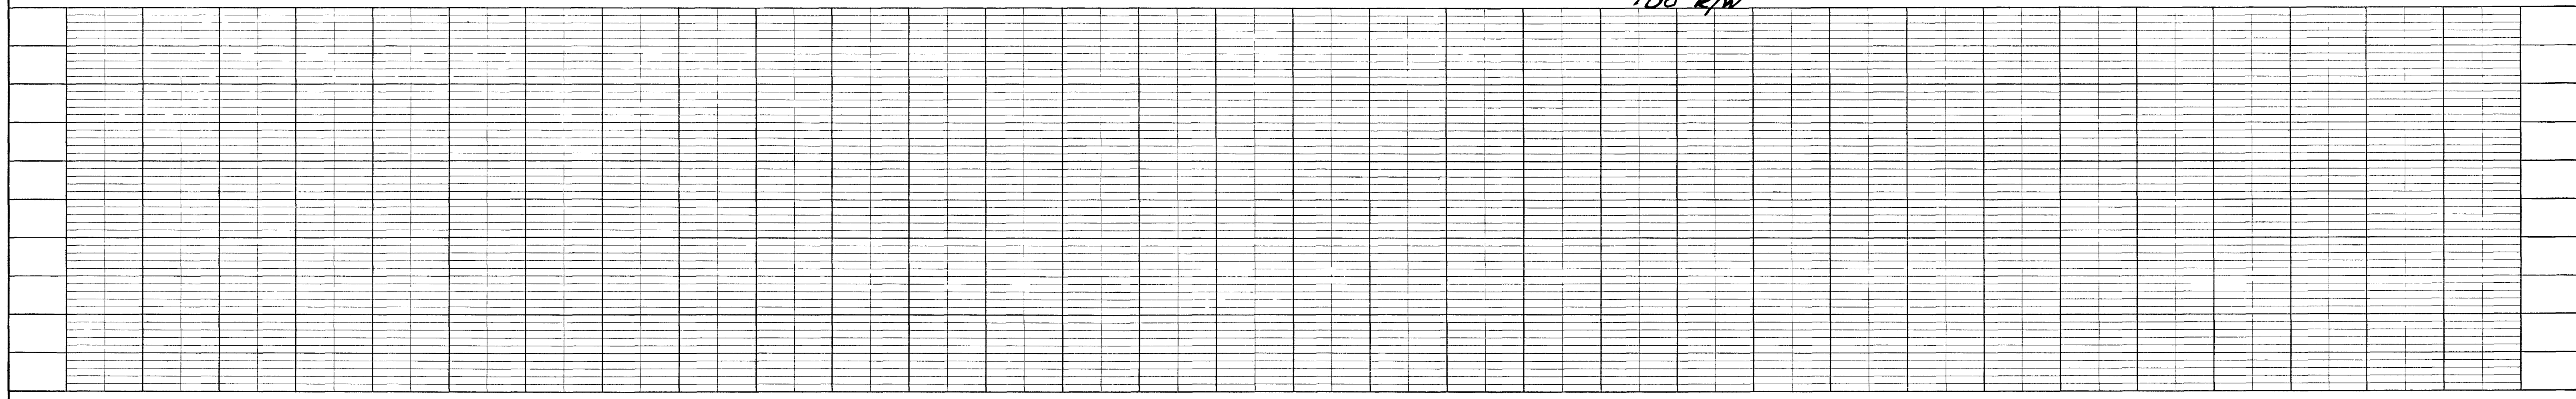


PLAN
 SUBMITTED BY DATE
 PLOTTED BY
 NOTE BOOK NO.
 ALIGNMENT CHECKED BY
 STRUCTURE NOTED NECH 60

PROFILE
 SUBMITTED BY DATE
 PLOTTED BY
 NOTE BOOK NO.
 STRUCTURE NOTED NECH 60

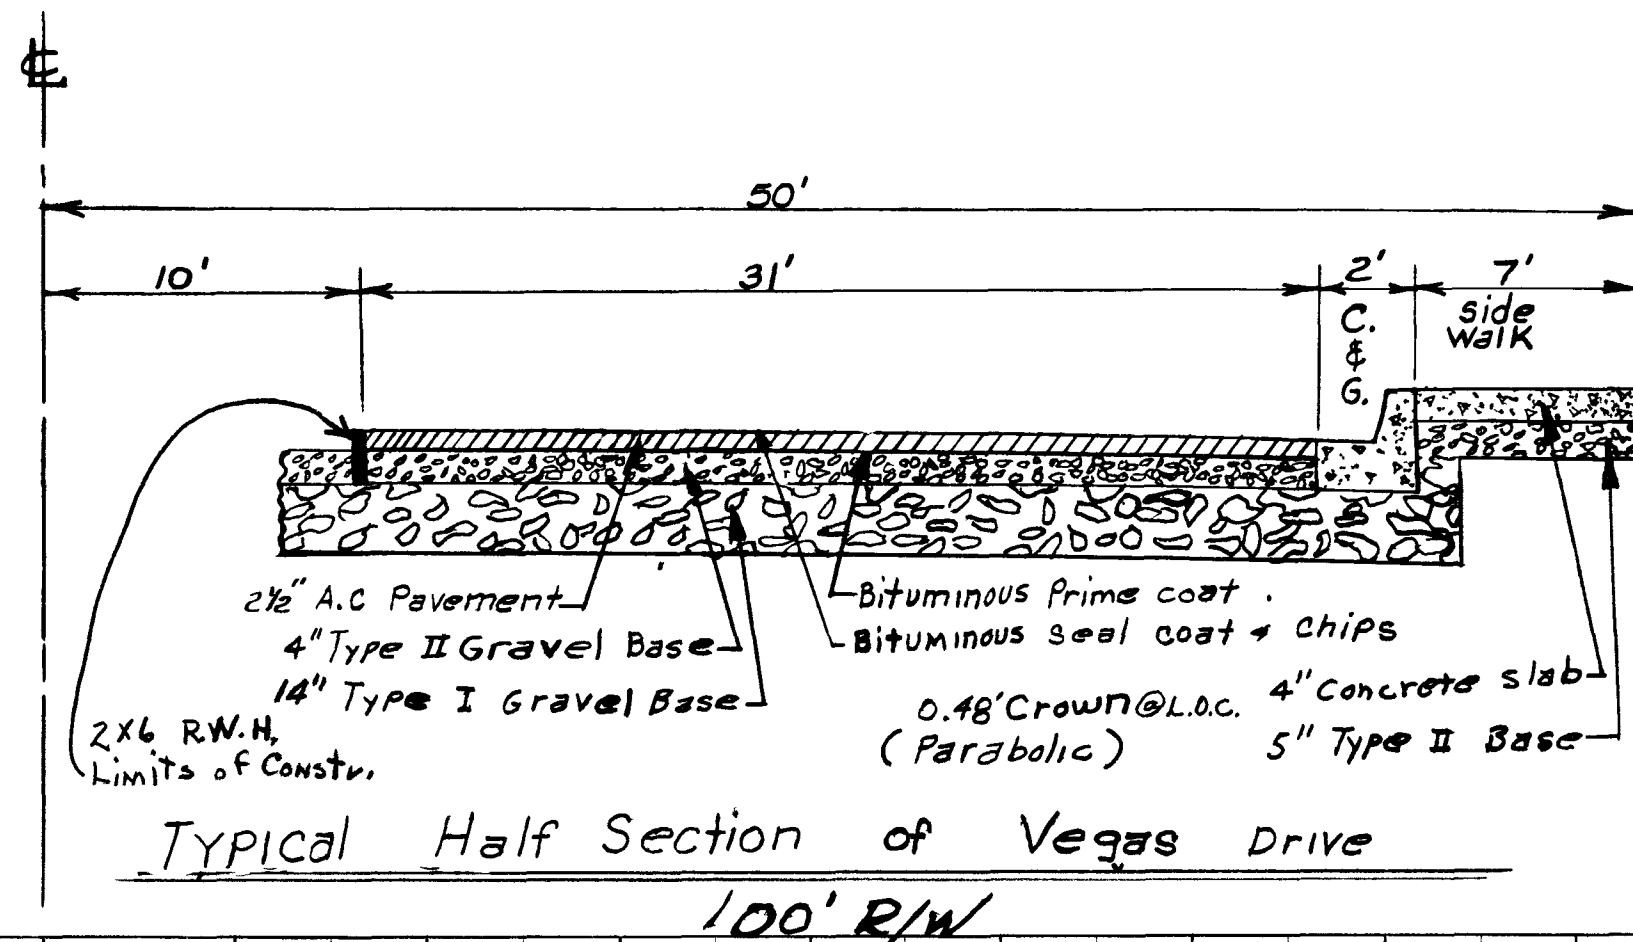

| Revision | Description | Approved |
|----------|----------------------|-------------|
| No. 1 | 1 1/2" AC Temp Trans | [Signature] |

SIERRA NEVADA
 NO. 1
 STREETS
 SHEET 4 OF 6
 FIELD ENG. [Signature]
 CITY ENG. [Signature]
 DES. [Signature]
 SOUTHERN NEVADA ENGINEERING, INC.
 154 WATER ST. HENDERSON, NEVADA

