

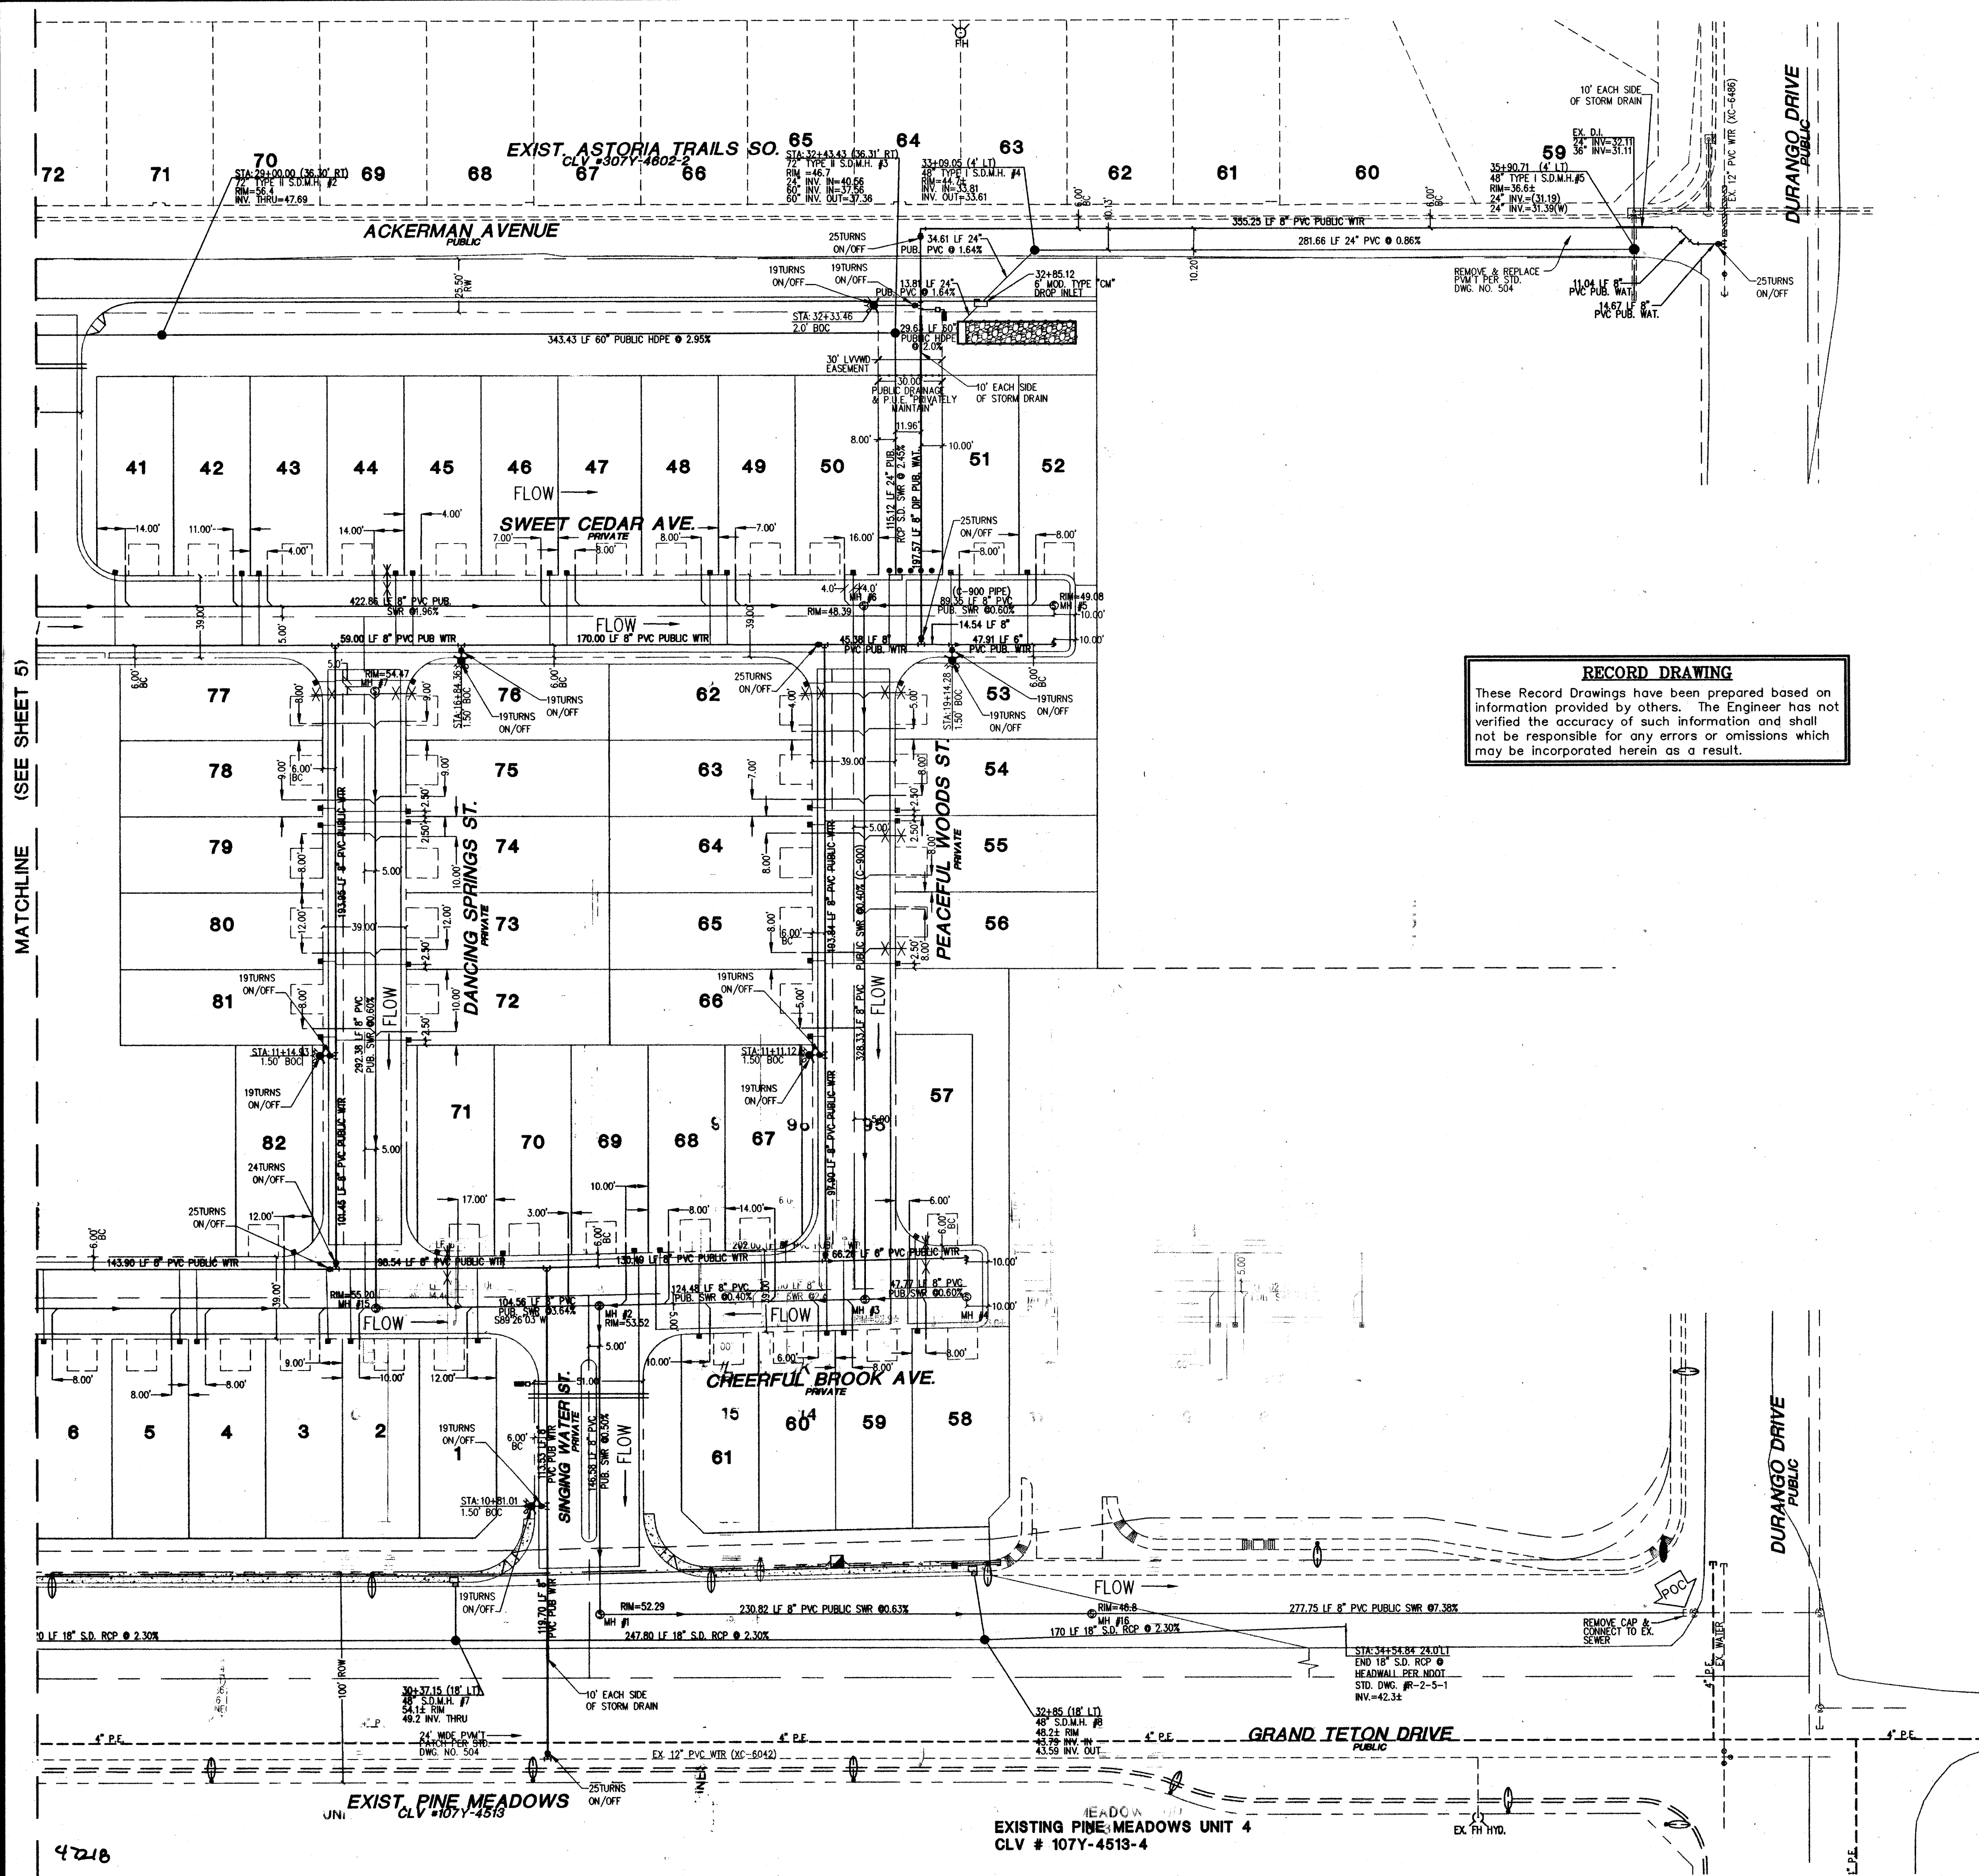


MATCHLINE (SEE SHEET 5)

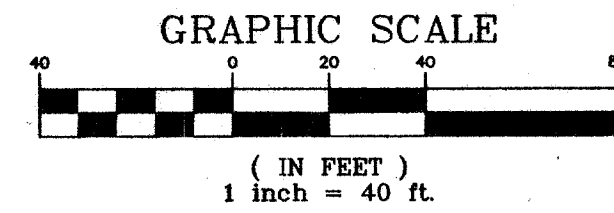

RECORD DRAWING
These Record Drawings have been prepared based on information provided by others. The Engineer has not verified the accuracy of such information and shall not be responsible for any errors or omissions which may be incorporated herein as a result.

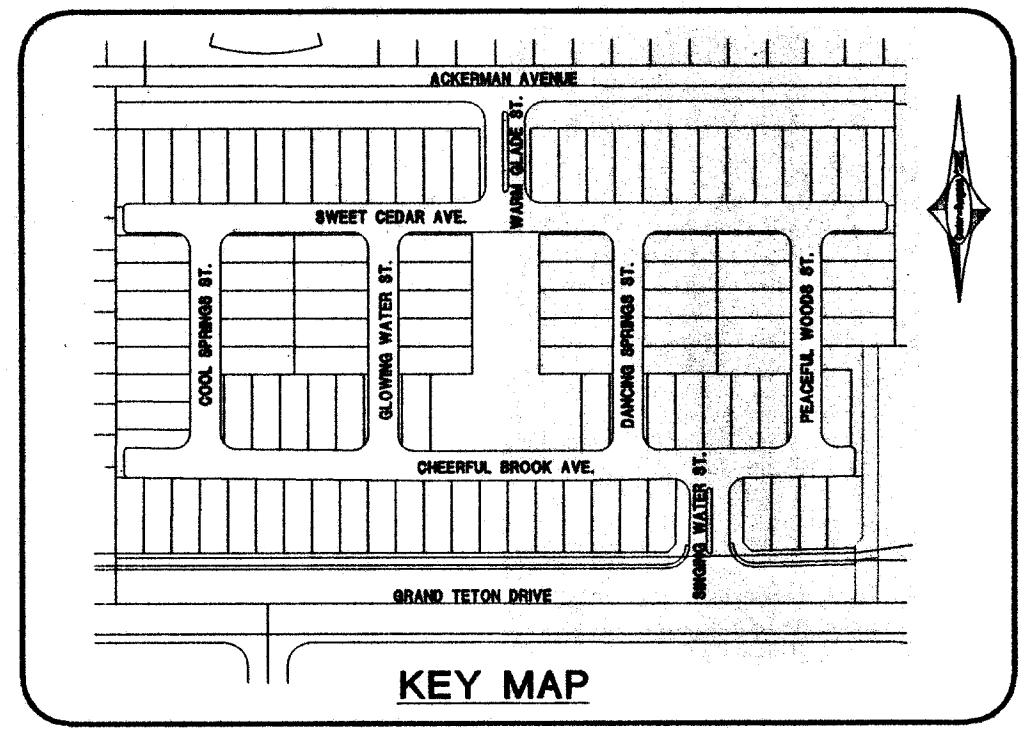

BASIS OF BEARINGS
THE BASIS OF BEARINGS FOR THIS PROJECT IS GRID NORTH, AS DEFINED BY THE NEVADA COORDINATE SYSTEM OF 1983 (NCS83) EAST ZONE, (2701) AS DETERMINED BY CLARK COUNTY GIS CONTROL POINTS 801, 805, AND 808.

BENCHMARK
CLV BM #7, STA. 0LV9017NES
RIVET & PLATE IN TOP OF CURB
SW CORNER OF GRAND TETON & DURANGO DRIVE
ELEVATION = 2539.74 (NAVD 88)
(774.1140 METERS)

SEWER
8" MAIN SWR SDR-35 J.M. MFG
(48) 4" SEWER LATS. J.M. MFG
(9) 48" M.H. J.M. MFG
SEPERATOIN SWR TO WATER = 18.5'

WATER
8" MAIN-C-900 J.M. MFG
(48) 1" COPPER SERVICES
F.H. MUELLER MADE
SEPERATION WATER TO SWR = 18.5'

Call before you Overhead
1-702-593-6111
NEVADA POWER ENVIRONMENT AND SAFETY SERVICES DEPARTMENT

Call before you Dig
1-800-227-2600

GREYSTONE HOMES		6655 Bermuda road Las Vegas, NV 89119 (702) 938-5400 Fax (702) 938-5454	
AS-BUILT UTILITY PLAN		Carter Burgess Consultants in Planning, Engineering, Construction Management, and Related Services 3785 E. SUNSET ROAD Las Vegas, NV 89120 (702) 735-9100	
Spring Mountain Ranch Unit 57A BY GREYSTONE HOMES		DRAWN BY: TLD DESIGNED BY: CHECKED BY: BW PROJECT NO: 206612 SCALE: 1"=40' HORIZ VERT.	
SHEET 3 OF 3 SHEETS		DRAWING NO. 107Y-4518-57A	
107Y-4518-57A		L:\206612\DESIGN\MPR\WTS\612-5-BUT.dwg(SHT6)	