



AS-BUILT UTILITY PLANS FOR BIG MOUNTAIN RANCH UNIT 57A

(A RESIDENTIAL PLANNED DEVELOPMENT)

APN No's.125-08-806-001, 125-08-806-002, 125-08-806-009, 125-08-813-003

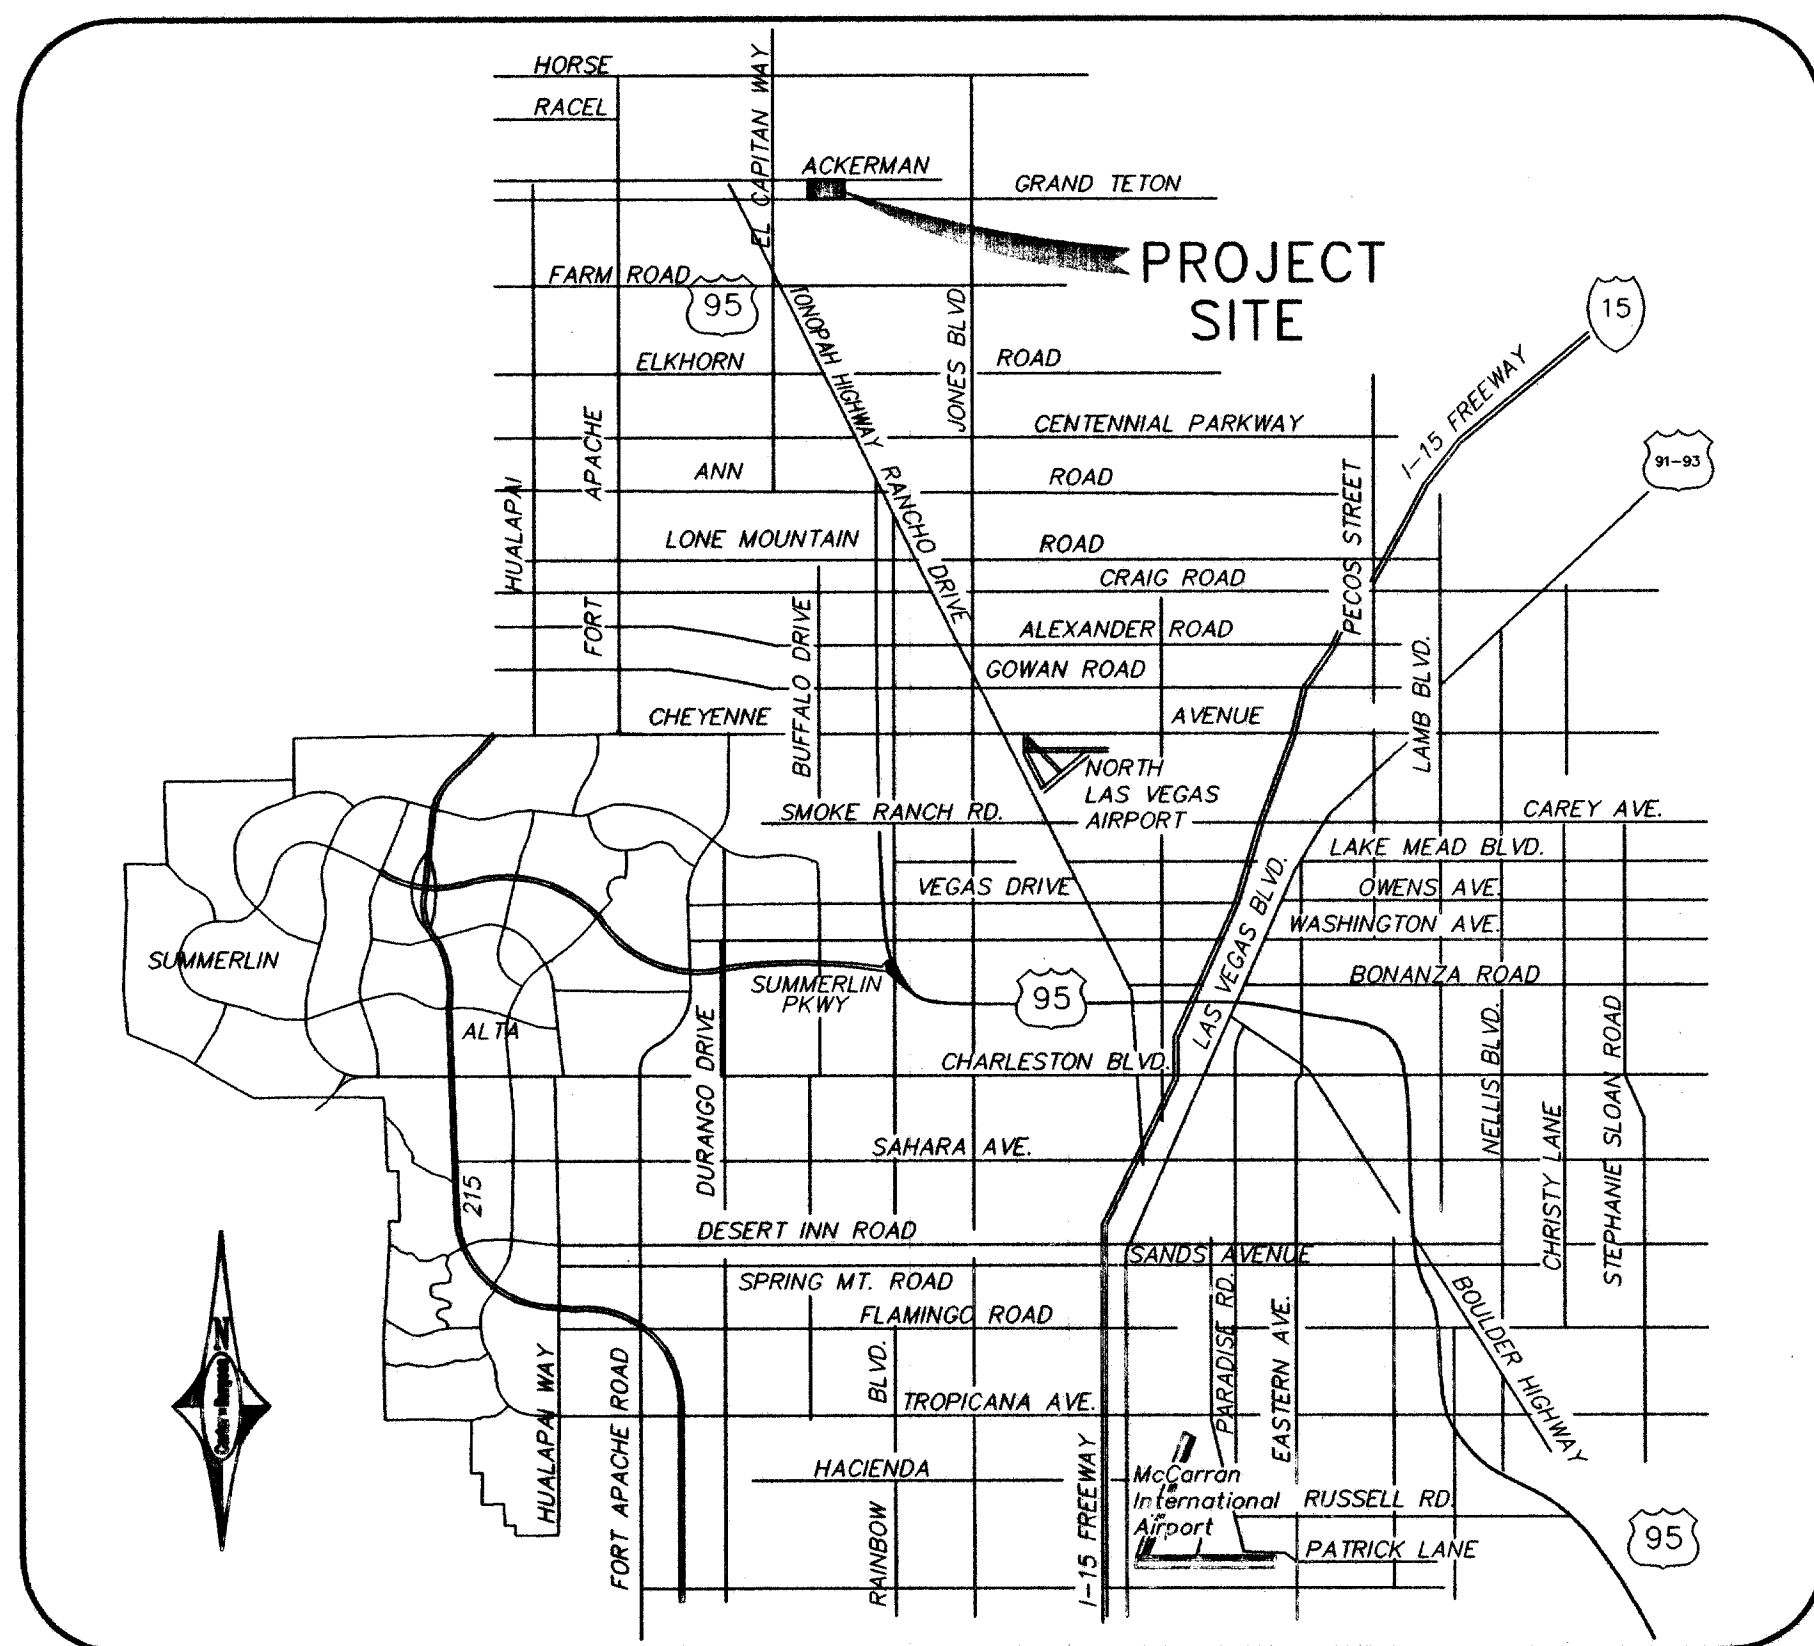

VICINITY MAP

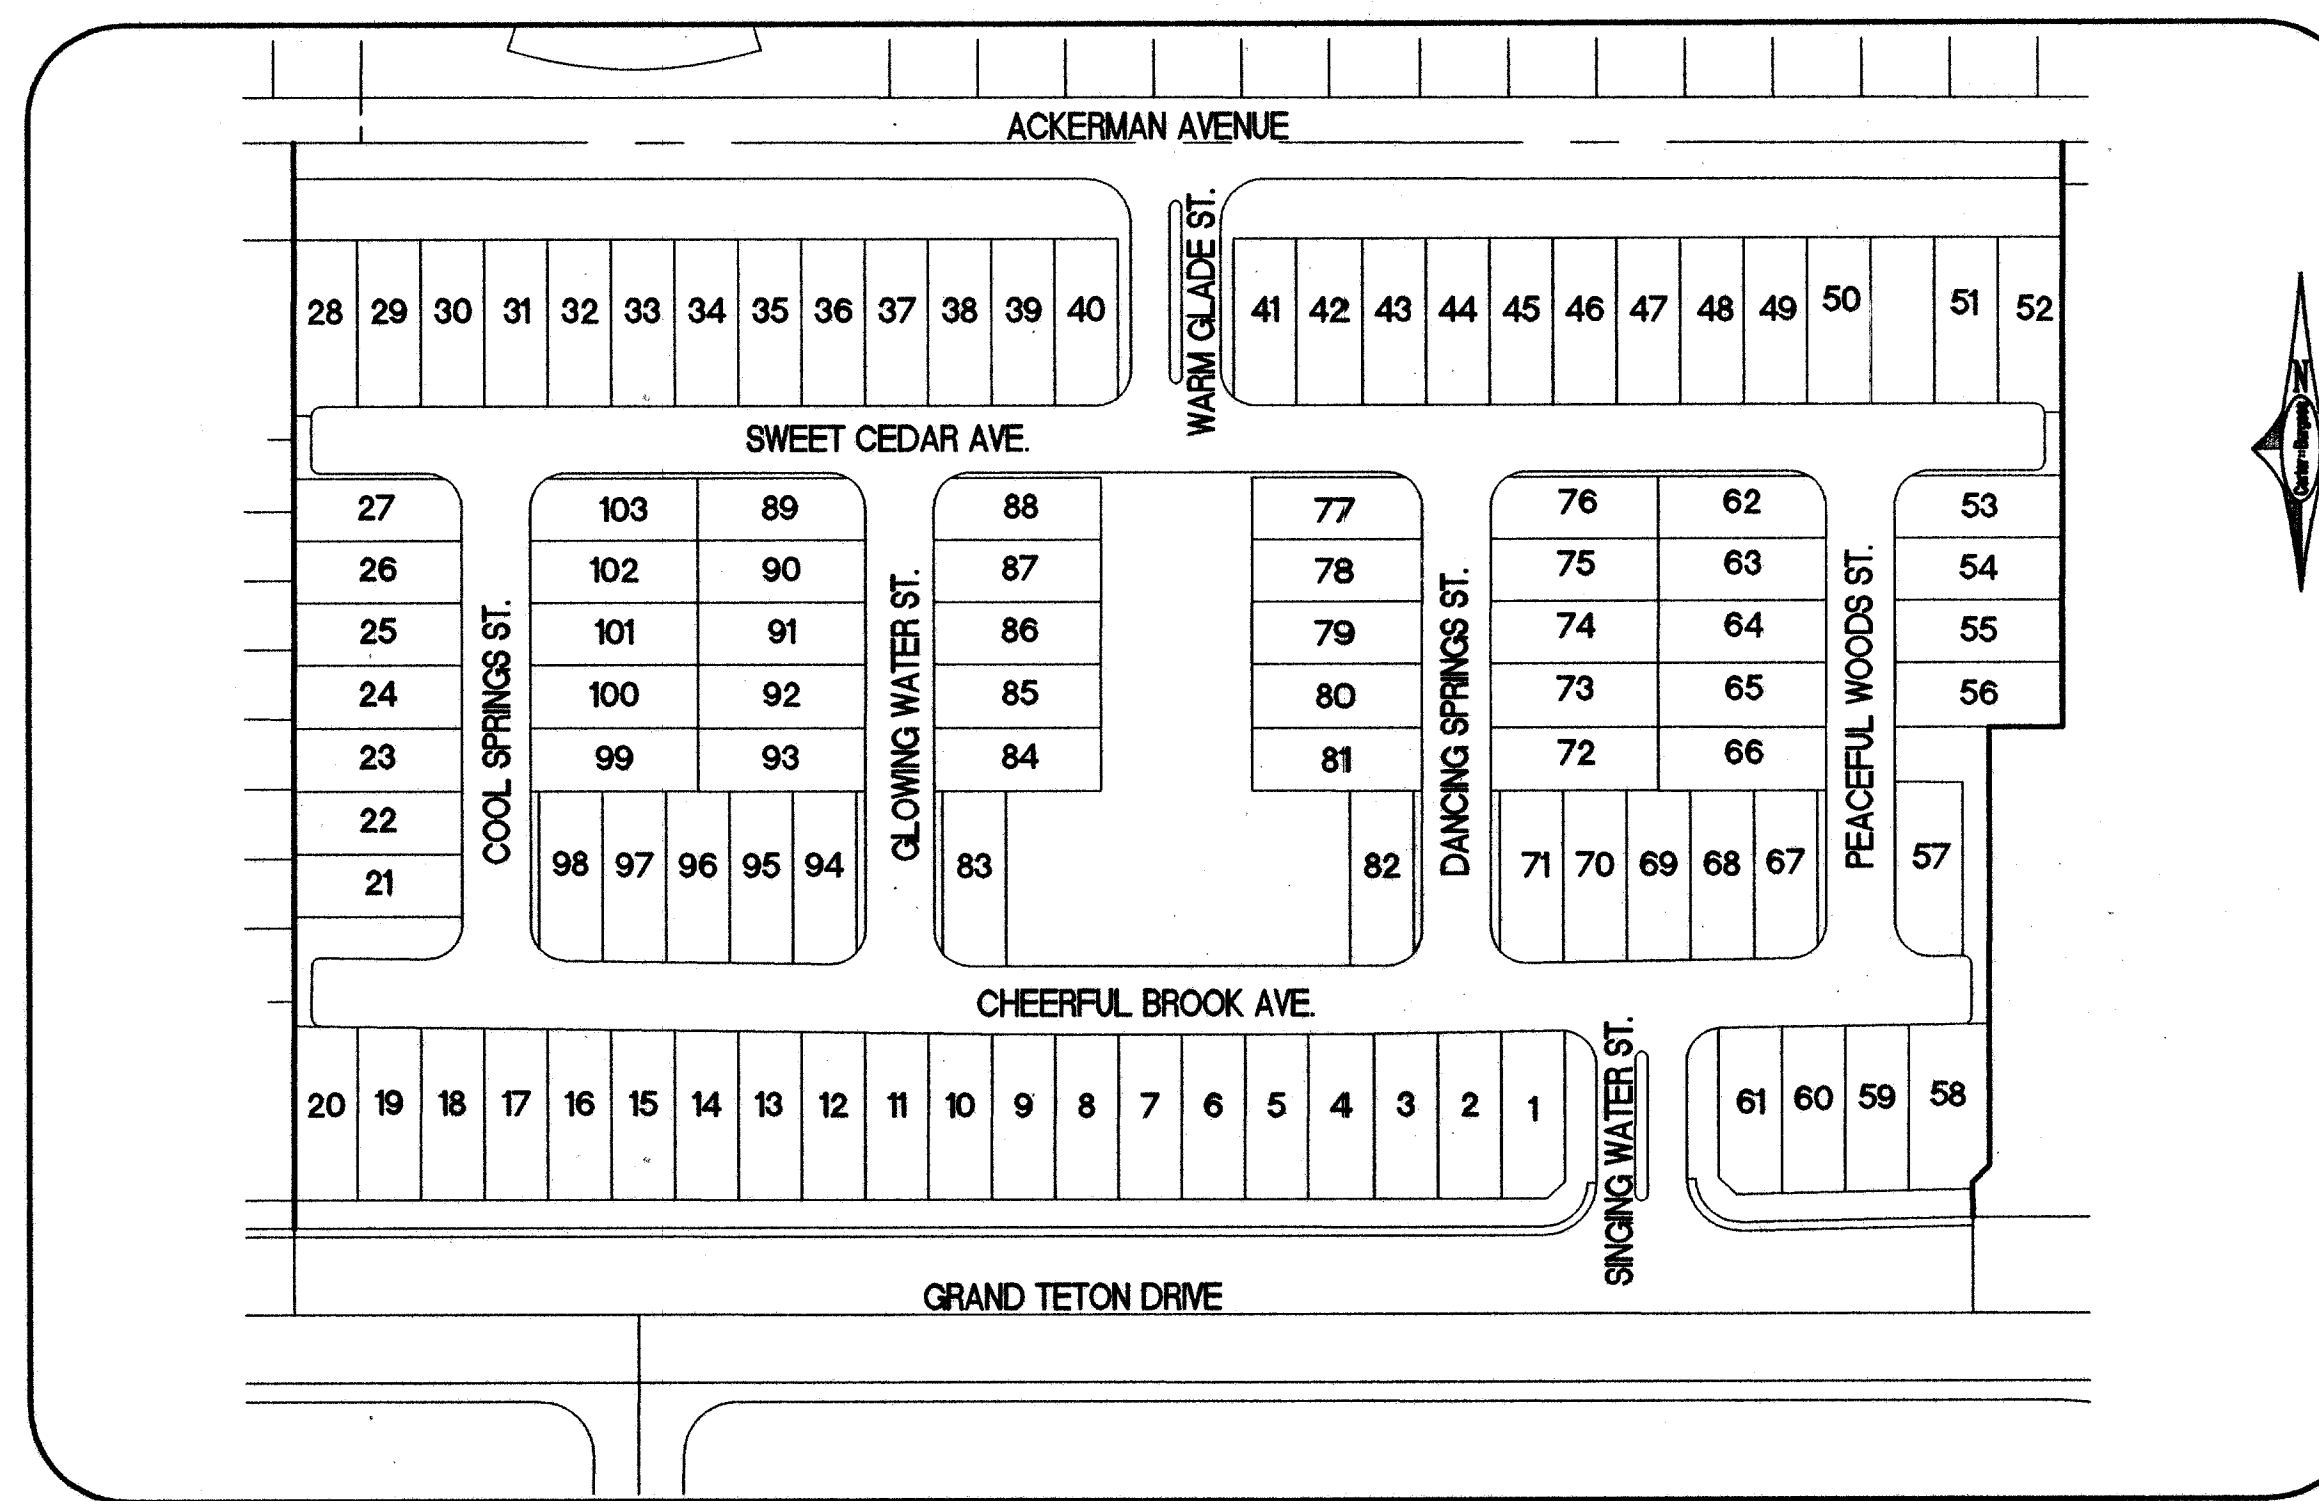

SITE MAP

OWNER/DEVELOPER:

GREYSTONE HOMES
3765 E. SUNSET ROAD
Las Vegas, NV 89120
(702) 739-9100

ENGINEER:

Carter :: Burgess

CONSULTANTS IN PLANNING, ENGINEERING,
CONSTRUCTION MANAGEMENT, AND RELATED SERVICES
8655 BERMUDA ROAD, LAS VEGAS, NEVADA 89119
(702) 938-5400 FAX (702) 938-5454
MARK J. FAKLER, PE No. 9911

LEGAL DESCRIPTION

A PORTION OF THE SOUTH HALF (S 1/2) OF
THE SOUTHEAST QUARTER (SE 1/4)
OF SECTION 8, TOWNSHIP 19 SOUTH,
RANGE 60 EAST, M.D.M., CITY OF LAS VEGAS,
CLARK COUNTY, NEVADA.

BASIS OF BEARING

THE BASIS OF BEARINGS FOR THIS PROJECT IS GRID NORTH, AS DEFINED BY THE NEVADA COORDINATE SYSTEM OF 1983 (NCS83) EAST ZONE, (2701) AS DETERMINED BY CLARK COUNTY GIS CONTROL POINTS 801, 805, AND 806.

BENCHMARK

C.L.V. BM #7, STA. 0LV9017NES
RIVET & PLATE IN TOP OF CURB
© SW CORNER OF GRAND TETON
& DURANGO DRIVE

ELEVATION = 2539.74 (NAVD 88)
(774.1140 METERS)

SHEET INDEX

<u>SHEET</u>	<u>TITLE</u>
1.	COVER SHEET
5.	AS-BUILT UTILITY PLAN
6.	AS-BUILT UTILITY PLAN

RECORD DRAWING

These Record Drawings have been prepared based on information provided by others. The Engineer has not verified the accuracy of such information and shall not be responsible for any errors or omissions which may be incorporated herein as a result.

AS-BUILT COVER SHEET	GREYSTONE HOMES
----------------------	-----------------

**Spring Mountain Ranch Unit 57A
BY GREYSTONE HOMES**

Carter::Burgess

6655 Bermuda road
Las Vegas, NV 89119
(702) 938-5400 Fax (702) 938-5454

\\240612\DESIGN\IMPRVMTS\612-1-COV.DWG