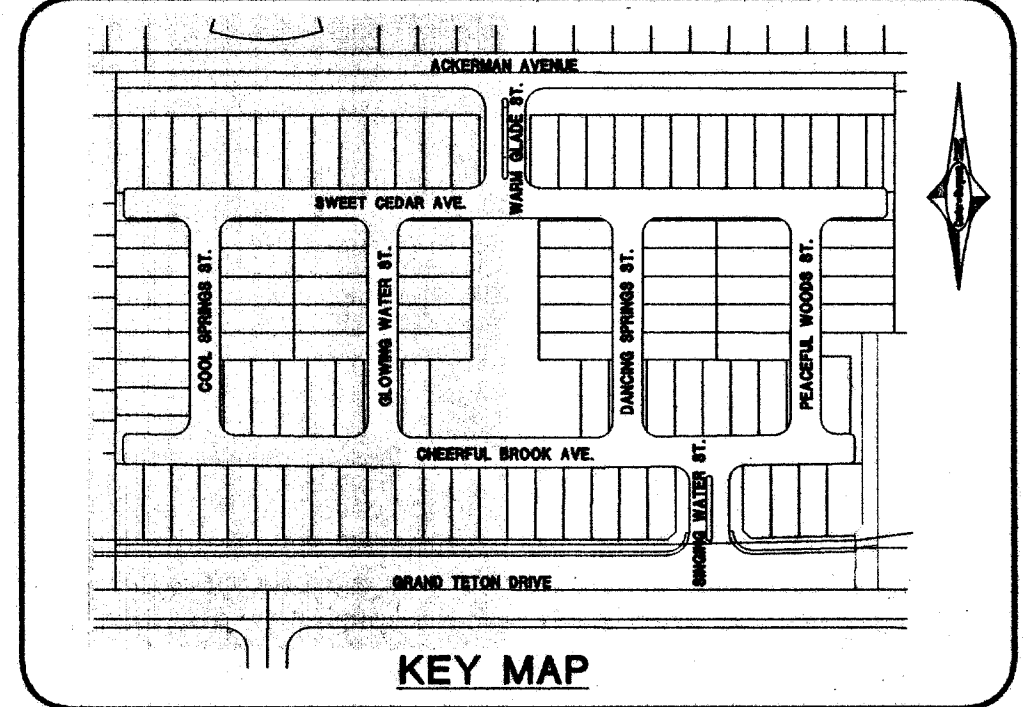
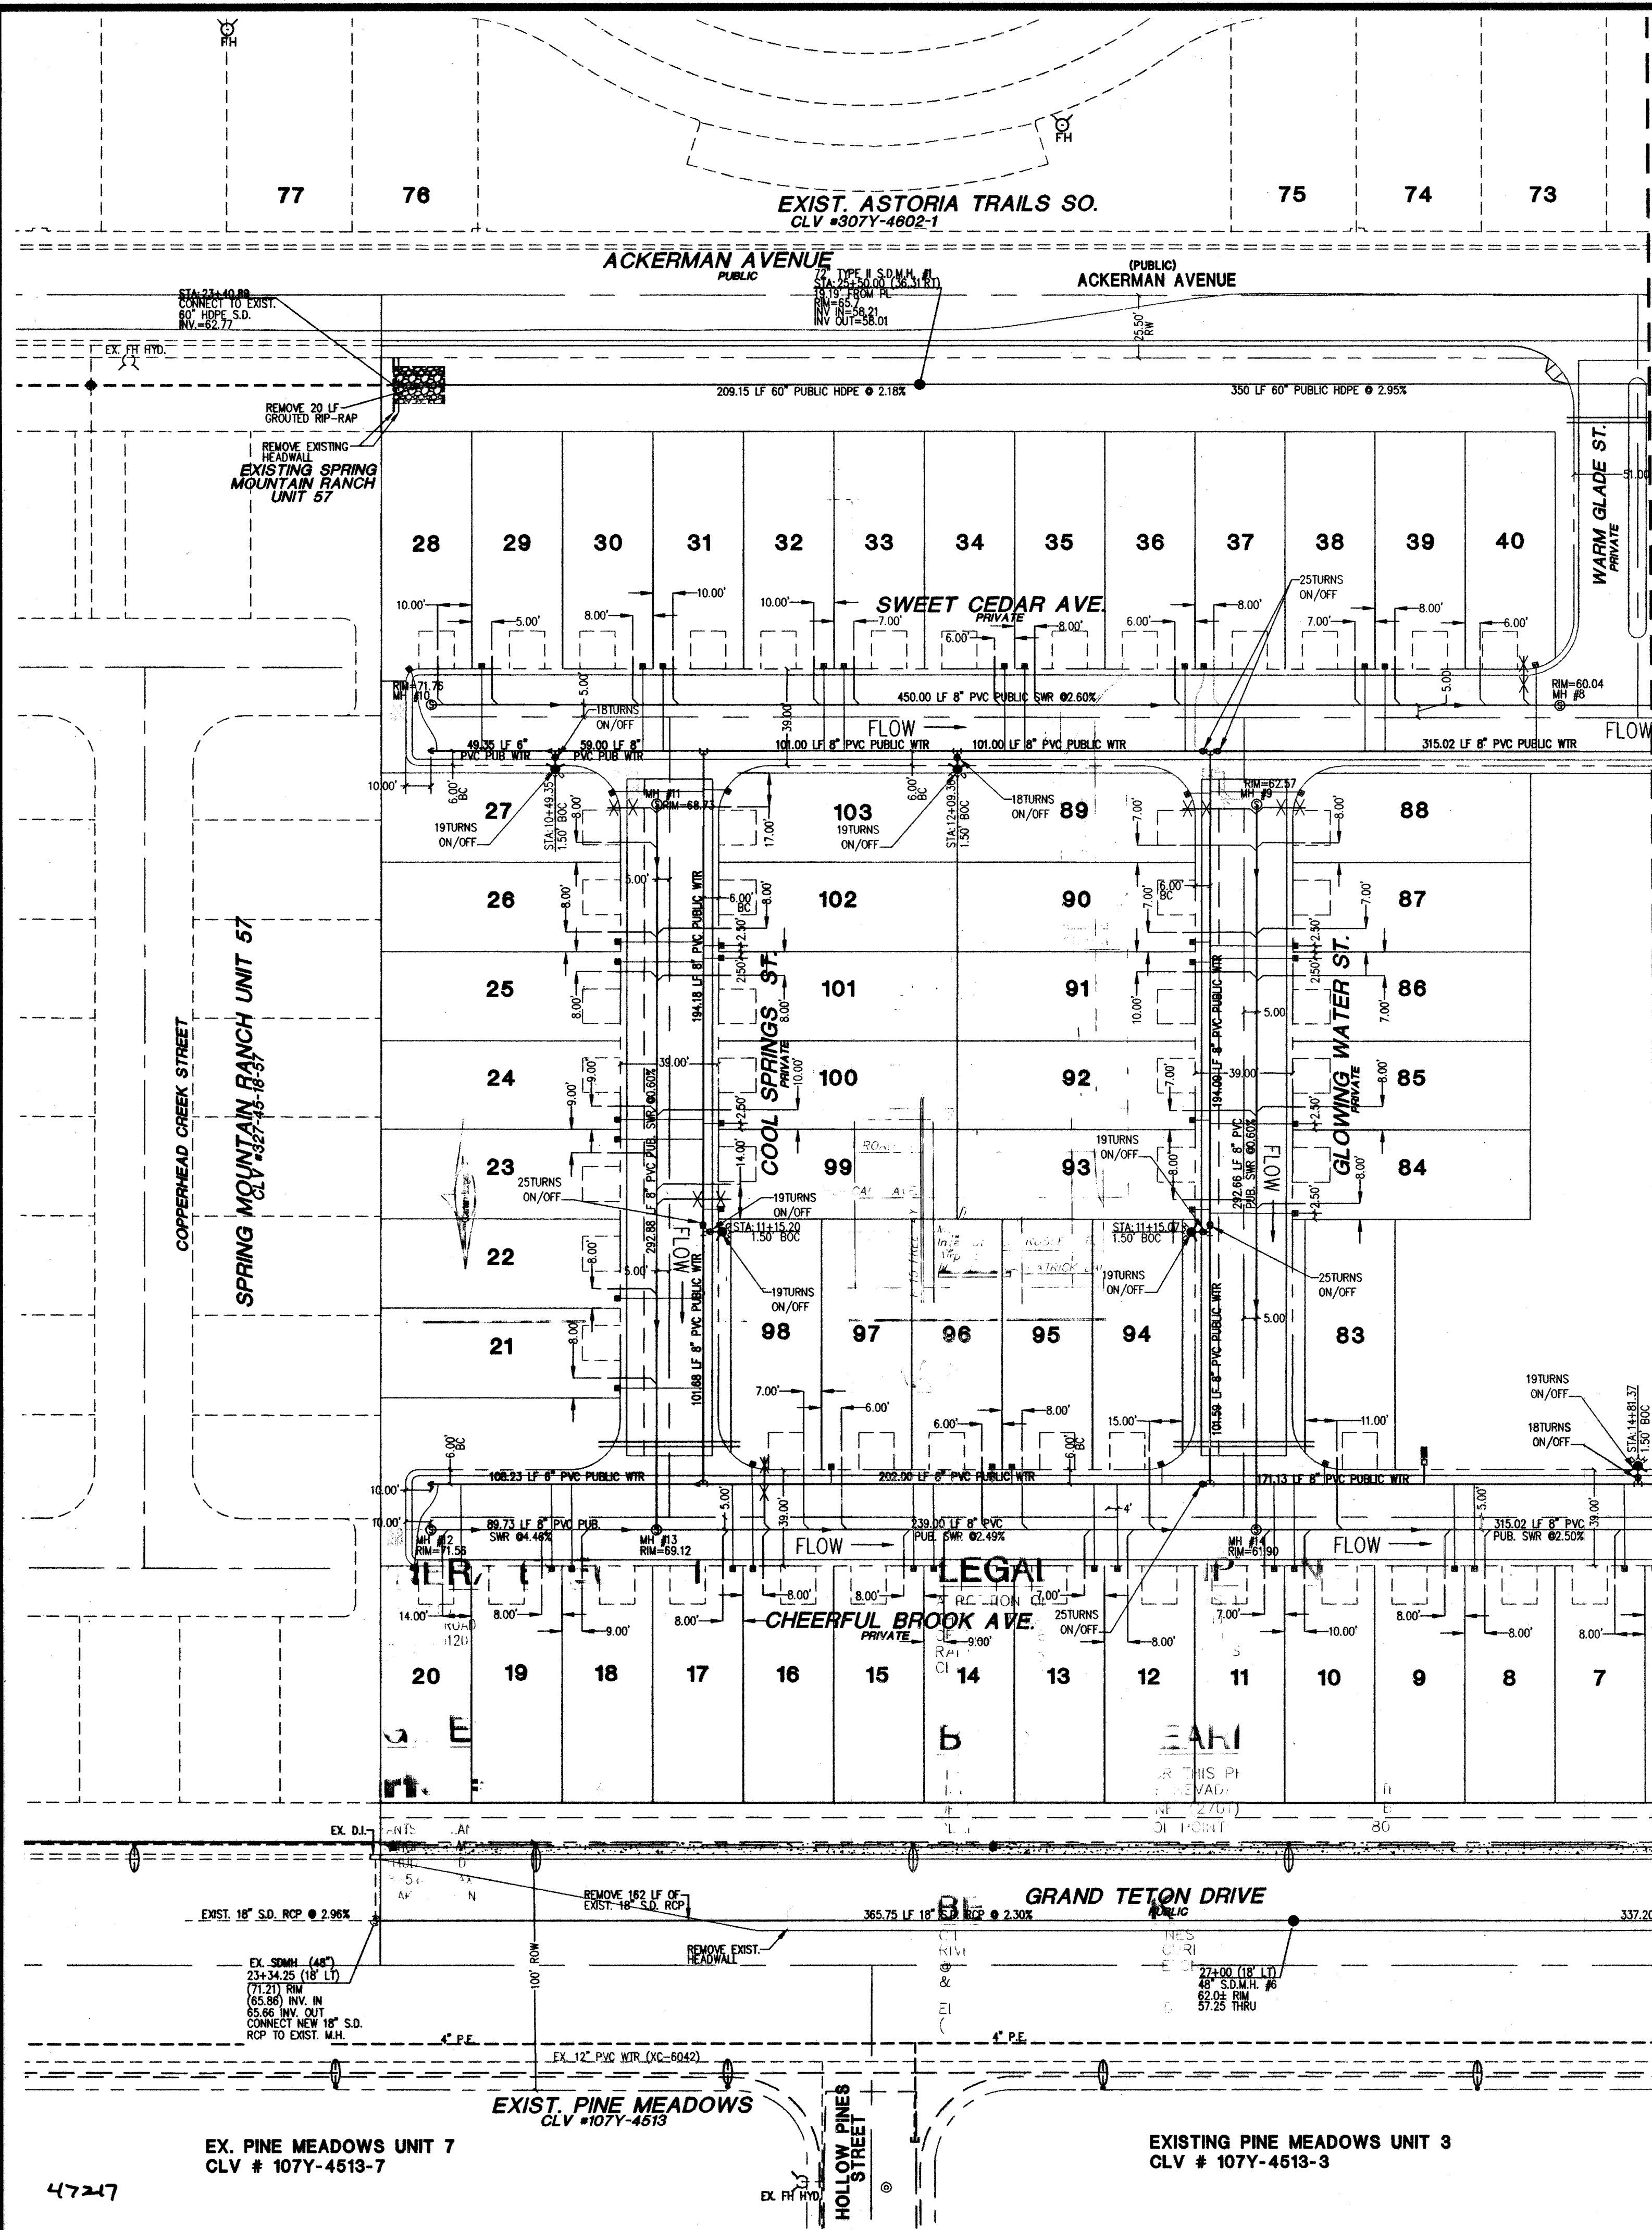


RECORD DRAWING
These Record Drawings have been prepared based on information provided by others. The Engineer has not verified the accuracy of such information and shall not be responsible for any errors or omissions which may be incorporated herein as a result.

BASIS OF BEARINGS

THE BASIS OF BEARINGS FOR THIS PROJECT IS GRID NORTH, AS DEFINED BY THE NEVADA COORDINATE SYSTEM OF 1983 (NCS83) EAST ZONE, (2701) AS DETERMINED BY CLARK COUNTY GIS CONTROL POINTS 801, 805, AND 806.

BENCHMARK

CLV. BM #7, STA. 01V9017NES
RIVET & PLATE IN TOP OF CURB
@ SW CORNER OF GRAND TETON
& DURANGO DRIVE
ELEVATION = 2539.74 (NAVD 88)
(774.1140 METERS)

SEWER

8" MAIN SWR SDR-35 J.M. MFG
(55) 4" SEWER LATS. J.M. MFG
(7) 48" M.H. J.M. MFG
SEPERATION SWR TO WATER = 18.5'

WATER

8" MAIN-C-900 J.M. MFG
(55) 1" COPPER SERVICES
F.H. MUELLER MADE
SEPERATION WATER TO SWR = 18.5'

GREYSTONE HOMES

AS-BUILT UTILITY PLAN

DRAWN BY: TLD
DESIGNED BY:
CHECKED BY: DW
PROJECT NO: 240612
SCALE: 1"=40'
HORIZ. VERT.

SHEET 2 OF 3 SHEETS
DRAWING NO. 107Y-4518-57A

3765 E. SUNSET ROAD
Las Vegas, NV 89120
702 739-9100

Spring Mountain Ranch Unit 57A
BY GREYSTONE HOMES

6655 Bermuda Road
Las Vegas, NV 89119
702 938-5400 Fax 702 938-5464

Carter Burgess
Consultants in Planning, Engineering,
Construction Management, and Related Services

REC
vin
red
roc
re
gate
Call before you Overhead
1-702-593-6111
NEVADA POWER ENVIRONMENT AND SAFETY SERVICES DEPARTMENT

Call before you Dig
1-800-227-2600

47247