

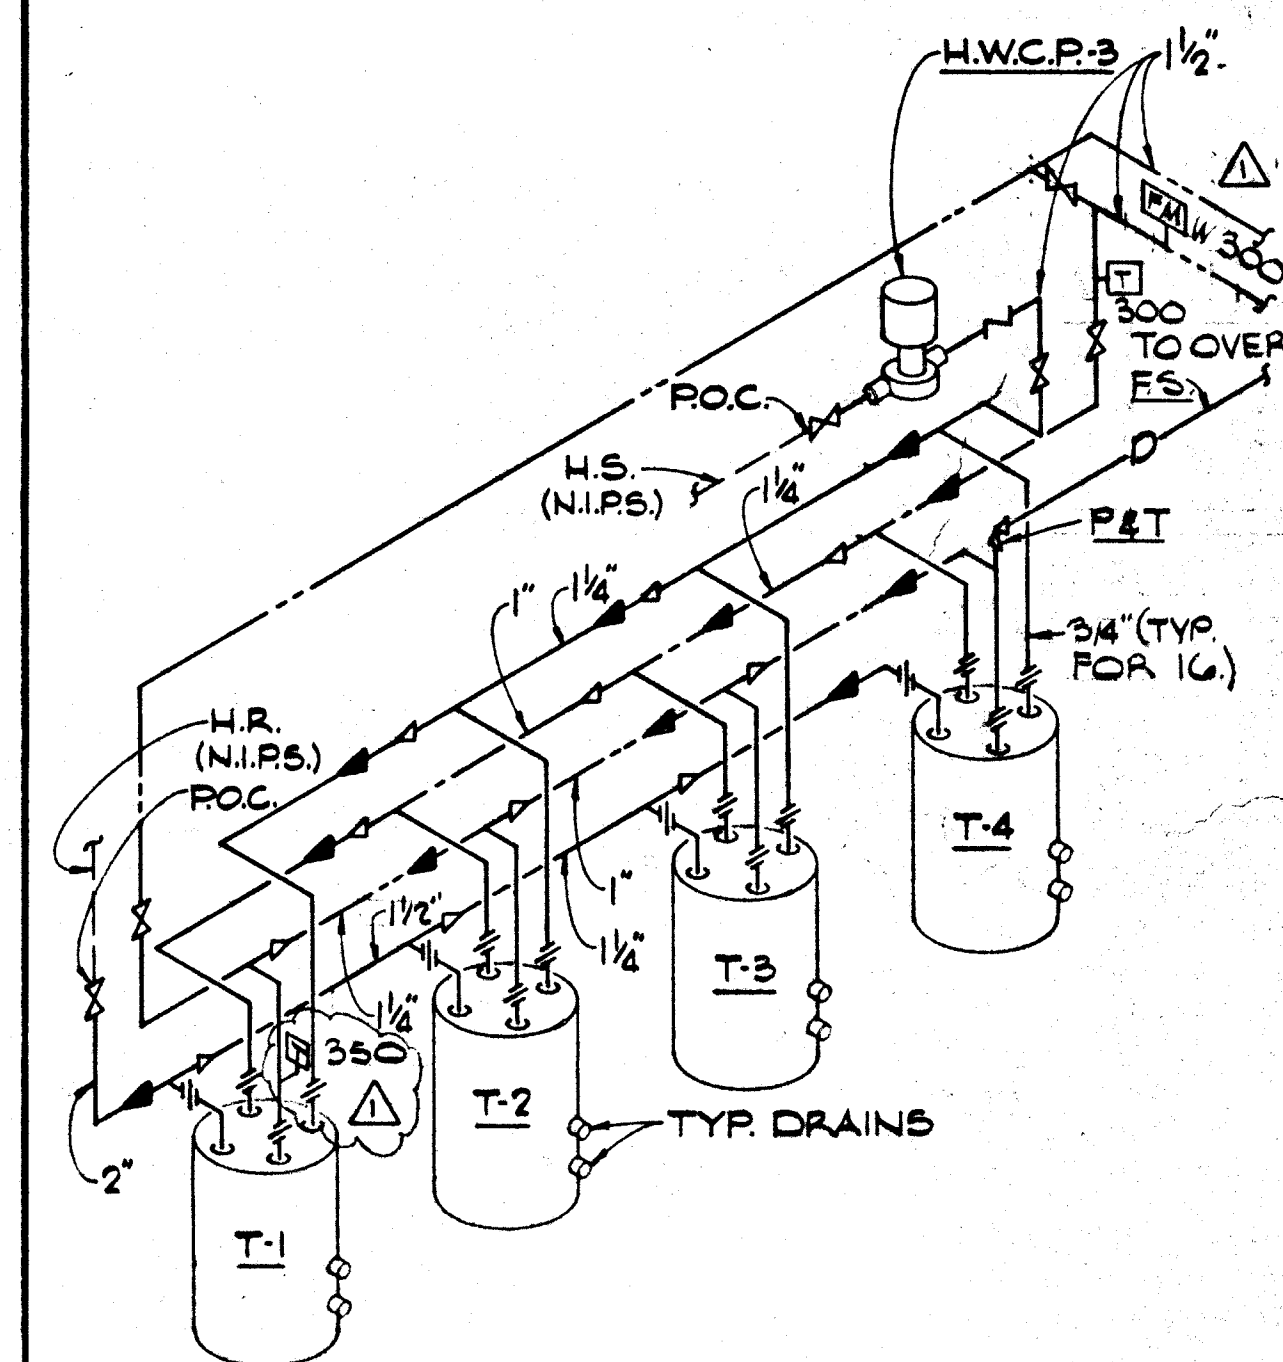
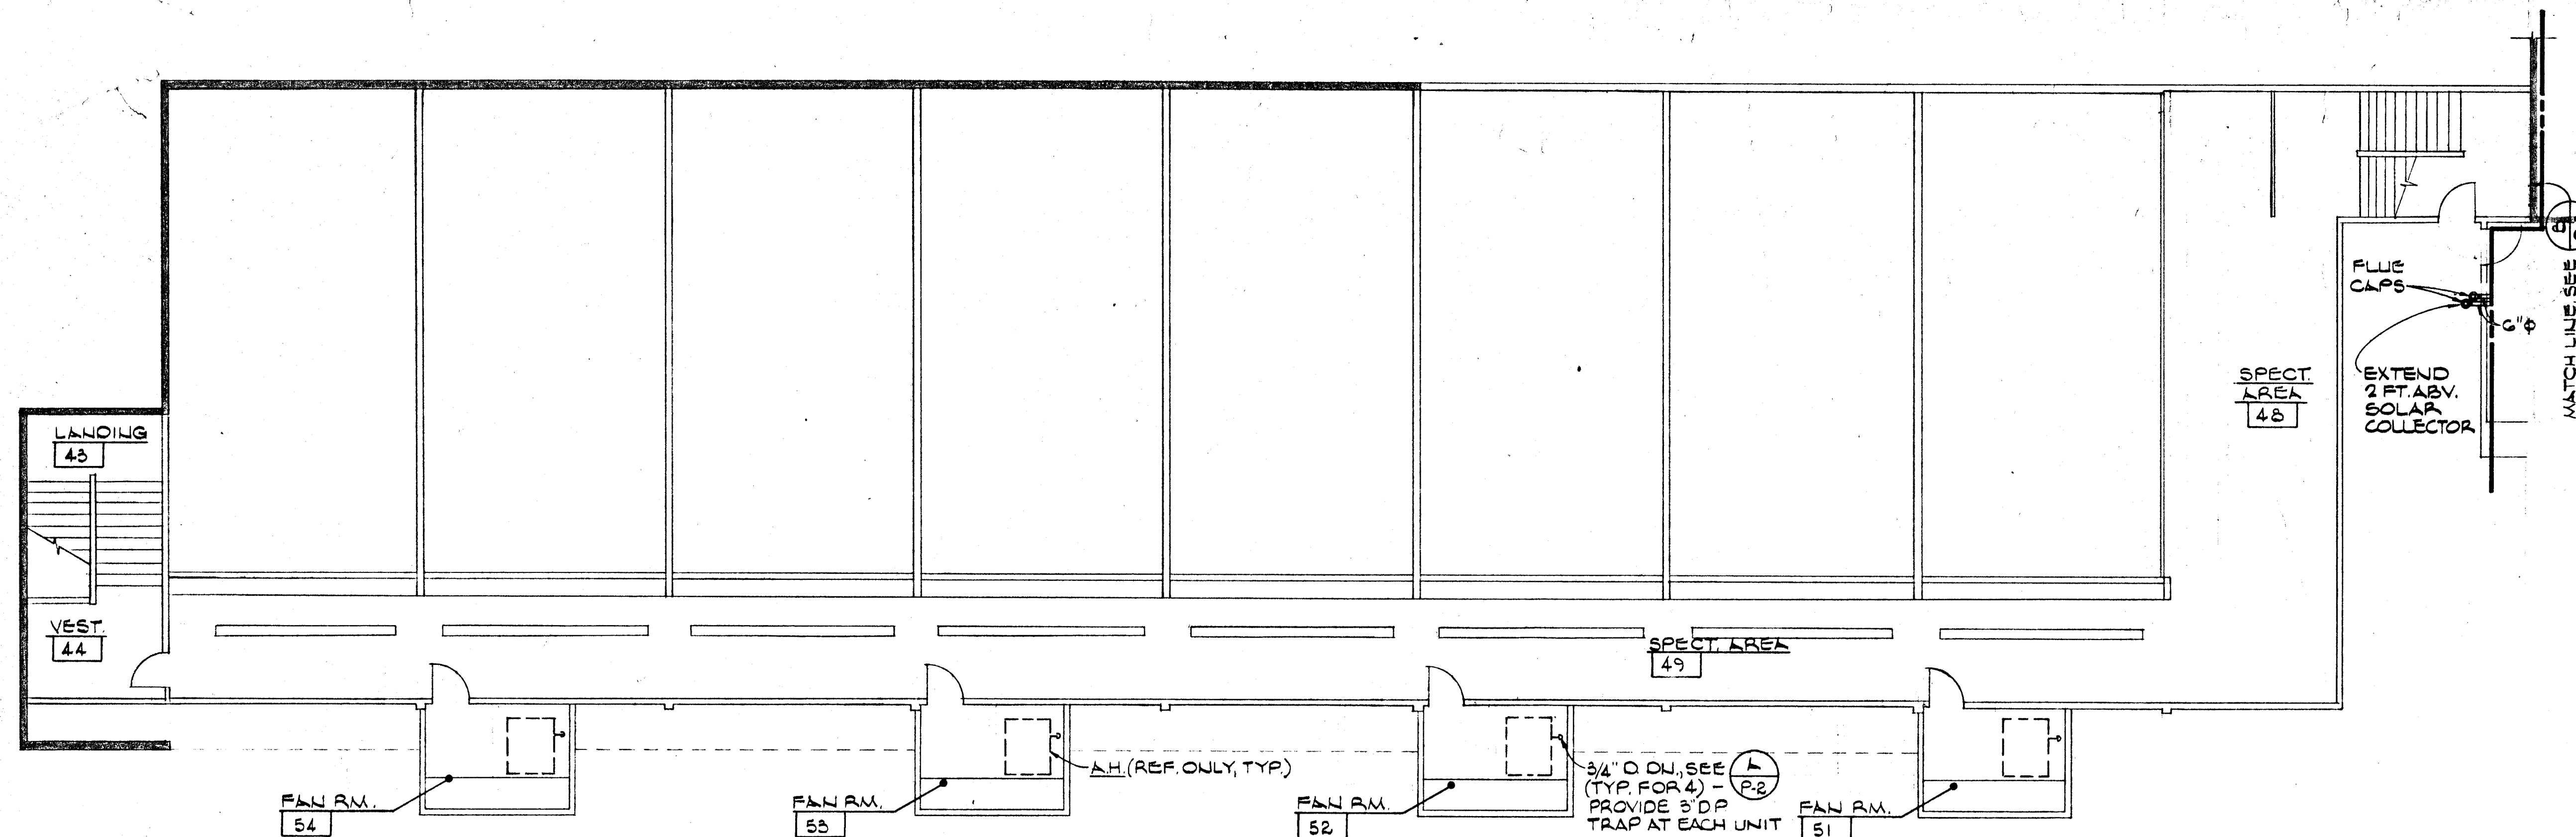


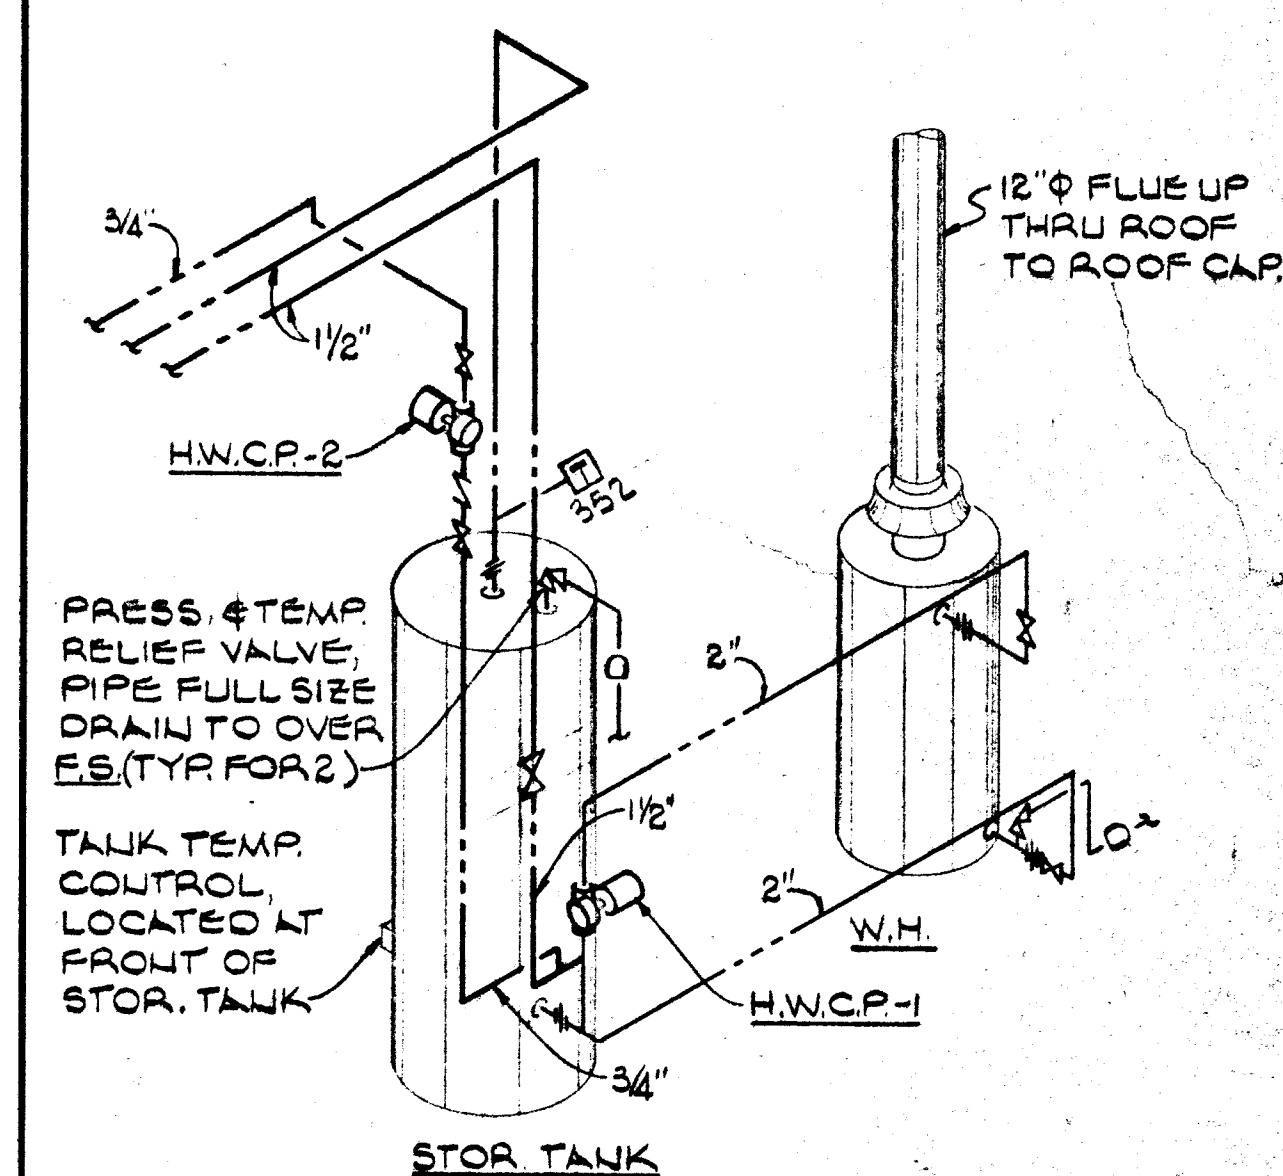

T-1 THRU 4 PIPING DETAIL  
NO SCALE

STEWART-MOORE RECREATION CENTER  
FOR THE CITY OF LAS VEGAS  
LAS VEGAS, NEVADA  
BUILDING FIRST FLOOR & MEZZANINE  
PART PLANS & DETAILS

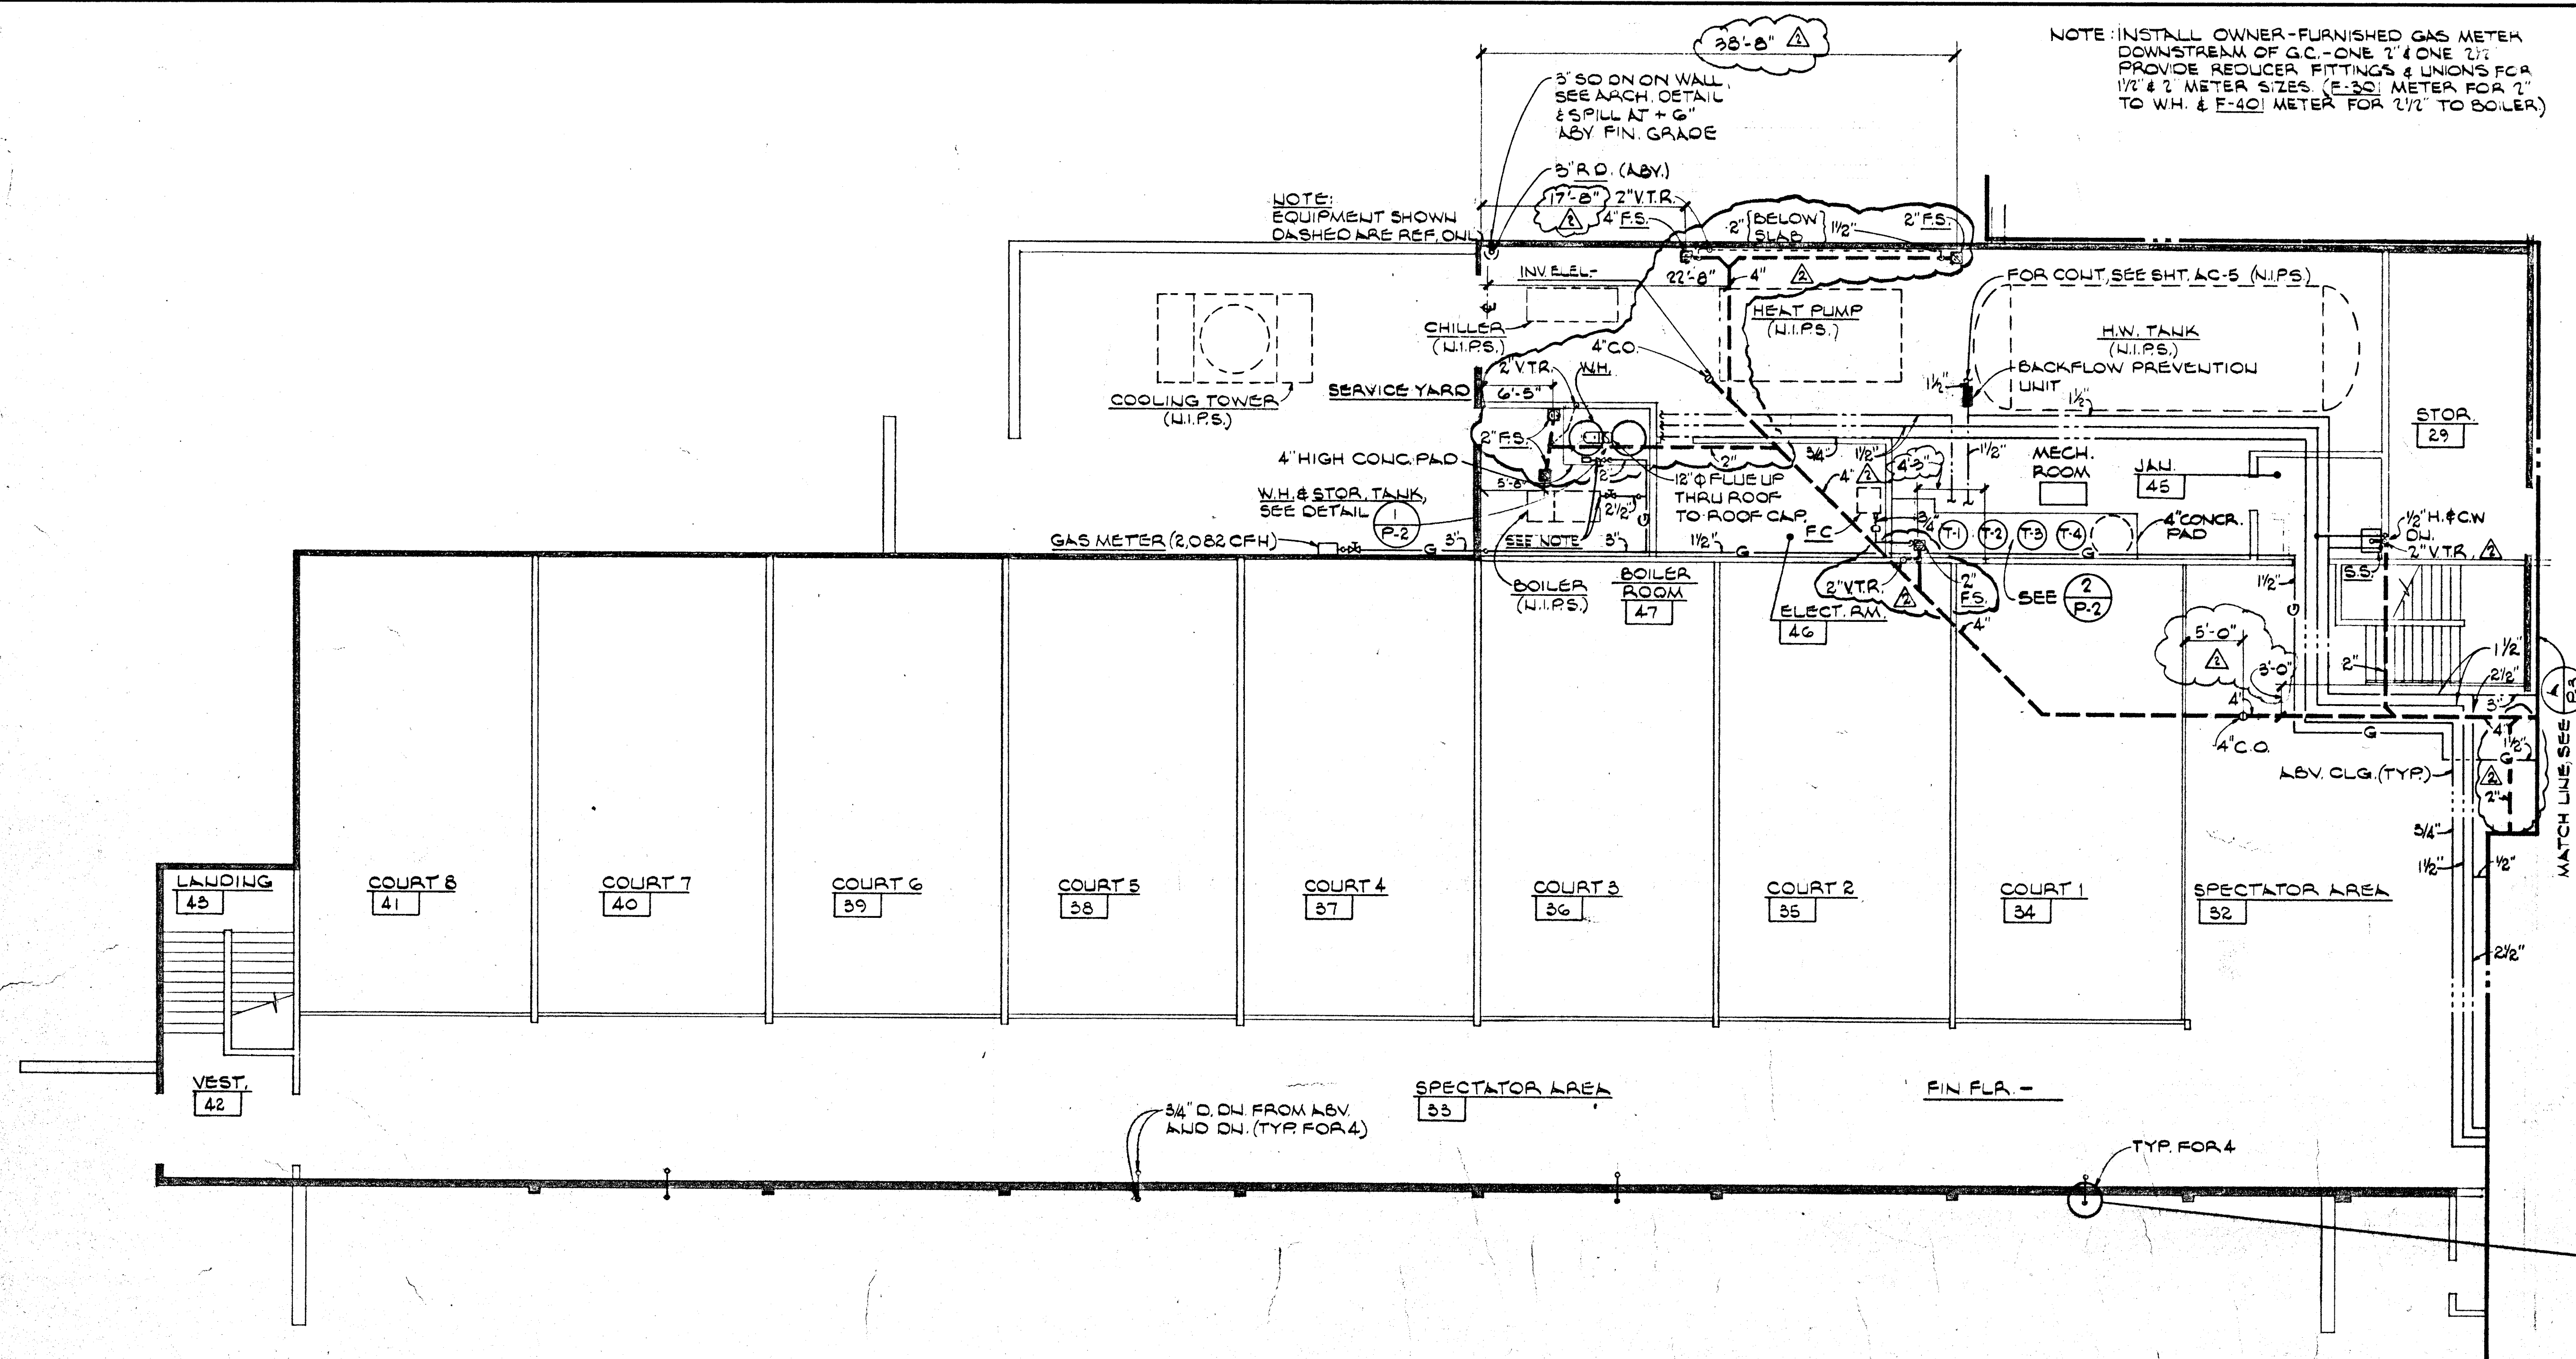

W.H. & STOR. TANK DET.  
NO SCALE

4-3-79 REVISE PER N.A.S.A.  
4-21-81 AS-BUILT  
677  
R.L.  
R.T.J.  
1-10-75

LEO F. BORN

a.i.a. architect 1009 casino center boulevard south las vegas, nevada 89101 phone 384-3185

P-2

3815

671-43 G