


**MEZZANINE FLOOR PART PLAN**  
 1/8"=1'-0" (P.3)

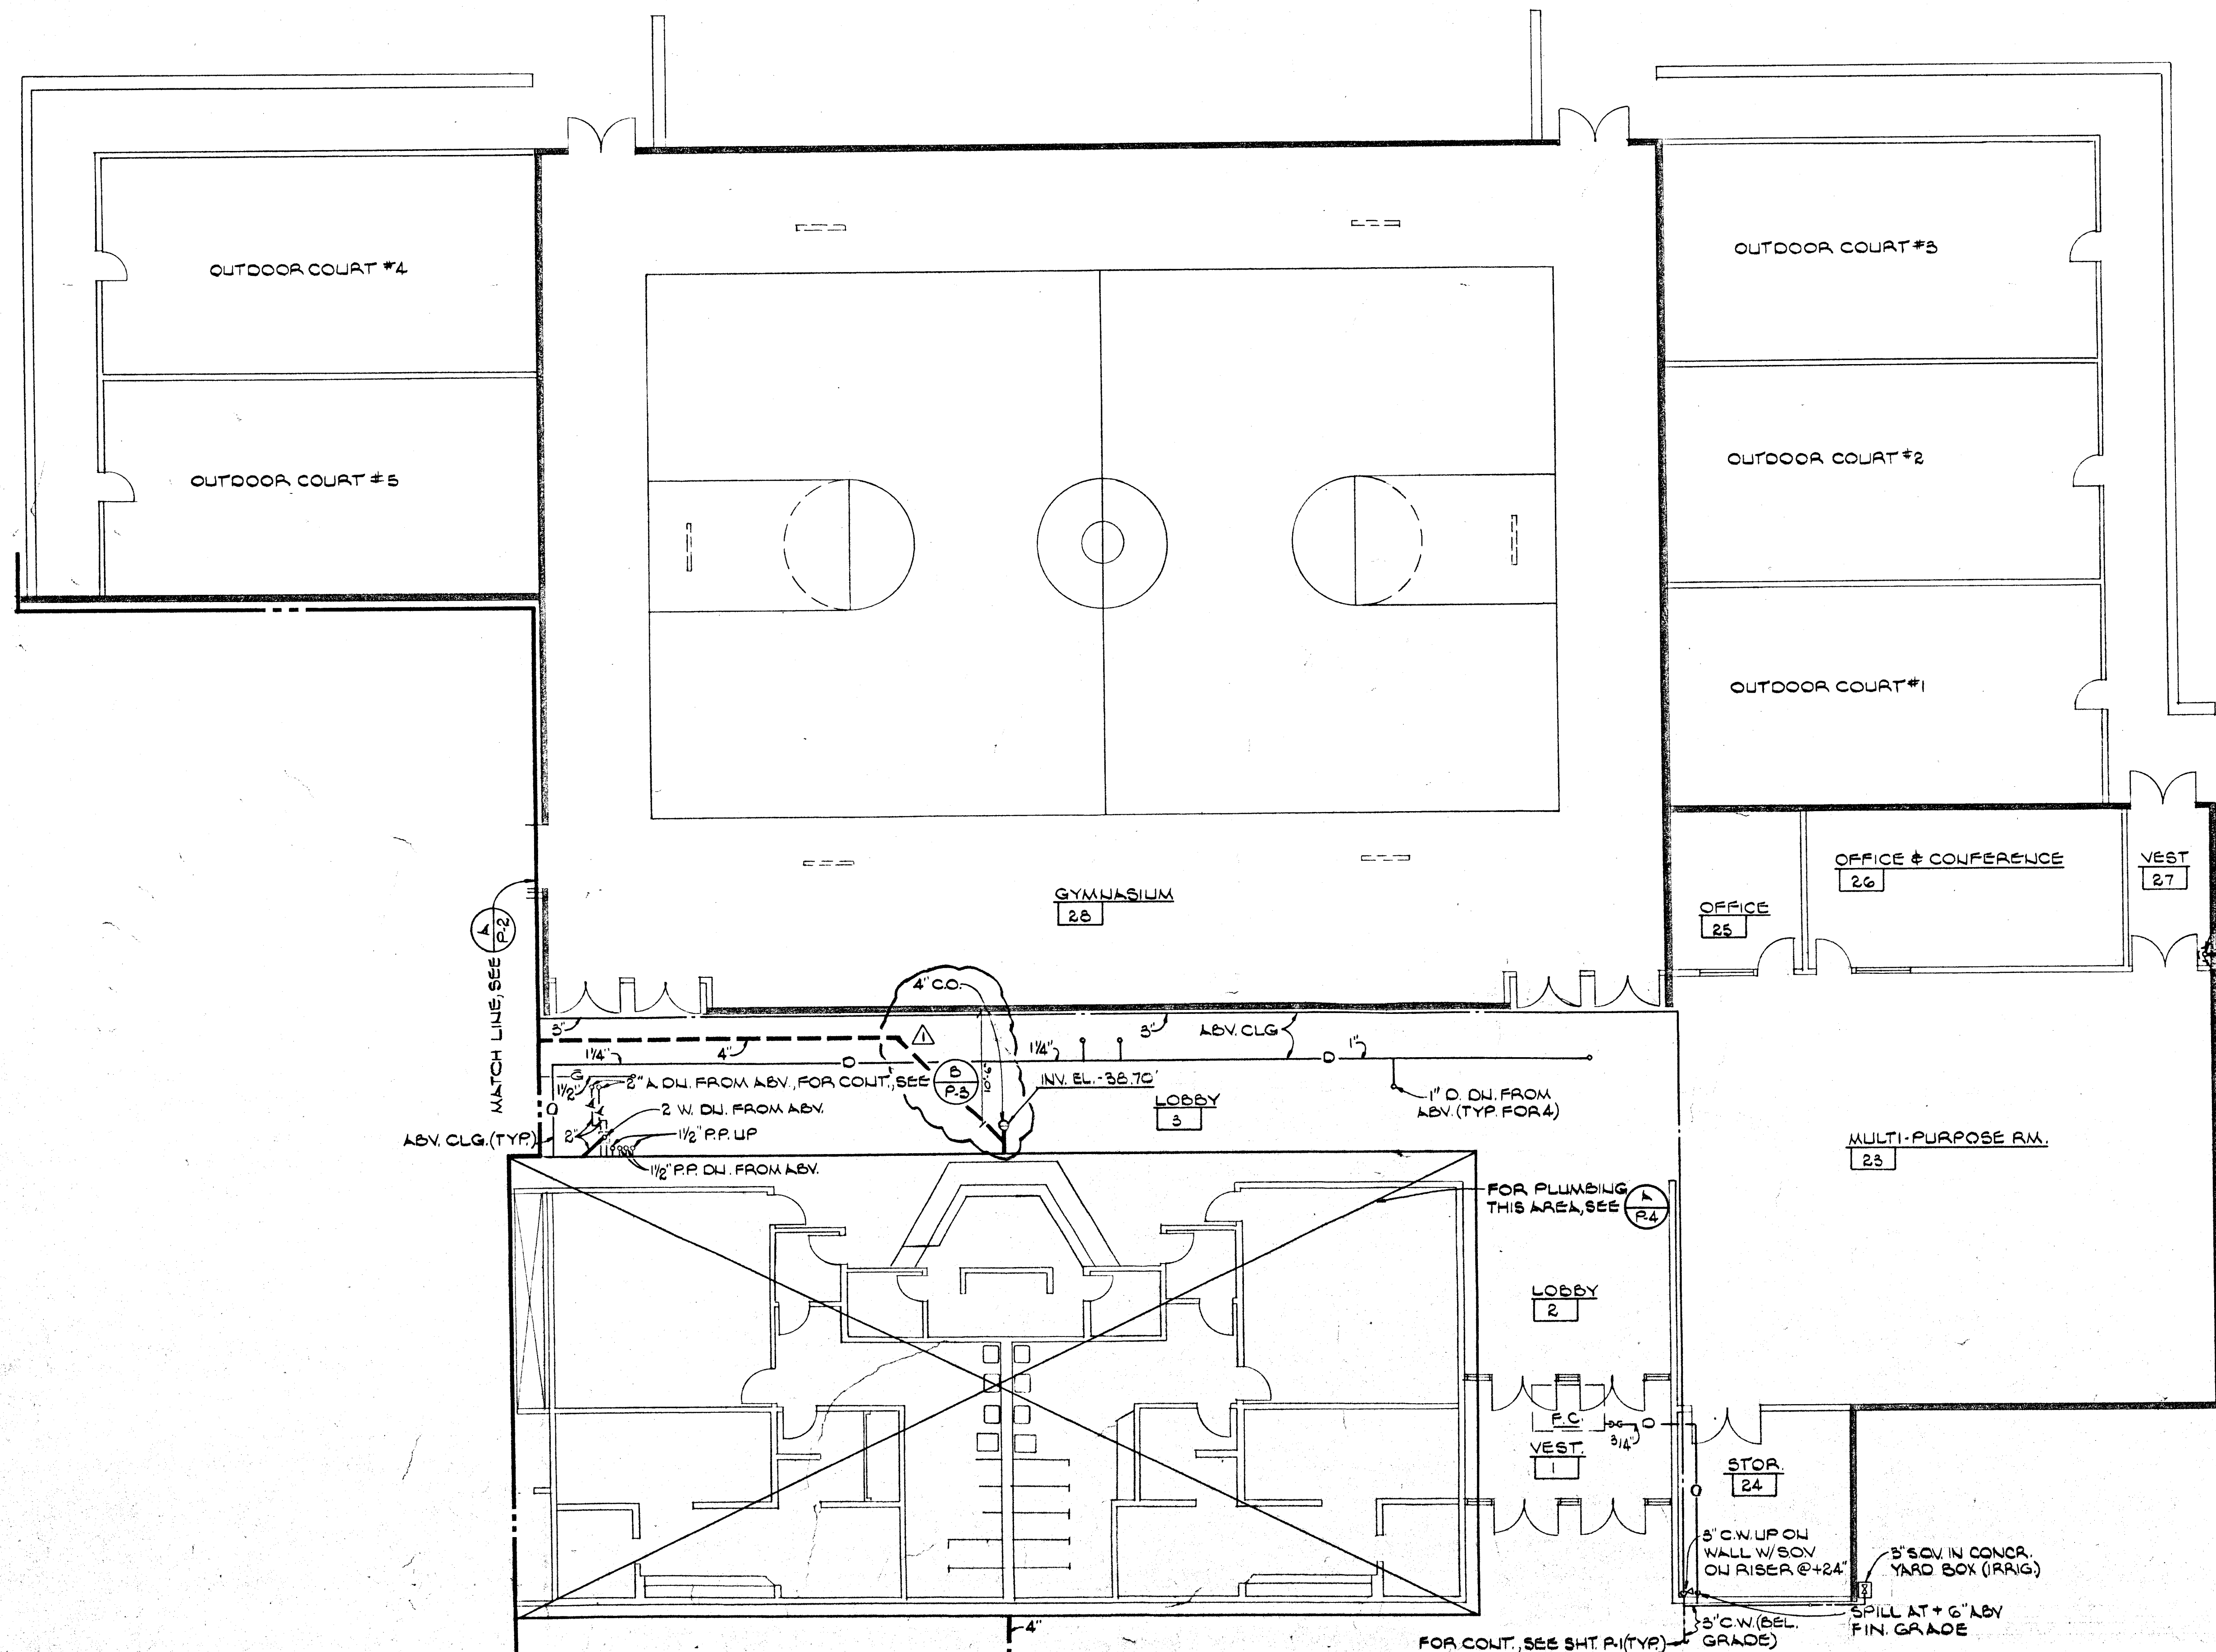

**FIRST FLOOR PART PLAN**  
 1/8"=1'-0" (P.3)

STEWART-MOJAVE RECREATION CENTER  
 FOR THE CITY OF LAS VEGAS  
 LAS VEGAS, NEVADA

4-21-91 AS-BUILT

BY	AL
CHECKED BY	ATJ
DATE	1-20-76

**LEO F. BORNS**  
 a. i. e. architect 1009 casino center, boulevard south las vegas, nevada 89101 phone 384-3185

(P.3)