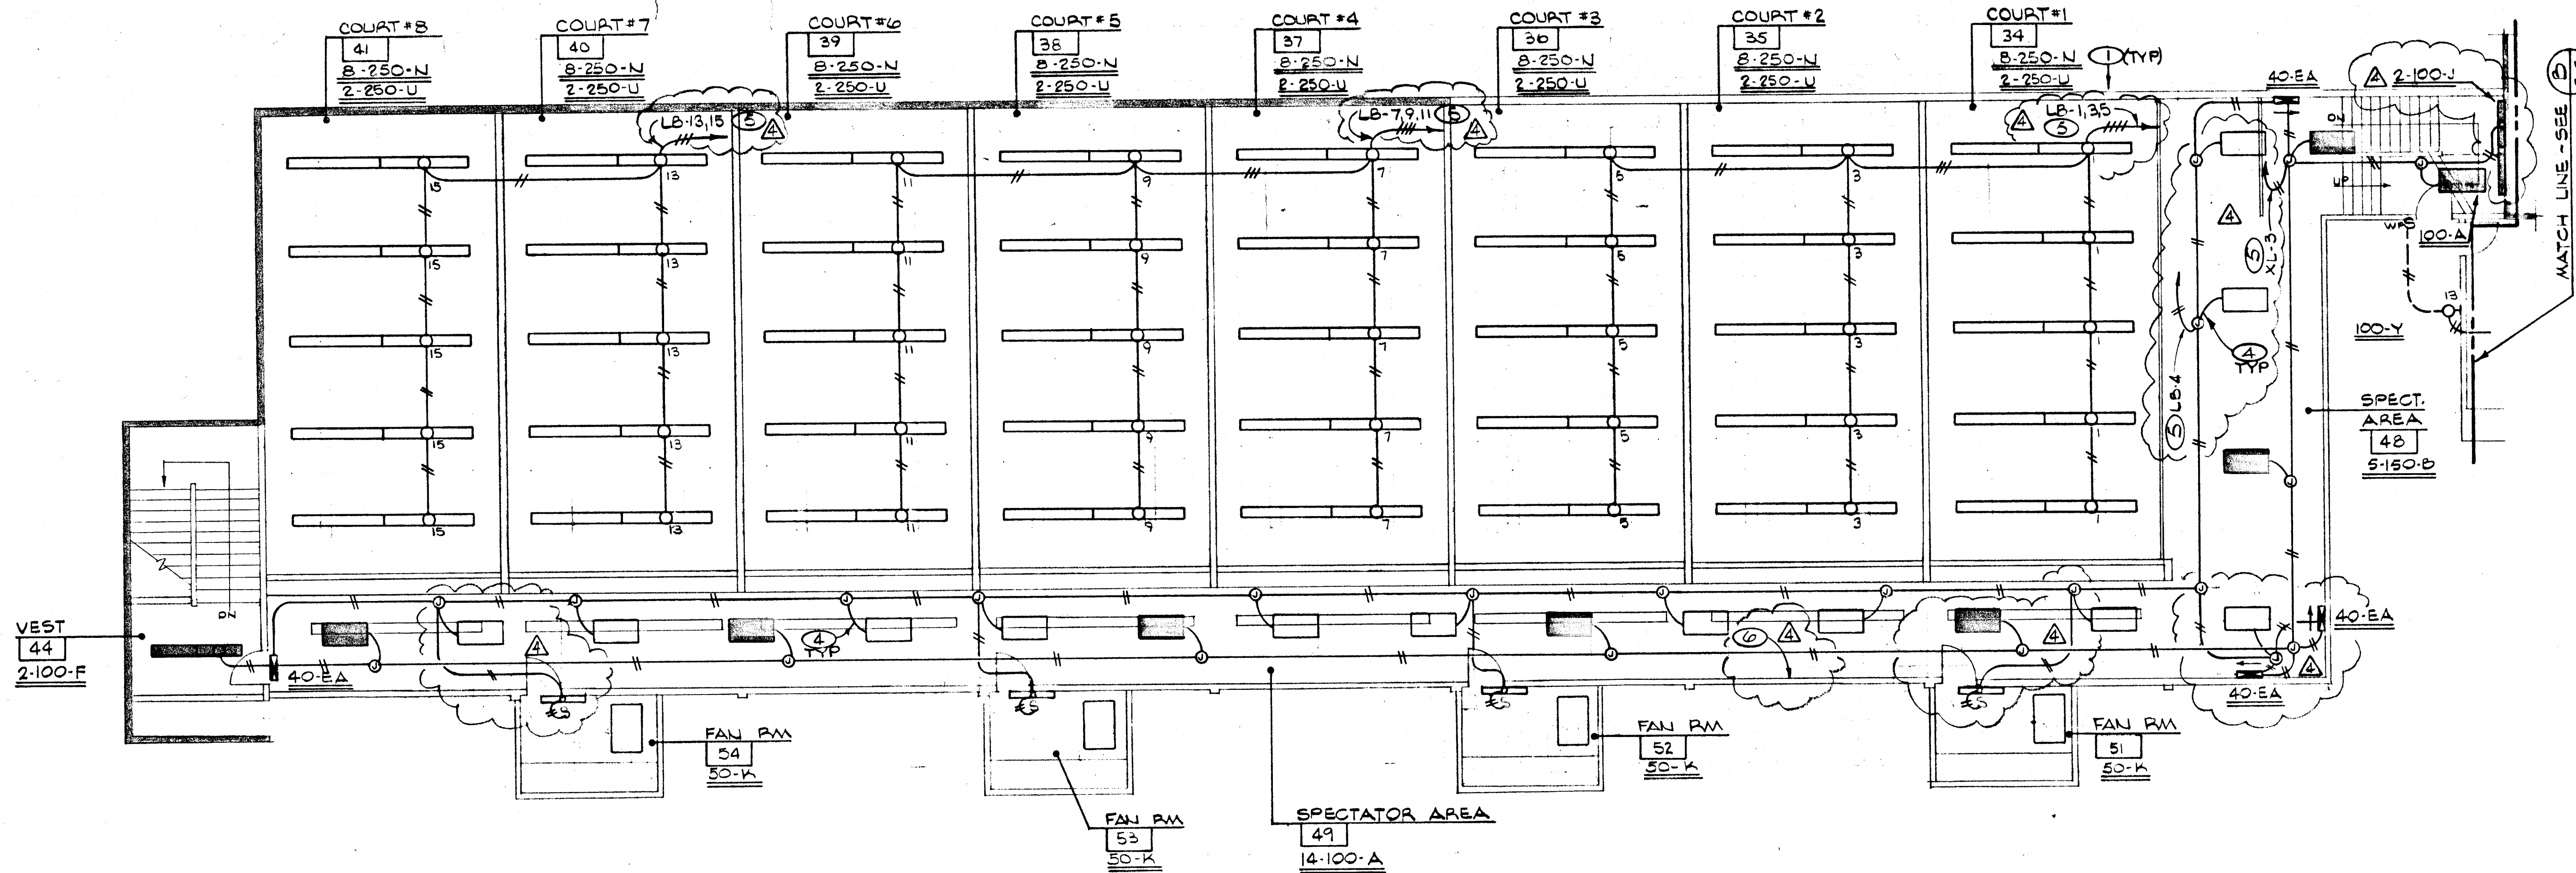




LIGHTING PART PLAN - MEZZANINE (B) E-4

NOTES (THIS SHEET ONLY)

- SEE ARCH. REFLECTED CLG. PLAN FOR EXACT LOCATION OF FIXTURES.
- COORDINATE LOCATION TO CLEAR PIPING, DUCTWORK, ETC.
- VERIFY EXACT LOCATION W/ARCH. PRIOR TO ROUGH-IN.
- FINAL CONNECTIONS TO FIXTURES IN TBA TYPE CEILING SHALL BE W/1/2" FLEX & 2#12.
- THROUGH GUTTER IN MECH. RM.
- ALL J-BOXES FOR XL-3 & LB-4 ARE MOUNTED ON THIS WALL.
- ALL LUG THIS AREA TO BE HUNG FROM CHAINS AT BOTTOM OF PIPING, +12' WHERE NO PIPING EXISTS.

STEWART-WAGNER RECREATION CENTER
FOR THE CITY OF LAS VEGAS
LAS VEGAS, NEVADA

LIGHTING PART PLANS

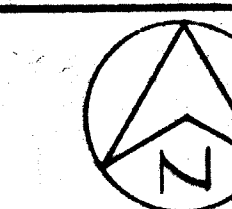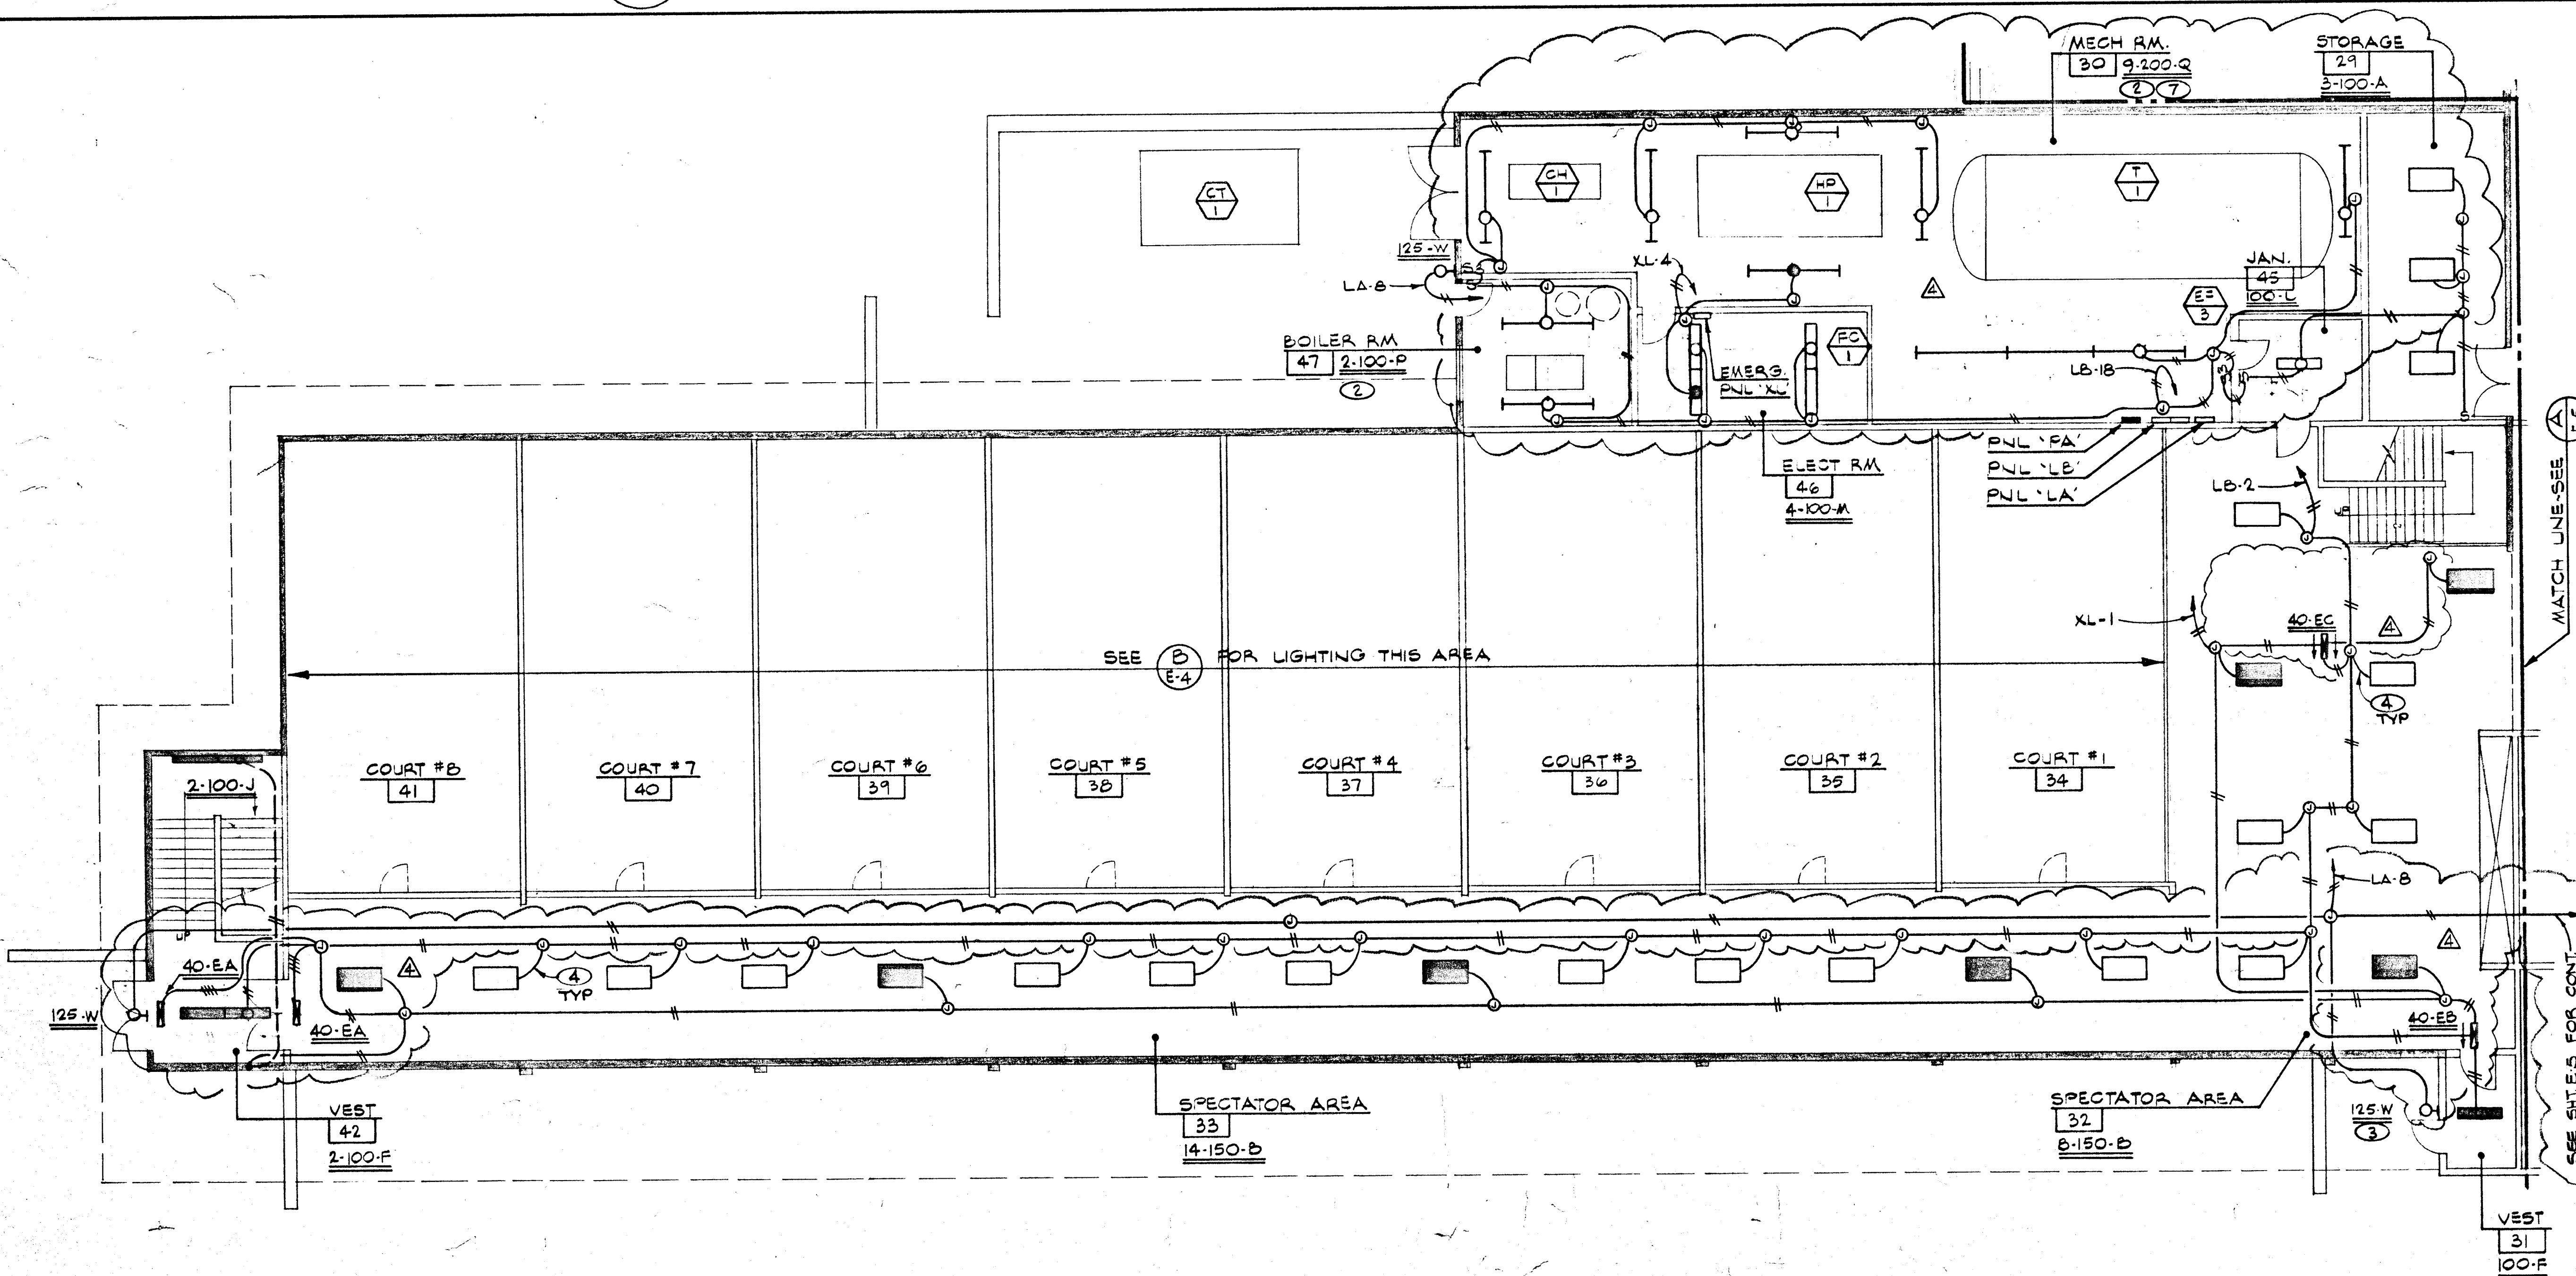

LIGHTING PART PLAN - FIRST FLOOR (A) E-4

AS BUILT

BY
G.G.
O.O.
1-00-12

LEO F. BURNS

a.i.a. architect 1009 casino center boulevard south las vegas, nevada 89101 phone 384-1185

E-4

671-436