


NOTES

- 1 RECEPTACLE FOR EWC, COORDINATE ROUGH-IN & LOCATION HEIGHT WITH DIVISION 15. PROVIDE CORD & PLUG SET.
- 2 CONNECT TO MODULAR FURNITURE. COORDINATE CONNECTION REQUIREMENTS WITH FURNITURE VENDOR.
- 3 TRAPEZE HANG IN CEILING SPACE. PROVIDE STRUCTURAL SUPPORT BETWEEN BEAMS TO HOLD TRAPEZE.
- 4 1 1/4"-4 #10, 1 #8 NEUTRAL, 1 #10 NEUTRAL, 1 #10 GRND AND 1 #10 ISO GRND.
- 5 EQUIPMENT LOCATED ON ROOF.
- 6 30A, 125V, NEMA L5-30R.
- 7 INSTALL 8" ABOVE COUNTERTOP.
- 8 P&S #44 PORCELAIN LAMP SOCKET WITH 100W A-19.
- 9 CONNECT TO COMBINATION FIRE/SMOKE DAMPER, COORDINATE WITH DIVISION 15.
- 10 INSTALL INSIDE CABINET.
- 11 VARIABLE SPEED SWITCH FURNISHED UNDER DIVISION 15, INSTALLED AND WIRED UNDER DIVISION 16.
- 12 CONNECT TO DOOR HARDWARE POWER SUPPLIES COORDINATE WITH DIVISION 8.

**OFFICE ADMINISTRATION - BUILDING A
SECOND FLOOR PLAN - AREA 1 - POWER**

SCALE: 1/8" = 1'-0"

997AFLR1

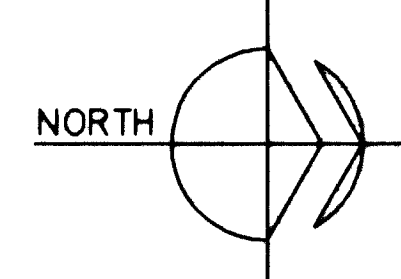


P:\STEWARTS BUILT STEWART AVE PARKING GARAGE\DRAWINGS\ELECTRICAL\STW2002.dwg, 12/20/02 03:03:35 PM, mrogh

52019

RECORD DRAWINGS
DECEMBER 20, 2002

**STEWART AVENUE
PARKING GARAGE**

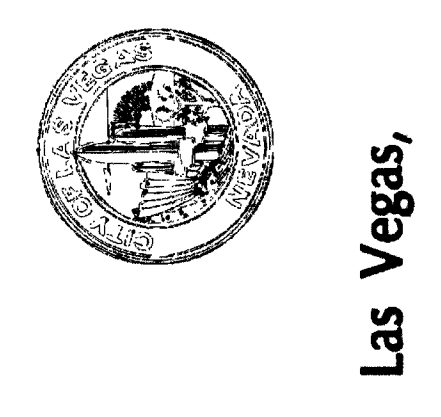

Las Vegas, Nevada



470 S. DECATUR BLVD. STE. B-4
LAS VEGAS, NEVADA 89103 USA
WWW.IGA-ARCHITECTS.COM
TELEPHONE 702.367.6000
FACSIMILE 702.367.3043

- CONSULTANTS**
- ONE
PODGENEY
DESIGN GROUP
PHONE 702-89-0888
 - LANDSCAPE
SOUTHWICK
AND ASSOCIATES
PHONE 702-89-0881
 - ELECTRICAL
BROTHER PRINCE
ASSOCIATES
PHONE 702-89-0888
 - MECHANICAL / ELECTRICAL / PLUMBING
BA
CONSULTING ENGINEERS
PHONE 702-89-0888
 - WORKSHEET CONSULTING
SHERI NELSON
& WELLS, P.C.
PHONE 89-99-0888
 - INTERIOR CONSULTING
INTERPARK
DESIGN
PHONE 702-89-0888

PROJECT:
STEWART AVENUE
127-V-3338

SHEET CONTENTS:
**BUILDING A
SECOND FLOOR PLAN
AREA 1 - POWER**
/ 87

DATE:
MARCH 21, 2002

JOB NO.:
99997.00

SHEET:
E2.12