
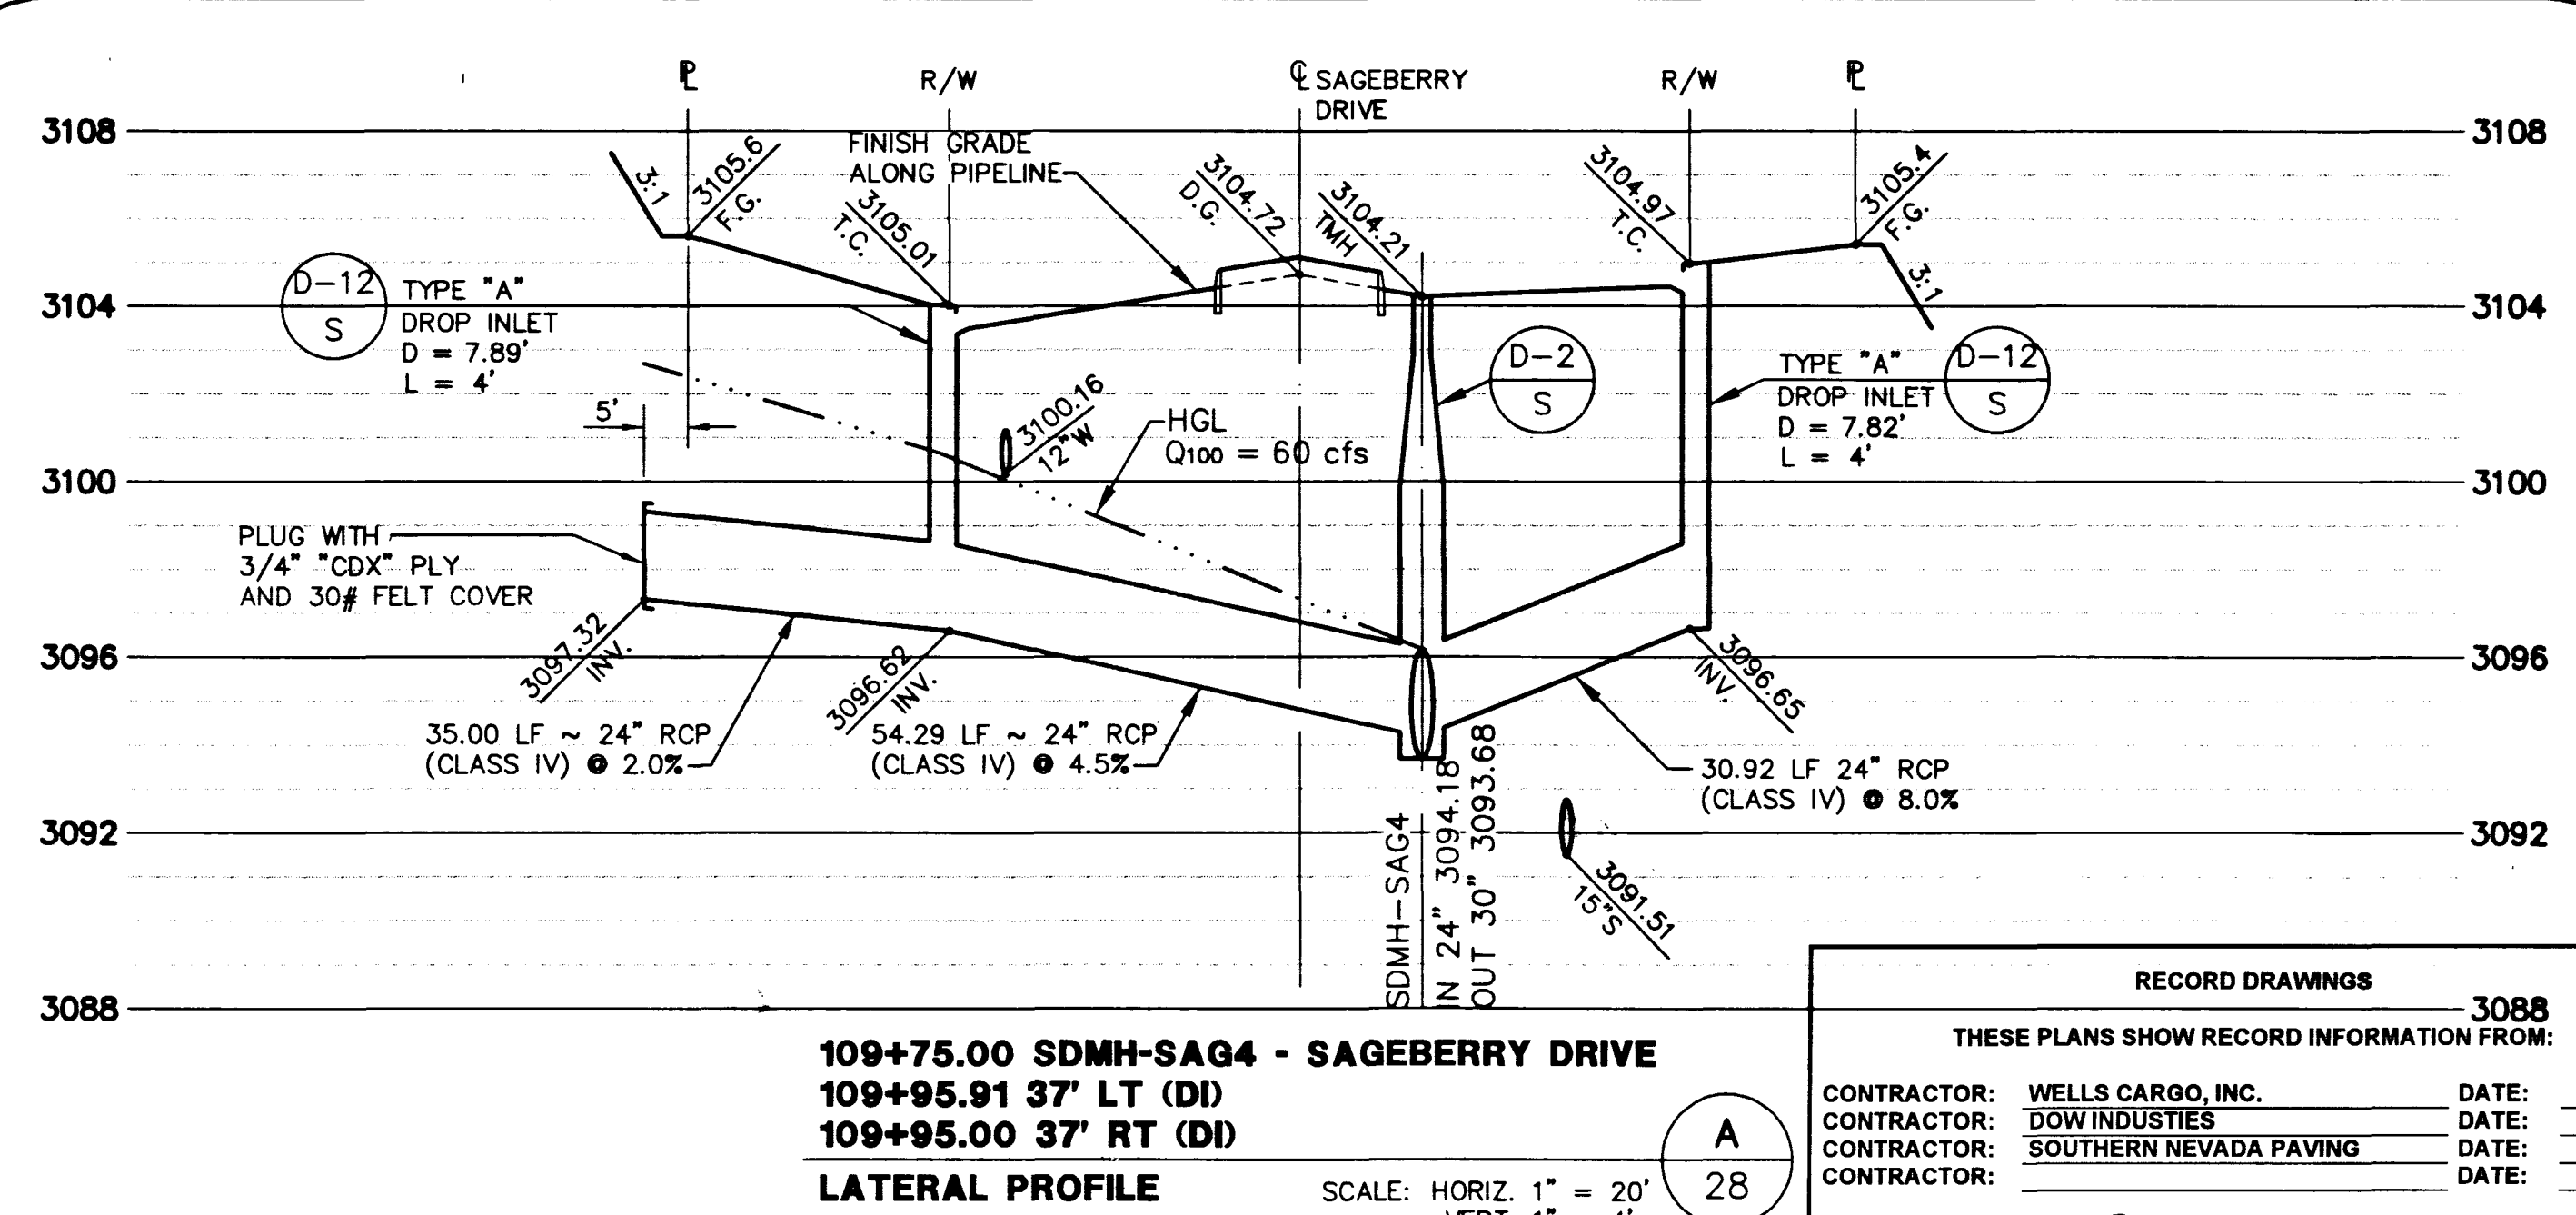
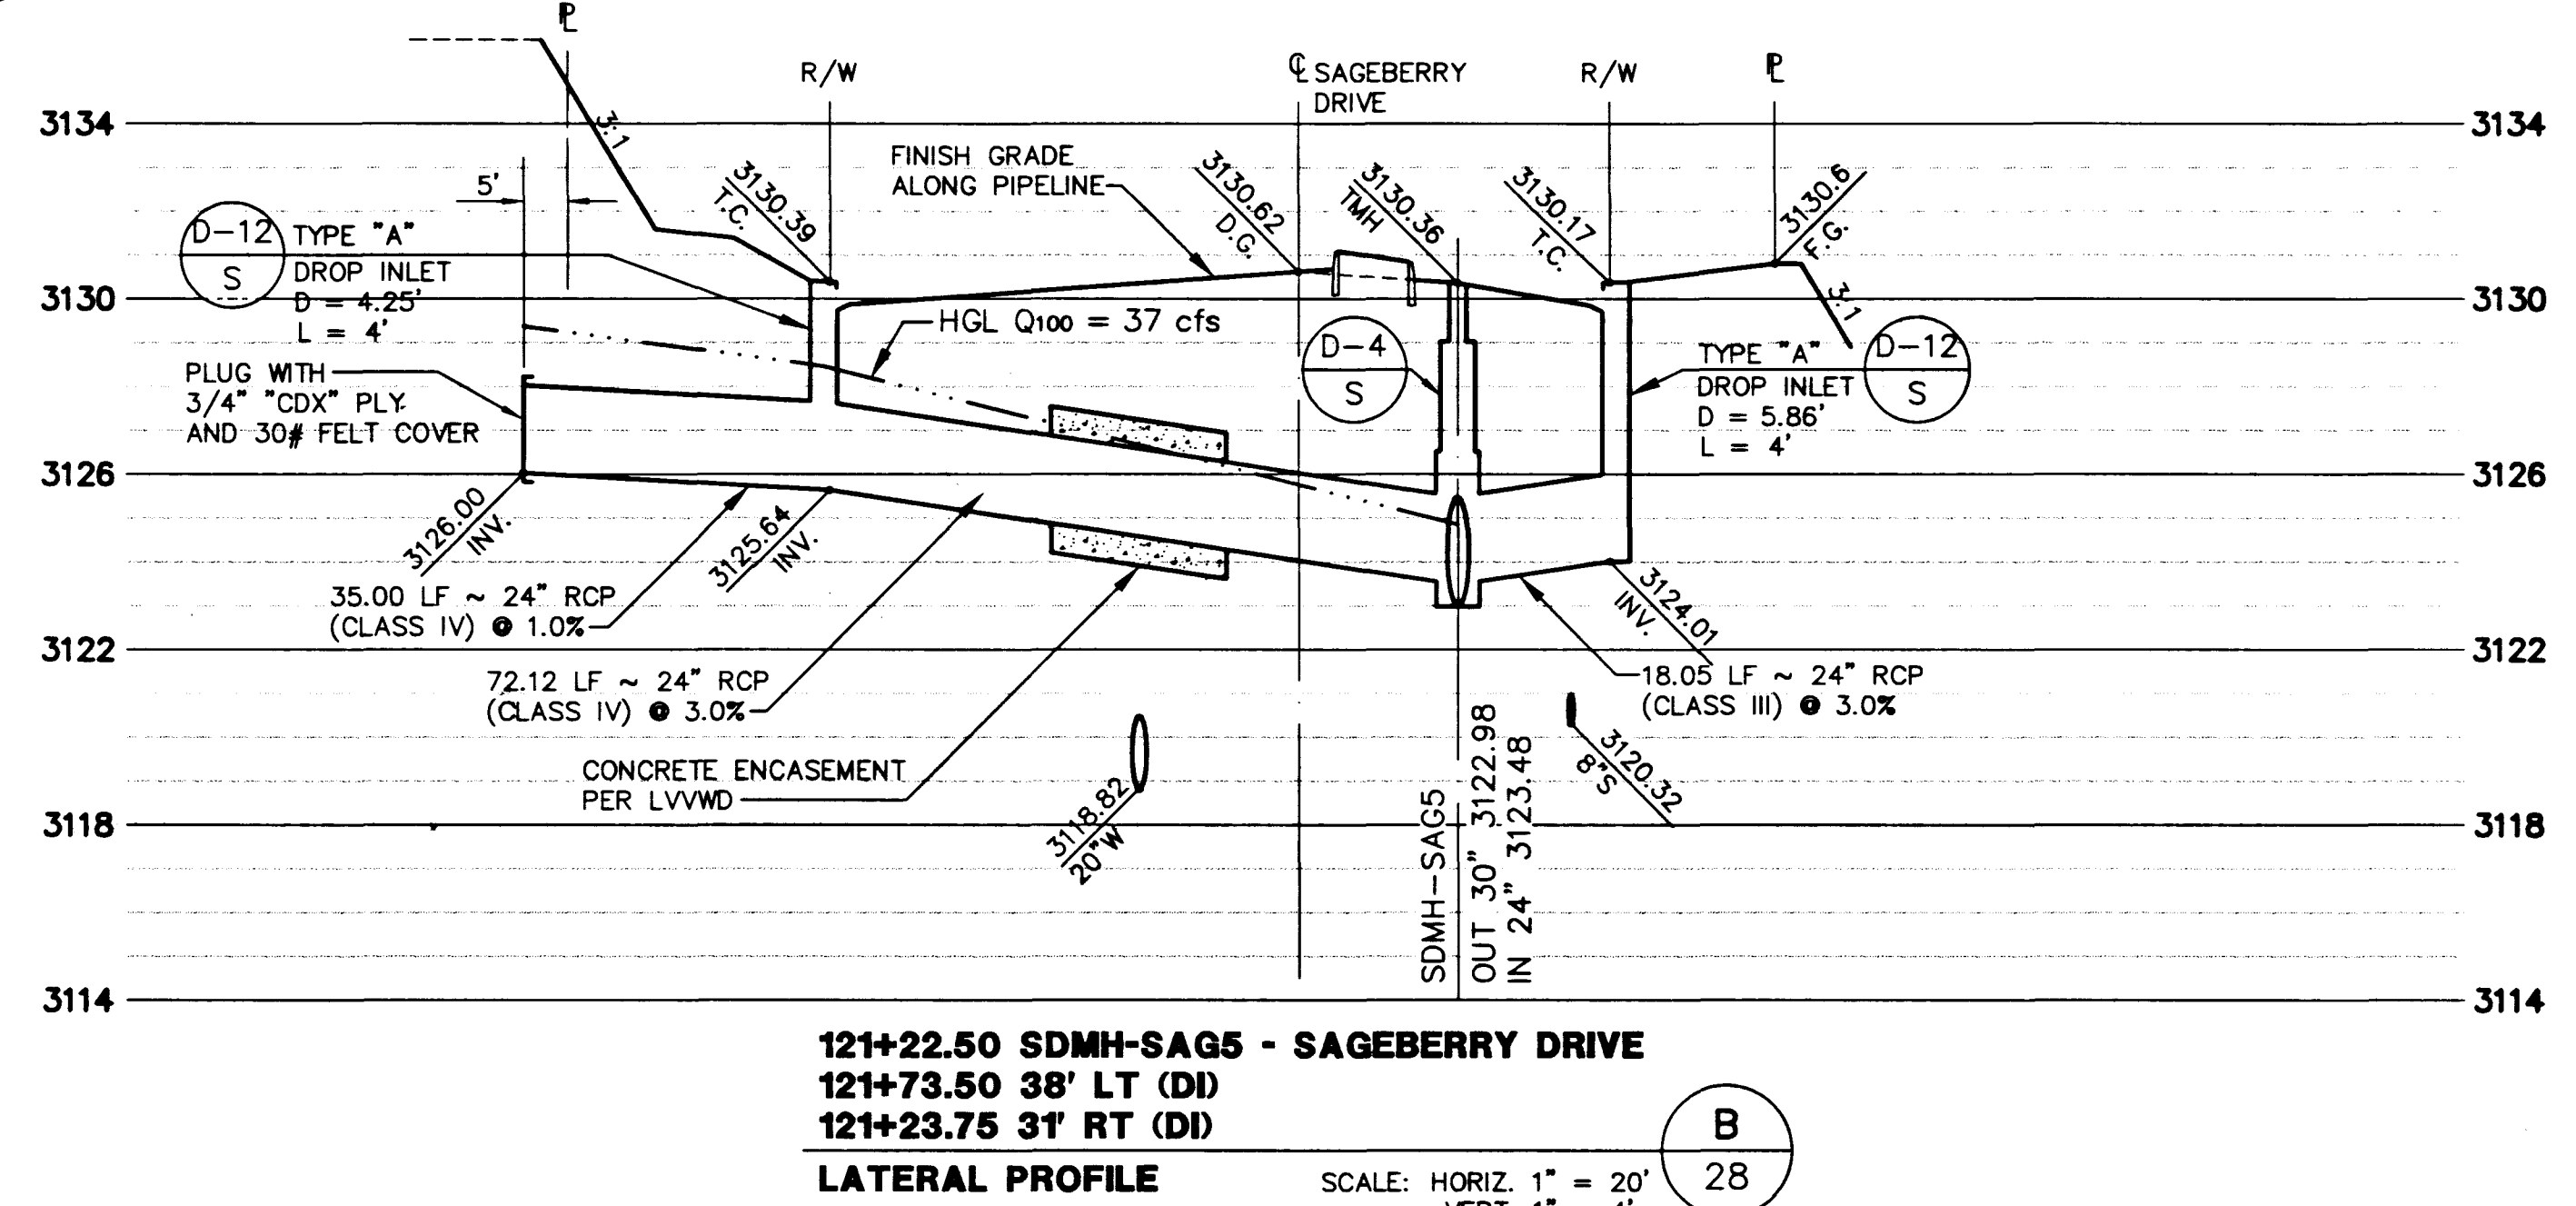
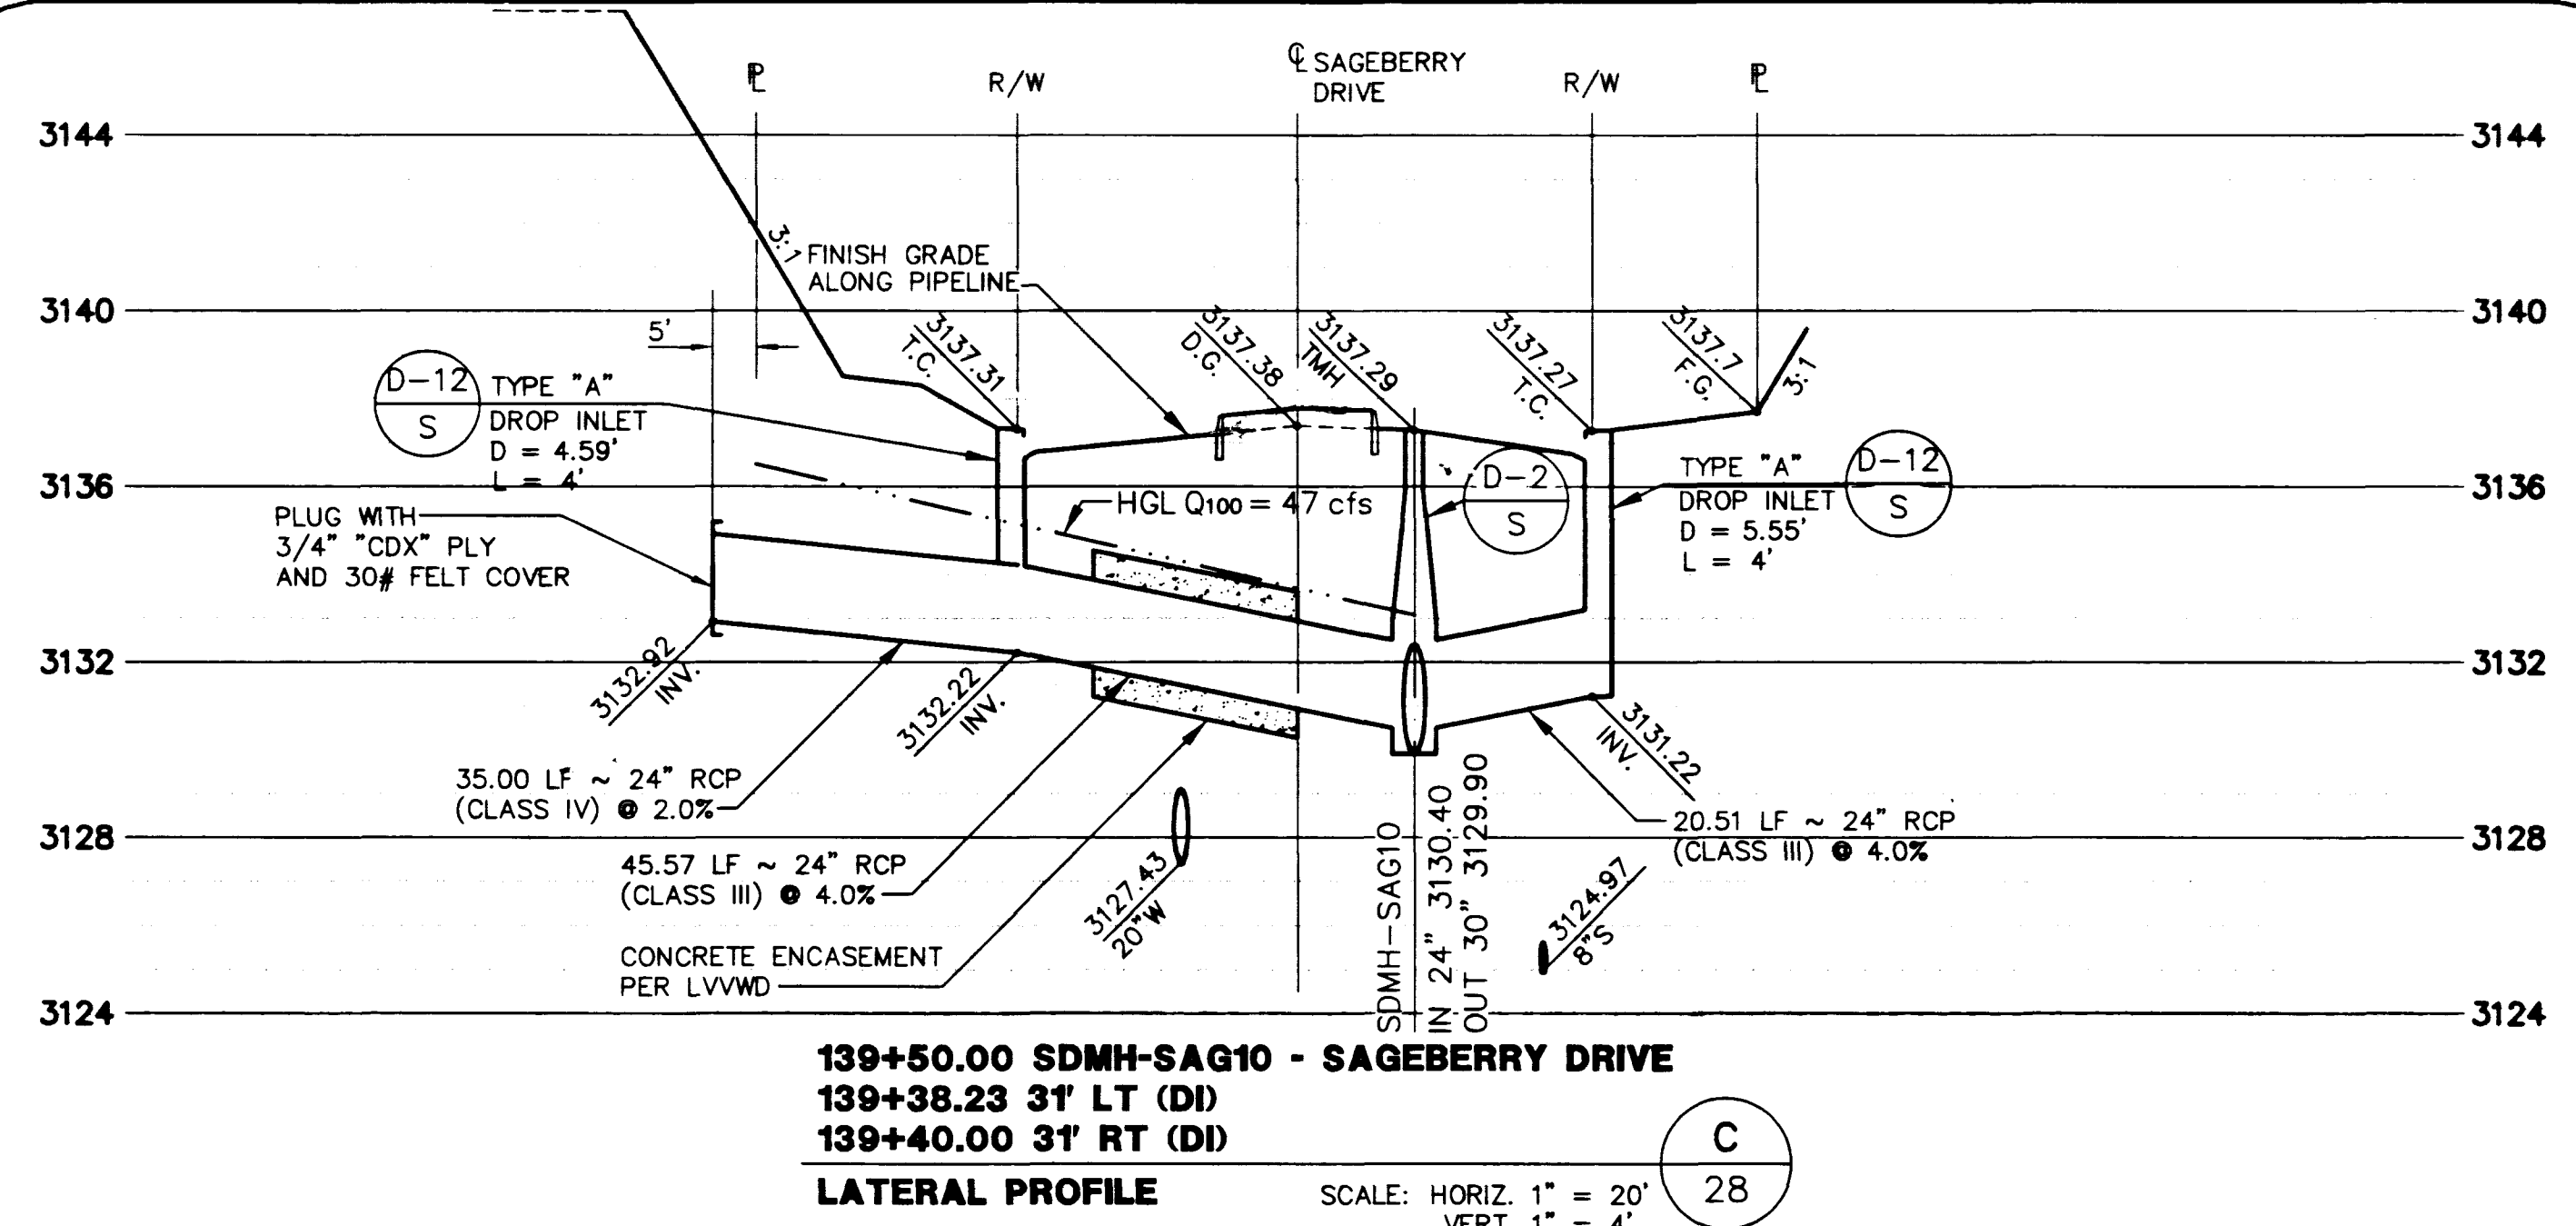
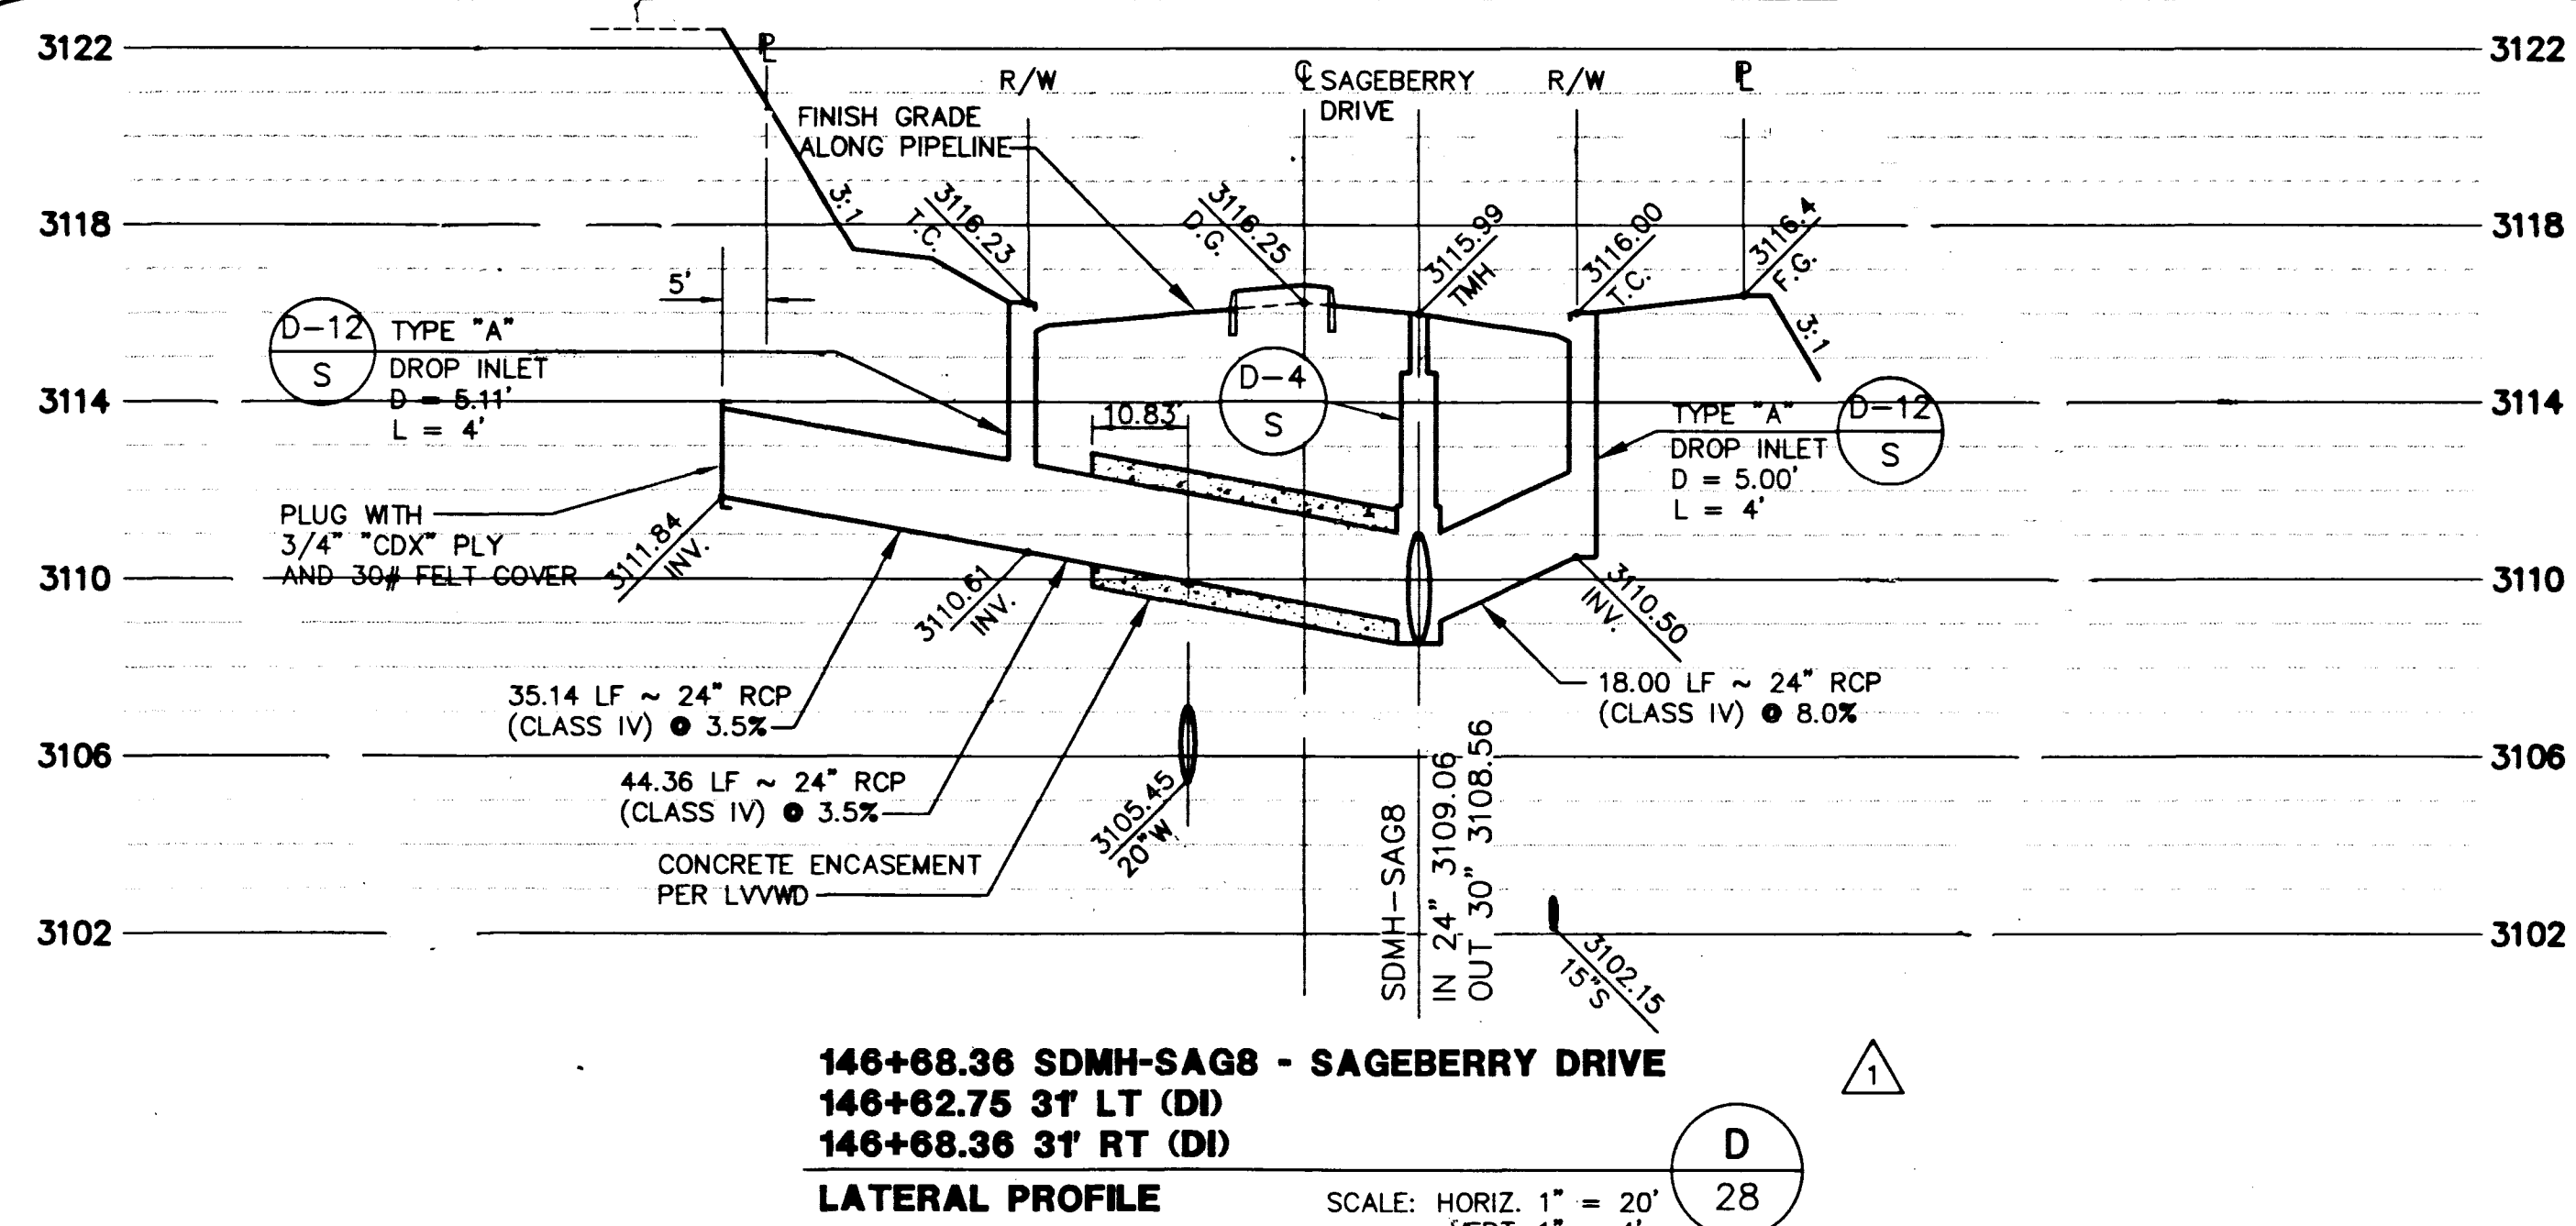


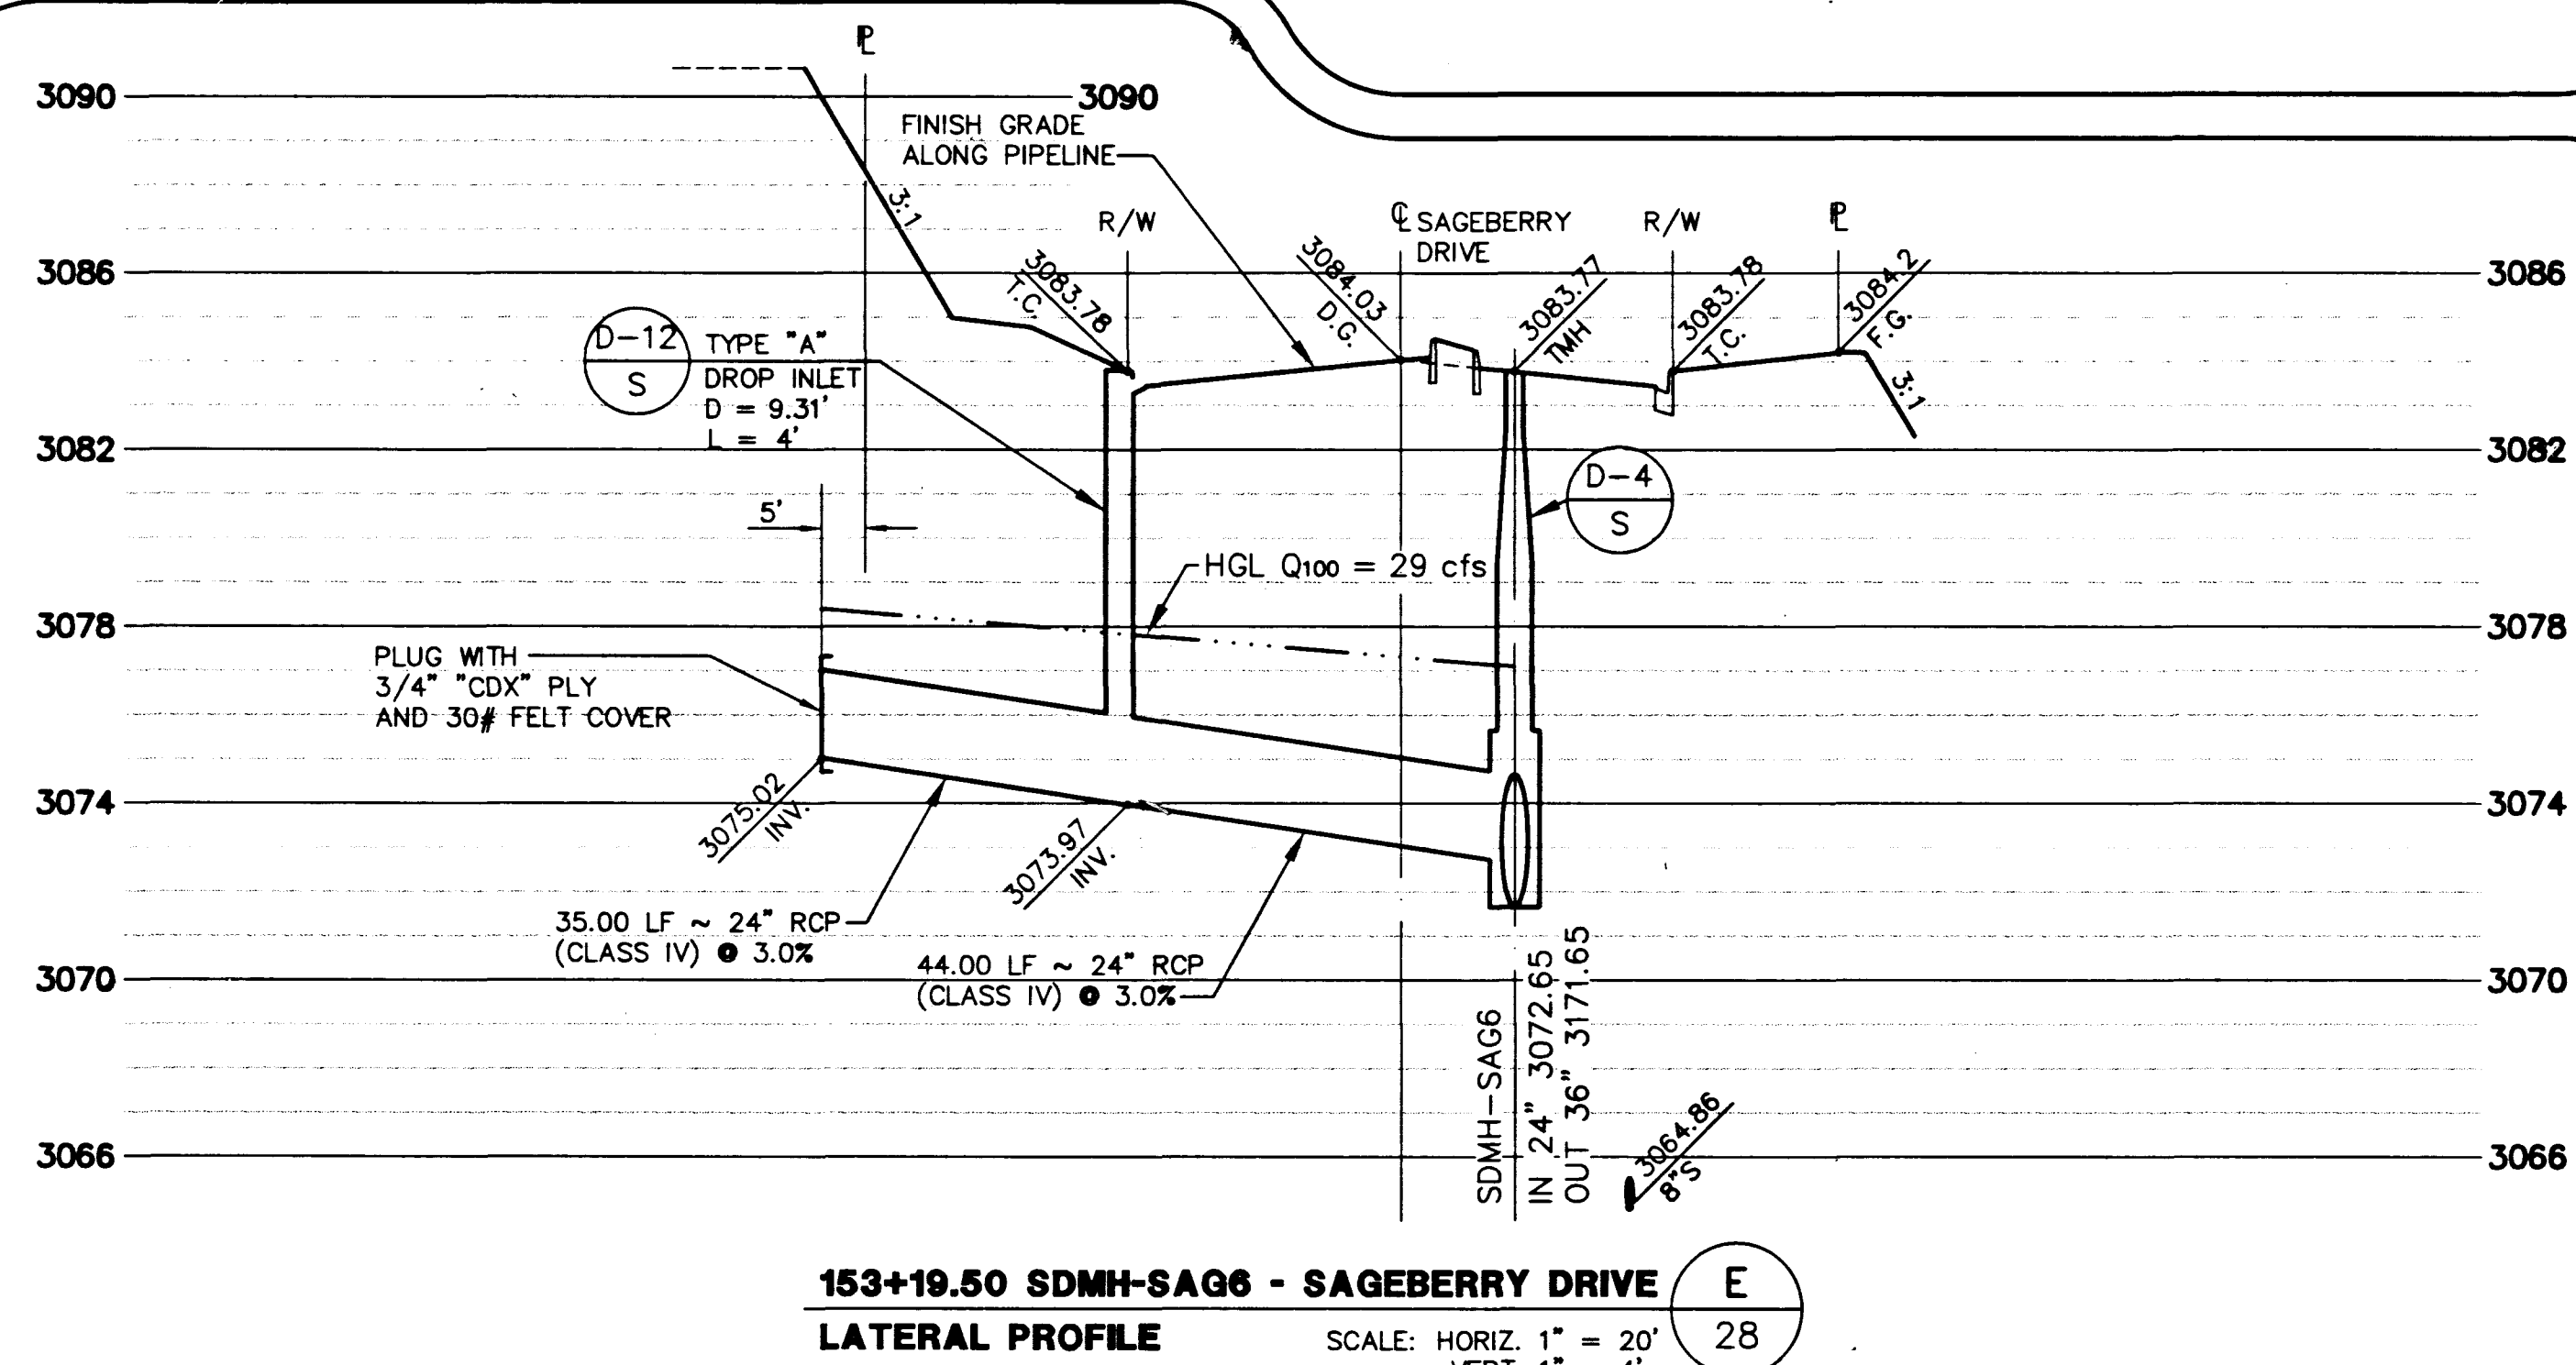

RECORD DRAWINGS	
THESE PLANS SHOW RECORD INFORMATION FROM:	
CONTRACTOR: WELLS CARGO, INC.	DATE: 04/23/98
CONTRACTOR: DOW INDUSTRIES	DATE: 04/09/98
CONTRACTOR: SOUTHERN NEVADA PAVING	DATE: 04/21/98
CONTRACTOR:	DATE:

THIS DATA MAY OR MAY NOT REFLECT THE ACTUAL FIELD LOCATIONS. ALL DATA SHOULD BE CONFIRMED PRIOR TO USE ON DEVELOPMENT OR ENGINEERING PLANS.

SUMMERLIN

VILLAGE 11/12 THE ARBORS-UNIT 3A-B

SAGEBERRY DRIVE

STORM DRAIN LATERALS

RECOMMENDED

CHARTERED PROFESSIONAL ENGINEER

STATE OF NEVADA

REGISTERED

NO. 5071

DATE

28

SHEET

28

SHT 28 OF 43



STANDARD FOR THE ARMY-SIGNAL CORPS
SYMBOLS AND LATERALS

