


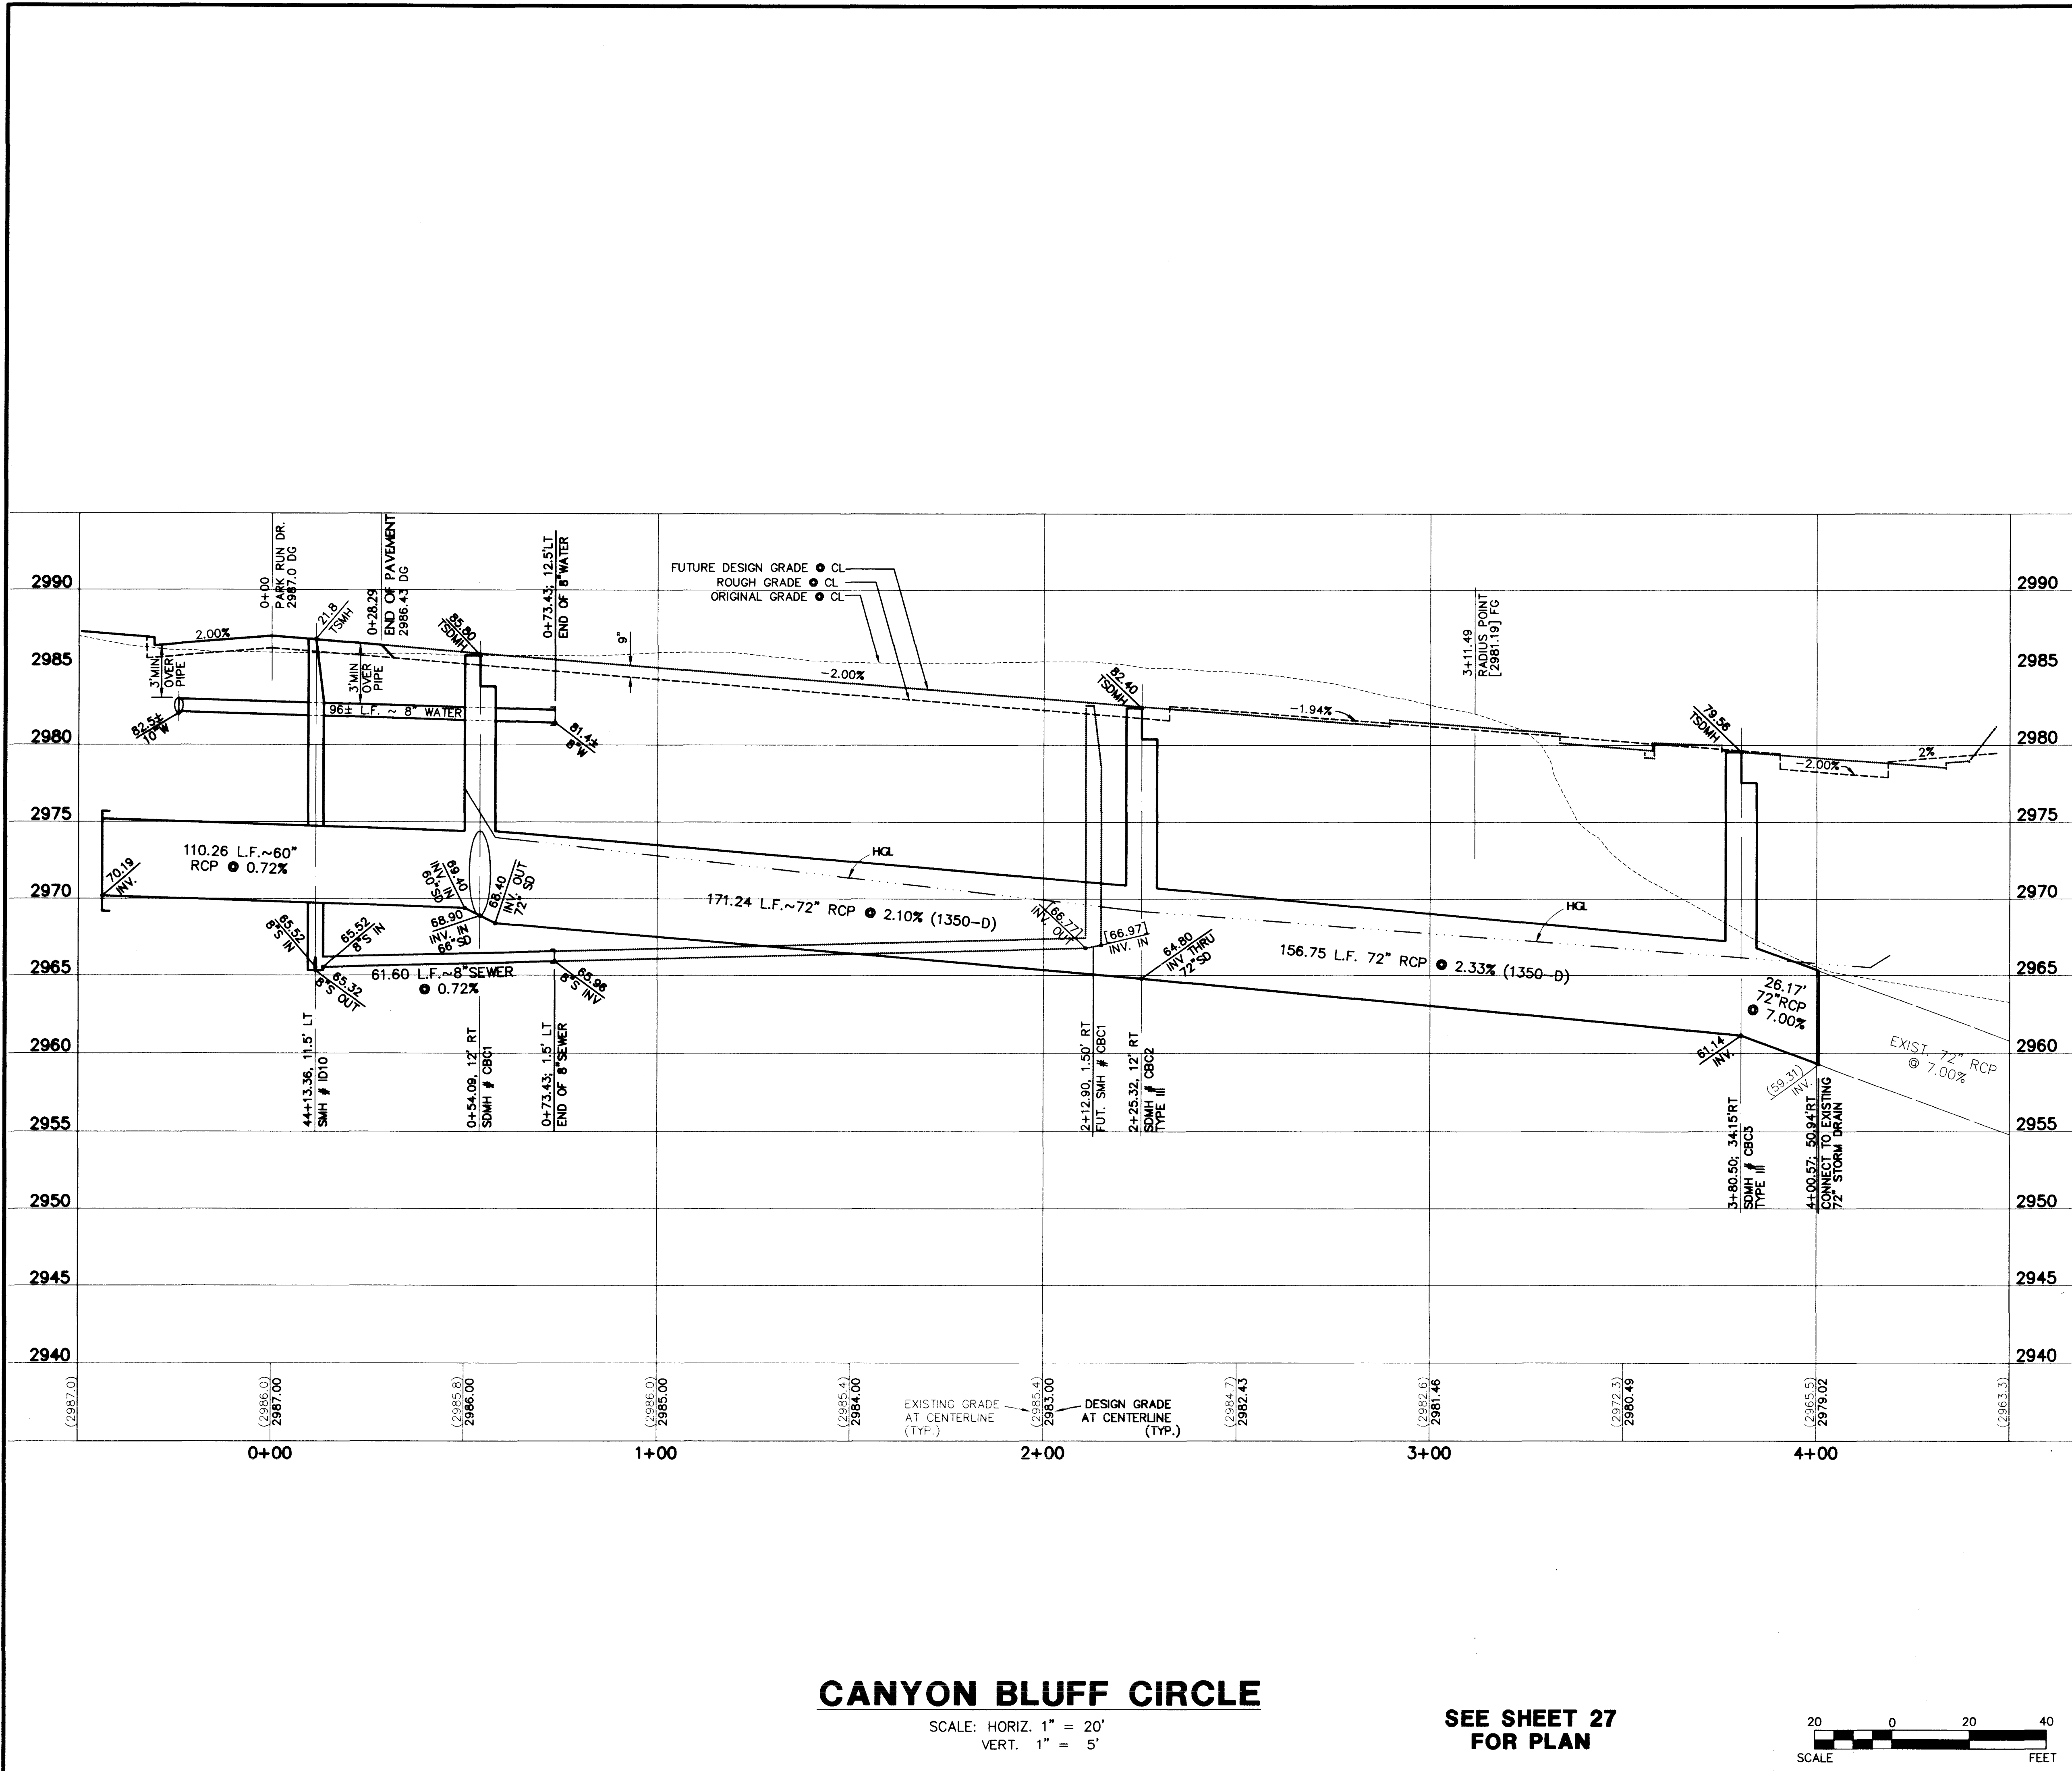

RECORD DRAWINGS

THESE PLANS SHOW RECORD INFORMATION FROM:

CONTRACTOR: DOW INDUSTRIES (UNDERGROUND UTILITIES) DATE: 07/10/98

CONTRACTOR: DATE:

CONTRACTOR: DATE:

CONTRACTOR: DATE:

THIS DATA MAY OR MAY NOT REFLECT THE ACTUAL FIELD LOCATIONS. ALL DATA SHOULD BE CONFIRMED PRIOR TO USE ON DEVELOPMENT OR ENGINEERING PLANS.

NOTE TO CONTRACTOR:

- ALL EXISTING UTILITY CROSSINGS MUST BE VERIFIED PRIOR TO CONSTRUCTION OF ANY MAIN LINES OR LATERALS THAT MAY BE ADVERSELY EFFECTED. ANY DISCREPANCIES IN LOCATION AND/OR ELEVATION MUST BE PROVIDED TO THE ENGINEER FOR ACCEPTANCE PRIOR TO CONSTRUCTION.
- TOPOGRAPHY SHOWN HEREIN REFLECTS ORIGINAL EXISTING TOPOGRAPHY. ACTUAL FIELD CONDITIONS INCLUDE SITE ROUGH GRADING.
- ALL COMMON LOTS AS SHOWN HEREIN TO BE PRIVATELY MAINTAINED BY THE H.O.A.
- ALL WATER LINE GATE VALVES, SERVICE GATE VALVES, AND FIRE HYDRANT GATE VALVES ARE TO BE CONSTRUCTED UNDER A.C. PAVEMENT. IT IS THE CONTRACTORS RESPONSIBILITY TO VERIFY THAT ALL WATER VALVES CANS DO NOT CREATE CONFLICTS WITH THE PROPOSED CURB LINE PRIOR TO PLACEMENT OF CONCRETE. ALL WATER FACILITIES SHOWN IN THESE DRAWINGS HAVE BEEN "SCALED-UP" FOR CLARITY ONLY.

APPROVAL:

1st Approval 2/29/97

[Signature] 4/18/99

LAS VEGAS VALLEY WATER DISTRICT DATE

SHEET INDEX MAP

VILLAGE 12 UNIT 2C IMPROVEMENTS

CANYON BLUFF CIRCLE

STA 0+00 TO END

SHEET 28

JOB NO. 62011.214

RECOMMENDED

BERT A. HUGHES

10259

P.E. NO. 10259

DATE 7/10/98

REV. DATE

DESCRIPTION

DATE LAGEN. APP. DATE GCW APP

100% SUBMITTAL 02-05-97

