

LEGEND:

- REMOVE AND REPLACE FULL-DEPTH AC PATCH
- DENSE GRADE MILL AND OVERLAY


REMOVAL ITEMS:

- A** MATCHLINE, NEW A.C. TO MATCH EXISTING
- B** REMOVE EXISTING TRAFFIC DELINEATION, MARKINGS AND SYMBOLS
- C** REMOVE EXISTING ASPHALT
- D** MILL EXISTING 2.5" AC
- E** REMOVE AND SALVAGE SIGN

CONSTRUCTION ITEMS:

- 1** CONSTRUCT ASPHALT PATCH TO MATCH EXISTING DEPTH
- 2** CONSTRUCT 2.5" OVERLAY
- 3** 6" SOLID YELLOW LINE (EPOXY)
- 4** 6" SOLID WHITE LINE (EPOXY)
- 5** 12" SOLID WHITE LINE (EPOXY)
- 6** TYPE 4 LANE LINE (RPM) (USDCCA STD. NO. 244A)
- 7** DROP LANE LINE (RPM) (USDCCA STD. NO. 246A)
- 8** WHITE PAVEMENT ARROW (PMF-TYPE II)
- 9** REFRESH TYPE 4 LANE LINE (RPM) (USDCCA STD. DWG. NO. 244A)
- 10** INSTALL NEW SIGN(S)
- 11** RELOCATE EXISTING SIGN(S)
- 12** EXISTING TO REMAIN IN PLACE
- 13** 24" WHITE STOP LINE (PMF-TYPE I)
- 14** STORAGE LANE LINE (RPM) (STD. DWG. NO. 246)
- 15** WHITE PAVEMENT "ONLY" (PMF-TYPE I)

RECORD DRAWINGS
 RECORD DRAWINGS COMPLETED: 10/9/08
 BY: G. C. WALLACE, INC.
 PROJECT FINAL COMPLETION: 06/08
 CONTRACTOR: SOUTHERN NEVADA PAVING
 CONSTRUCTION MANAGER: CITY OF LAS VEGAS
 THESE DRAWINGS HAVE BEEN ALTERED TO INDICATE AS-BUILT INFORMATION AS PROVIDED BY THE CONSTRUCTION CONTRACTOR. THIS DATA MAY NOT REFLECT ACTUAL FIELD CONDITIONS. ALL DATA SHOULD BE CONFIRMED PRIOR TO INCLUSION IN SUBSEQUENT PLANS.

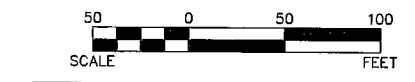

REVISIONS	DATE

SCALE (H) AS SHOWN: NONE
 F.L.D. BK. #: -
 W.A. #: -
 DESIGN BY: MDM
 DATE: 05/09/08
G. C. WALLACE COMPANIES
 ENGINEERS | PLANNERS | SURVEYORS
 1555 S. RAINBOW BOULEVARD, LAS VEGAS, NV 89146
 T: 702.804.2000 F: 702.804.2999 GCWALLACE.COM



DEPARTMENT OF FIELD OPERATIONS
 PROJECT: **SUMMERLIN PARKWAY**
CC 215 TO US 95
 SHEET: **CONSTRUCTION PLAN**
"SP" 603+50.00 TO "SP" 607+50.00

SEAL
RECORD DRAWINGS
 COVER SHEET SEALED
 5/8/08
 ENGINEER OF RECORD:
 MATTHEW D. MEYER
 P.E. No. 15790
 DATE SIGNED: _____
 DRAWING NO.
C-10
 15

113856

10725135