

RECORD DRAWINGS
 RECORD DRAWINGS COMPLETED: 10/9/08
 BY G. C. WALLACE, INC.
 PROJECT FINAL COMPLETION: 06/08
 CONTRACTOR: SOUTHERN NEVADA PAVING
 CONSTRUCTION MANAGER: CITY OF LAS VEGAS
 THESE DRAWINGS HAVE BEEN ALTERED TO INDICATE AS-BUILT INFORMATION AS PROVIDED BY THE CONSTRUCTION CONTRACTOR. THIS DATA MAY NOT REFLECT ACTUAL FIELD CONDITIONS. ALL DATA SHOULD BE CONFIRMED PRIOR TO INCLUSION IN SUBSEQUENT PLANS.

REVISIONS	DATE


SCALE (H): 1:100
 SCALE (V): N/A
 W.A. #: 412-651
 DATE: 05/09/08
 DESIGN BY:
G.C. WALLACE COMPANIES
 ENGINEERS | PLANNERS | SURVEYORS
 450 ANDREWS BOULEVARD, LAS VEGAS, NV 89166
 P: 702.699.8800 F: 702.699.8225 GCWALLACE.COM



DEPARTMENT OF FIELD OPERATIONS
 PROJECT:
SUMMERLIN PARKWAY
 CC 215 TO US 95

SHEET:
 HORIZONTAL CONTROL PLAN

SEAL
RECORD DRAWINGS
 COVER SHEET SEALED
 5/8/08
 ENGINEER OF RECORD:
 DANNY E. HILL
 P.L.S. No. 9389
 DATE SIGNED:
 DRAWING NO.
G-3

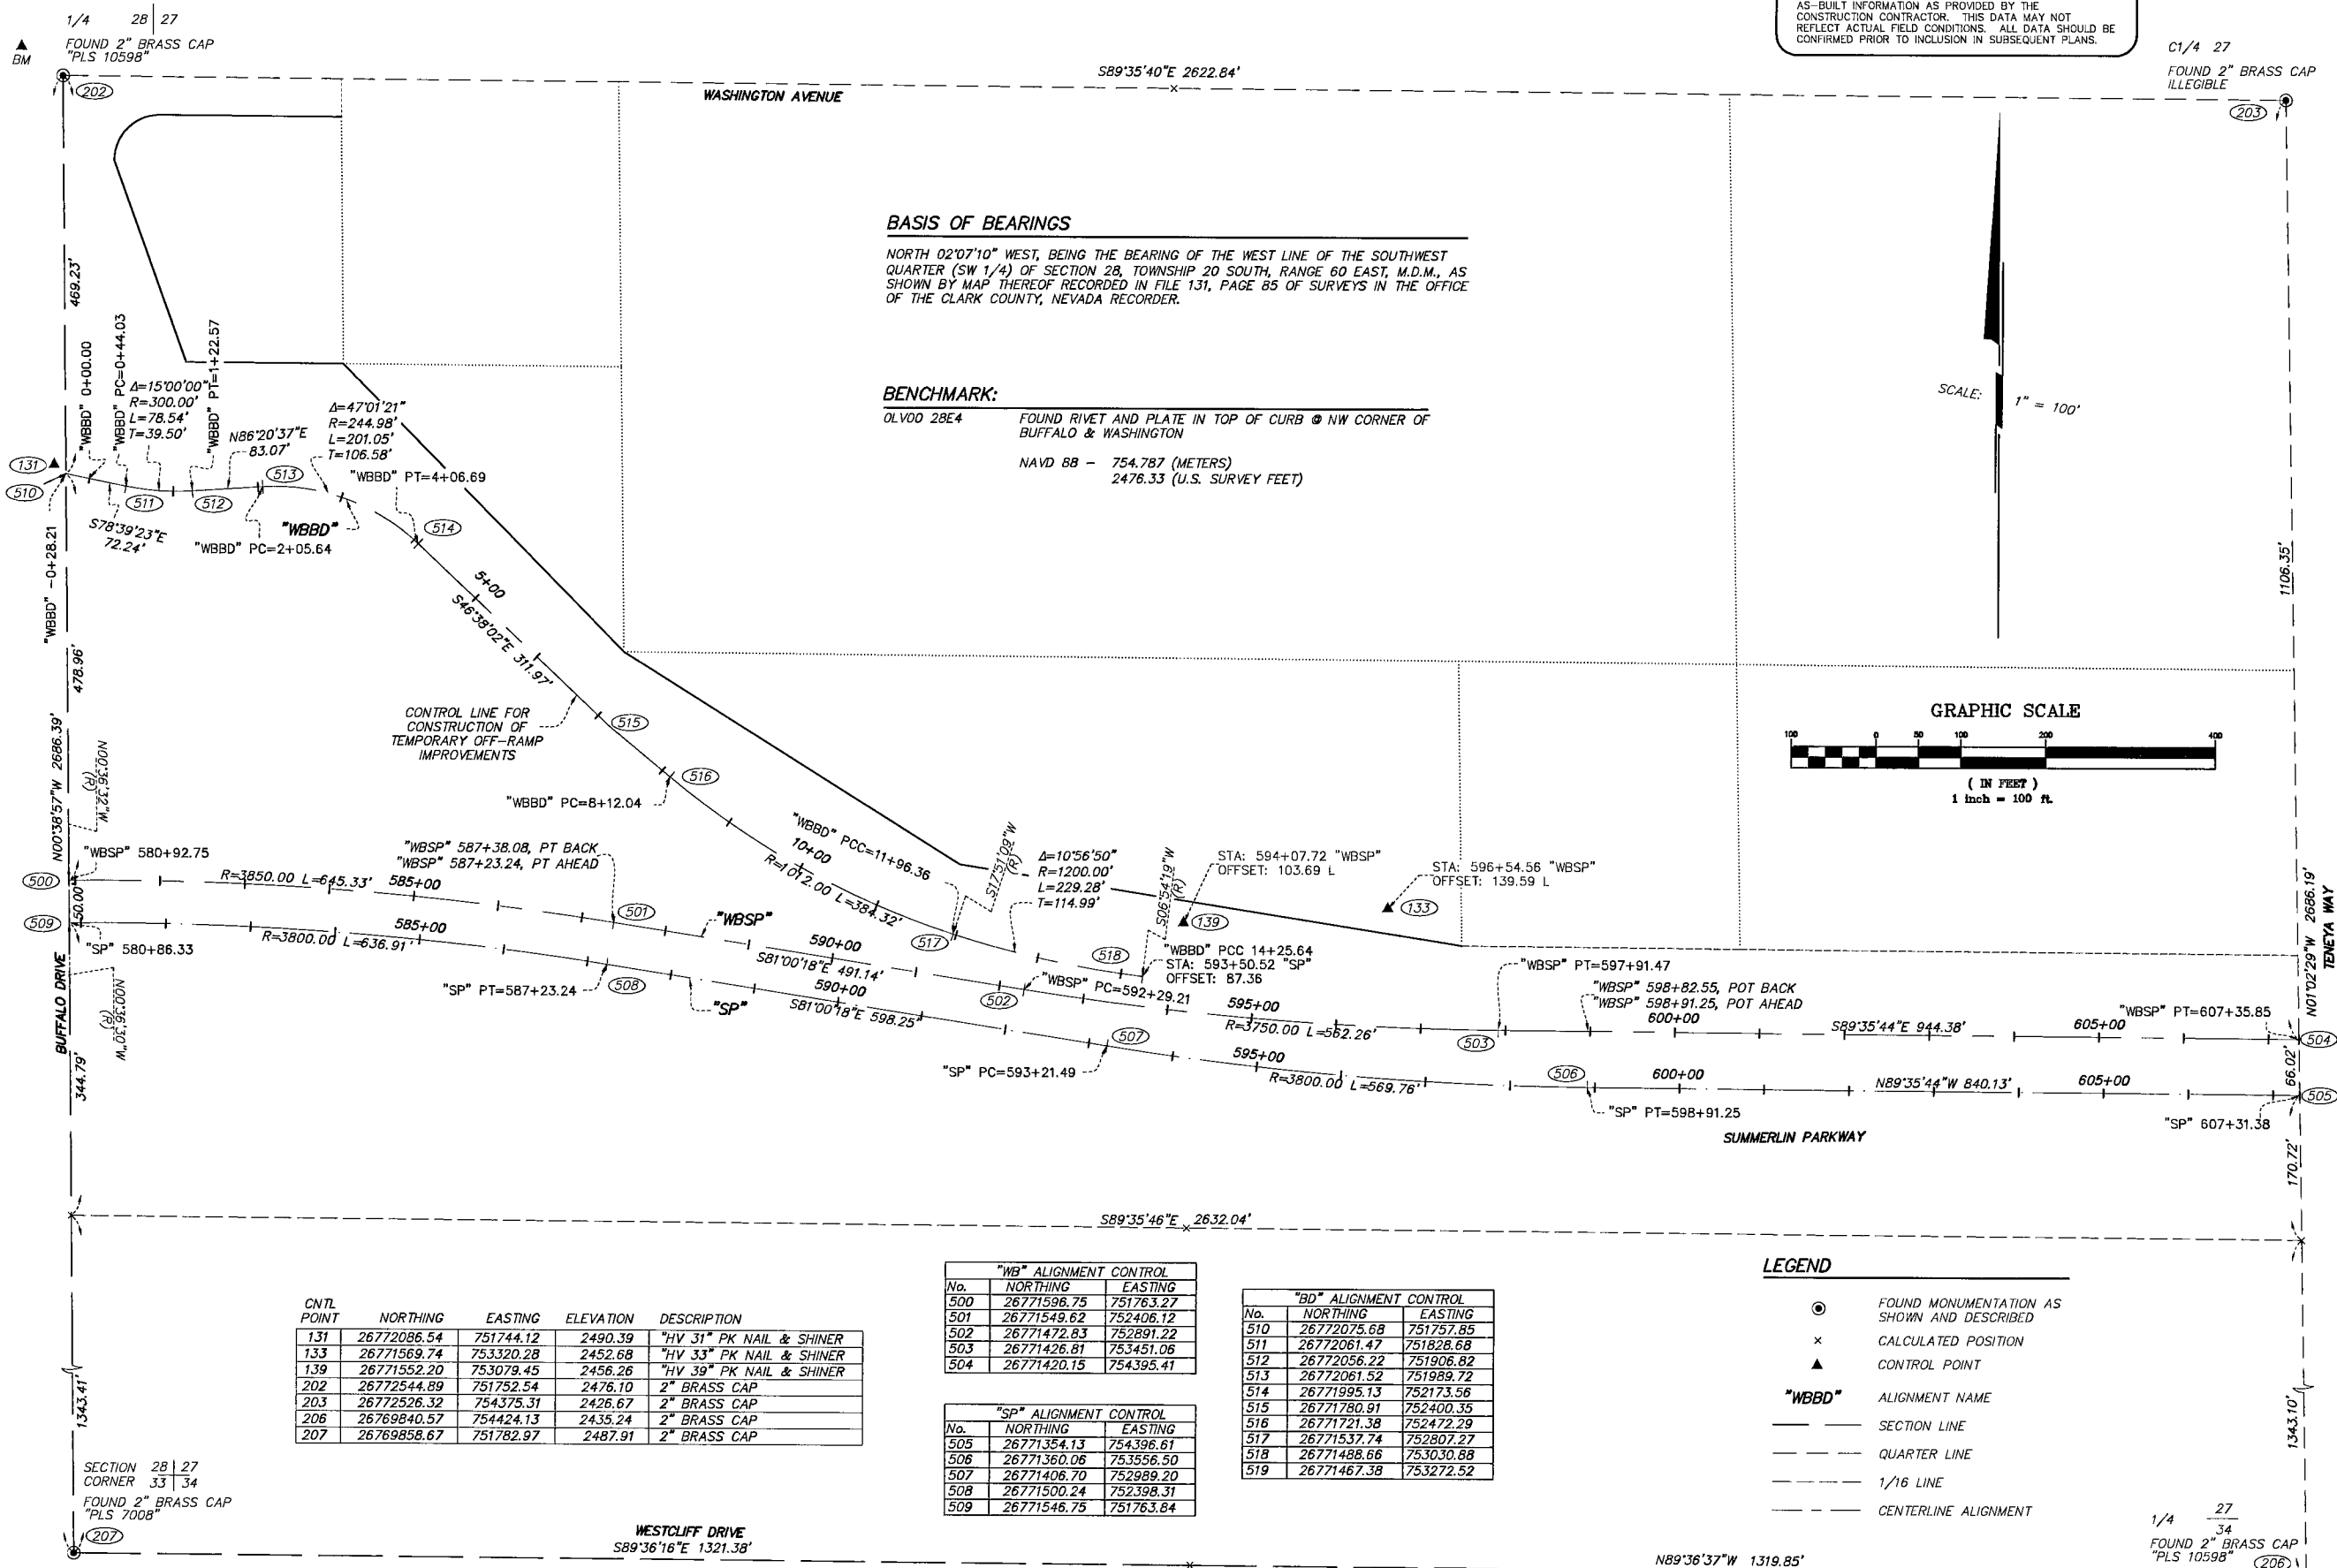

CNTL POINT	NORTHING	EASTING	ELEVATION	DESCRIPTION
131	26772086.54	751744.12	2490.39	"HV 31" PK NAIL & SHINER
133	26771569.74	753320.28	2452.68	"HV 33" PK NAIL & SHINER
139	26771552.20	753079.45	2456.26	"HV 39" PK NAIL & SHINER
202	26772544.89	751752.54	2476.10	2" BRASS CAP
203	26772526.32	754375.31	2426.67	2" BRASS CAP
206	26769840.57	754424.13	2435.24	2" BRASS CAP
207	26769858.67	751782.97	2487.91	2" BRASS CAP

"WB" ALIGNMENT CONTROL		
No.	NORTHING	EASTING
500	26771596.75	751763.27
501	26771549.62	752406.12
502	26771472.83	752891.22
503	26771426.81	753451.06
504	26771420.15	754395.41

"SP" ALIGNMENT CONTROL		
No.	NORTHING	EASTING
505	26771354.13	754396.61
506	26771360.05	753556.50
507	26771406.70	752989.20
508	26771500.24	752398.31
509	26771546.75	751763.84

"BD" ALIGNMENT CONTROL		
No.	NORTHING	EASTING
510	26772075.68	751757.85
511	26772061.47	751826.68
512	26772056.22	751906.82
513	26772061.52	751989.72
514	26771995.13	752173.56
515	26771780.91	752400.35
517	26771721.38	752472.29
518	26771537.74	752807.27
519	26771467.38	753272.52

113844

107V5135