

LEGEND:

- REMOVE AND REPLACE FULL-DEPTH AC PATCH
- DENSE GRADE MILL AND OVERLAY

RECORD DRAWINGS
 RECORD DRAWINGS COMPLETED: 10/9/08
 BY G. C. WALLACE, INC.
 PROJECT FINAL COMPLETION: 06/08
 CONTRACTOR: SOUTHERN NEVADA PAVING
 CONSTRUCTION MANAGER: CITY OF LAS VEGAS
 THESE DRAWINGS HAVE BEEN ALTERED TO INDICATE AS-BUILT INFORMATION AS PROVIDED BY THE CONSTRUCTION CONTRACTOR. THIS DATA MAY NOT REFLECT ACTUAL FIELD CONDITIONS. ALL DATA SHOULD BE CONFIRMED PRIOR TO INCLUSION IN SUBSEQUENT PLANS.


REMOVAL ITEMS:

- A** MATCHLINE, NEW A.C. TO MATCH EXISTING
- B** REMOVE EXISTING TRAFFIC DELINEATION, MARKINGS AND SYMBOLS
- C** REMOVE EXISTING ASPHALT
- D** MILL EXISTING 2.5" AC
- E** REMOVE AND SALVAGE SIGN

CONSTRUCTION ITEMS:

- 1** CONSTRUCT ASPHALT PATCH TO MATCH EXISTING DEPTH
- 2** CONSTRUCT 2.5" OVERLAY
- 3** 6" SOLID YELLOW LINE (EPOXY)
- 4** 6" SOLID WHITE LINE (EPOXY)
- 5** 12" SOLID WHITE LINE (EPOXY)
- 6** TYPE 4 LANE LINE (RPM) (USDCCA STD. NO. 244A)
- 7** DROP LANE LINE (RPM) (USDCCA STD. NO. 246A)
- 8** WHITE PAVEMENT ARROW (PMF-TYPE II)
- 9** REFRESH TYPE 4 LANE LINE (RPM) (USDCCA STD. DWG. NO. 244A)

- 10** INSTALL NEW SIGN(S)
- 11** RELOCATE EXISTING SIGN(S)
- 12** EXISTING TO REMAIN IN PLACE
- 13** 24" WHITE STOP LINE (PMF-TYPE I)
- 14** STORAGE LANE LINE (RPM) (STD. DWG. NO. 246)
- 15** WHITE PAVEMENT "ONLY" (PMF-TYPE I)

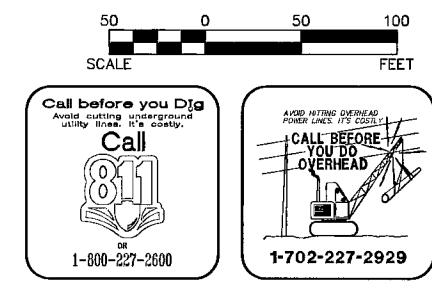

REVISIONS	DATE

SCALE (P): AS SHOWN SCALE (V): NONE W.A. # -
 FLD. BK. # - DATE: 05/09/08 DESIGN BY: MDM



DEPARTMENT OF FIELD OPERATIONS
 PROJECT: SUMMERLIN PARKWAY
 CC 215 TO US 95

CONSTRUCTION PLAN
 "SP" 403+50.00 TO "SP" 432+00.00

SEAL
RECORD DRAWINGS
 COVER SHEET SEALED
 5/8/08
 ENGINEER OF RECORD
 MATTHEW D. MEYER
 P.E. No. 15790
 DATE SIGNED: _____
 DRAWING NO.
C-3