
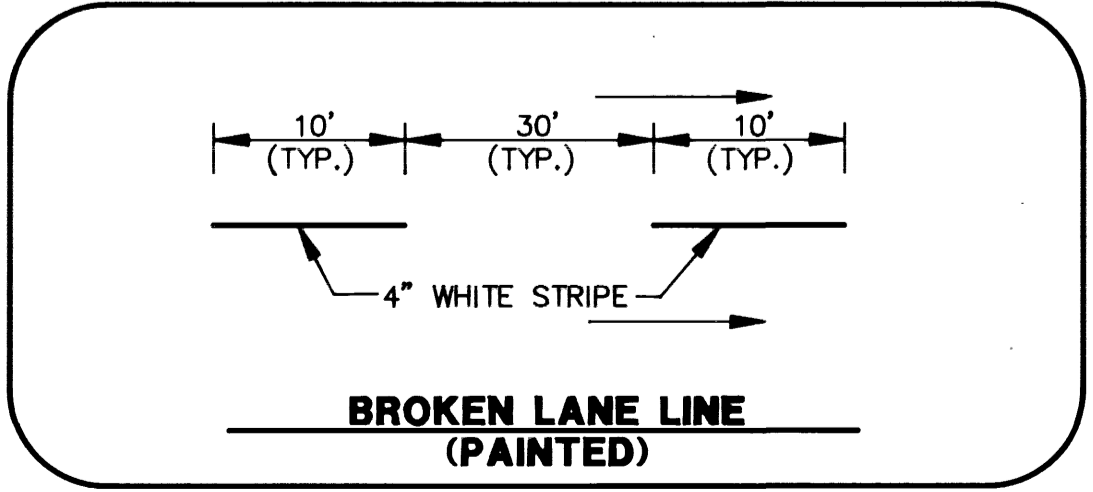
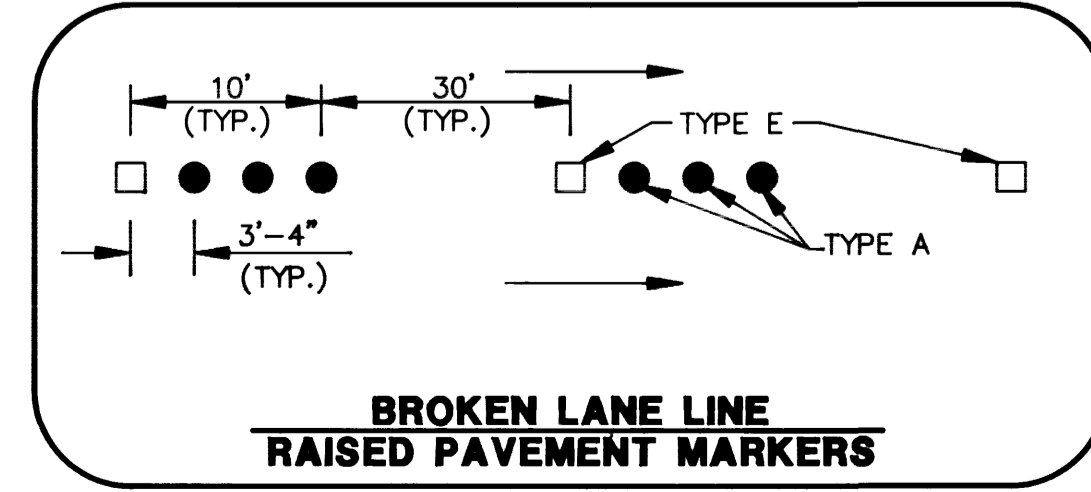


RECORD DRAWINGS
 THESE PLANS SHOW RECORD INFORMATION RECEIVED FROM:
 CONTRACTOR: **WELLS CARGO/ACME ELECTRIC**
 DATE: **OCTOBER 22, 1993**
 THIS DATA MAY OR MAY NOT REFLECT THE ACTUAL FIELD LOCATIONS. ALL DATA SHOULD BE CONFIRMED PRIOR TO USE ON DEVELOPMENT OR ENGINEERING PLANS.

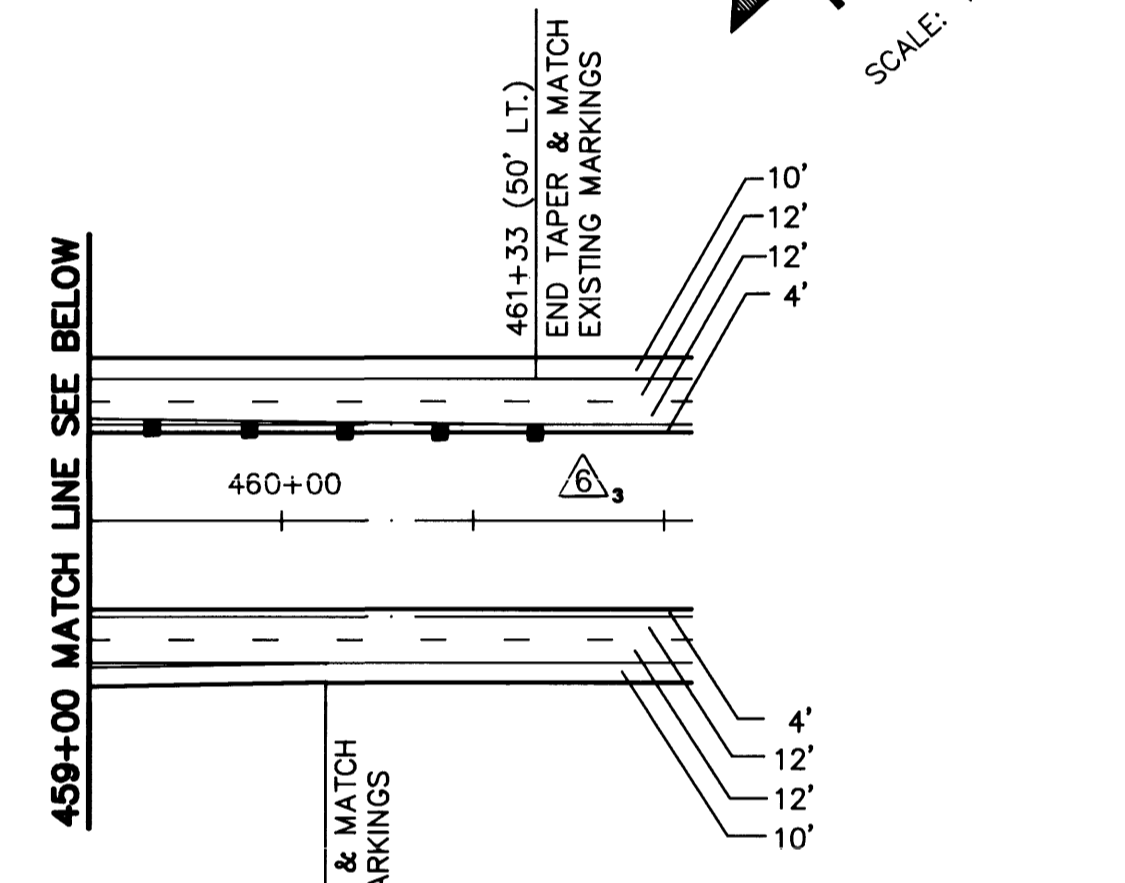

- LEGEND**
- 36" HIGH FLEXIBLE GUIDE POST, SURFACE MOUNT ASSEMBLY AS MANUFACTURED BY SAFE HIT OR EQUAL @ 50' O.C.
- NOTES:**
- REMOVE ALL PHASE 1 AND PHASE 2 SIGNS THAT ARE NOT SHOWN ON THIS PLAN. (ADD EXISTING SIGNS ON THIS PLAN FROM SHEET 21 SIGNS NO. 43 TO NO. 52.)
 - MARKERS ARE PER SUMMERLIN STD. DWG. S-91.

RECORD DRAWINGS	10/22/93	10/22/93	10/22/93
REVISE FINAL SIGNAGE	06/19/93	06/19/93	06/19/93
ISSUE TO CONSTRUCT	12/17/92	12/17/92	12/17/92
ISSUE TO BID	11/16/92	11/16/92	11/16/92
REV. DATE			
DESCRIPTION			
APPROVAL			

8540 10/22/93
 R.P.E. NO. DATE
 1555 SOUTH HANDEY BLVD./LAS VEGAS, NEVADA 89102
G. C. WALLACE, INC.
 Engineering/Architecture

SUMMERLIN PARKWAY AT GRADE INTERCHANGE
SUMMERLIN PARKWAY
SIGNING AND STRIPING

SHEET **20**
 SHT 20 OF 29