
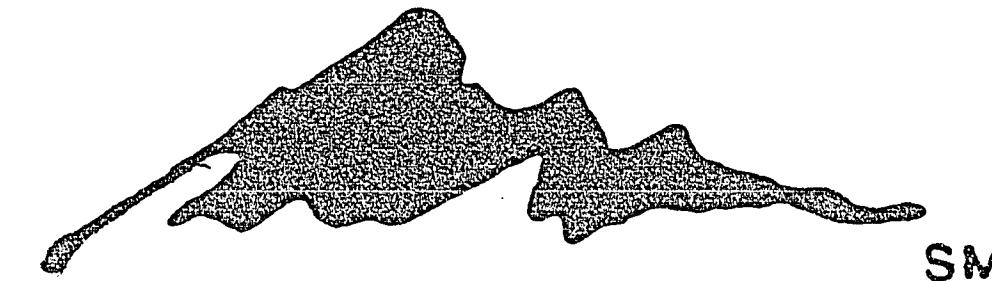


SUMMERLIN

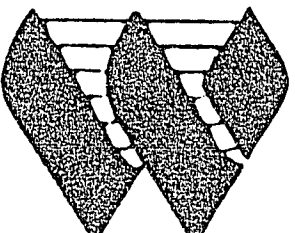

VILLAGE 1 NORTH RAMPART BLVD. WATER AND SEWER Howard Hughes Properties

 **G.C. WALLACE, INC.**
Engineering/Architecture
1555 SOUTH RAINBOW BLVD./LAS VEGAS, NEVADA 89102

Location: Las Vegas, Nevada

△ 12/1/91 REVISE SHEET 015-2
△ 5/15/90 AS-BUILT
△ 8/22/89 REVISIONS LVWD
O 7/12/89 ISSUE FOR CONSTRUCTION
B 7/13/89 ADDENDUM #2
A 8/22/89 ISSUE TO BID WATER/SEWER

RECORD DRAWINGS
THESE PLANS SHOW RECORD INFORMATION RECEIVED FROM:

CONTRACTOR WESTERN STATES DATE 5/15/90

THIS DATA MAY OR MAY NOT REFLECT THE ACTUAL FIELD
LOCATIONS. ALL DATA SHOULD BE CONFIRMED PRIOR TO
USE ON DEVELOPMENT OR ENGINEERING PLANS.

CLV # 307-V649 **SHEET 1 OF 5**

620.314

VILLAGE 1 NORTH RAMPART BLVD.